

OFFICE UNIT PLANS

SEVENTH FLOOR PLAN

100 retreat ave.
dimensions & sq. footages hartford, conn.


The tracings 1, 7, & 8 are Attachment A to the First Amendment to the Declaration of Retreat Medical Condominium and expandable condominium.

Exhibit 'C' to the Declaration of Retreat Medical Condominium - Expandable Condominium



I hereby certify that this plan is substantially correct and represents the conditions and dimensions as they presently exist at 100 Retreat Avenue.

James K. Farrell
James K. Farrell, AIA
Conn. #1560

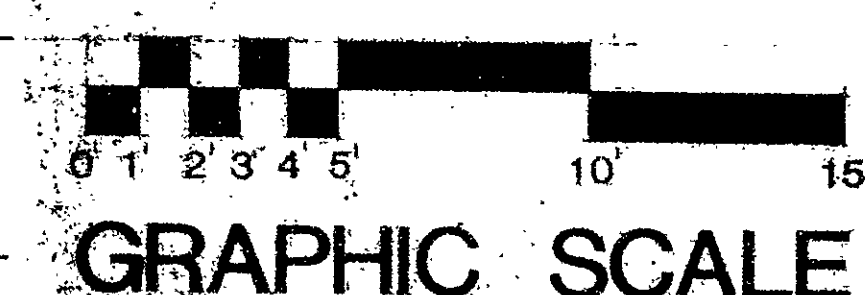

7TH FLOOR

NOTE:
ALL DIMENSIONS ARE FROM FACE OF GYPSUM BOARD TO FACE OF GLASS AT EXTERIOR WINDOW WALL.


FLOOR TO CEILING HEIGHT = 8'-0"

REVISIONS:
9-28-79
REVISION: C-11-79

kanal
kanal
white

Scale	1/4" = 1'	Drawn By	
Date	8-25-78	Checked By	
Revisions	10/21/78	Project No.	08-78
Verify All Dimensions At Site On Map Scale Drawing			
DRAWING NO.			

8

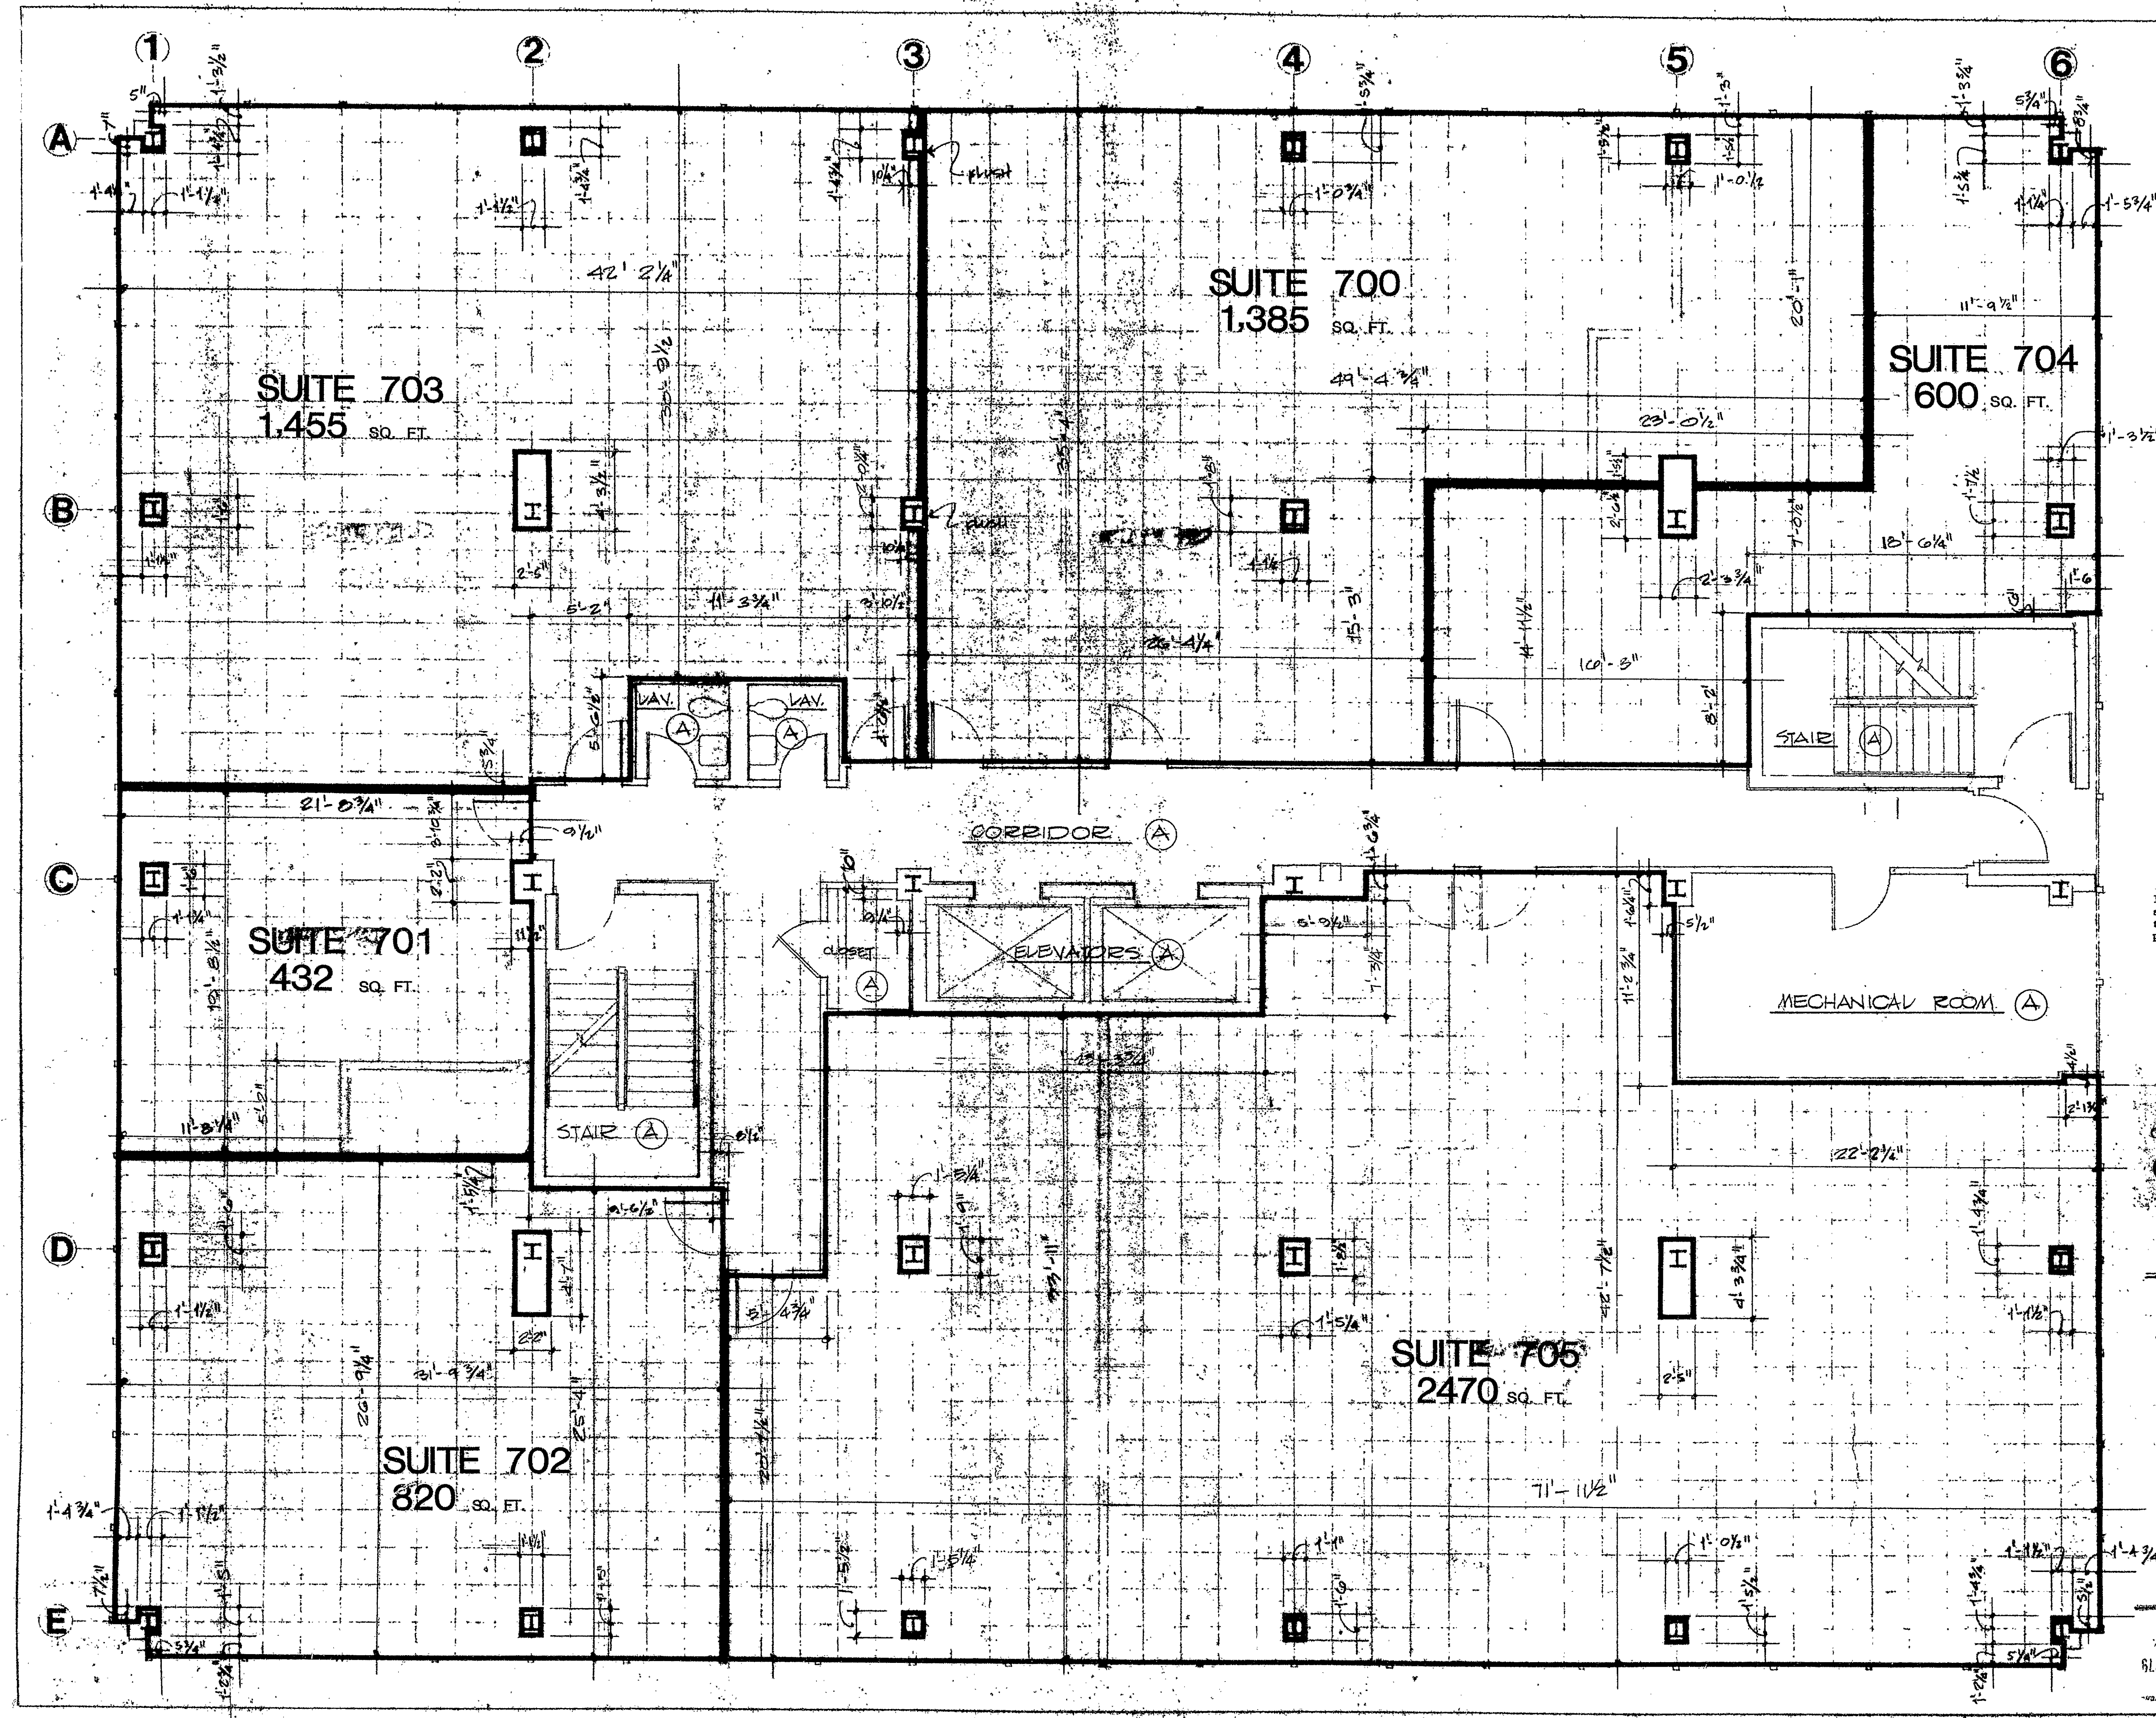

Condo Floor Plan 7th Fl.

