



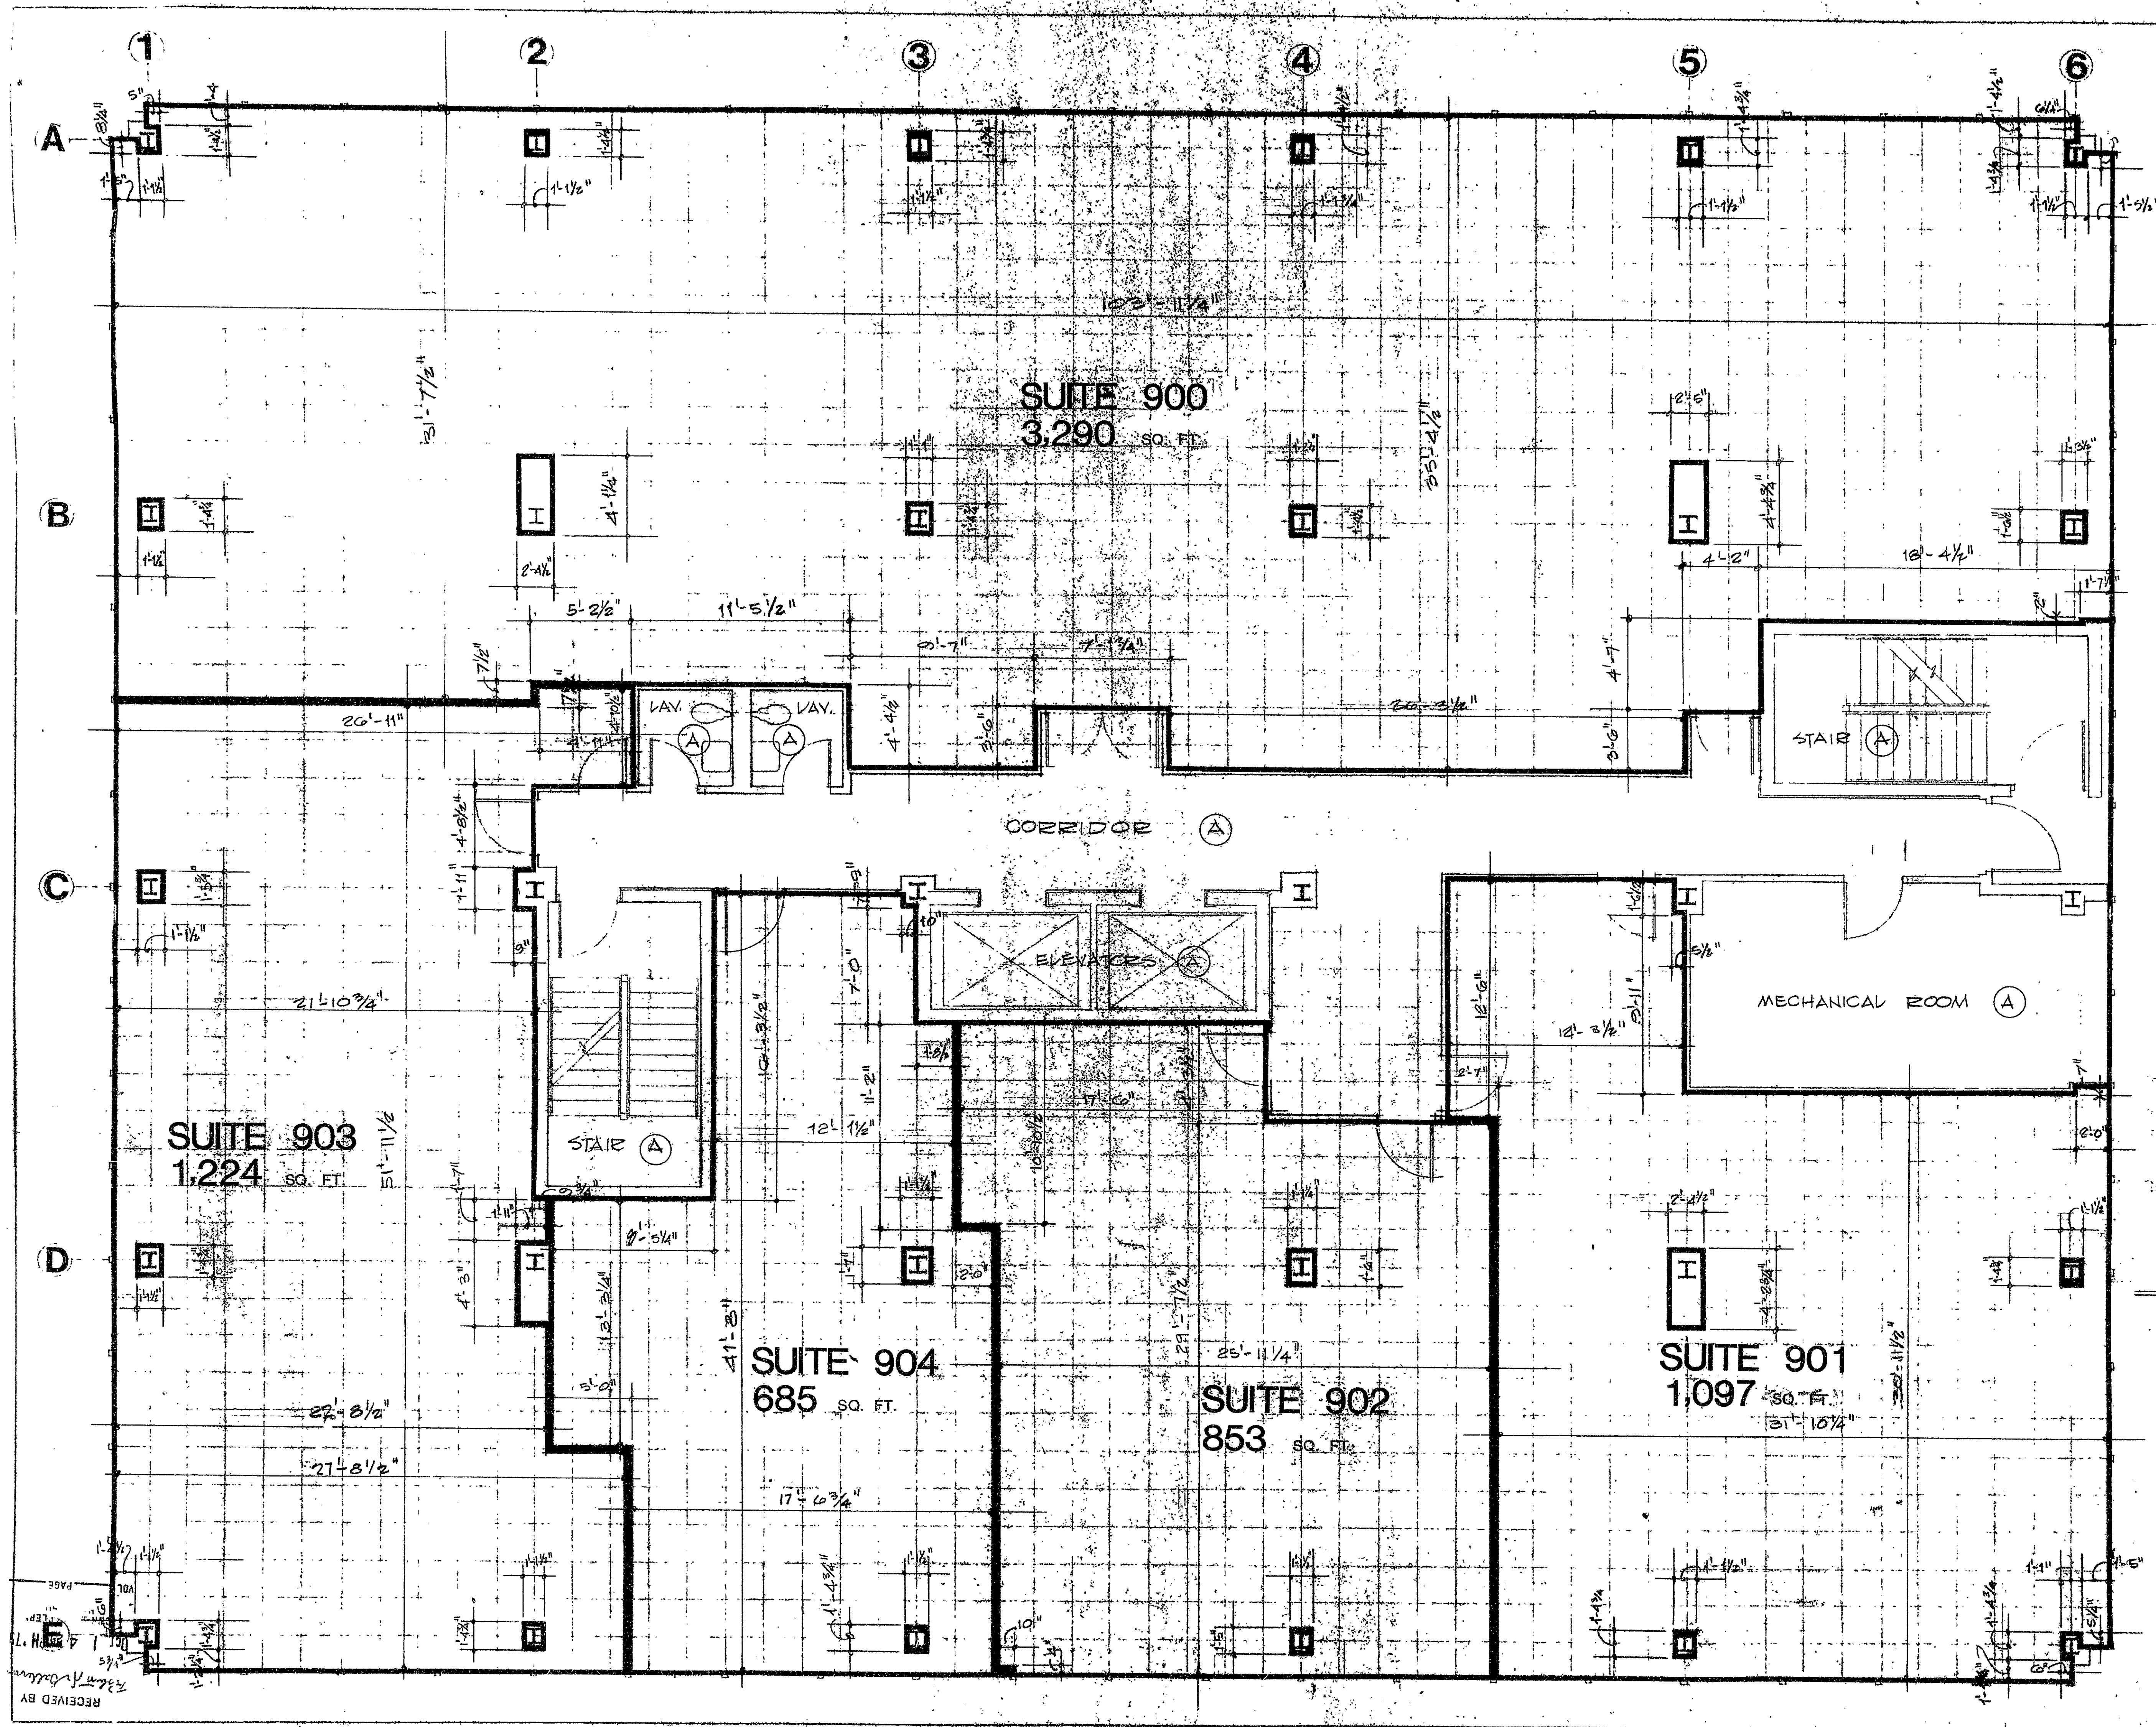

I hereby certify that this plan is substantially correct and represents the conditions and dimensions as they presently exist at 100 Retreat Avenue.

James K. Farrell
James K. Farrell, AIA
Conn. #1566

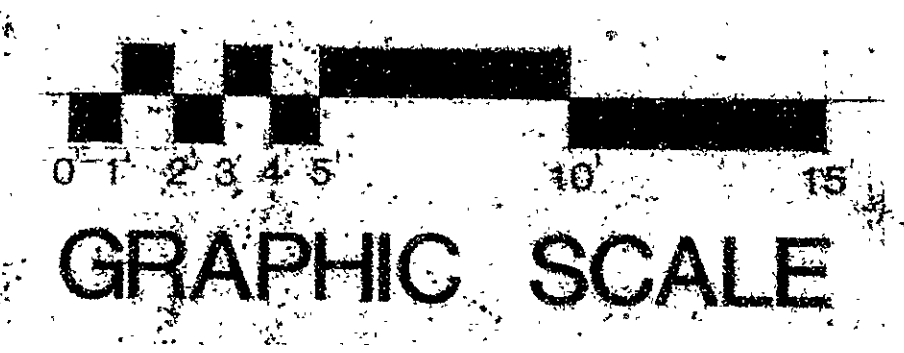

9TH FLOOR

NOTE: ALL DIMENSIONS ARE FROM FACE OF SHEET ROCK TO FACE OF GLASS AT EXTERIOR WINDOW WALL.

NOTE: FLOOR TO CEILING HEIGHT @ 9TH FLOOR IS 8' 0"

THIS IS 10 OF 10
C. TO BE EXAMINED
RETREAT AVENUE, HARTFORD, CT

9.28.79
REVISION - 6.11.79
REVISION - 6.18.79

NINTH FLOOR PLAN

100 retreat ave.

dimensions & sq. footages hartford, conn.

GRAPHIC SCALE






DRAWING NO. 10

Condo Floor Plan 4

