




I hereby certify that this plan is substantially correct and represents the conditions and dimensions as they presently exist at 100 Retreat Avenue.

James K. Farrell
James K. Farrell, AIA
Conn. #1566

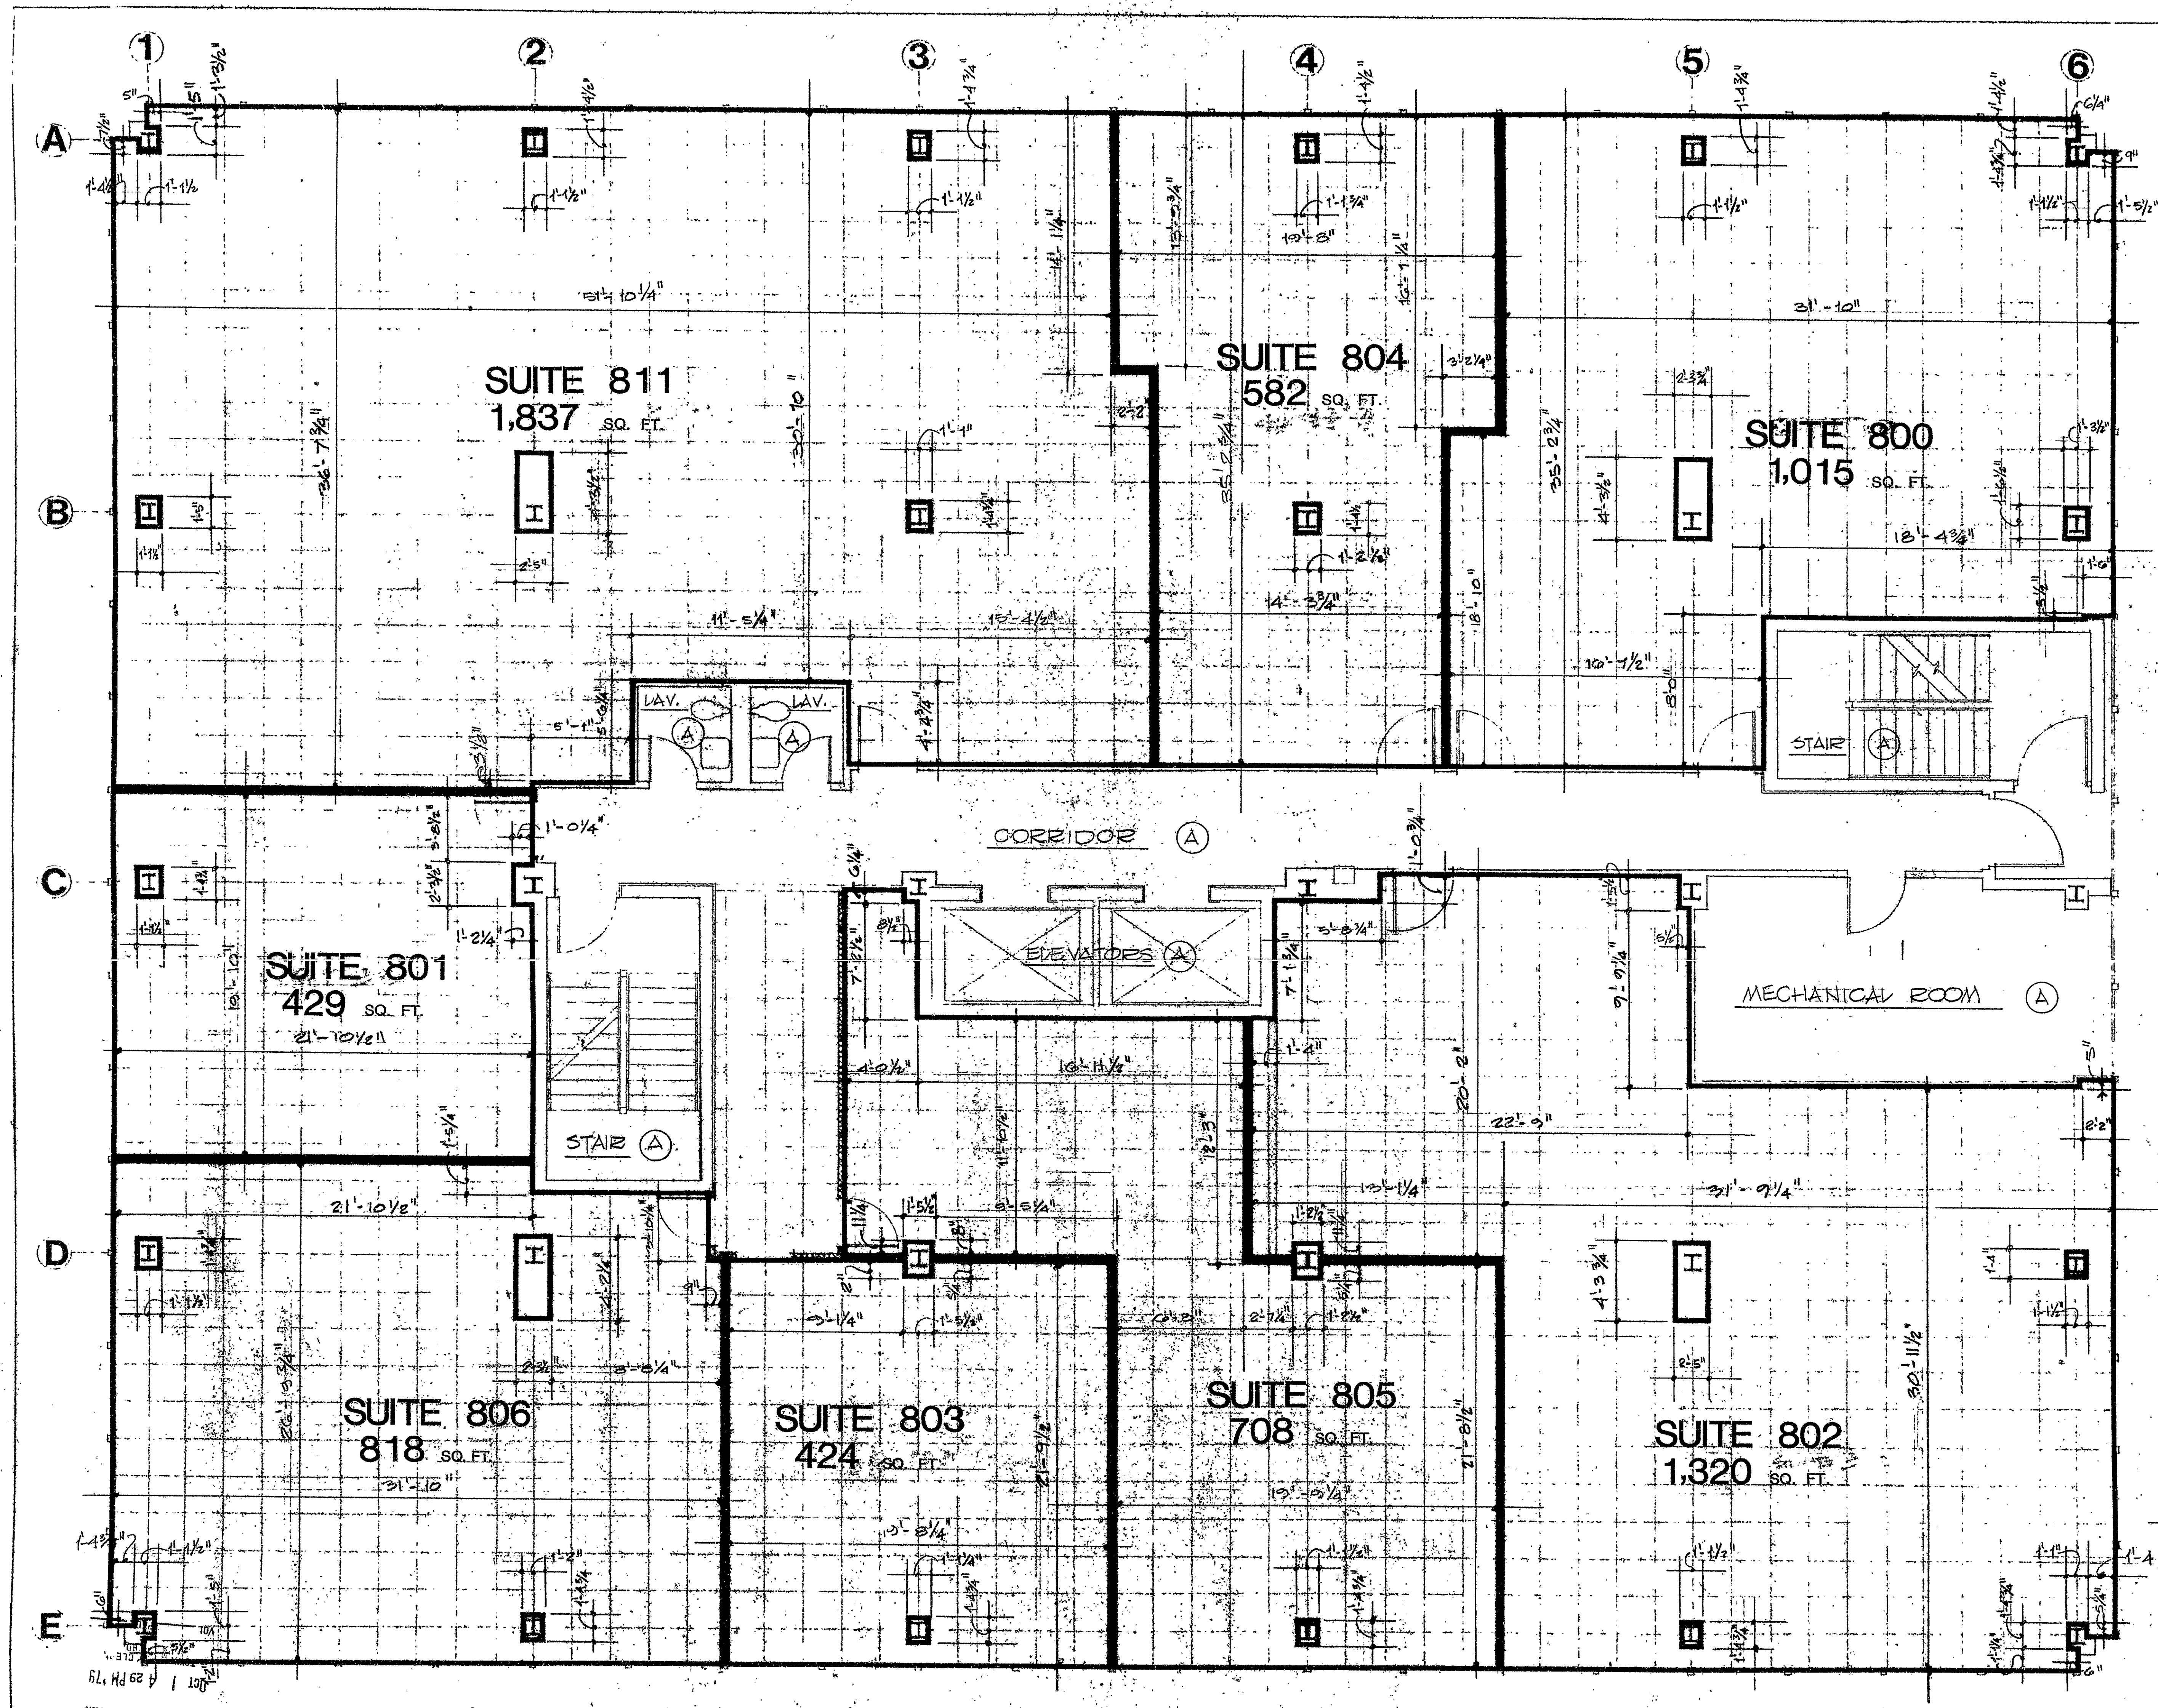

8TH FLOOR

NOTE:
ALL DIMENSIONS ARE FROM FACE OF GYPSUM BOARD TO FACE OF GLASS AT EXTERIOR WINDOW WALL.

FLOOR TO CEILING HEIGHT = 8'-0"

Page 9 of 10
EX C TO DECLARATION
RETREAT MEDICAL CENTER
9.28.79
REVISION: 6.11.79
REVISION: 6.18.79

100 retreat ave.
dimensions & sq. footages hartford, conn.

EIGHTH FLOOR PLAN

architects planners e.i.e.
100 Retreat Ave. Hartford, Conn.
06103

Scale
1" = 4'-0"

Date
8-25-78

Checked By
[Signature]

Revisions
10/3/79
1/8/79

Project No.
08-78

**Verify All Dimensions
As Shown On
Scale Drawings**

DRAWING NO.
9

Corrdo. Floor Plan # 4

