


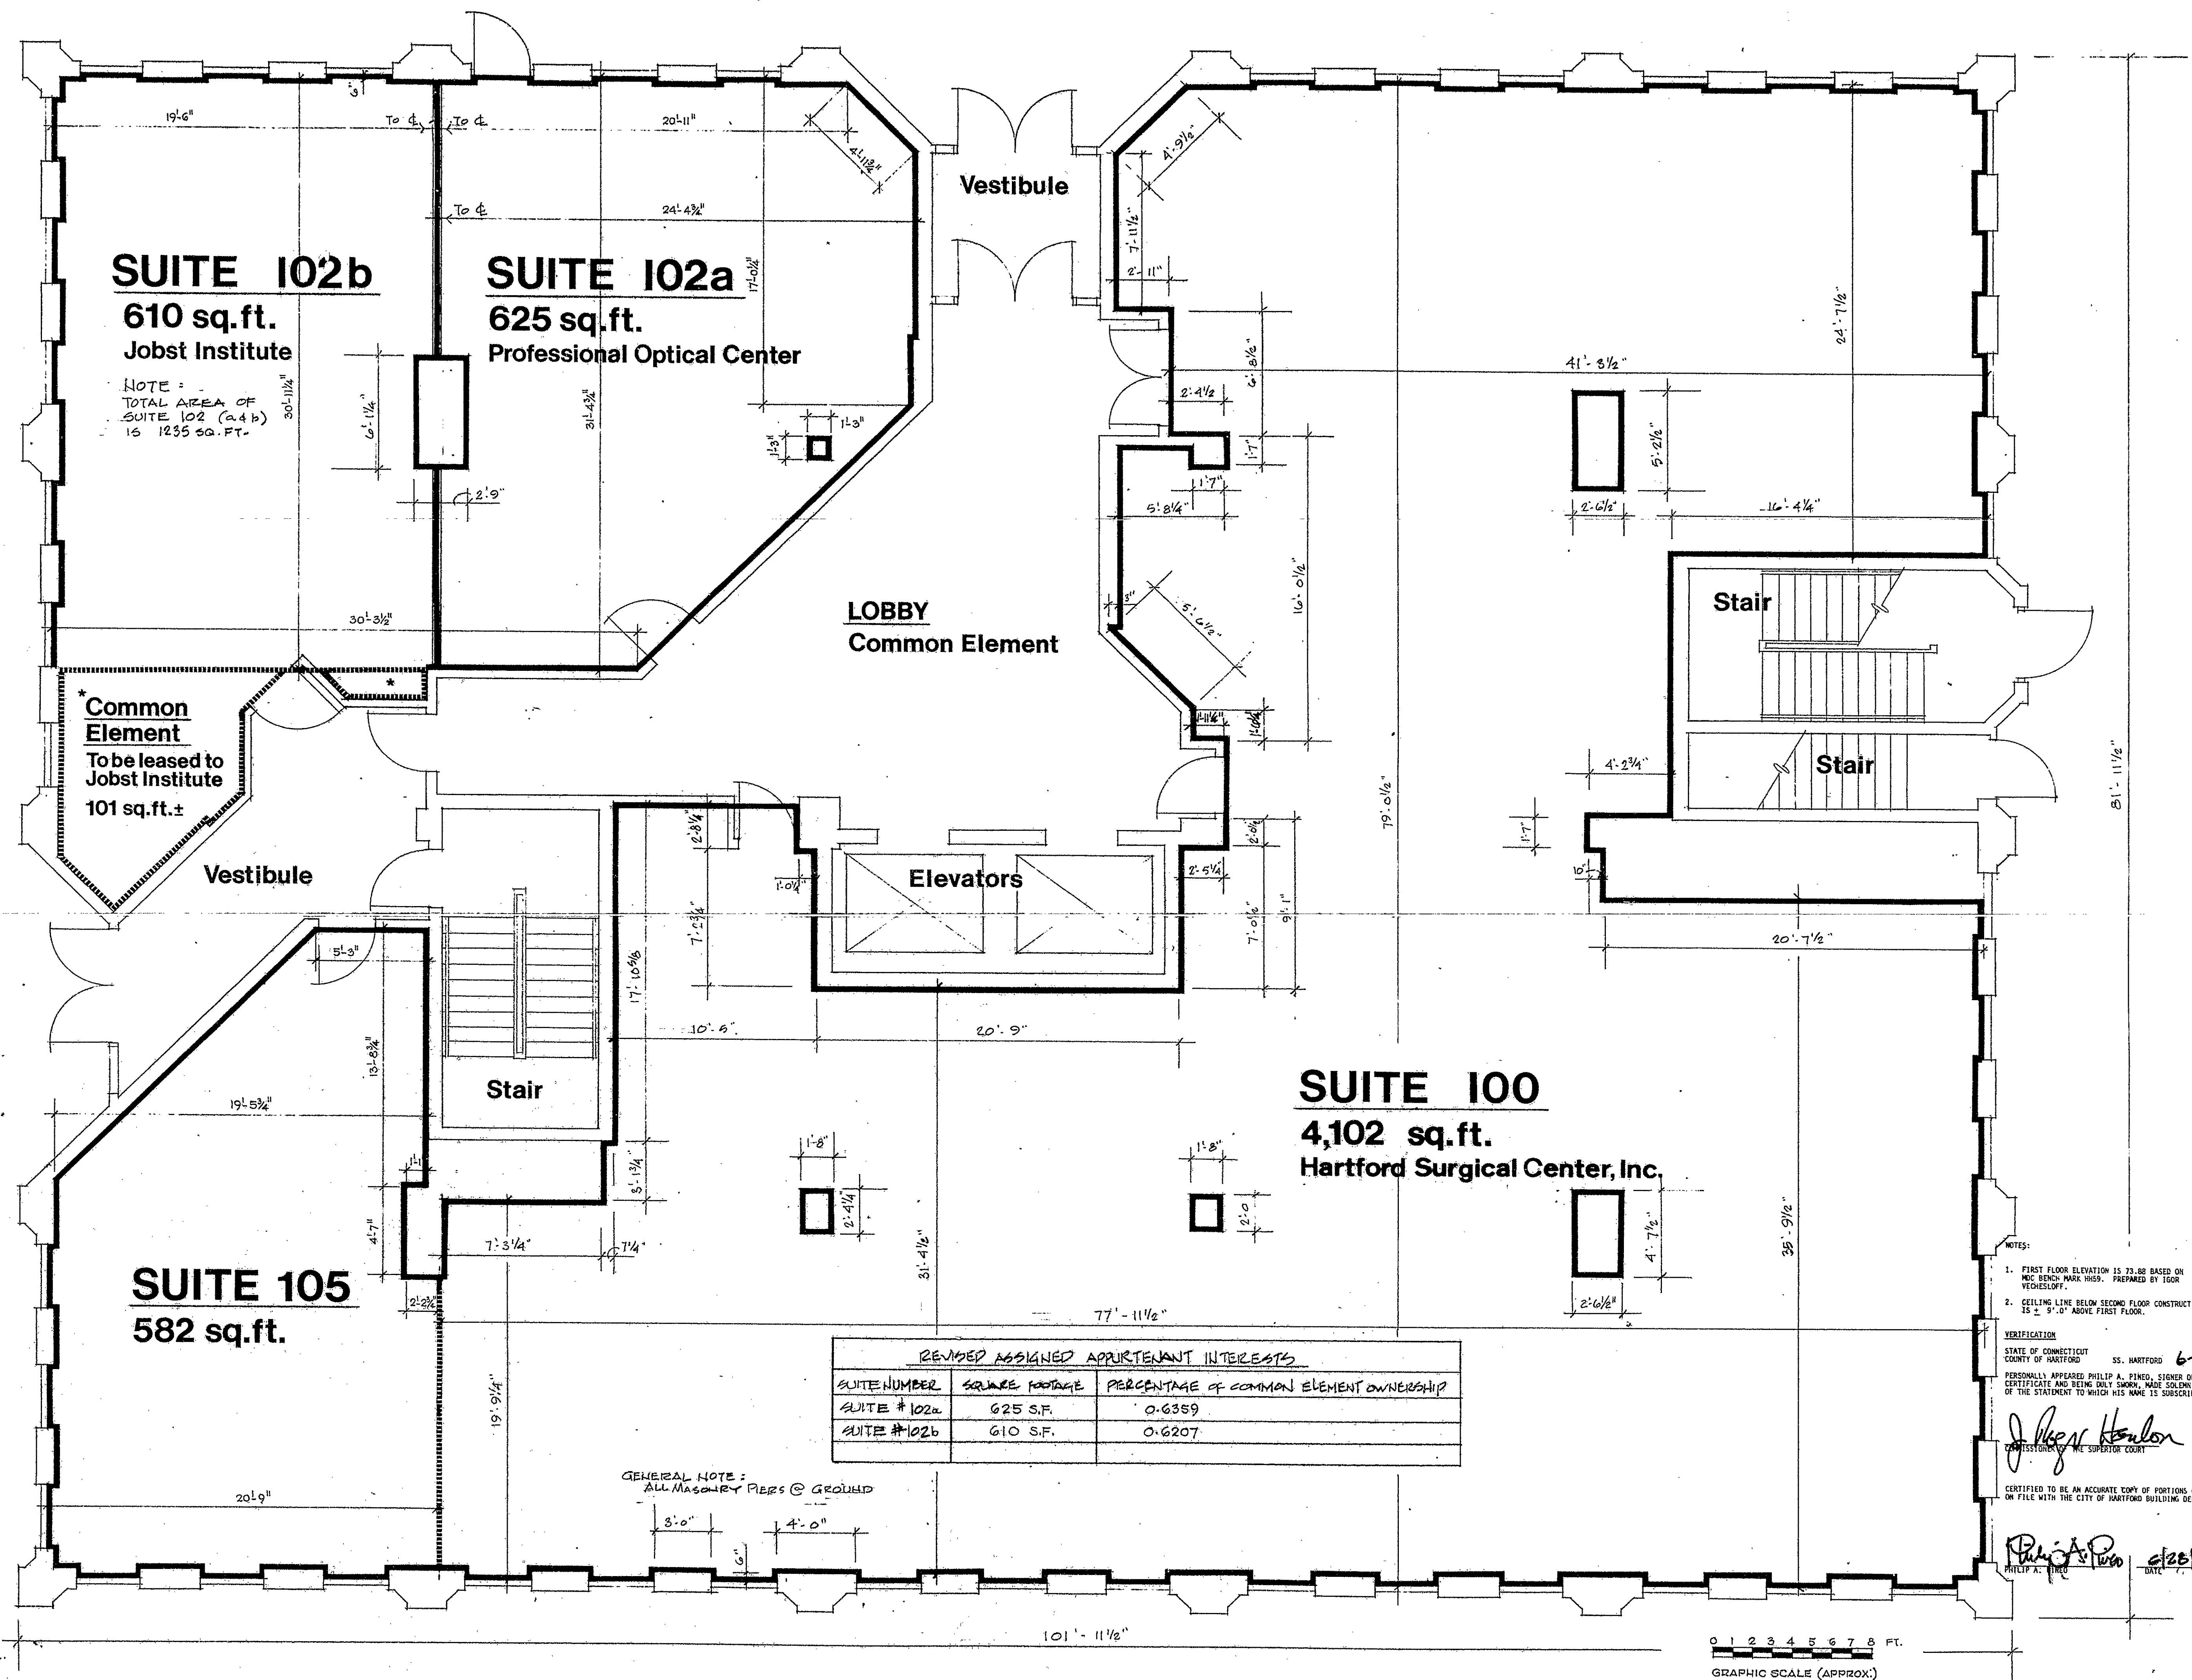

Retreat Medical Condominium
An Expandable Condominium
100 Retreat Avenue
Hartford, Connecticut

jeter cook jepson
architects p.c.
450 Church Street
Hartford, CT 06103

unit ownership plans
modified 26 June 1984
First Floor Plan

Initial Issue MAY 3, 1984
drawn by RCL
job no 7611-07
scale AS NOTED
no date revision
1. JETER COOK JEPSON
2. JETER COOK JEPSON

Condo Floor Plan # 4

