

OFFICE UNIT PLANS

LOWER LEVEL PLAN

100 retreat ave.
dimensions & sq. footages hartford, conn.

The tracings 1, 7, & 8 are Attachment A to the First Amendment to the Declaration of Retreat Medical Condominium and expandable condominium

Exhibit 'C' to the Declaration of Retreat Medical Condominium - Expandable Condominium




I hereby certify that this plan is substantially correct and represents the conditions and dimensions as they presently exist at 100 Retreat Avenue.

James K. Farrell
James K. Farrell, AIA
Conn. #1366

TOTAL SQUARE FOOTAGE ALL UNITS
66,810 SQ. FT.

COMMON AREA - (A)

LOWER LEVEL

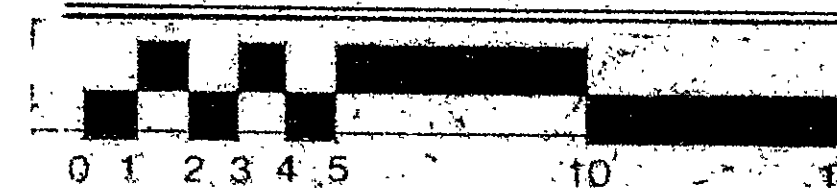

GRAPHIC SCALE


NOTE: ALL DIMENSIONS ARE TAKEN FROM FACE OF GYPSUM BOARD TO FACE OF GYPSUM BOARD.

FLOOR TO CEILING HEIGHT = 8'-0"

REVISION: 8-75-79
REVISION: 6-11-79
REVISION: 6-12-79
REVISION: 10-17-79
REVISION: 12-10-79

1

PAGE 1 OF 10

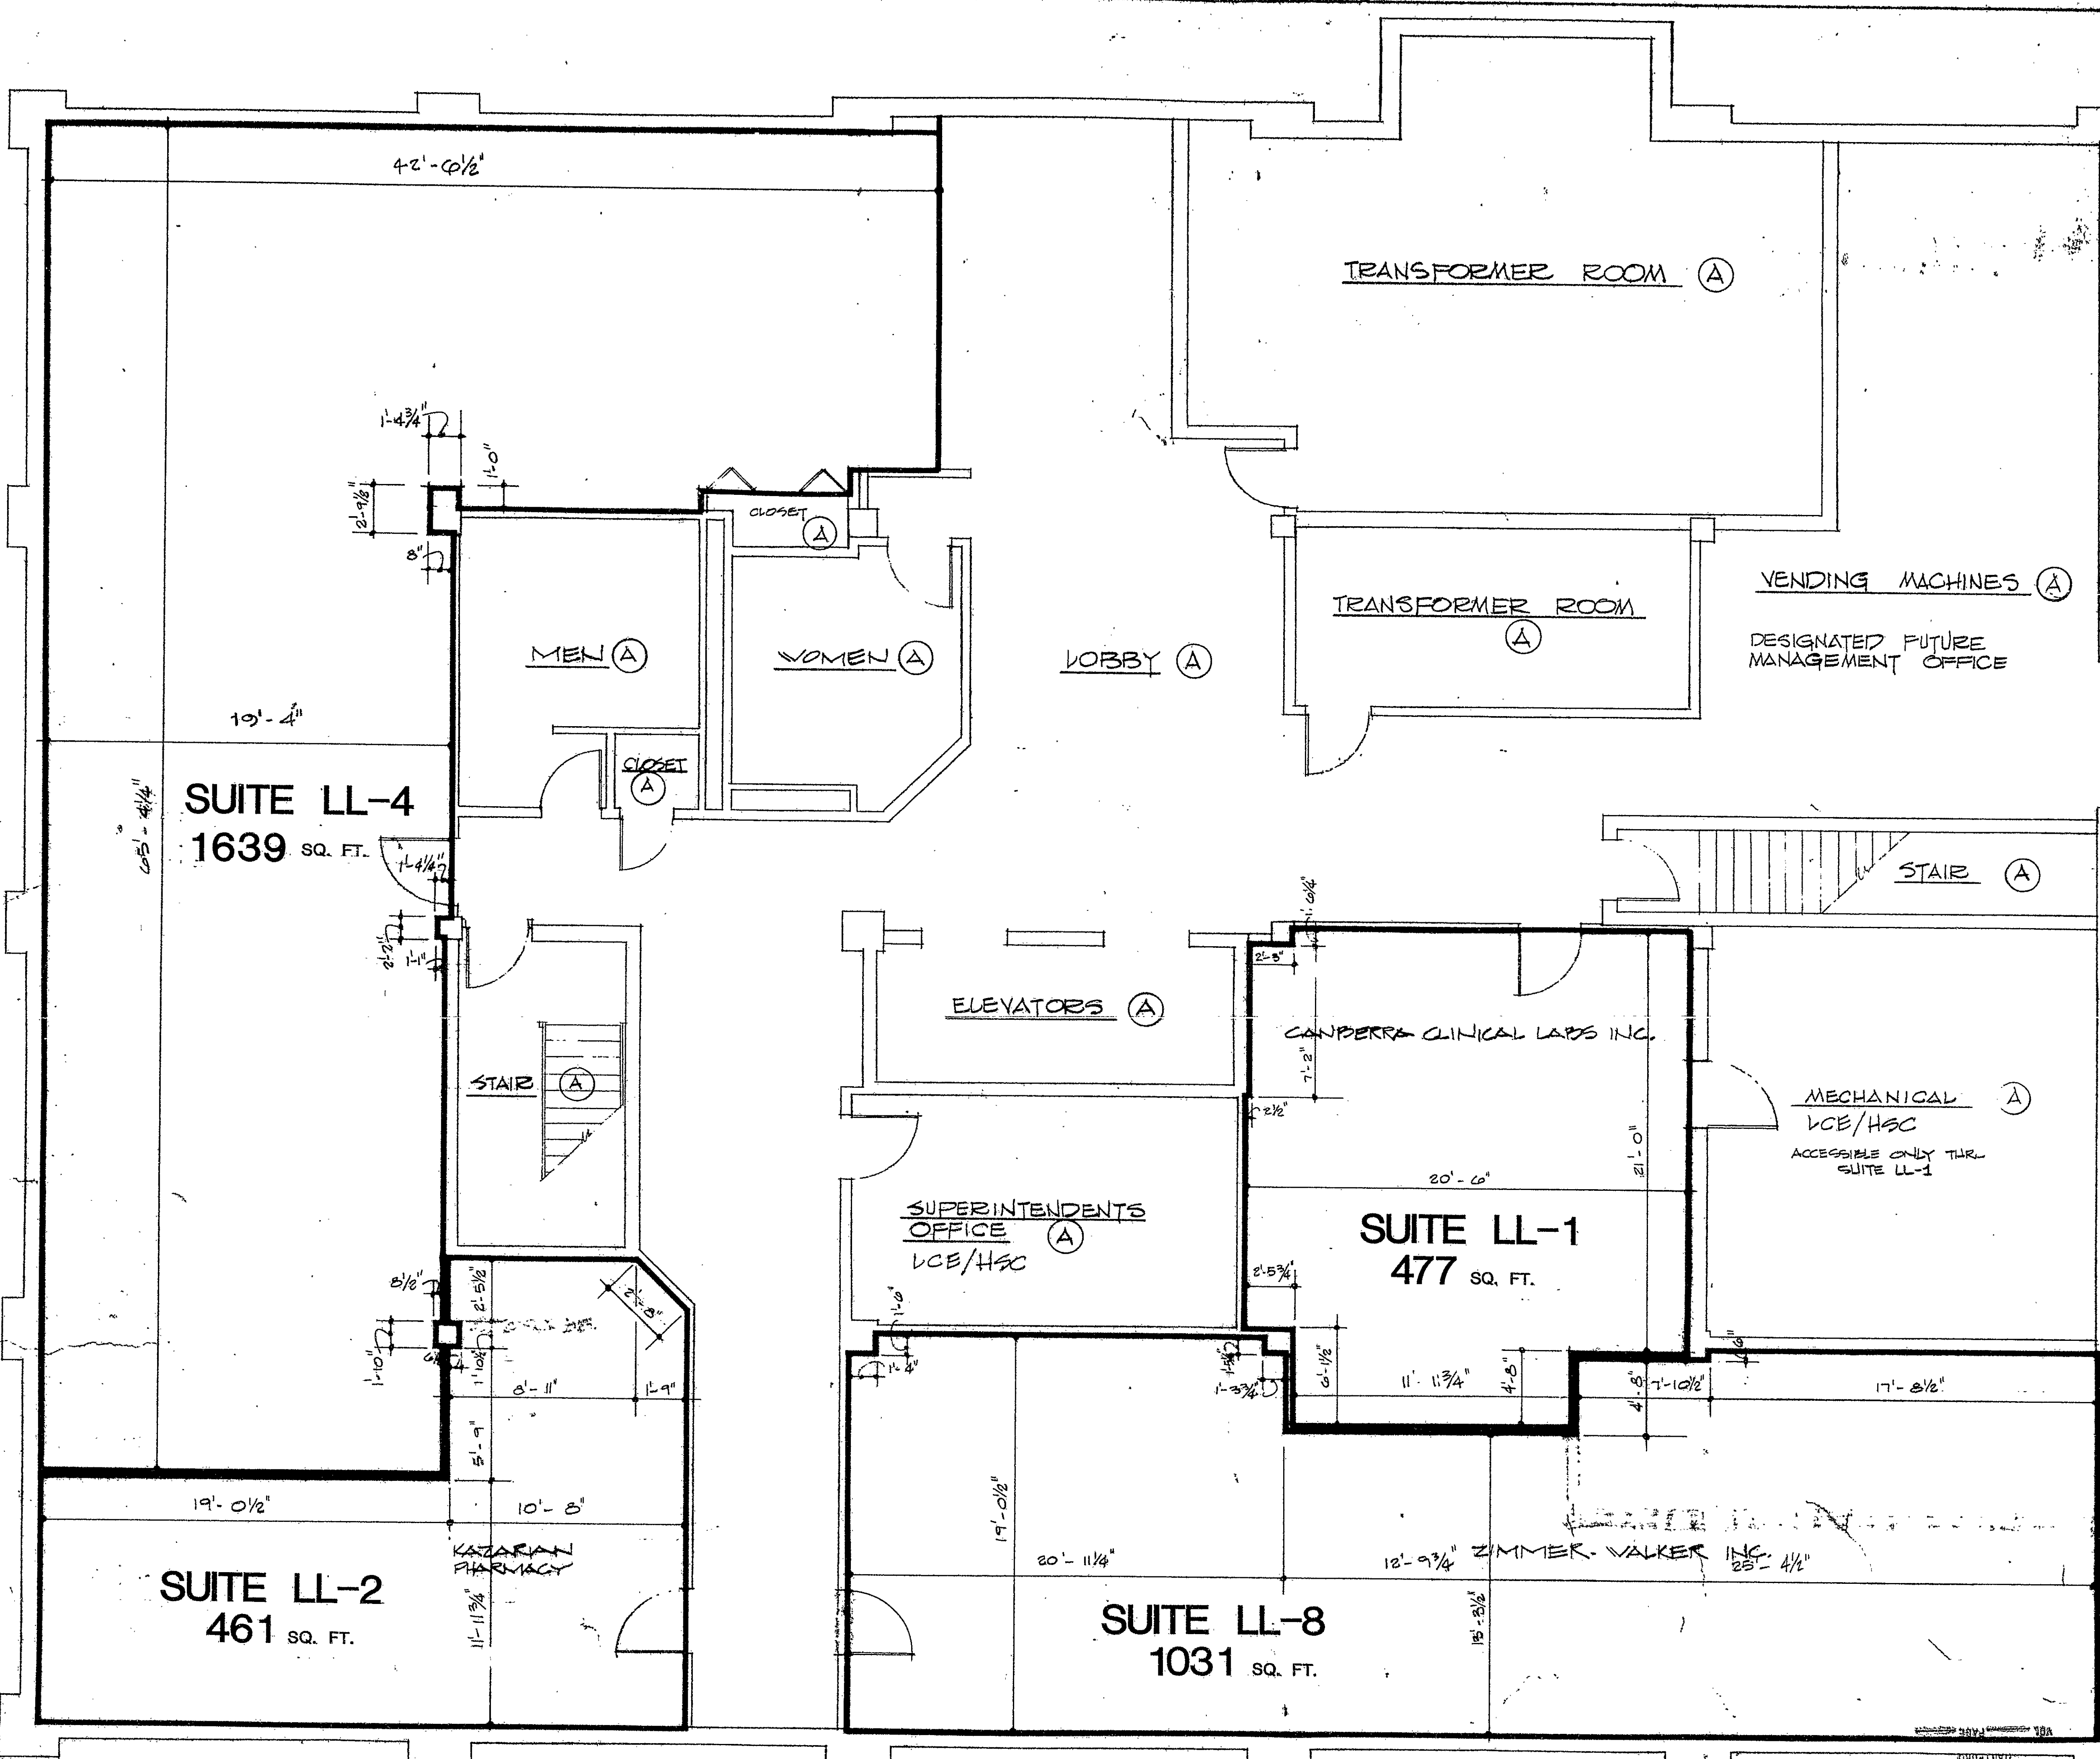

Condo Floor Plan # 14

