


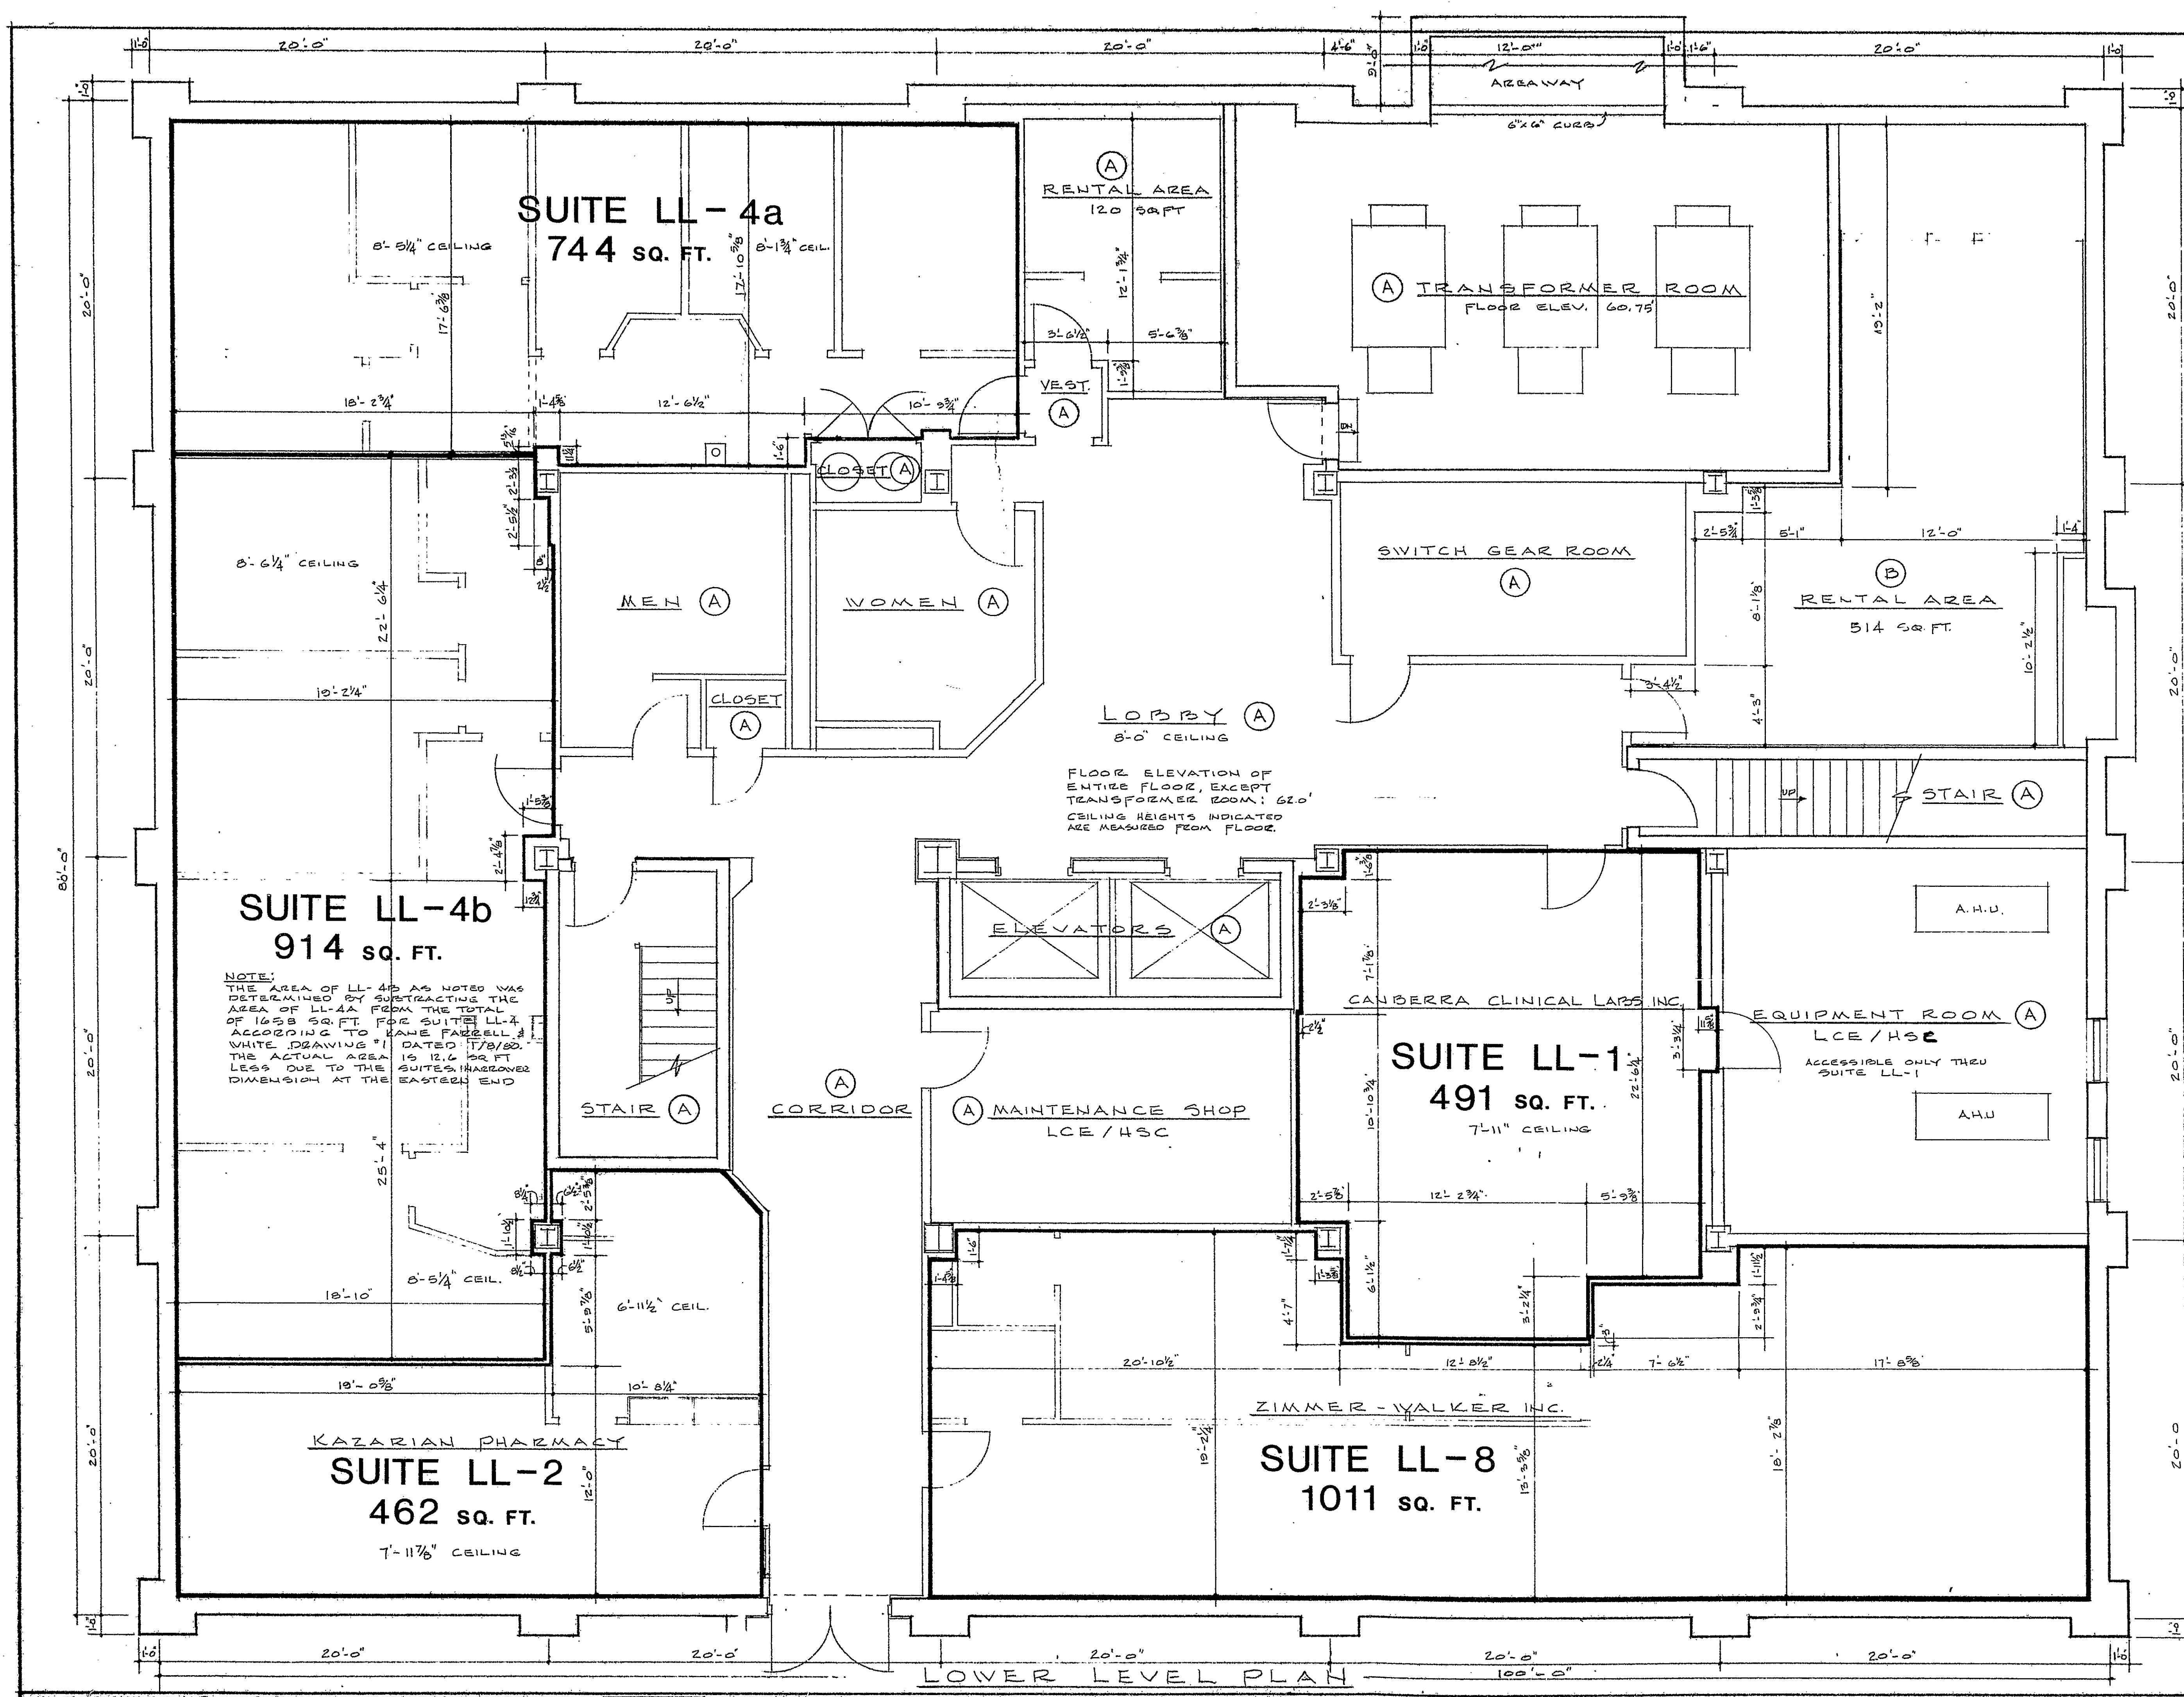

LIMITED COMMON ELEMENTS (A)
TO ALL OFFICE UNITS
COMMON ELEMENT (B)

TOTAL SQUARE FOOTAGE ALL UNITS
66,825 SQ. FT.



NOTE:
ALL DIMENSIONS ARE TAKEN FROM
FACE OF FINISHED WALL EXCEPT WHERE
CENTERLINE OF PARTITION IS USED
BETWEEN SUITE LL-4A & 4B

UNIT OWNERSHIP - PLANS MODIFIED

THIS DRAWING #1 IS ATTACHMENT A
TO THE FIFTH AMMENDMENT TO THE
DECLARATION OF RETREAT MEDICAL
CONDOMINIUM, AN EXPANDABLE
CONDOMINIUM.

THIS DRAWING REPLACES DRAWING
#1 OF ATTACHMENT A TO THE SECOND
AMMENDMENT TO THE DECLARATION OF
RETREAT MEDICAL CONDOMINIUM, AN
EXPANDABLE CONDOMINIUM.

AS SUCH, THIS DRAWING IS THE MOST
CURRENT FLOOR PLAN FOR THE LOWER
LEVEL OF THE OFFICE BUILDING IN
THE CONDOMINIUM. THE FLOOR PLANS,
AS AMENDED, COLLECTIVELY CONSTITUTE
EXHIBIT "C" TO THE DECLARATION OF
RETREAT MEDICAL CONDOMINIUM, AN
EXPANDABLE CONDOMINIUM.

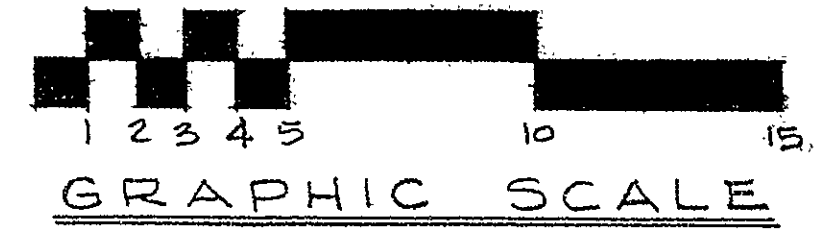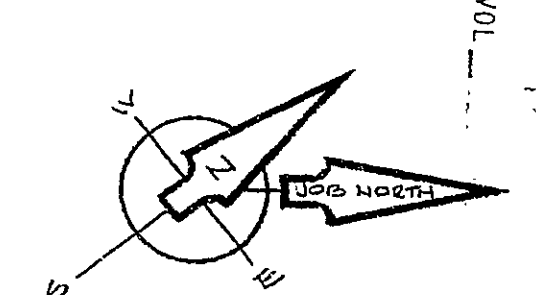

I HEREBY CERTIFY THAT THIS PLAN IS
SUBSTANTIALLY CORRECT AND
REPRESENTS THE CONDITIONS AND
DIMENSIONS AS THEY PRESENTLY
EXIST AT 100 RETREAT AVENUE
AND THAT THIS PLAN IS AN
ACCURATE COPY OF PORTIONS OF
THE PLANS FILED WITH THE
HARTFORD BUILDING INSPECTOR
DATED FEB. 6, 1991.
Welles A. Standish II
WELLES A. STANDISH II



UNIT OWNERSHIP - PLANS MODIFIED,
EXHIBIT C TO DECLARATION OF
RETREAT MEDICAL CONDOMINIUM
100 RETREAT AVE. HARTFORD, CONN. 06106

JOB NO. 108
SCALE: 1/8"=1'-0"
FEB. 6, 1991

SEE FIFTH AMMENDMENT
TO DECLARATION OF
RETREAT MEDICAL CONDOMINIUM
REVISED: 2/21/91

OFFICE UNIT PLANS - 100 RETREAT AVE.
DIMENSIONS & SQUARE FOOTAGES

1
PAGE 1 OF 10

WELLES A. STANDISH II, AIA-ARCHITECT
124 LASALLE ROAD
WEST HARTFORD, CONN. 06107
TELEPHONE 232-6648

Condo Plan # 4

