



RECEIVED BY
Robert A. Bell
Nov 13 8 40 AM '79
PAGE 1

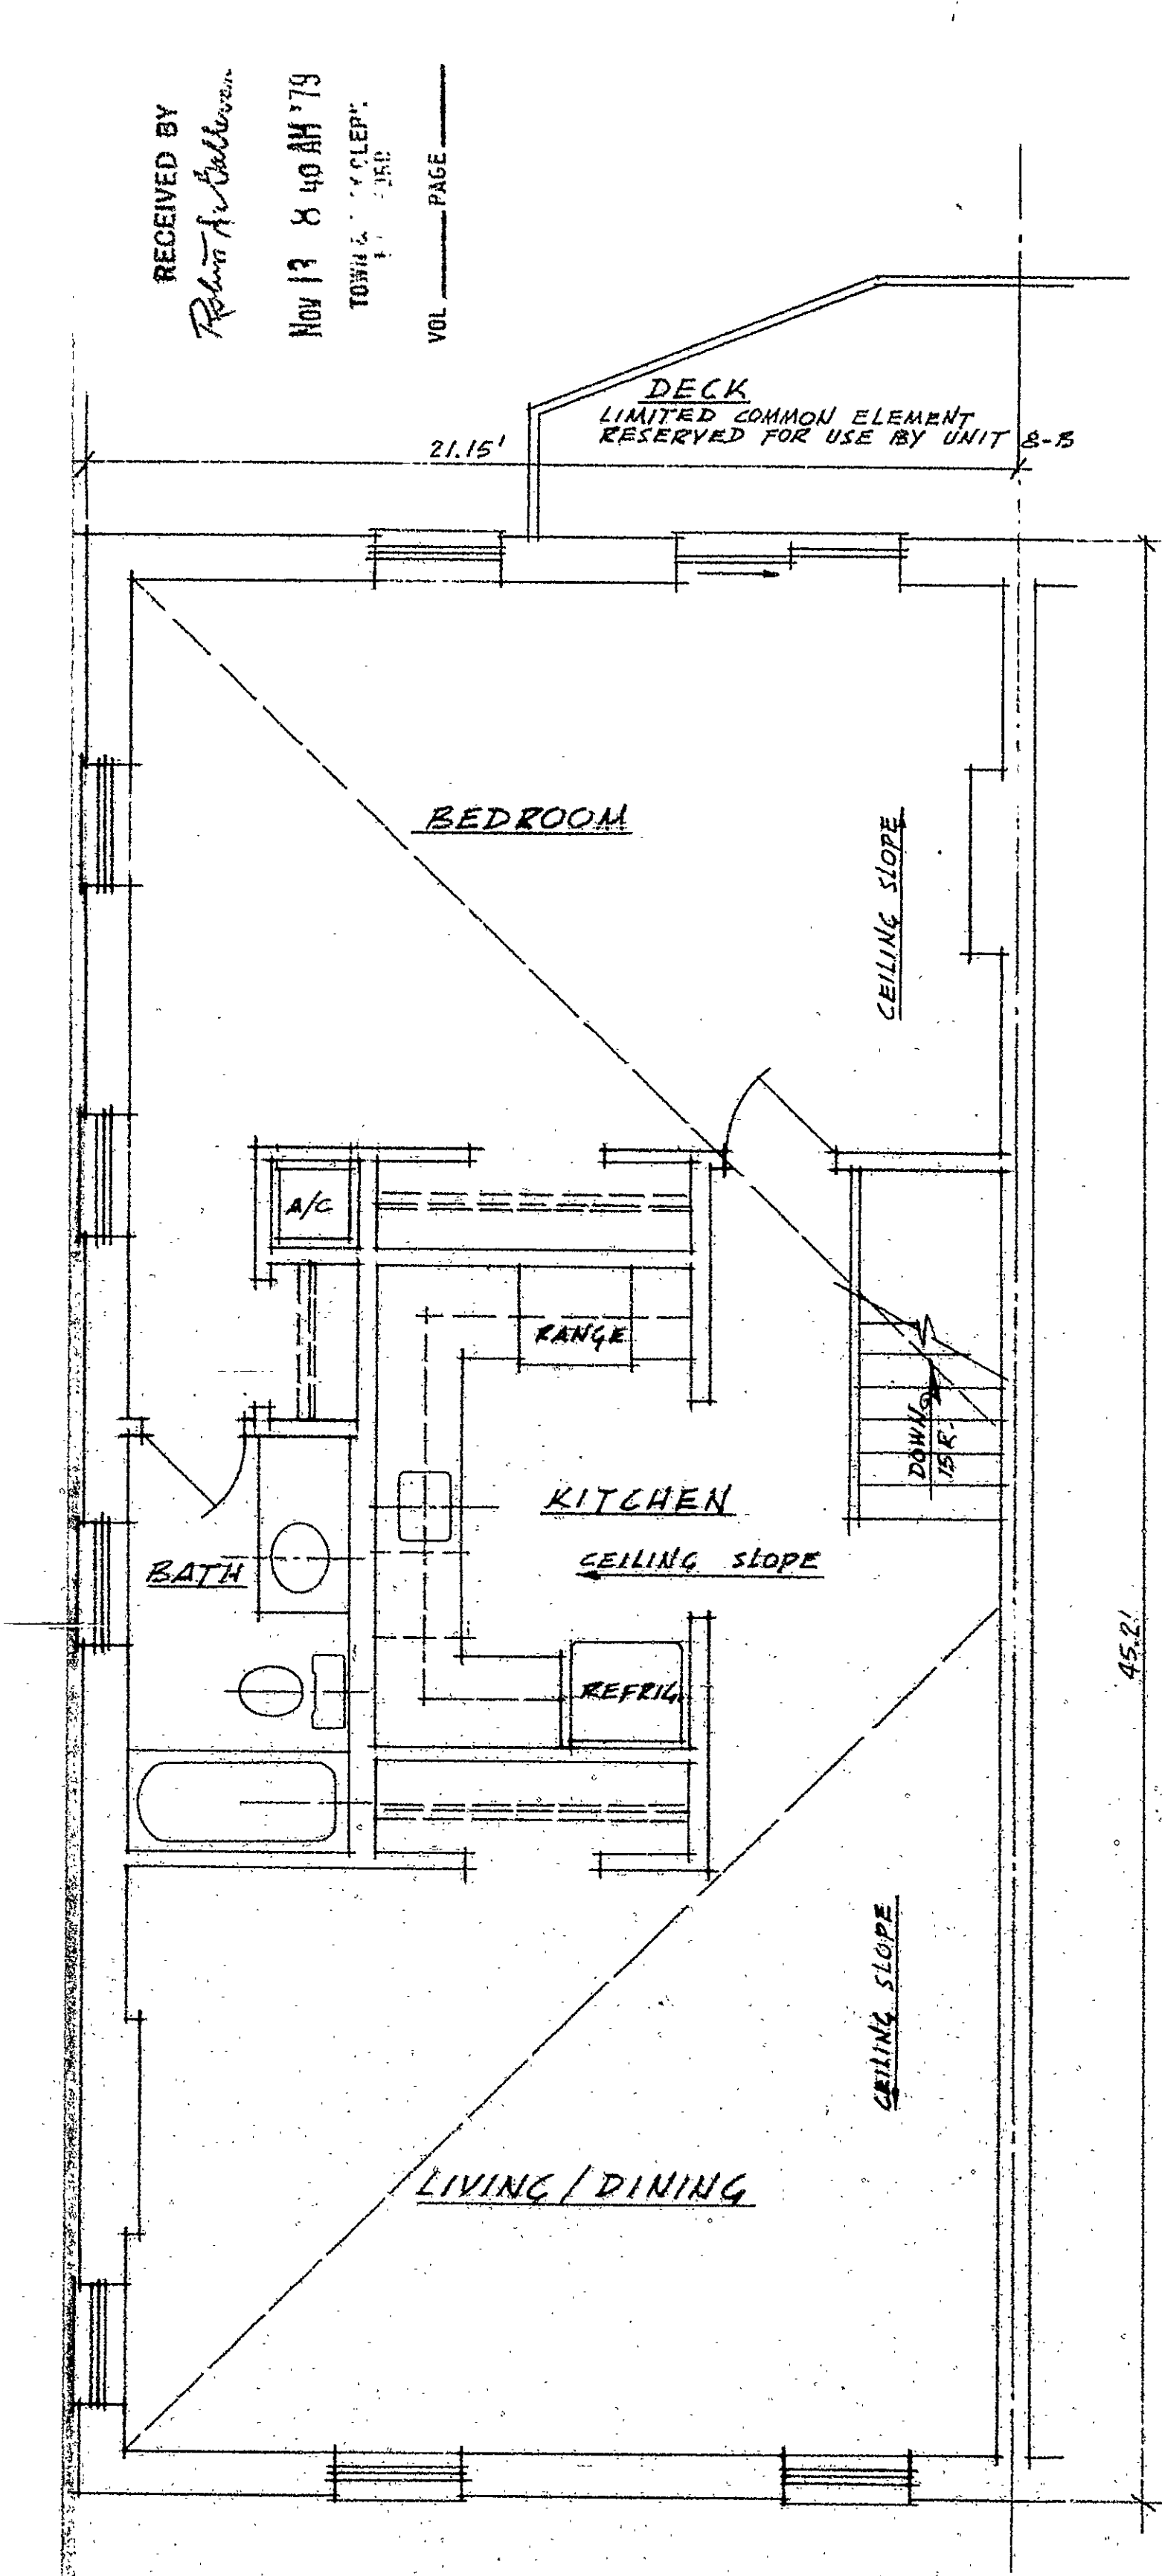


THIRD FLOOR
UNIT 8-B
ELEV. 98.50'

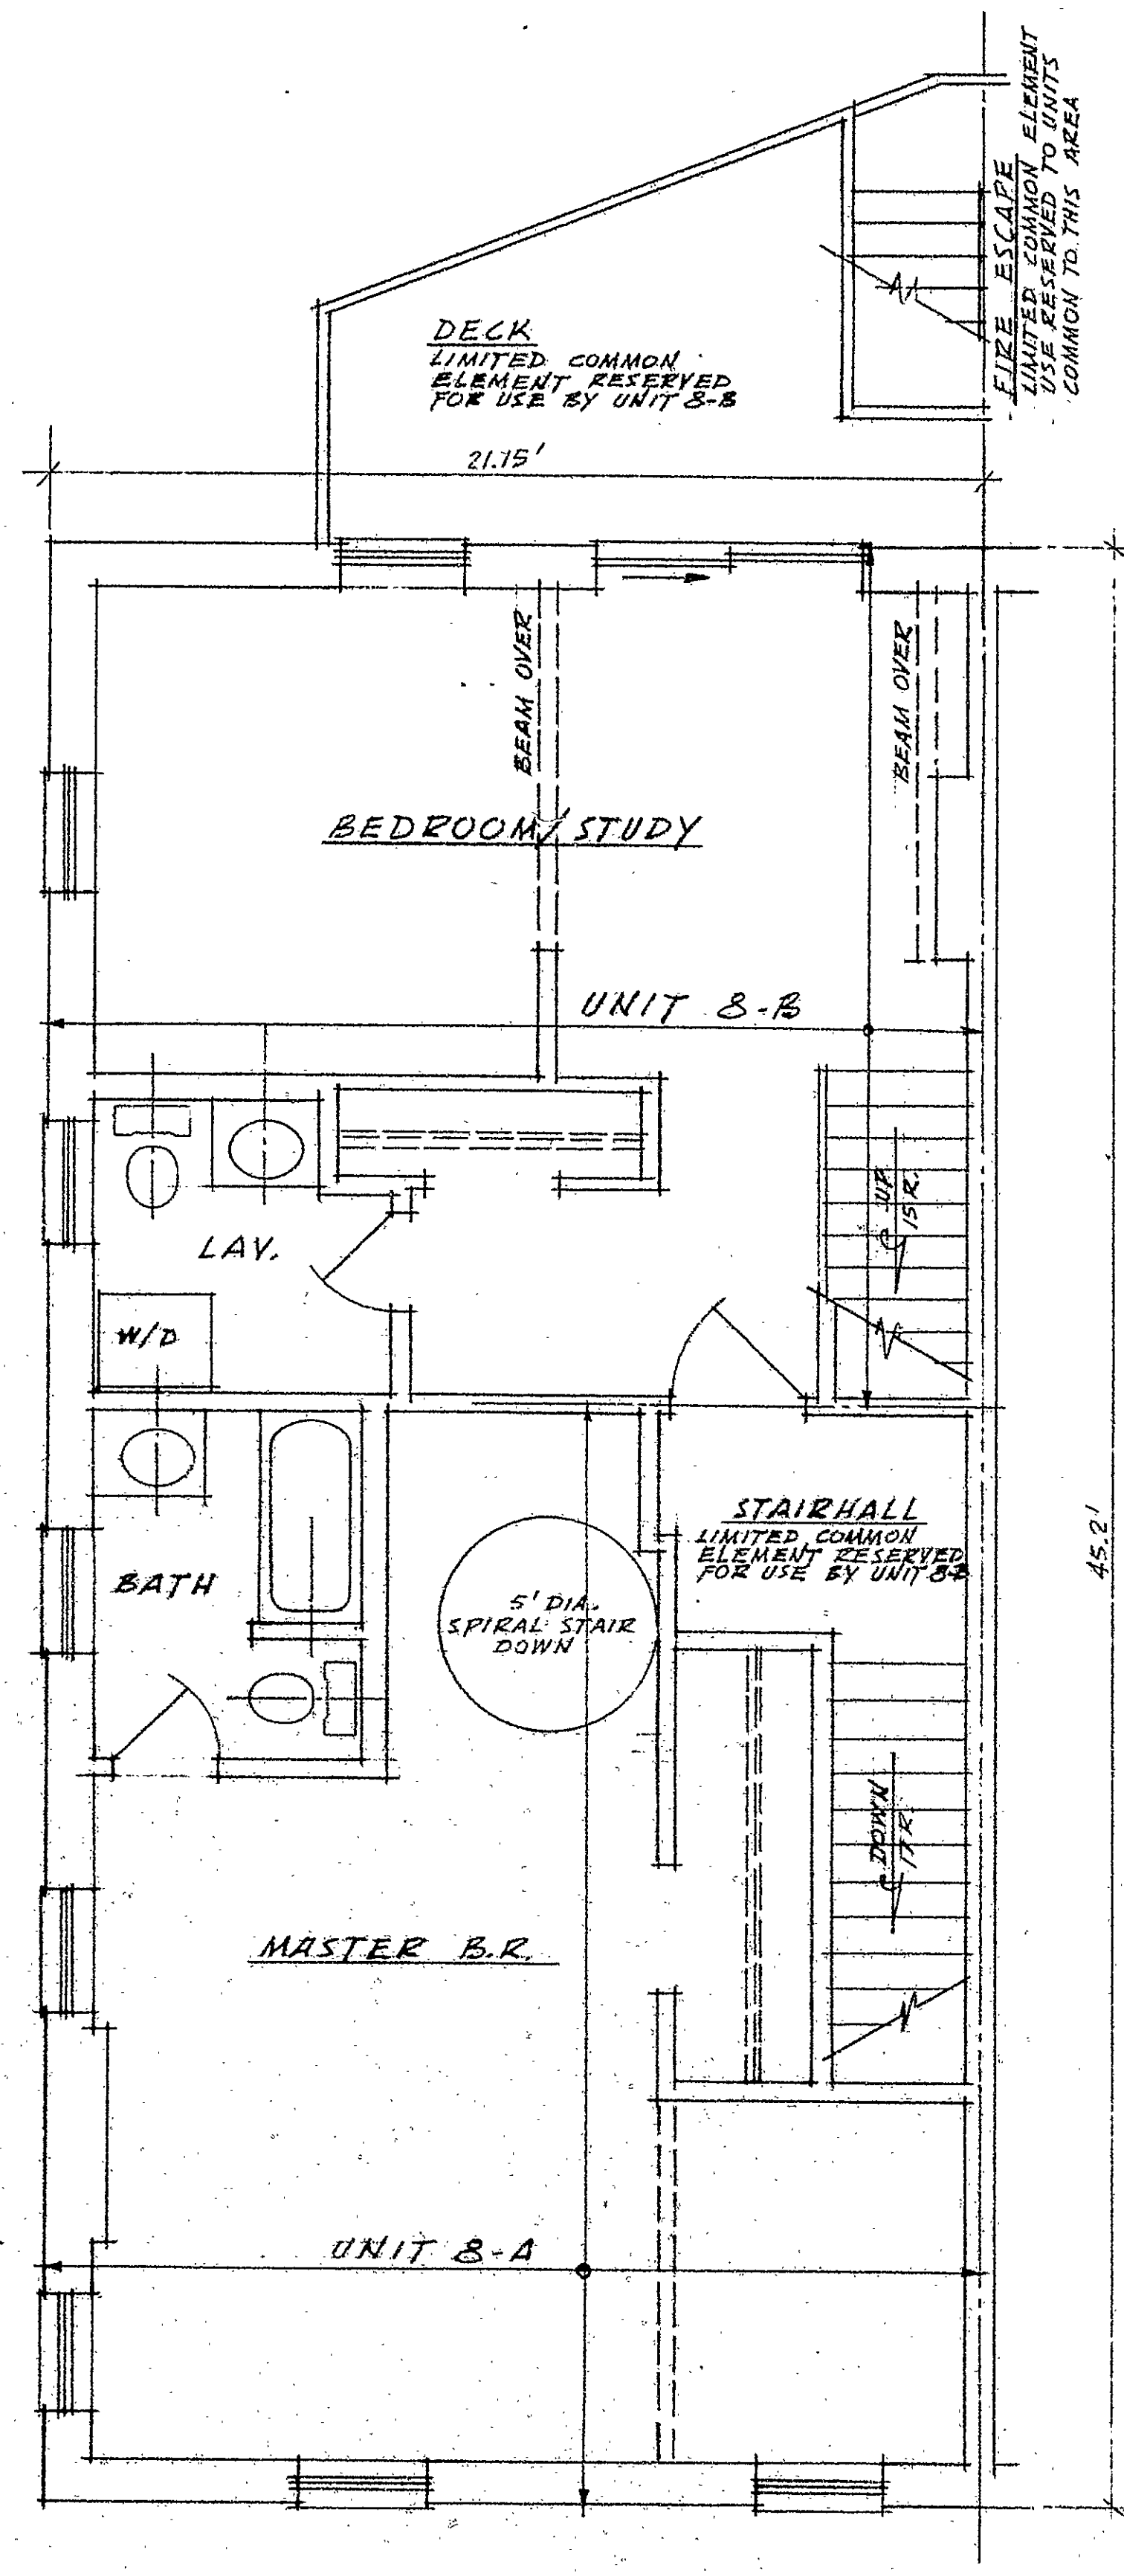


SECOND FLOOR
UNITS 8-A & 8-B
ELEV. 83.45'

UNIT AREA	
8-A	1,489 SQ. FT.
8-B	1,379 SQ. FT.

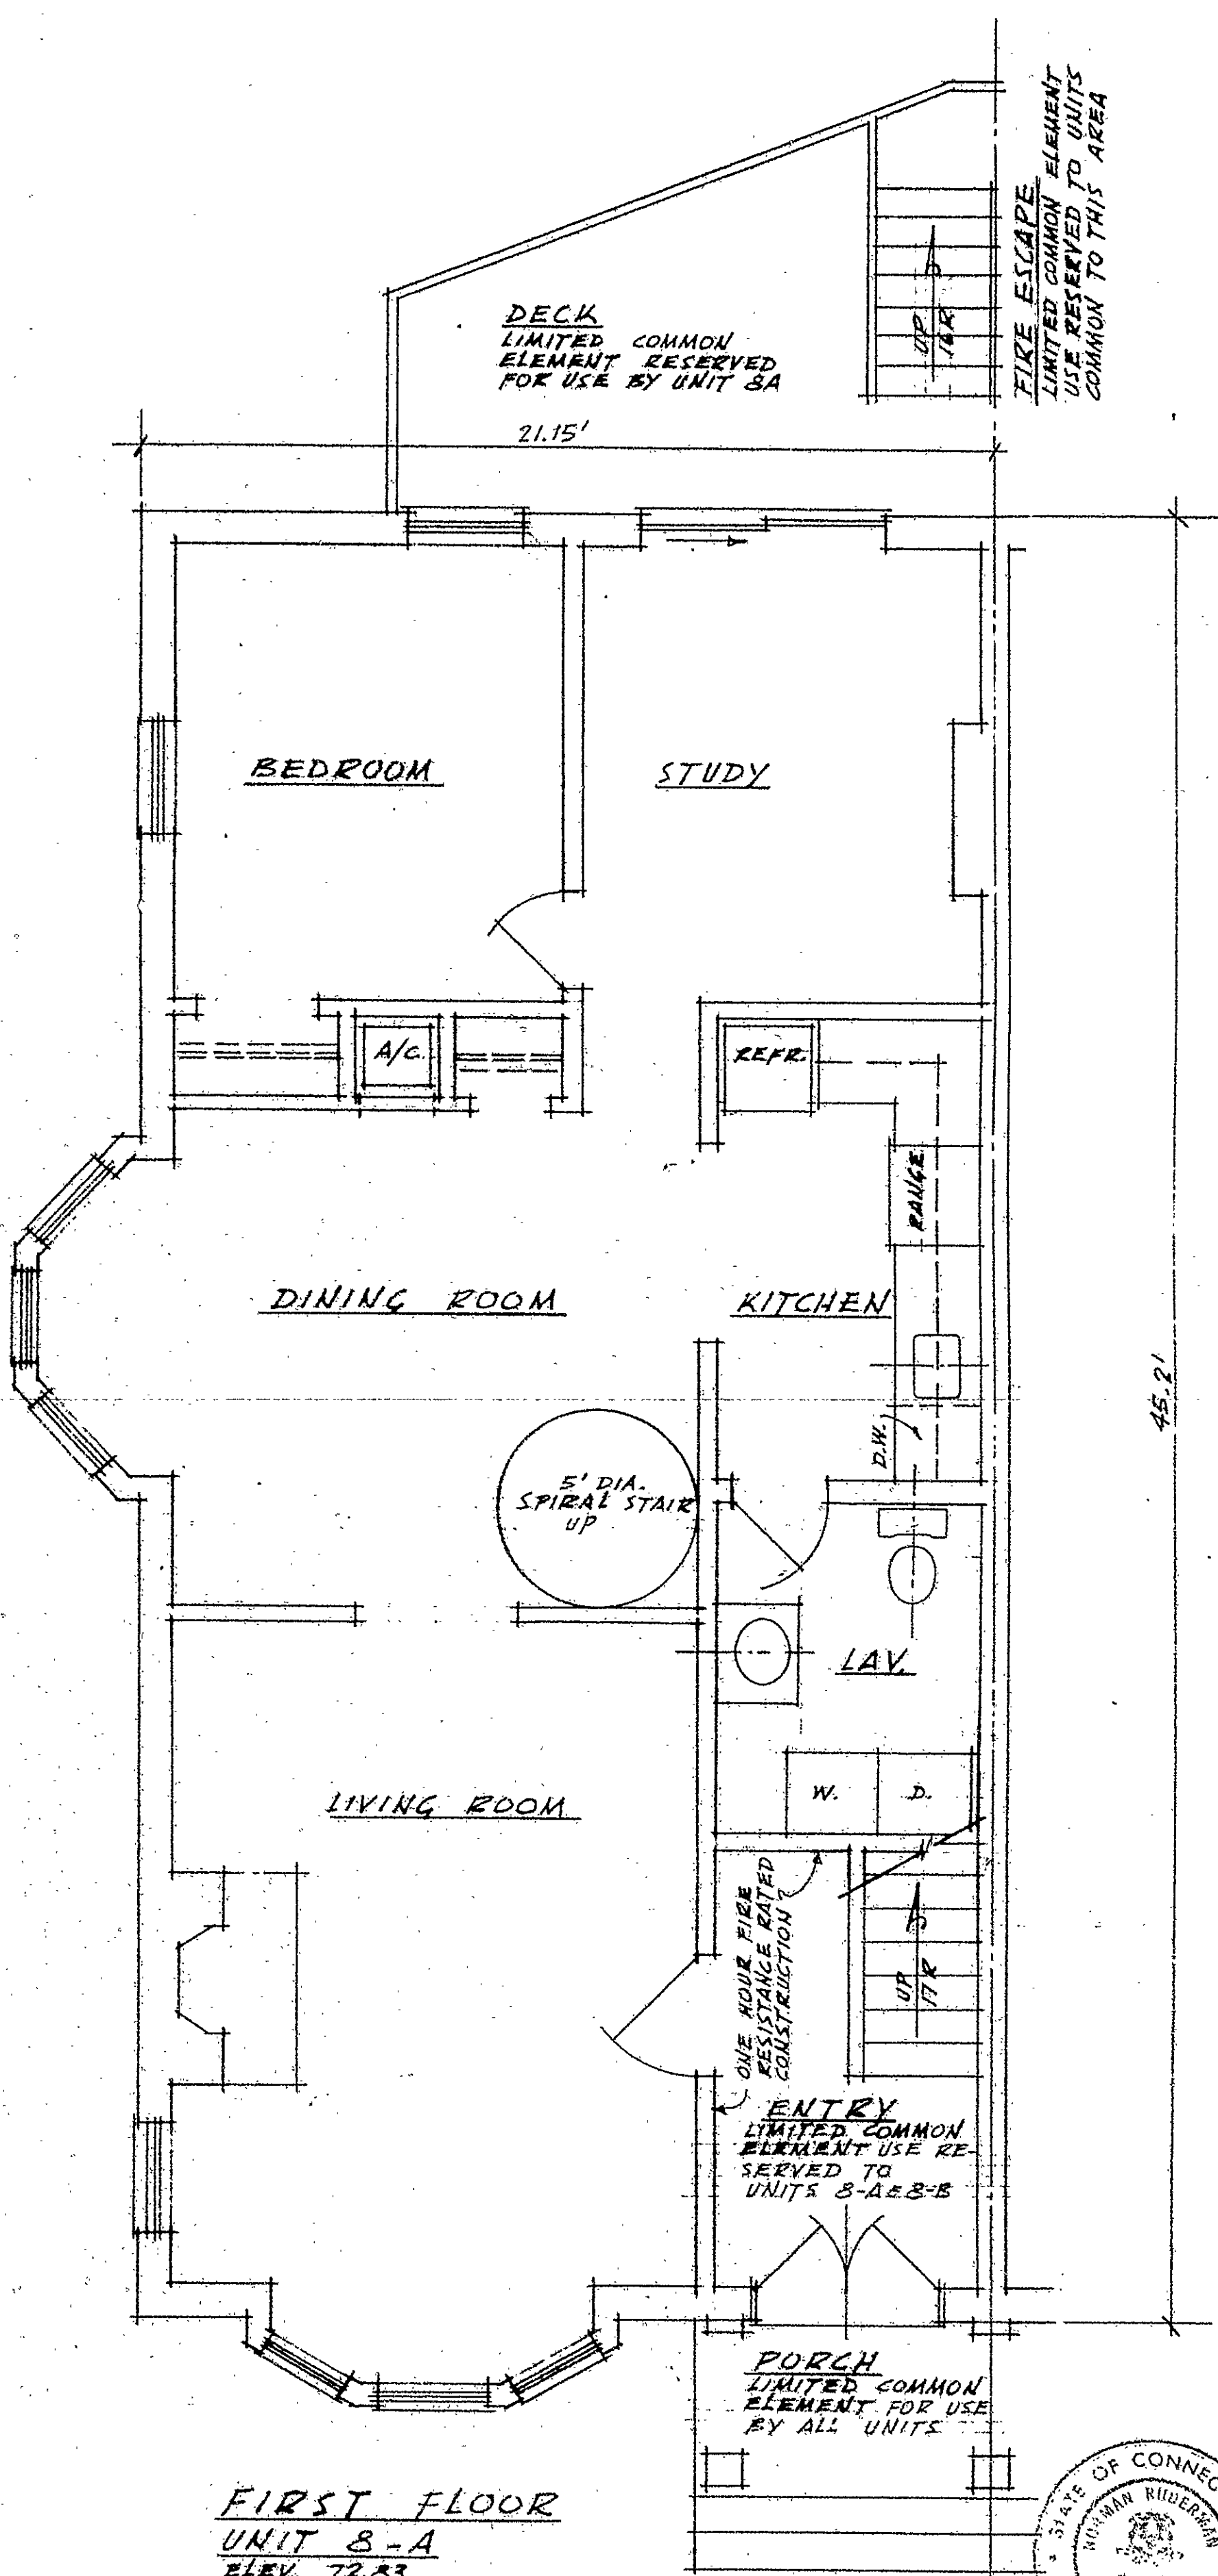

FIRST FLOOR
UNIT 8-A
ELEV. 72.83

NOTE
DIMENSIONS & ELEVATIONS TAKEN
FROM SURVEY BY CLOSE, JENSEN & MILLER

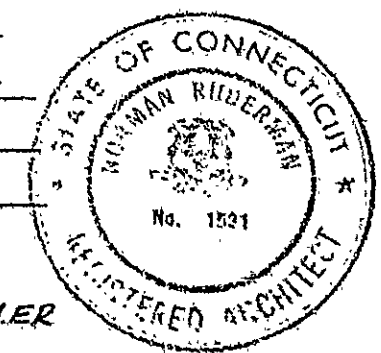

UNIT FLOOR PLANS
SUBMITTED TO THE DEPARTMENT OF CONSTRUCTION
BY JEFFREY J. JENSEN
DATED 11/13/79, RECORDED VOL. 127, PAGE 1
HARTFORD, LAND RECORDS

VERIFICATION
STATE OF CONN.
COUNTY OF HARTFORD
JULY 12, 1979
NORMAN RUDERMAN, AIA
ARCHITECT
880 ASYLUM AVENUE
HARTFORD, CT 06105

ATWOOD AT TOWNLEY
AN EXPANDABLE CONDOMINIUM
615 ATWOOD STREET
HARTFORD, CONN.

DWG. NO. A-2
12 NOV. 79

Condo Floor Plan #1

