


SITE PLAN

2 FRASER PLACE
HARTFORD, CONNECTICUT


MAY 1980

RECEIVED BY
Robert J. Sullivan
JUN 11 11 04 AM '80
TOWN & CITY CLERK
HARTFORD
VOL. _____ PAGE _____
436011

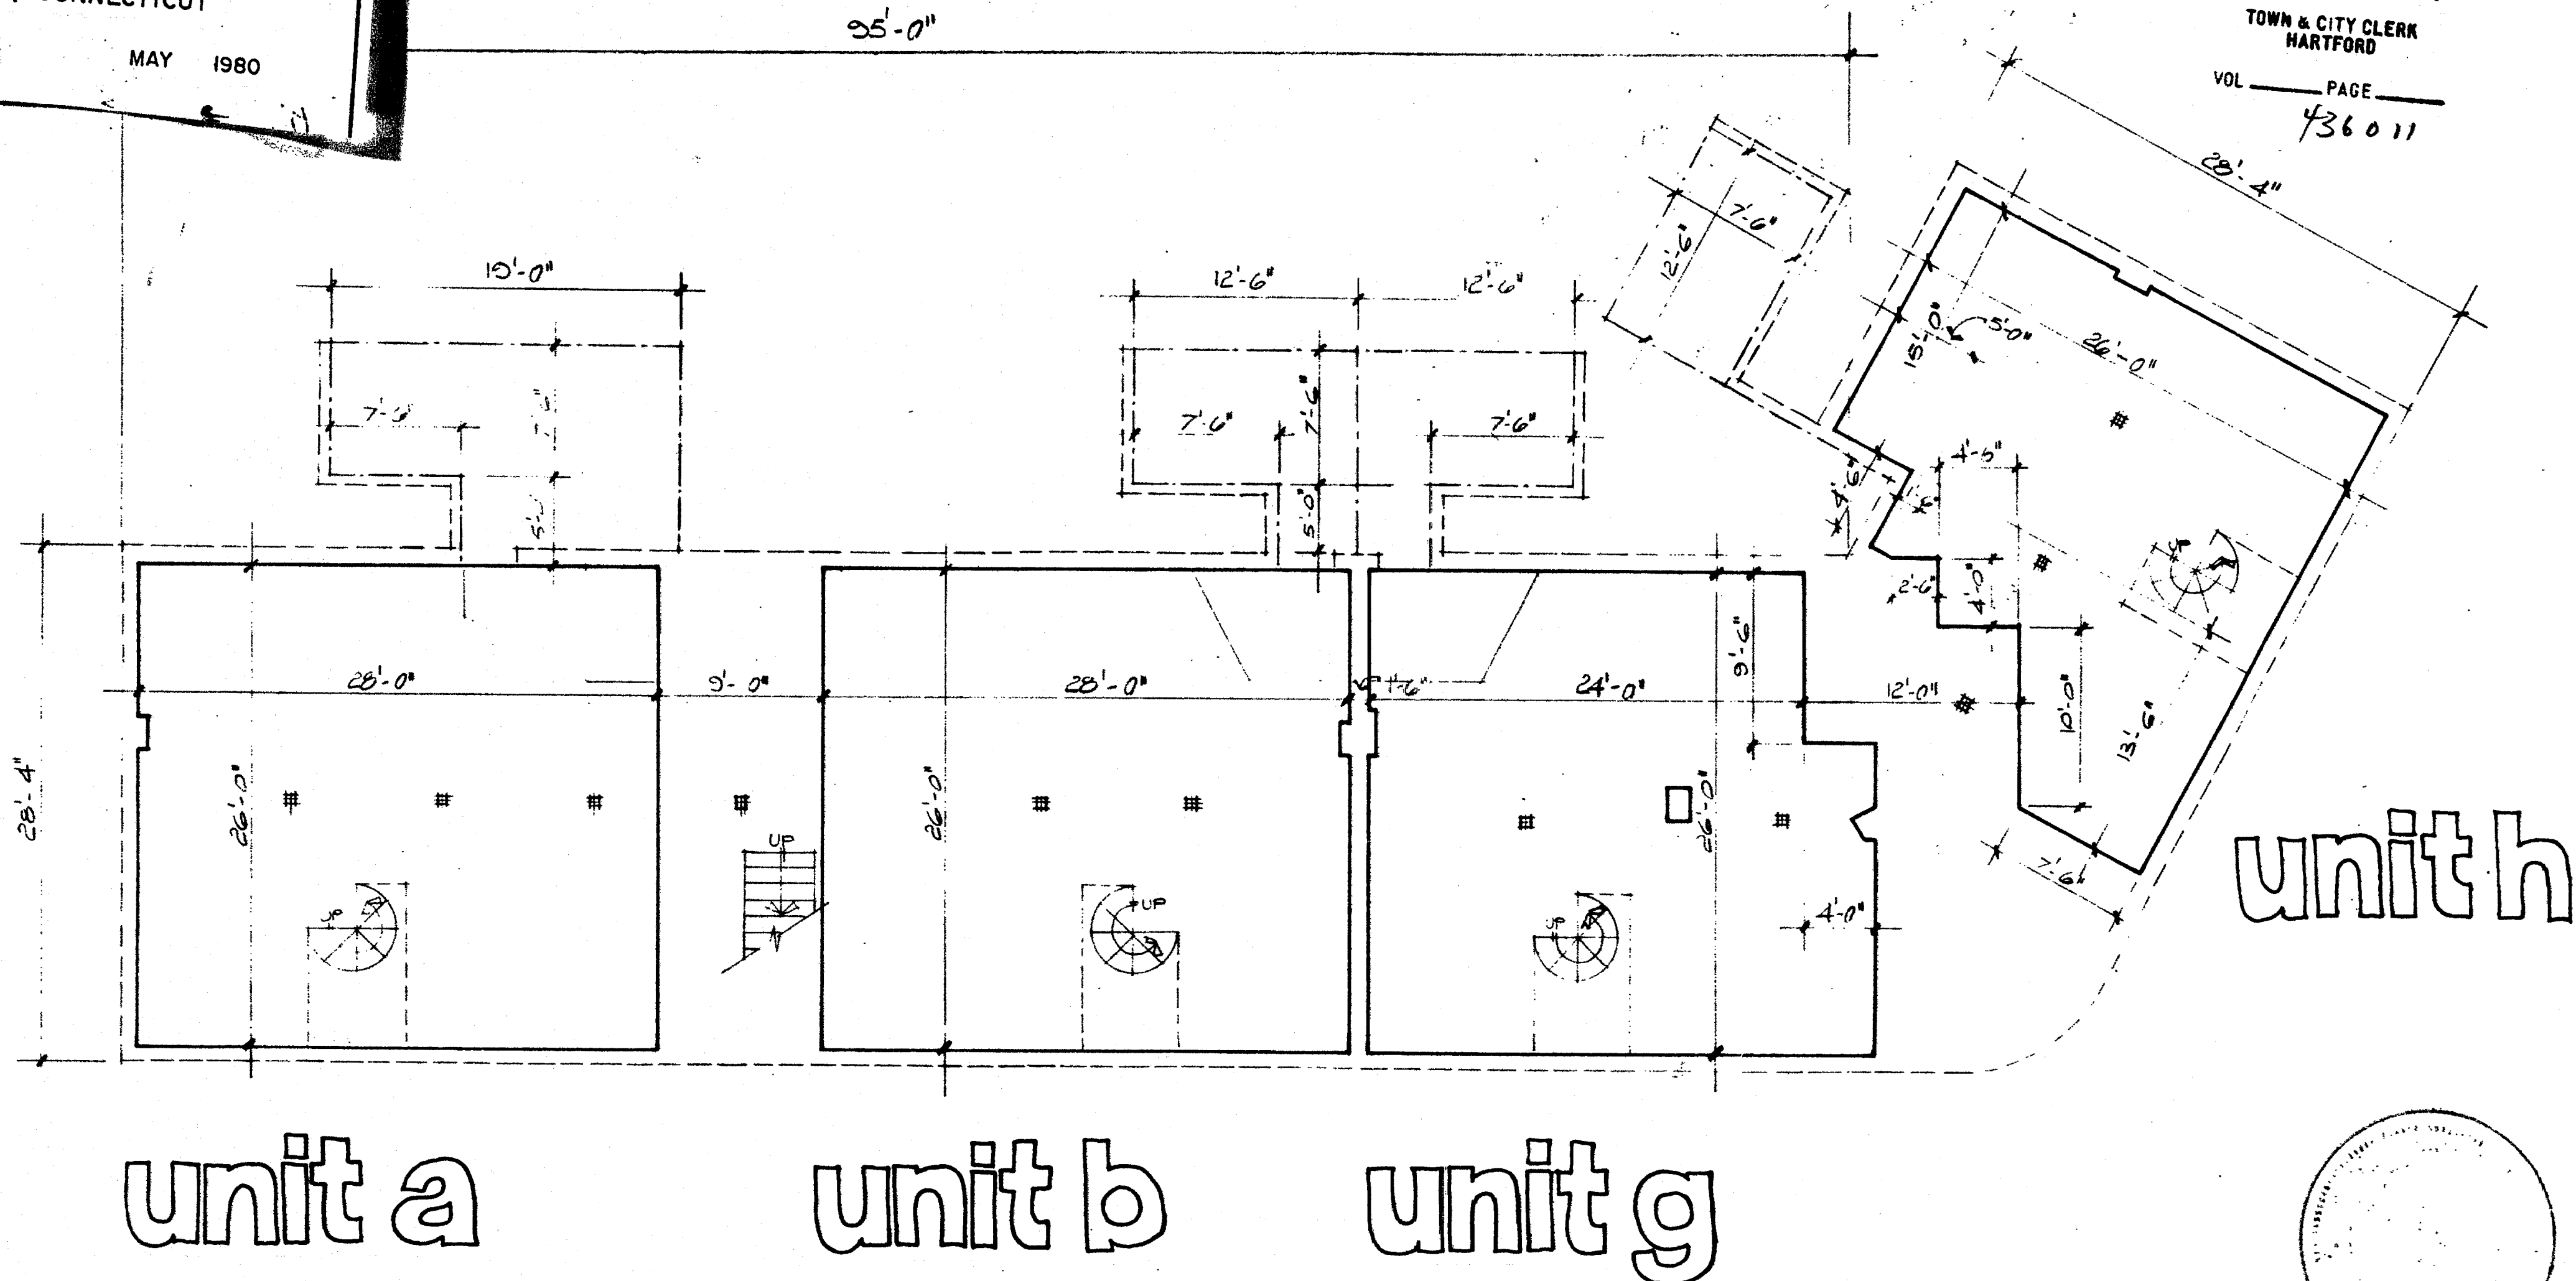


unit a

unit b


unit g

unit h

* NOTE:
ELEVATION BASED ON M.D.C. DATUM

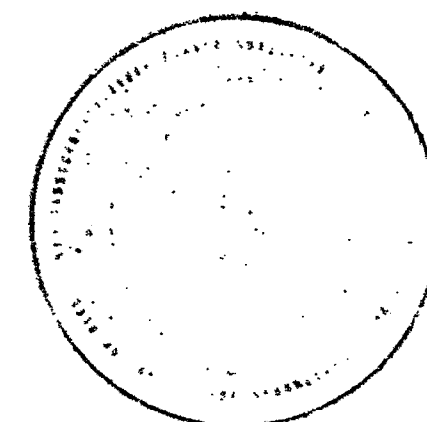

SHEET 1 OF 4

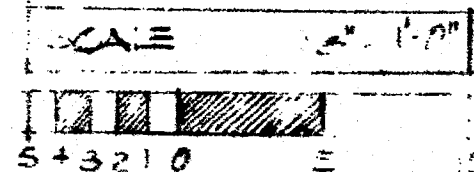

LEGEND :

UNIT BOUNDARY
COMMON ELEMENT IMPROVEMENT BOUNDARY
LIMITED COMMON ELEMENT BOUNDARY
BOTTOM OF ELEVATION FINISH FLOOR ELEVATION
ELEV. 83'-0" 74'-6"

lower level ground fl.

Certified to be an accurate copy
of portions of the plans on file with
the City of Hartford, Connecticut
Department of Licenses and Inspections.

Hans Lohse - Architect
Dated MAY 29, 80

VERIFICATION
State of Conn.) ss: 90119, 1980
County of Hartford)
Personally appeared Hans Lohse, duly sworn
who made oath of the truth of the statement
to which his signature appears.
Commissioner of the Superior Court

