


RECEIVED BY
Robert J. Ballin

JUN 11 11 04 AM '80

TOWN & CITY CLERK
HARTFORD

VOL. — PAGE —
436 & 11

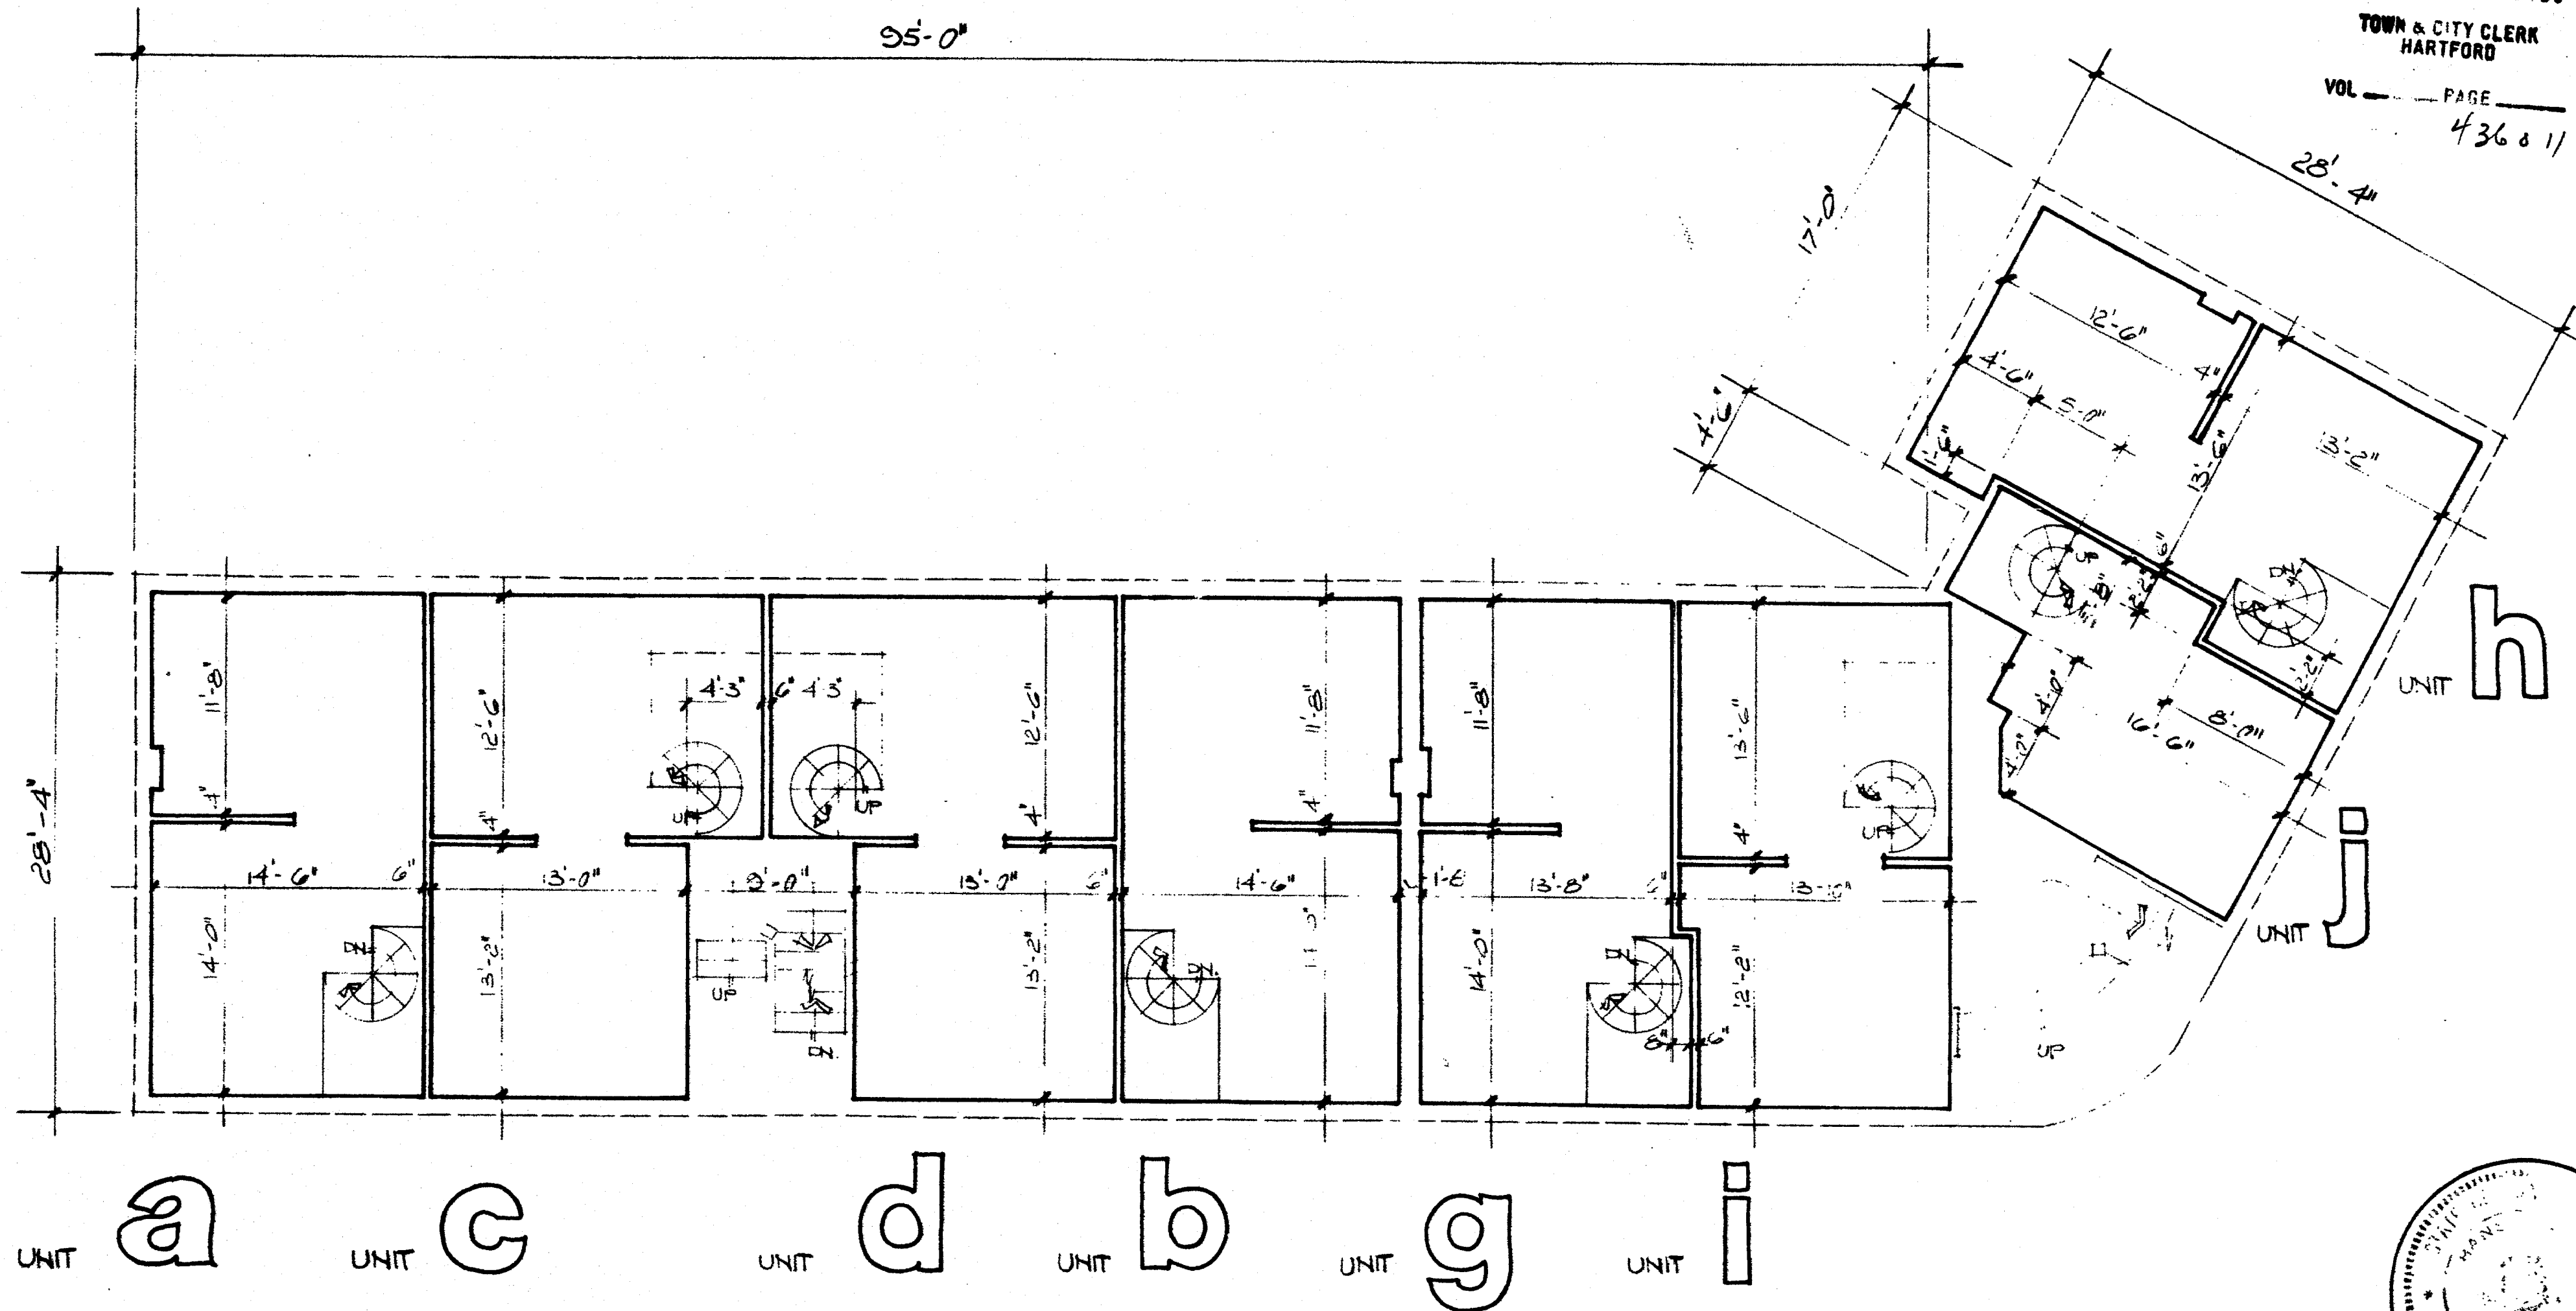

* NOTE :
ELEVATION BASED ON M.D.C. DATUM

REVISED MAY 15 '80 SHEET 2 OF 4

SCALE 1/8" = 1'-0"
543210 5 10

LEGEND :
—— UNIT BOUNDARY
--- COMMON ELEMENT IMPROVEMENT BOUNDARY
- - - LIMITED COMMON ELEMENT BOUNDARY
- - - - - BOTTOM OF CEILING FINISH FLOOR ELEVATION
ELEV. 93'-0" 84'-0"

upper level ground fl.

Certified to be an accurate copy
of portions of the plans on file with
the City of Hartford, Connecticut
Department of Licenses and Inspections.

Hans Lohse - Architect
Dated MAY 22 '80

State of Conn.) ss: *[Signature]* 1979
County of Hartford)
Personally appeared Hans Lohse, duly sworn
who made oath of the truth of the statement
to which his signature appears.
Commissioner of the Superior Court

