


RECEIVED BY
Robert J. Ballerina

JUN 11 11 04 AM '80

TOWN & CITY CLERK
HARTFORD

VOL _____ PAGE _____
436011

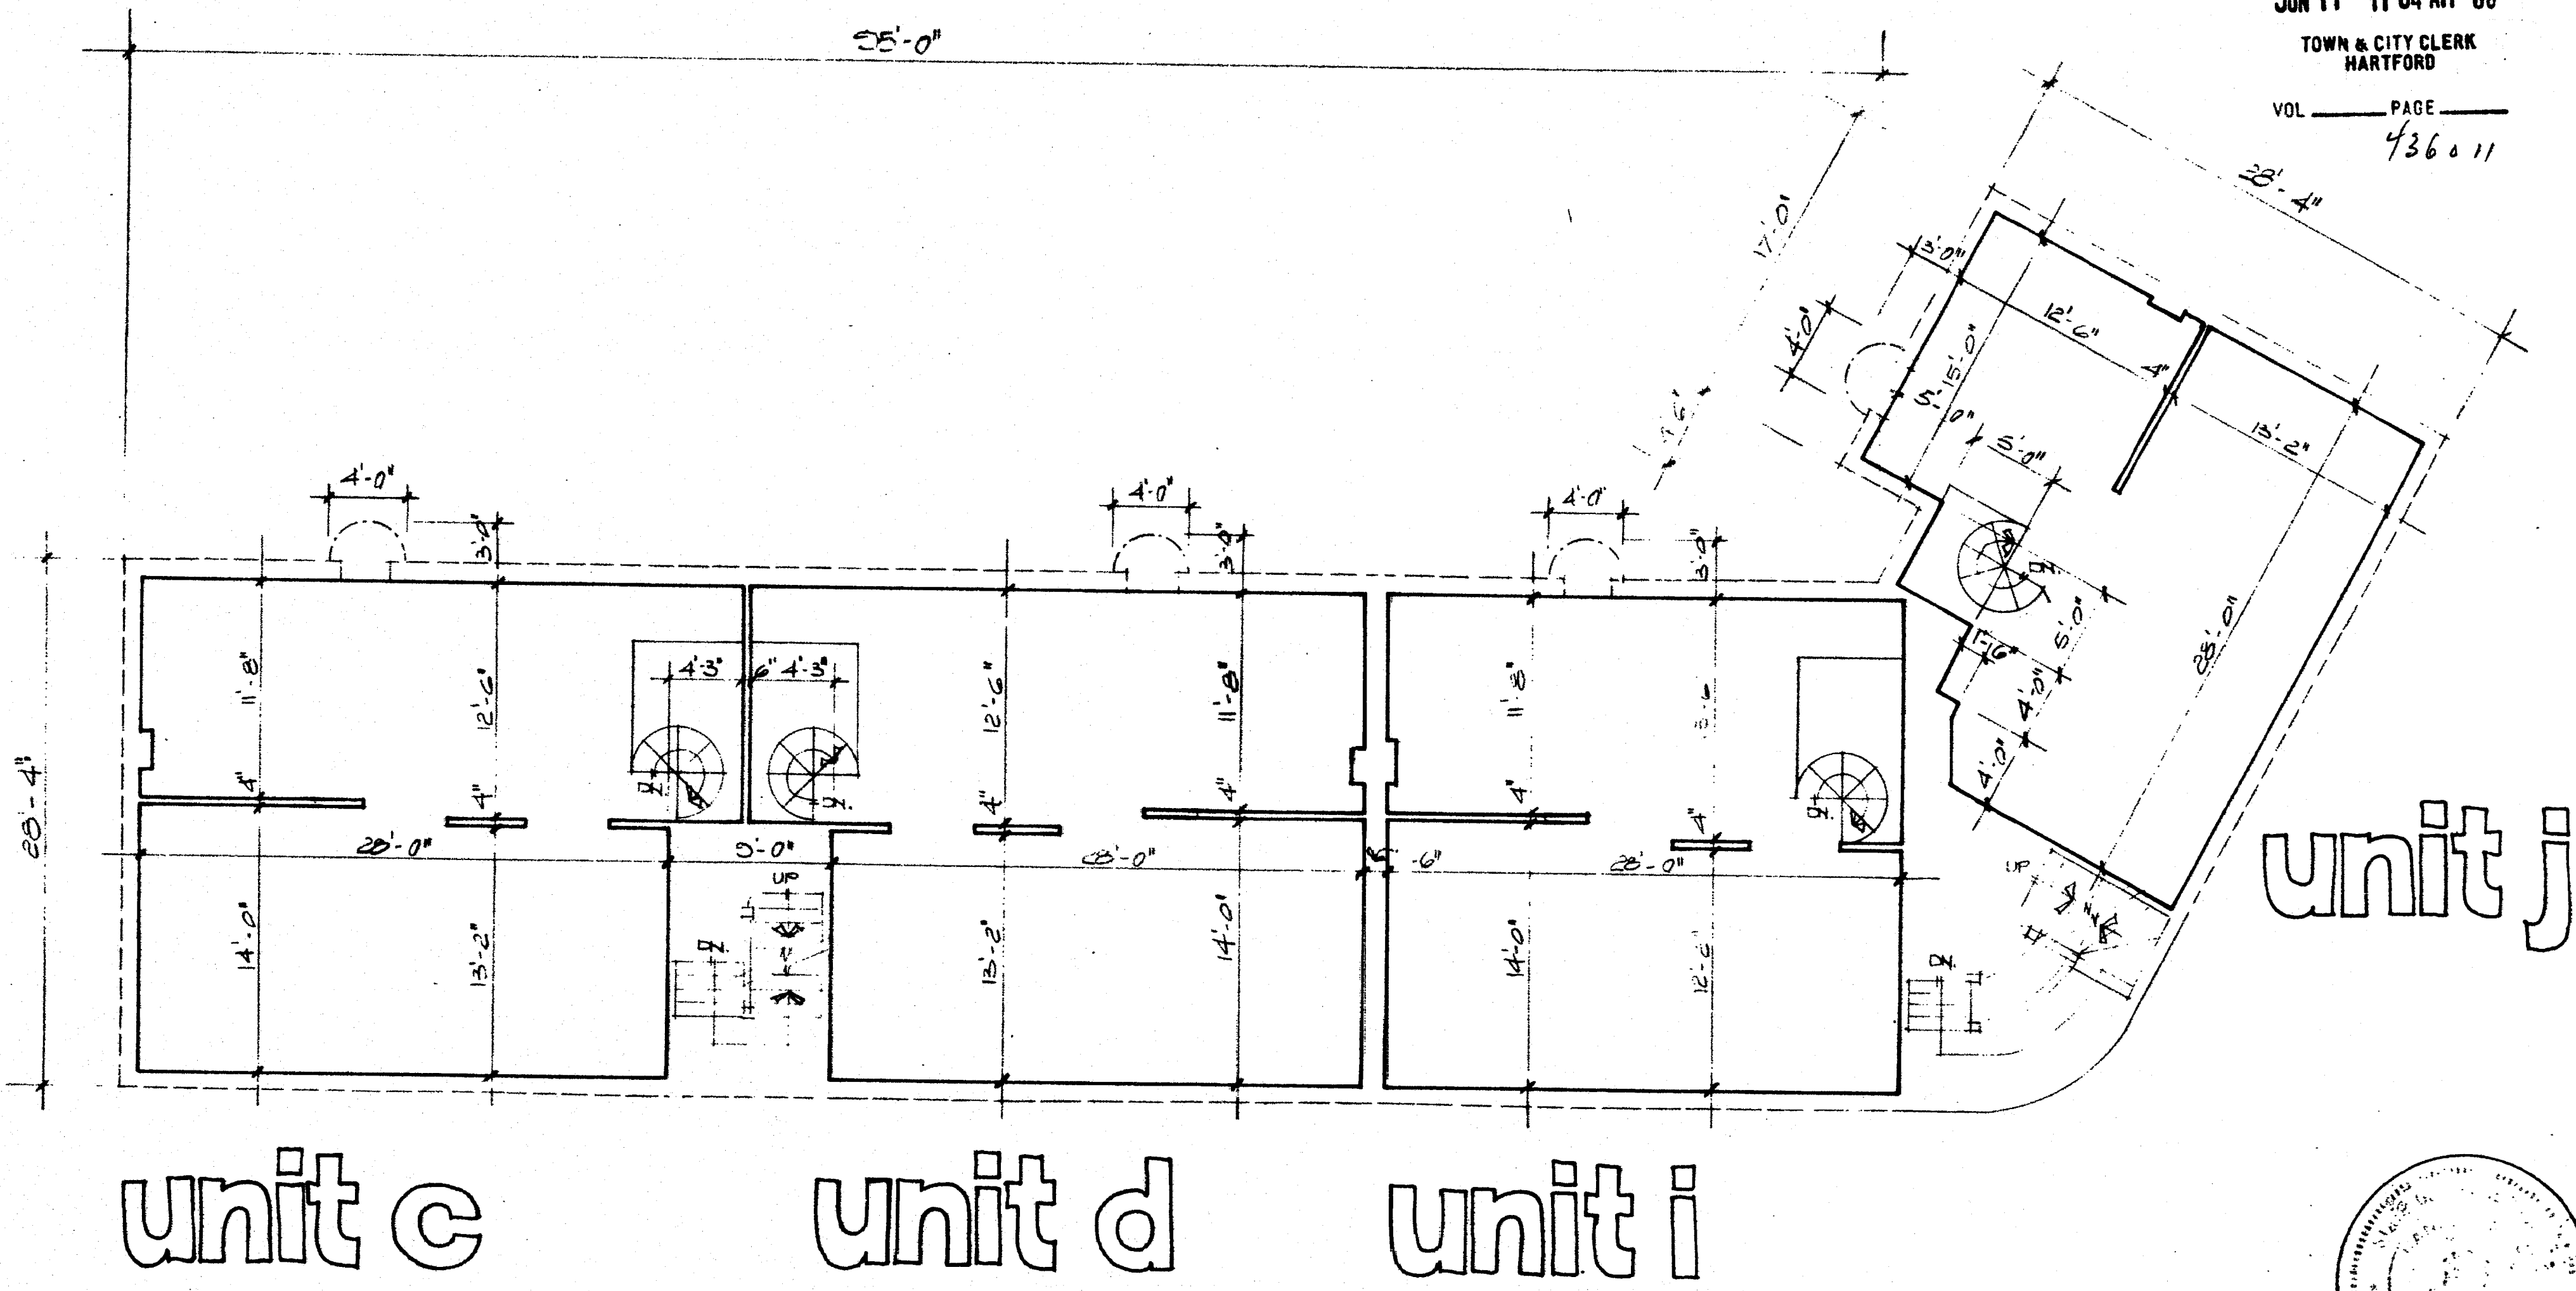


unit c

unit d

unit i

unit j

* NOTE :
ELEVATION BASED ON M.D.C. DATUM

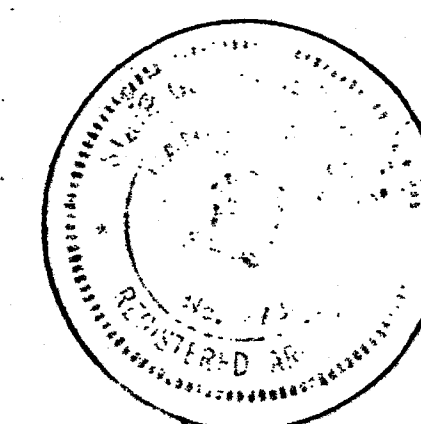

SHEET 3 OF 4

SCALE 1/8" = 1'-0"
543210 5 10

LEGEND :
—— UNIT BOUNDARY
--- COMMON ELEMENT IMPROVEMENT BOUNDARY
- - - LIMITED COMMON ELEMENT BOUNDARY

first floor

BOTTOM OF CEILING
ELEV. 103'-0"
FINISH FLOOR ELEVATION
54'-0"

Certified to be an accurate copy
of portions of the plans on file with
the City of Hartford, Connecticut
Department of Licenses and Inspections.

Hans Lohse - Architect
Dated MAY 23, 1980

CERTIFICATION
I, Hans Lohse, Registered Architect, No. 13, State of Connecticut, do hereby certify that I am the author of the plans and specifications herein and that I am a duly sworn and qualified person to make such a statement to which his signature appears.
Commissioner of the Superior Court

