


8

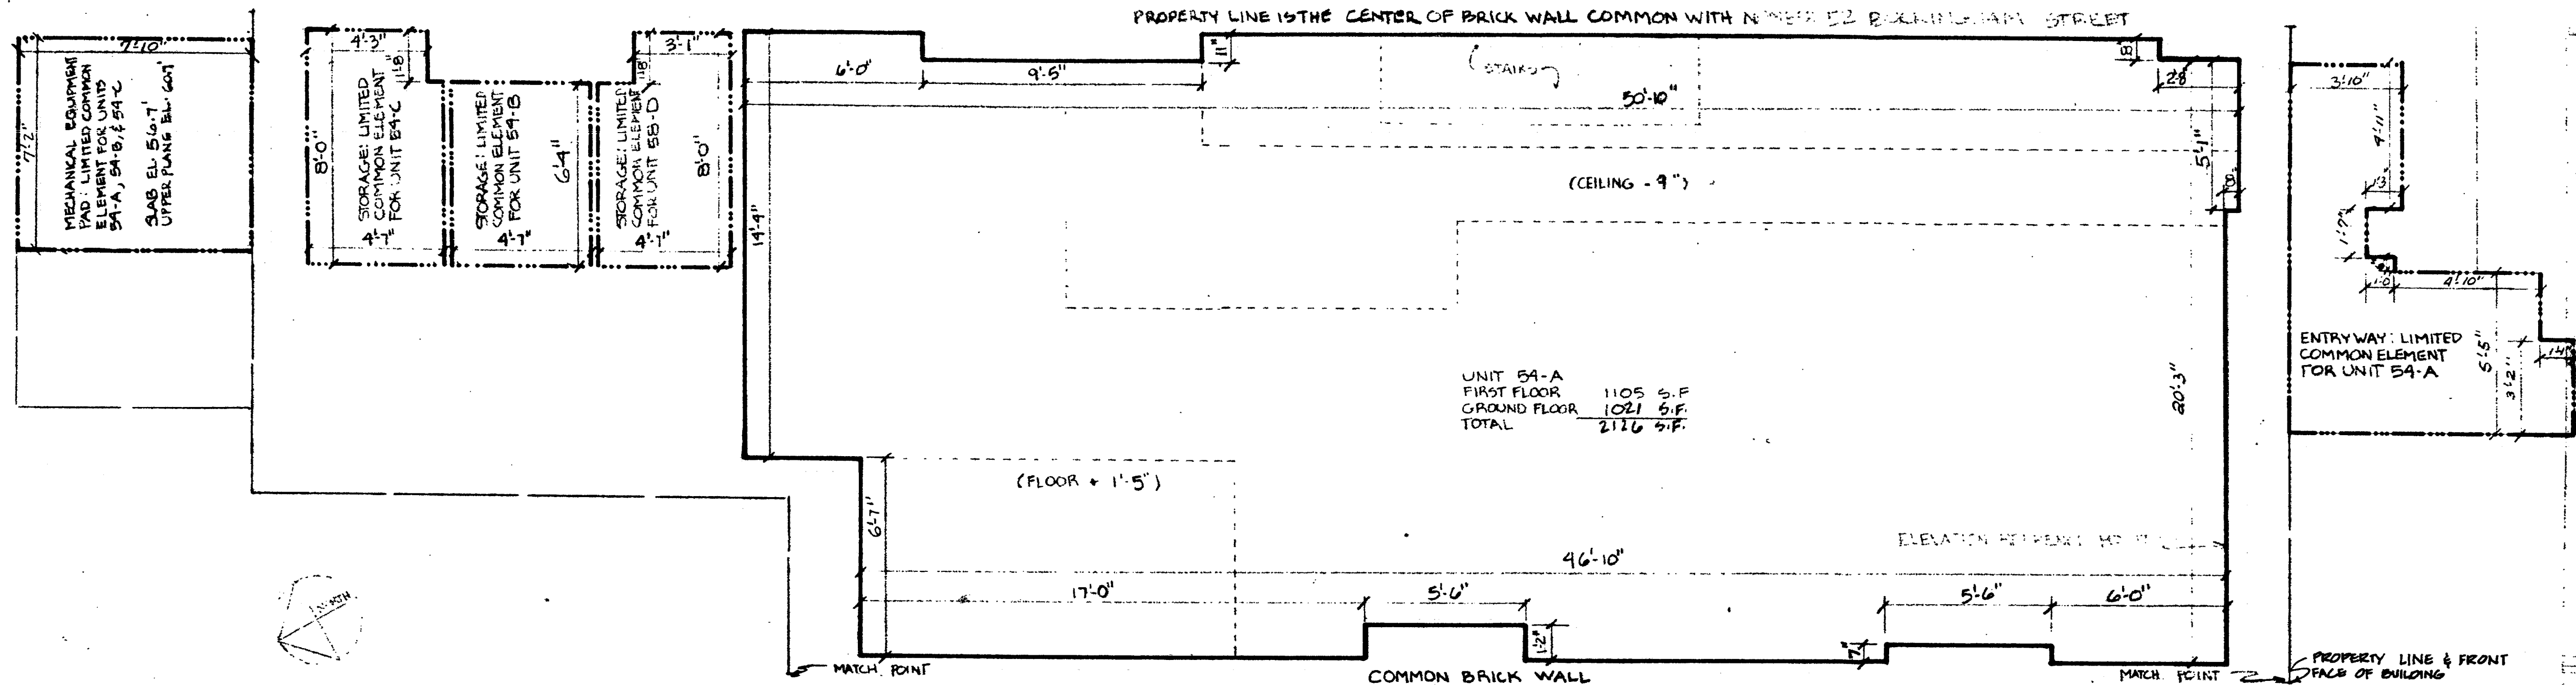

BUCKINGHAM CONDOMINIUM

UNIT 54 A

ground floor

GROUND & FIRST FLOORS 54 BUCKINGHAM STREET

COND FLOOR PLAN # 8

- EXTERIOR WALL OF BUILDING
- UNIT BOUNDARY
- LIMITED COMMON ELEMENT BOUNDARY
- CEILING OR FLOOR ELEVATION CHANGE

I HEREBY CERTIFY THAT THESE PLANS ARE AN ACCURATE COPY OF THAT PORTION OF THE PLANS FILED WITH THE BUILDING OFFICIAL OF THE STATE OF CONNECTICUT PURSUANT TO SECTION 19-396 OF THE CONNECTICUT GENERAL STATUTES, REVISED 1985, AS AMENDED.

JOHN L. DOLLARD
REGISTERED ARCHITECT

SUBSCRIBED AND SWORN TO BEFORE ME THIS 10th DAY OF NOVEMBER 1979

NOTARY PUBLIC MY COMMISSION EXPIRES 2/1/84

