


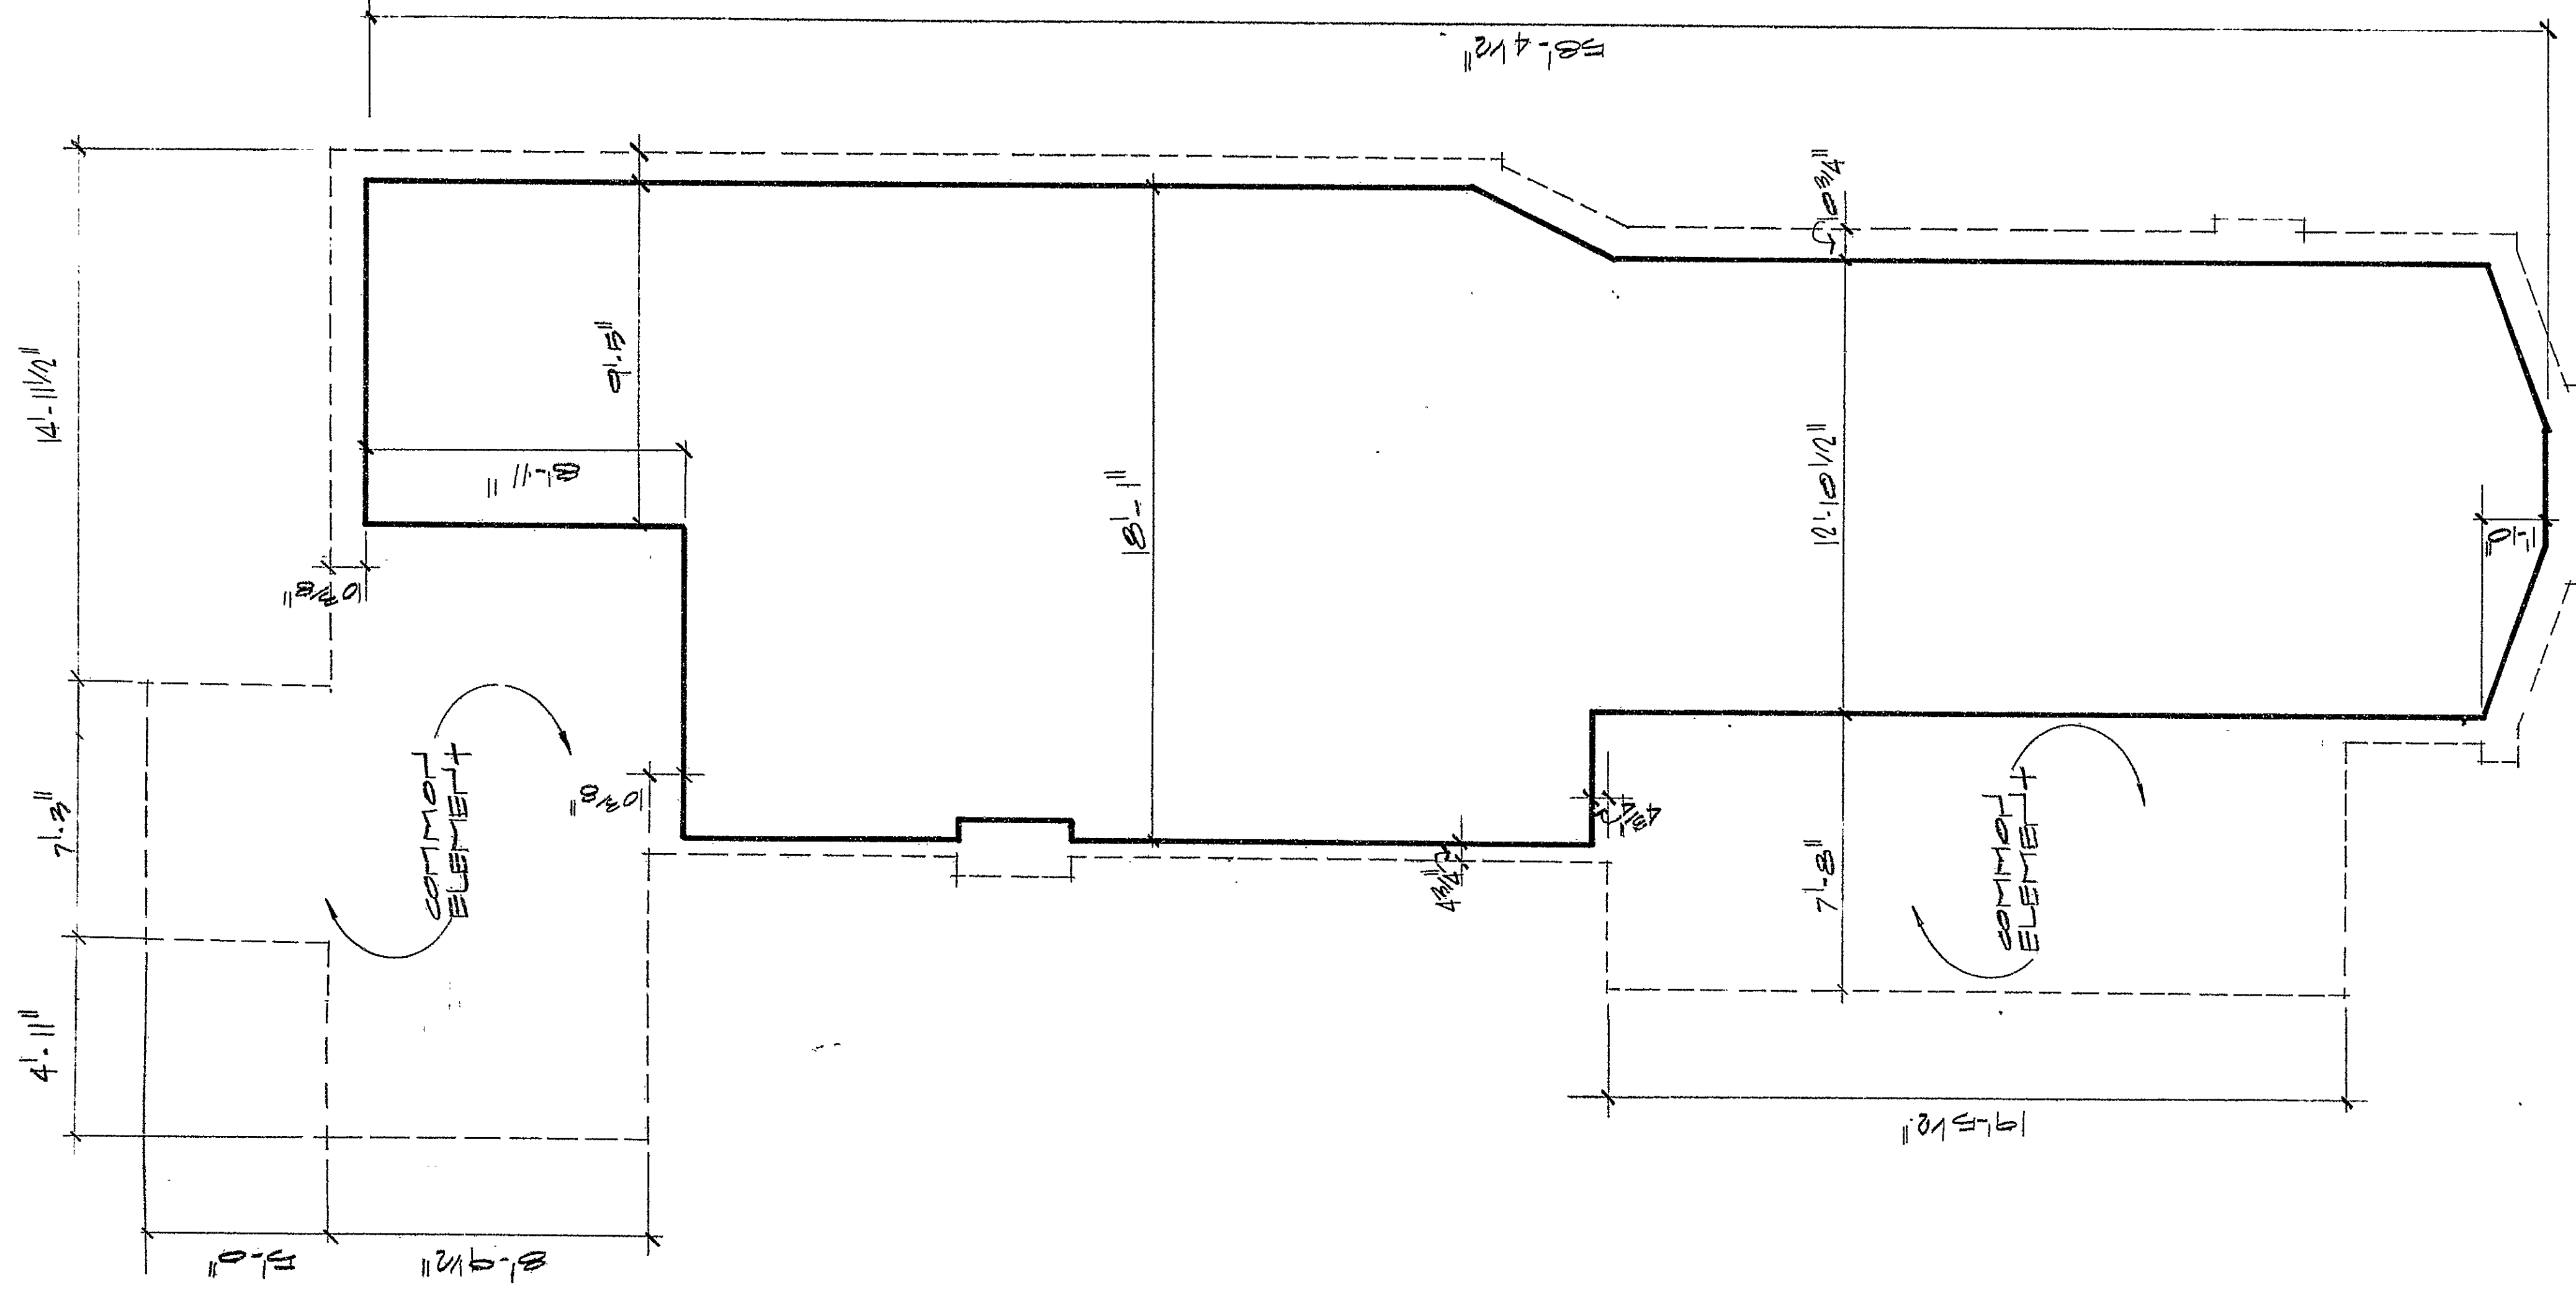

FIRST FLOOR PLAN
BUILDING NO. 356 - 358

RECEIVED
JUN 4 11 30 AM '74
TO: [illegible]
[illegible]
VOL _____ PAGE _____

Corrado Zlotnicki #19

CERTIFIED TO BE AN ACCURATE COPY
 OF PORTIONS OF THE PLANS ON FILE
 WITH THE CITY OF HARTFORD
 DEPARTMENT OF LICENSING AND INSPECTION.

Americo Mallozzi
 AMERICO MALLOZZI
 DATE: 07-29-02 *Architect*

VERIFICATION

STATE OF CONNECTICUT
COUNTY OF HARTFORD ss:
HARTFORD, CONNECTICUT Sept. 28, 1982
PERSONALLY APPEARED AMERICO MALLOZZI
WHO HAS SOLEMNLY AFFIRMED TO THE
TRUTH OF THE STATEMENT TO WHICH

Commissioner of the Superior Court

 $\frac{4}{9}$

FLOOR HEIGHT

WOODLAND ELEVEN CONDOMINIUMS
WOODLAND AVENUE
HARTFORD, CONNECTICUT

UNIT (S) - 101A
B

258

SQUARE FOOTAGE

KEY

INTERIOR BOUNDARIES —————

EXTERIOR CONDITIONS - - - - -

4

NO. OF ROOMS

3 OF 7 SHEETS