


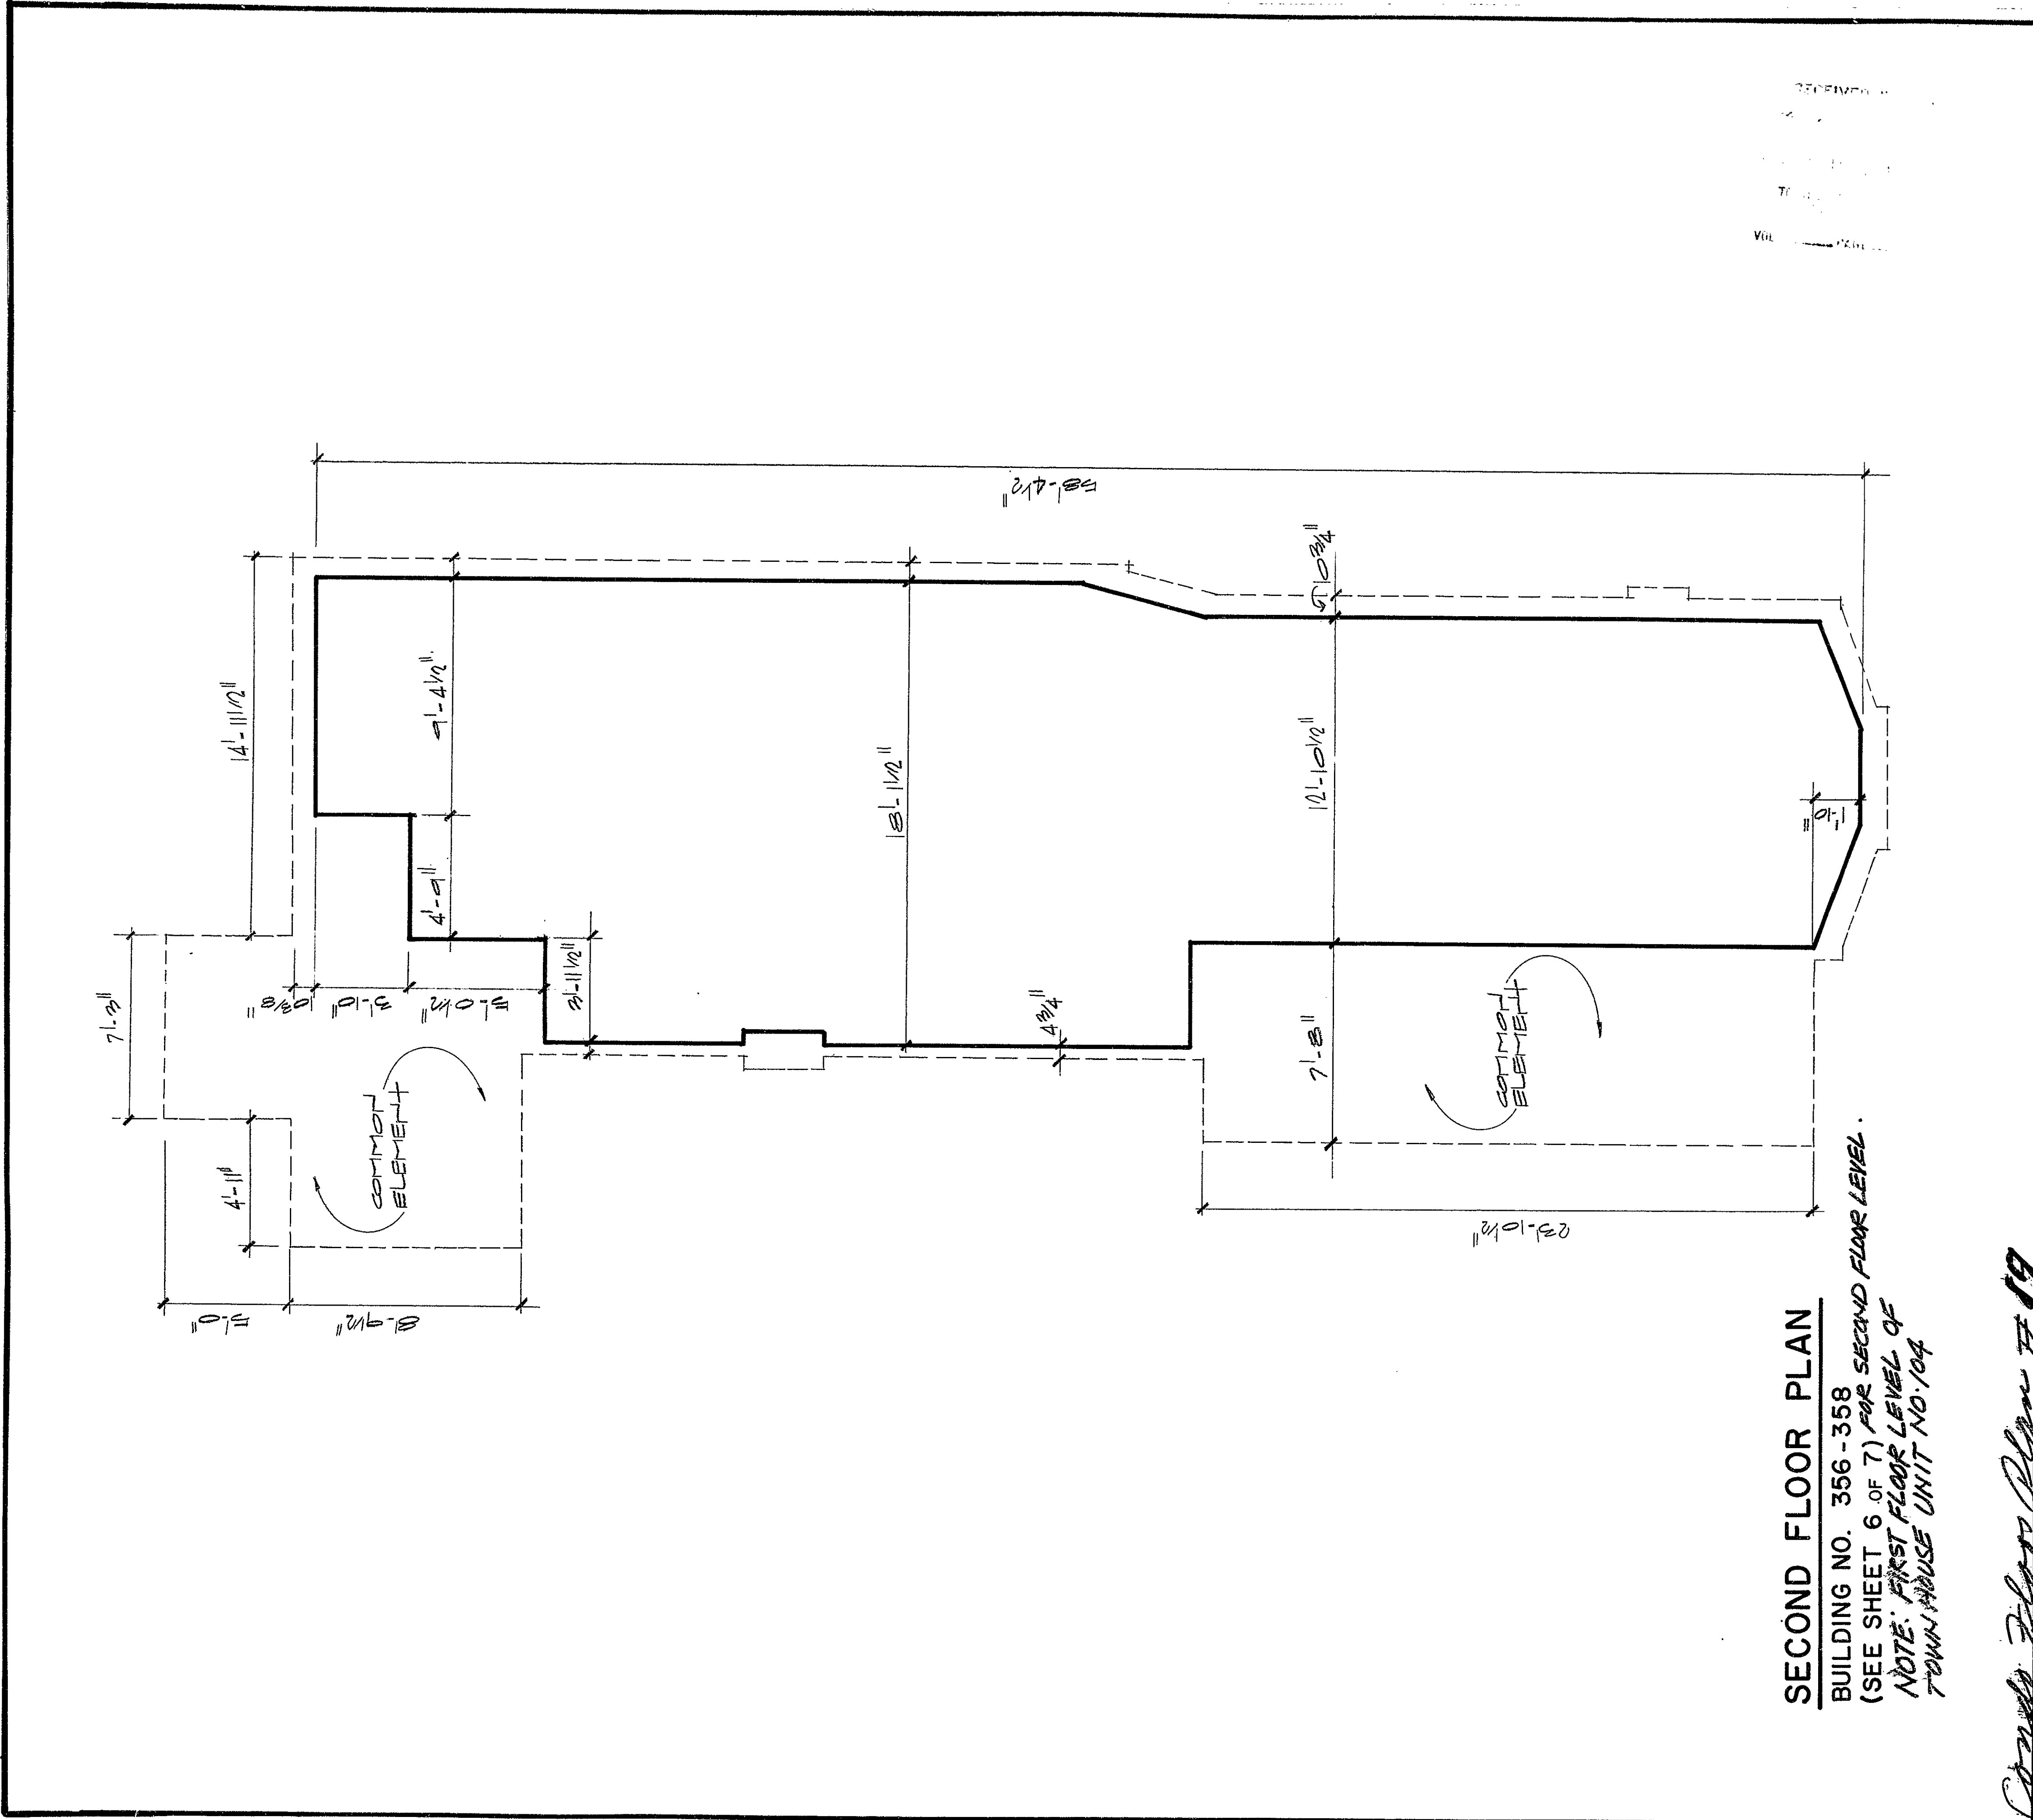

WOODLAND ELEVEN CONDOMINIUMS WOODLAND AVENUE HARTFORD, CONNECTICUT		UNIT(S) - 104		C	
PROJECT		NO. OF ROOMS		SHEETS	
9'-5"		6		5 OF 7	
FLOOR HEIGHT		KEY			
SEC. FL. 882		INTERIOR BOUNDARIES			
THIRD FL. 486		EXTERIOR CONDITIONS			
TOTAL 1368		SCALE			
10'		1' 2' 3' 4' 5'			
SQUARE FOOTAGE					
SEC. FL. 882					
THIRD FL. 486					
TOTAL 1368					
VERIFICATION					
STATE OF CONNECTICUT					
COUNTY OF HARTFORD					
HARTFORD, CONNECTICUT					
PERSONALLY APPEARED AMERICO MALLOZZI					
WHO HAS SOLEMNLY AFFIRMED TO THE					
TRUTH OF THE STATEMENT TO WHICH					
HIS NAME IS SUBSCRIBED.					
COMMISSIONER OF THE SUPERIOR COURT					