


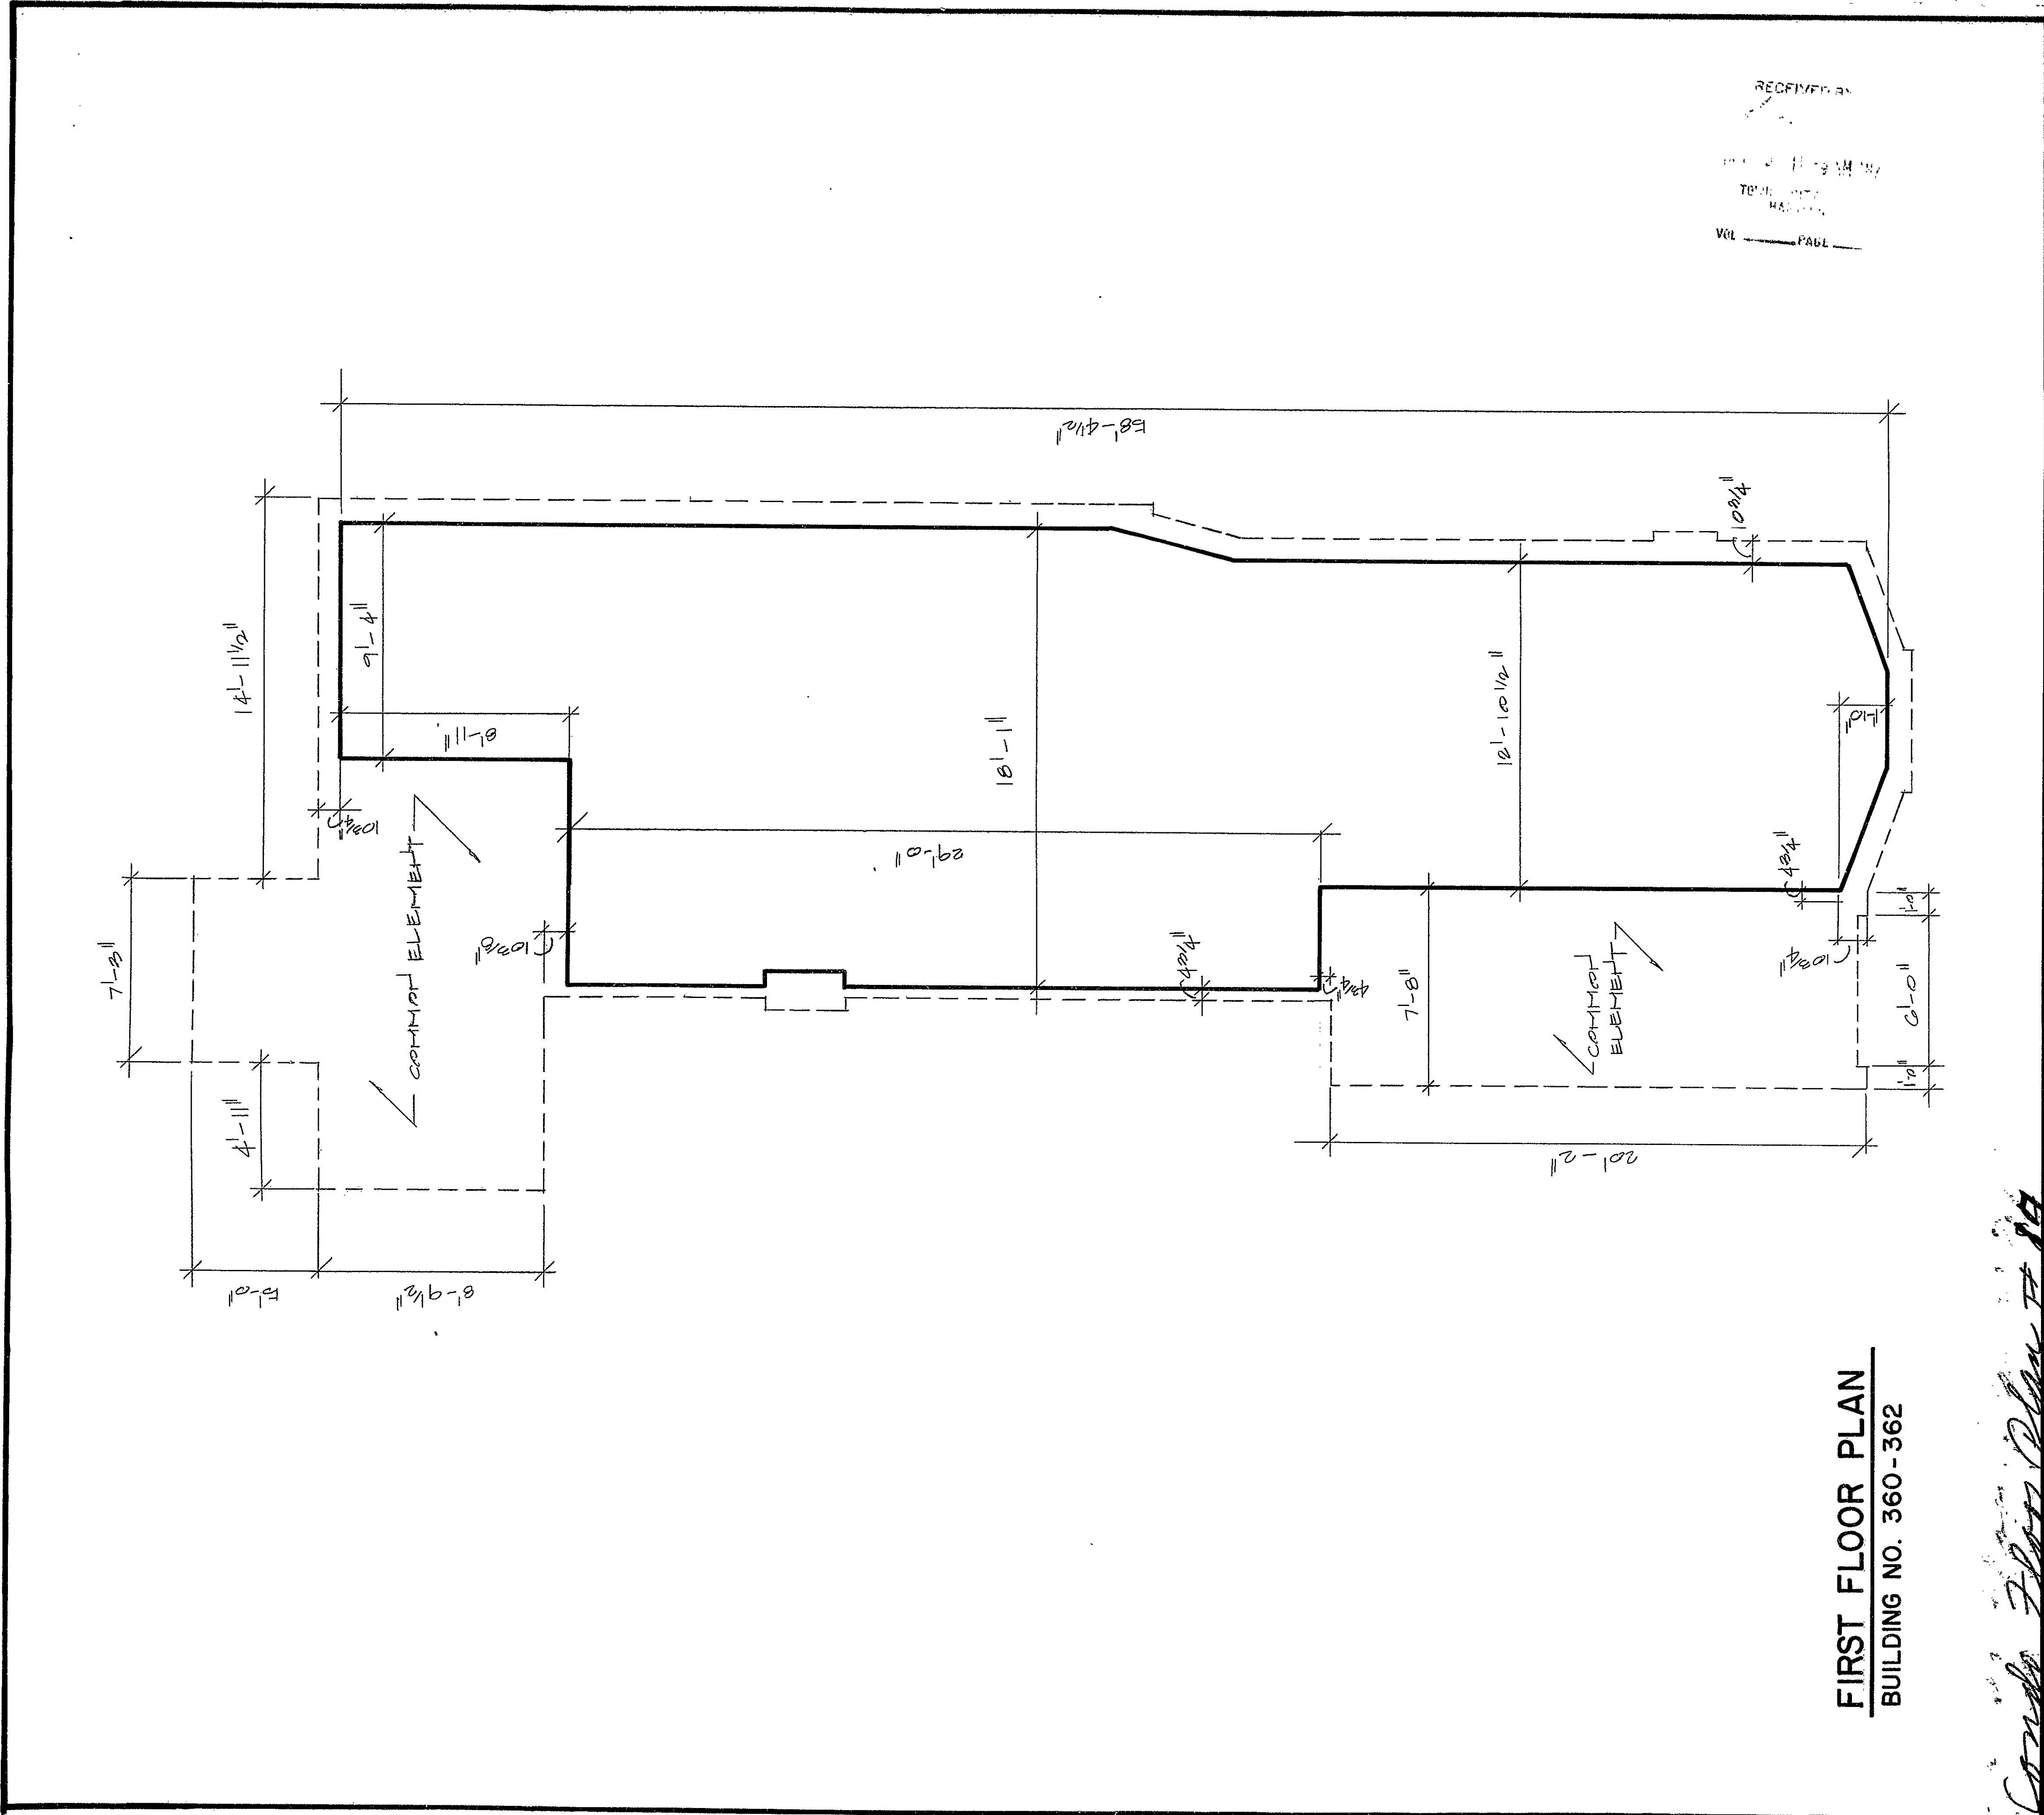

CERTIFIED TO BE AN ACCURATE COPY OF PORTIONS OF THE PLANS ON FILE WITH THE CITY OF HARTFORD DEPARTMENT OF LICENSING AND INSPECTION. Americo Mallozzi AMERICOMALLOZZI ARCHITECT DATE: 6/15/82		VERIFICATION STATE OF CONNECTICUT COUNTY OF HARTFORD HARTFORD, CONNECTICUT SEP. 28, 1982. PERSONALLY APPEARED AMERICOMALLOZZI WHO HAS SOLEMNLY AFFIRMED TO THE TRUTH OF THE STATEMENT TO WHICH HIS NAME IS SUBSCRIBED. <i>[Signature]</i> COMMISSIONER OF THE SUPERIOR COURT	
9'-4"	FLOOR HEIGHT	857	SQUARE FOOTAGE
1' 2" 3' 4" 5'	SCALE	10'	KEY
PROJECT WOODLAND ELEVEN CONDOMINIUMS WOODLAND AVENUE HARTFORD, CONNECTICUT		NO. OF ROOMS 4	
UNIT(S) - 204		SHEETS 3 OF 7	
B			