


17

17-11

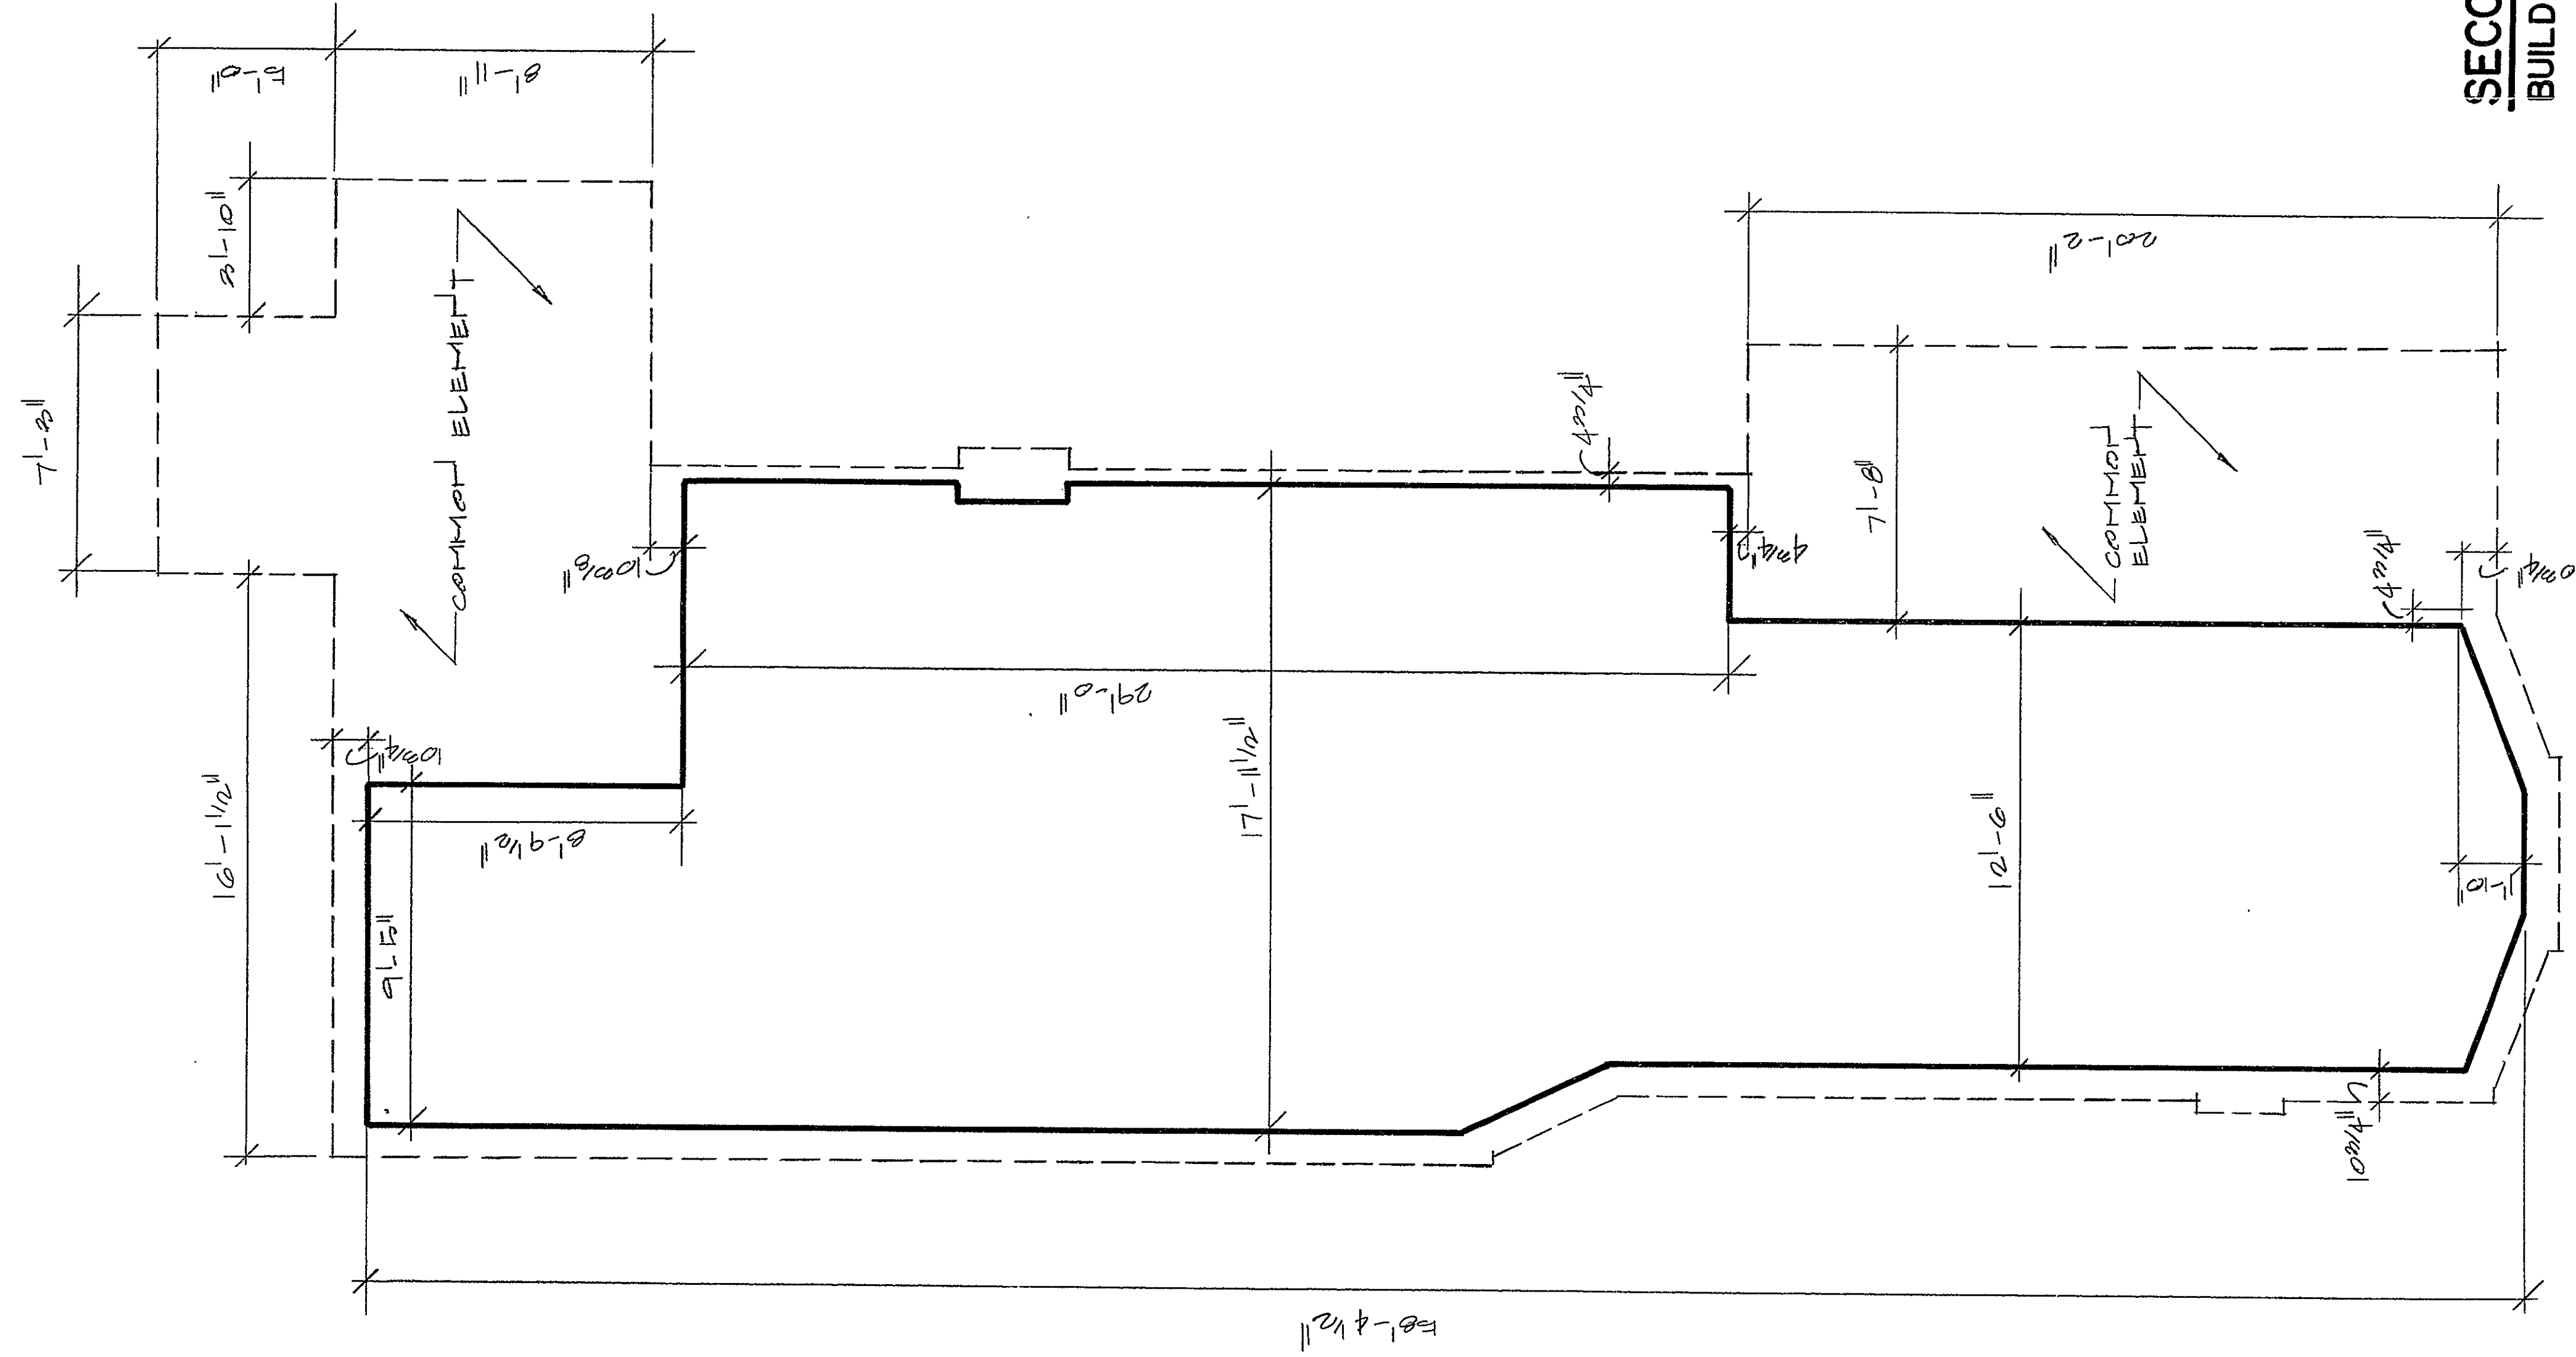

5-5-57

HEIGHT

5-9

SQUARE FOOTAGE

SCALE
1' 2' 3' 4' 5'

KEY

INTERIOR BOUNDARIES —————

EXTERIOR CONDITIONS - - - - -

NO. OF ROOMS

4 OF 7 SHEETS

WOODLAND ELEVEN CONDOMINIUMS
WOODLAND AVENUE
HARTFORD, CONNECTICUT

UNIT(S) - 202

△

CERTIFIED TO BE AN ACCURATE COPY
OF PORTIONS OF THE PLANS ON FILE
WITH THE CITY OF HARTFORD
DEPARTMENT OF LICENSING AND INSPECTION.

AMERICA MALLOZZI

DATE: 6/29/92 Wichita

VERIFICATION

STATE OF CONNECTICUT
COUNTY OF HARTFORD ss:
HARTFORD, CONNECTICUT *Sept. 28, 1982*
PERSONALLY APPEARED AMERICO MALLOZZI
WHO HAS SOLEMNLY AFFIRMED TO THE
TRUTH OF THE STATEMENT TO WHICH
HIS NAME IS SUBSCRIBED. *✓*

Commissioner of the Superior Court