


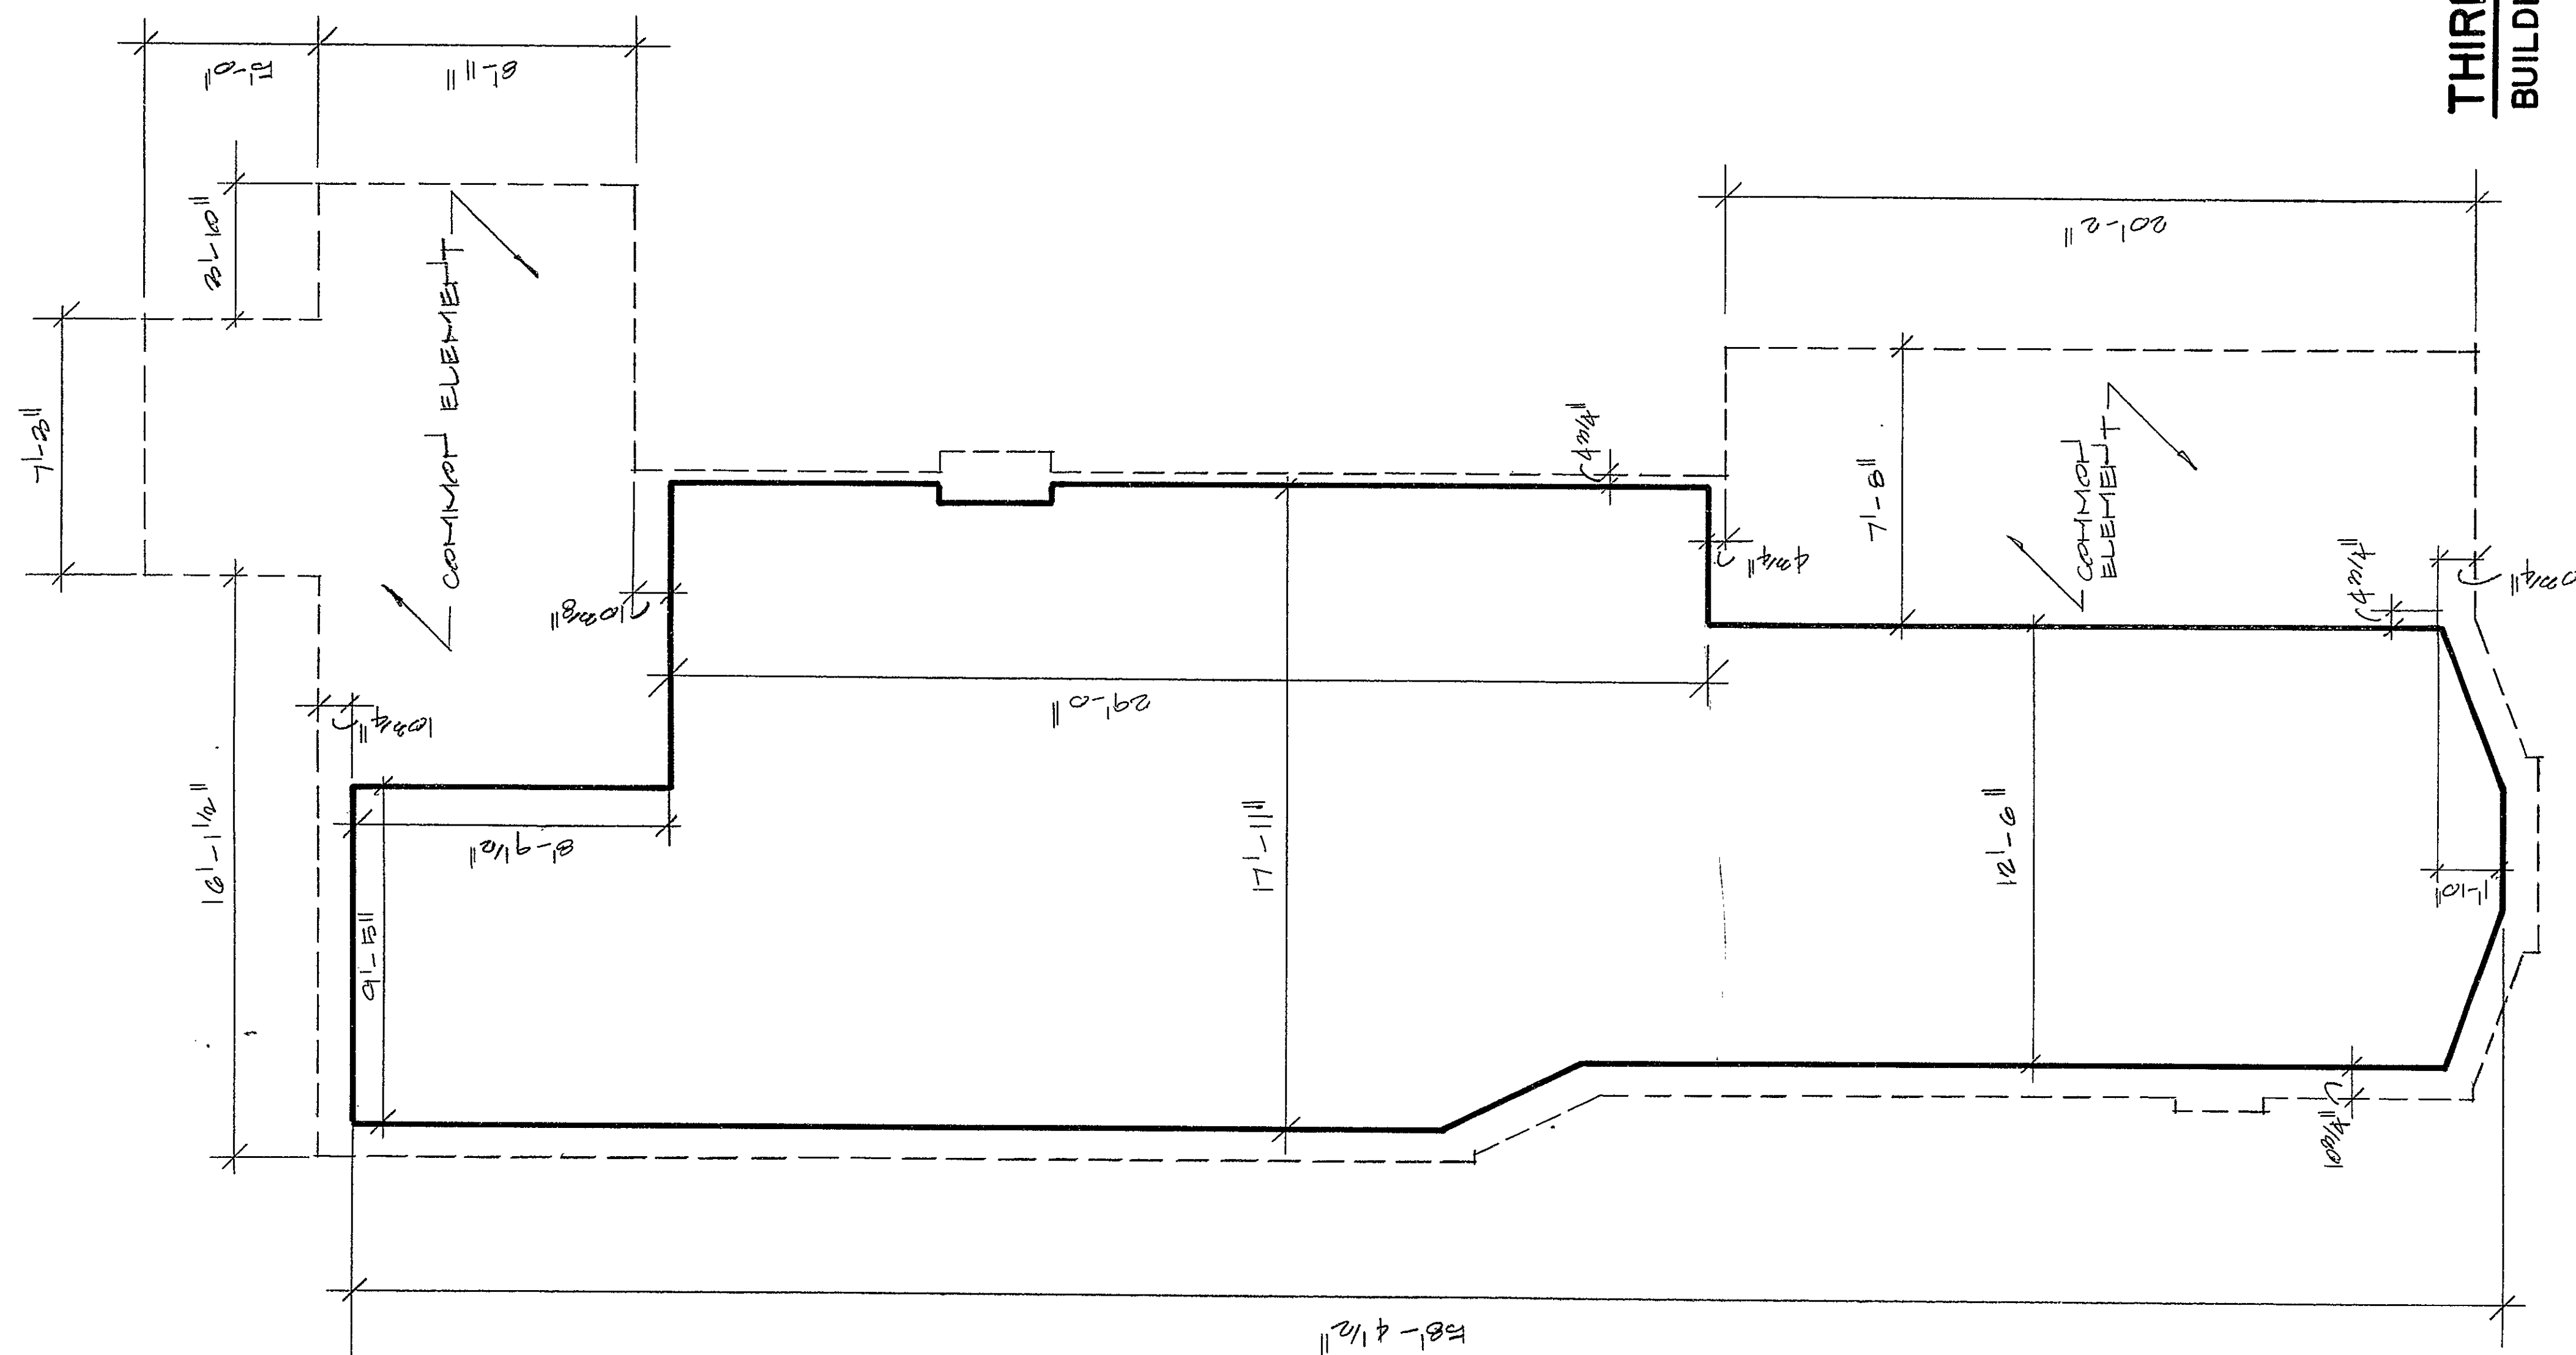

THIRD FLOOR PLAN
BUILDING NO. 360-362

On plan dated 11-11-77 CERTIFIED TO BE AN ACCURATE COPY OF PORTIONS OF THE PLANS ON FILE WITH THE CITY OF HARTFORD DEPARTMENT OF LICENSING AND INSPECTION. Americo Mallozzi AMERICOMALLOZZI ARCHITECT DATE: 11/11/77 VERIFICATION	9'-2" FLOOR HEIGHT PROJECT WOODLAND ELEVEN CONDOMINIUMS WOODLAND AVENUE HARTFORD, CONNECTICUT	842 SQUARE FOOTAGE  SCALE INTERIOR BOUNDARIES EXTERIOR CONDITIONS NO. OF ROOMS 4	UNIT (S) - 301 A 6 of 7 SHEETS
--	---	---	--