




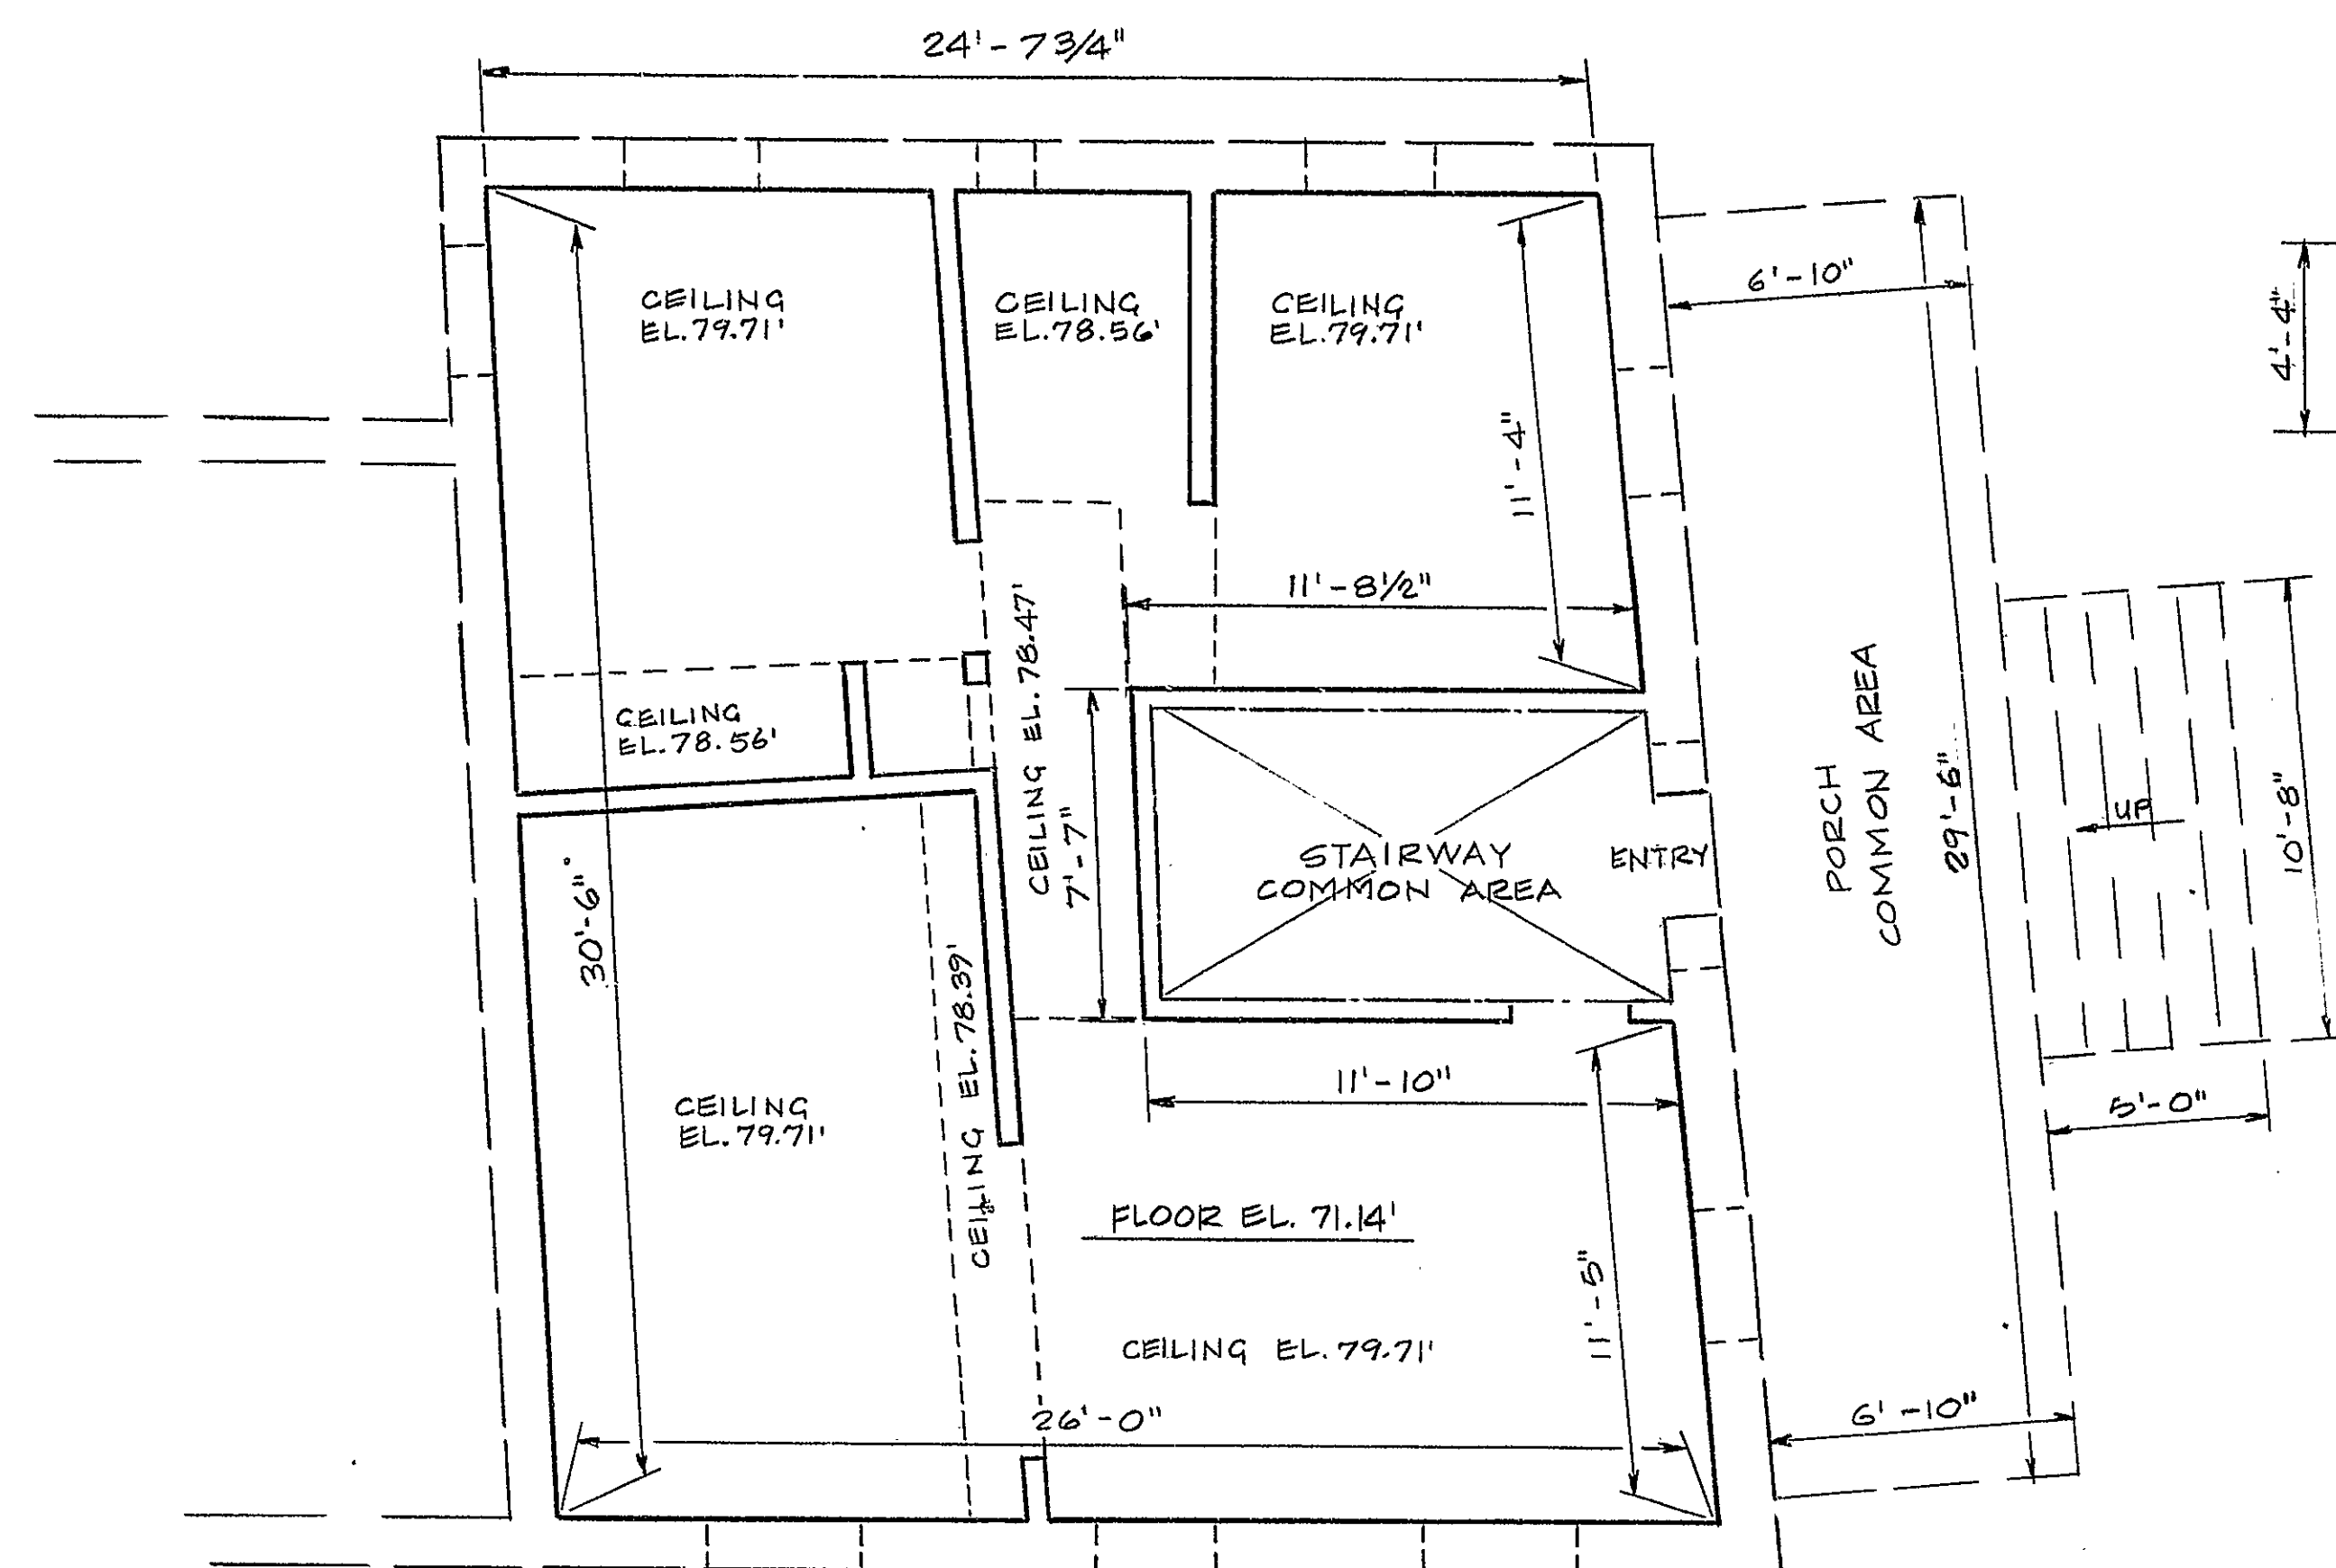


FIRST FLOOR
UNIT #286-B
AREA 683.3 S.F.

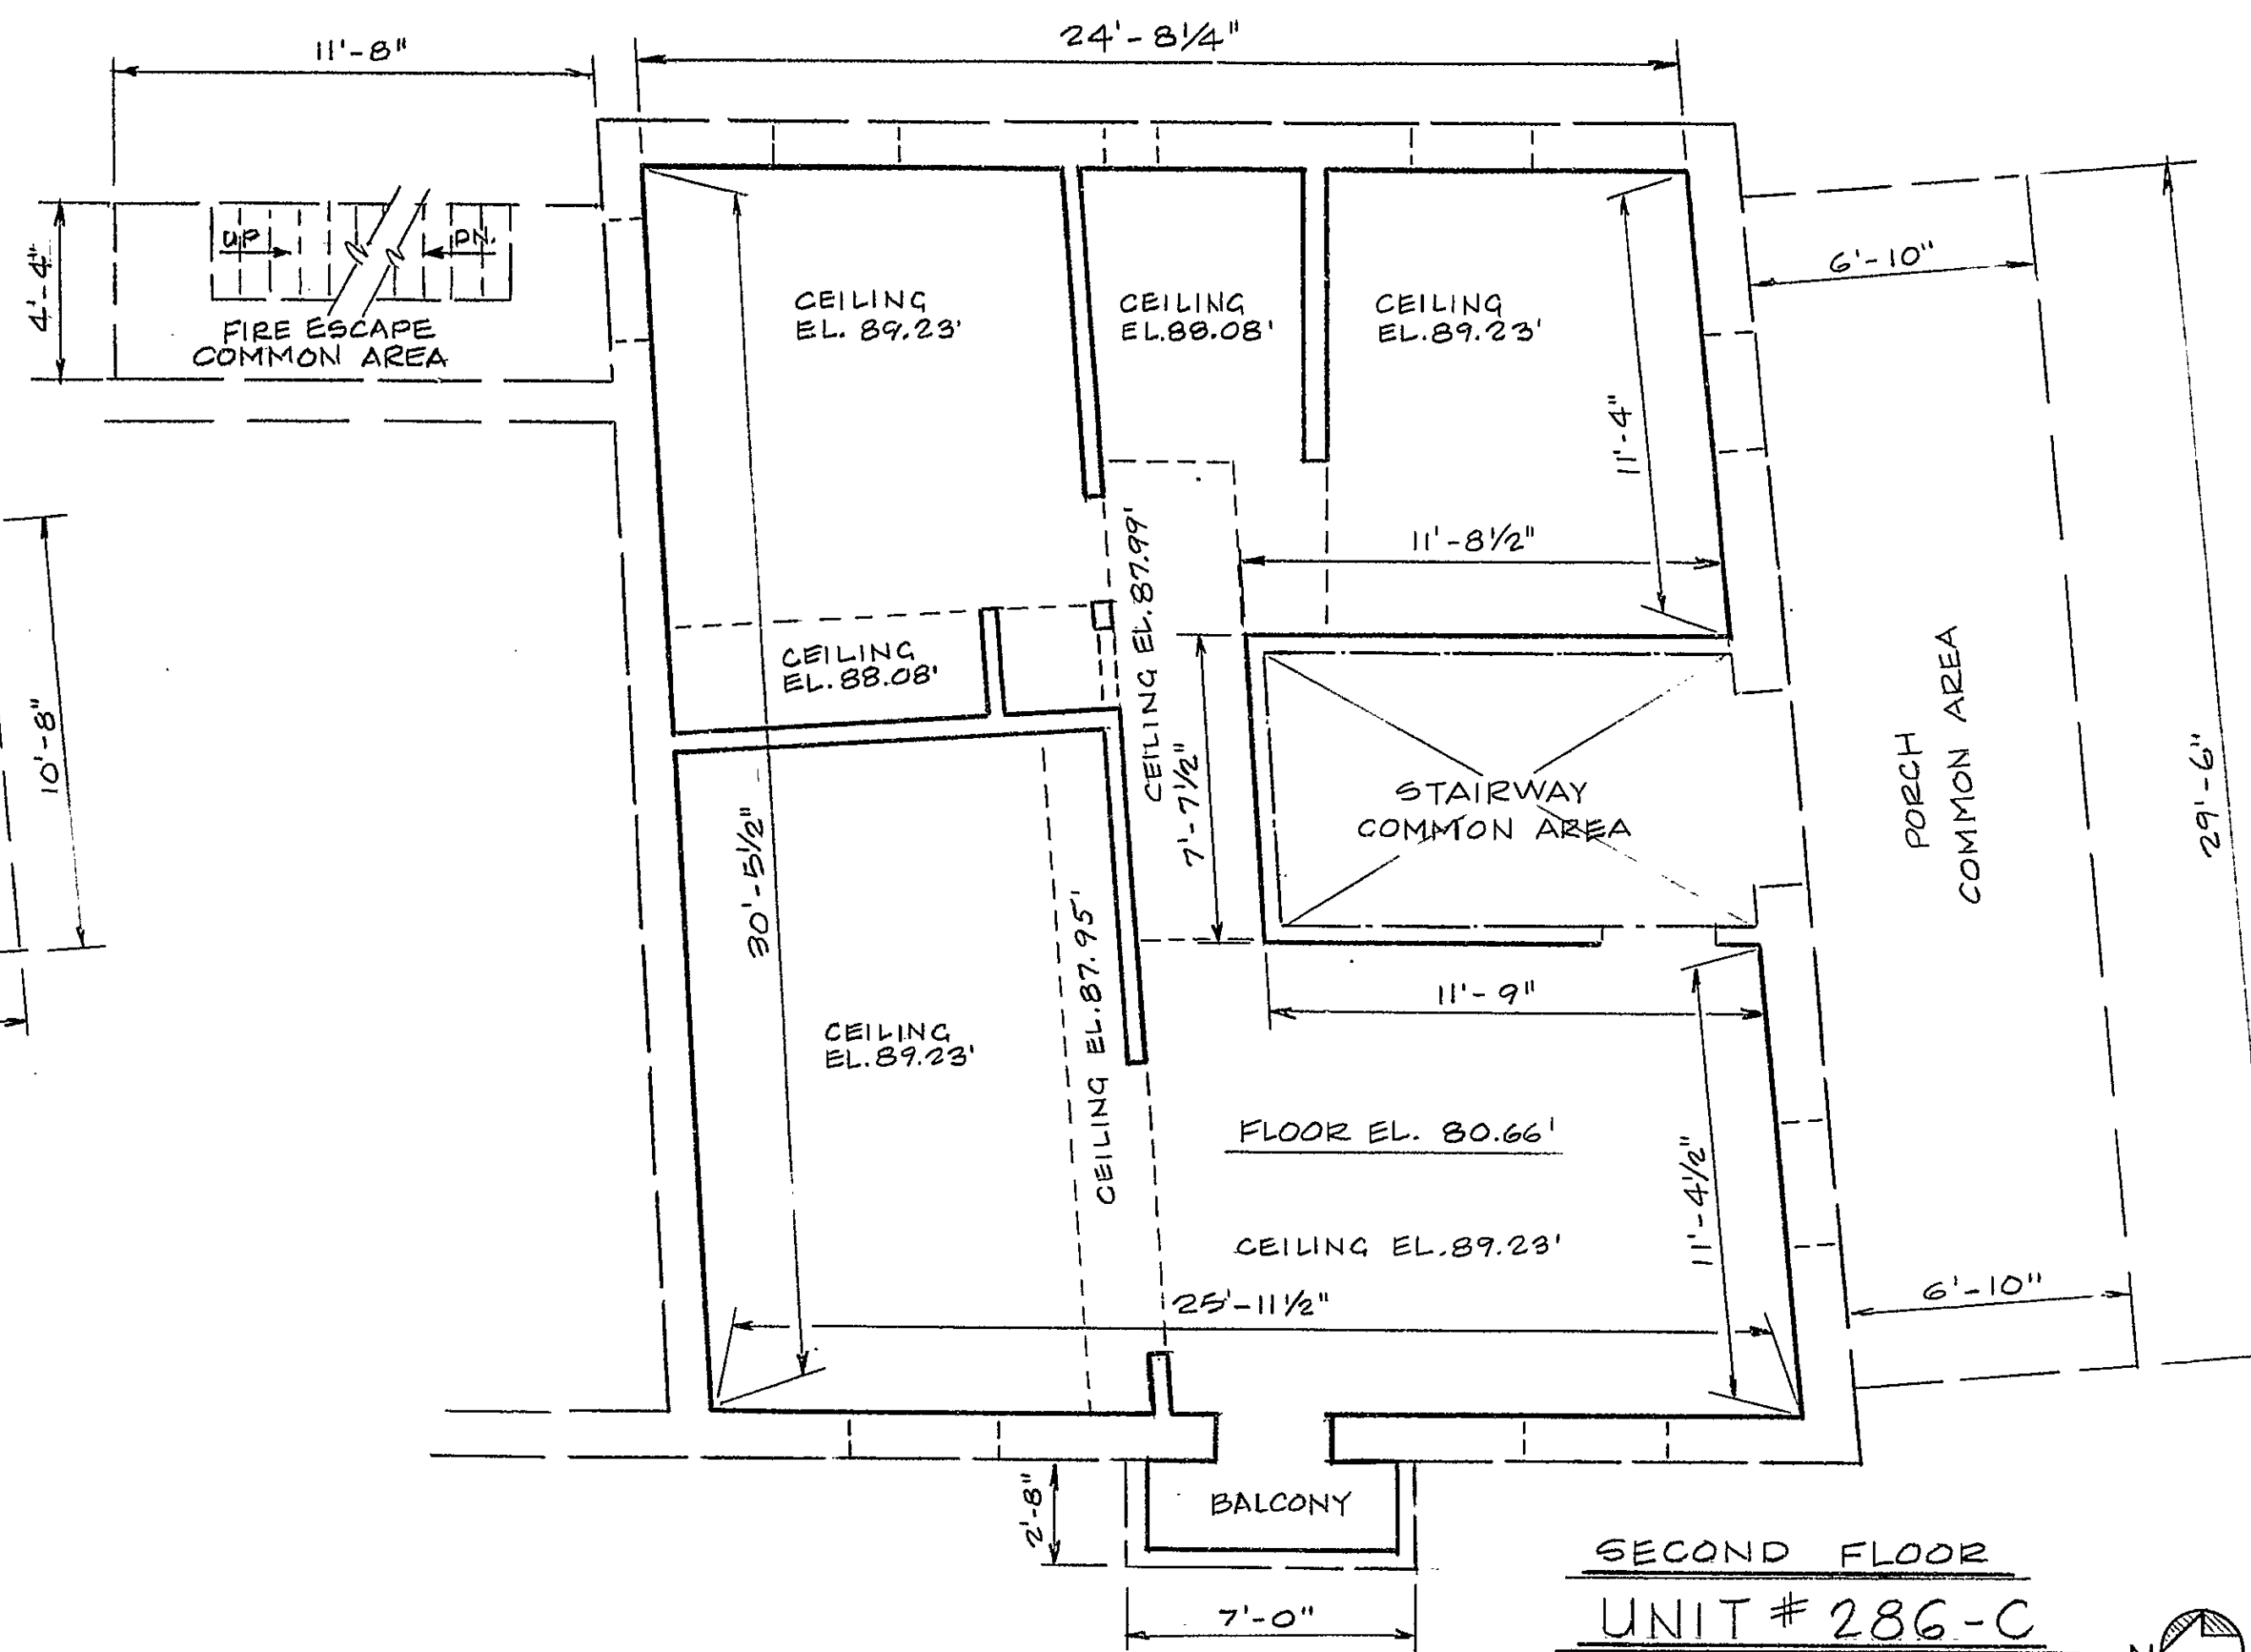


SECOND FLOOR
UNIT #286-C
AREA 681.4 S.F.
BALCONY AREA NOT INCLUDED

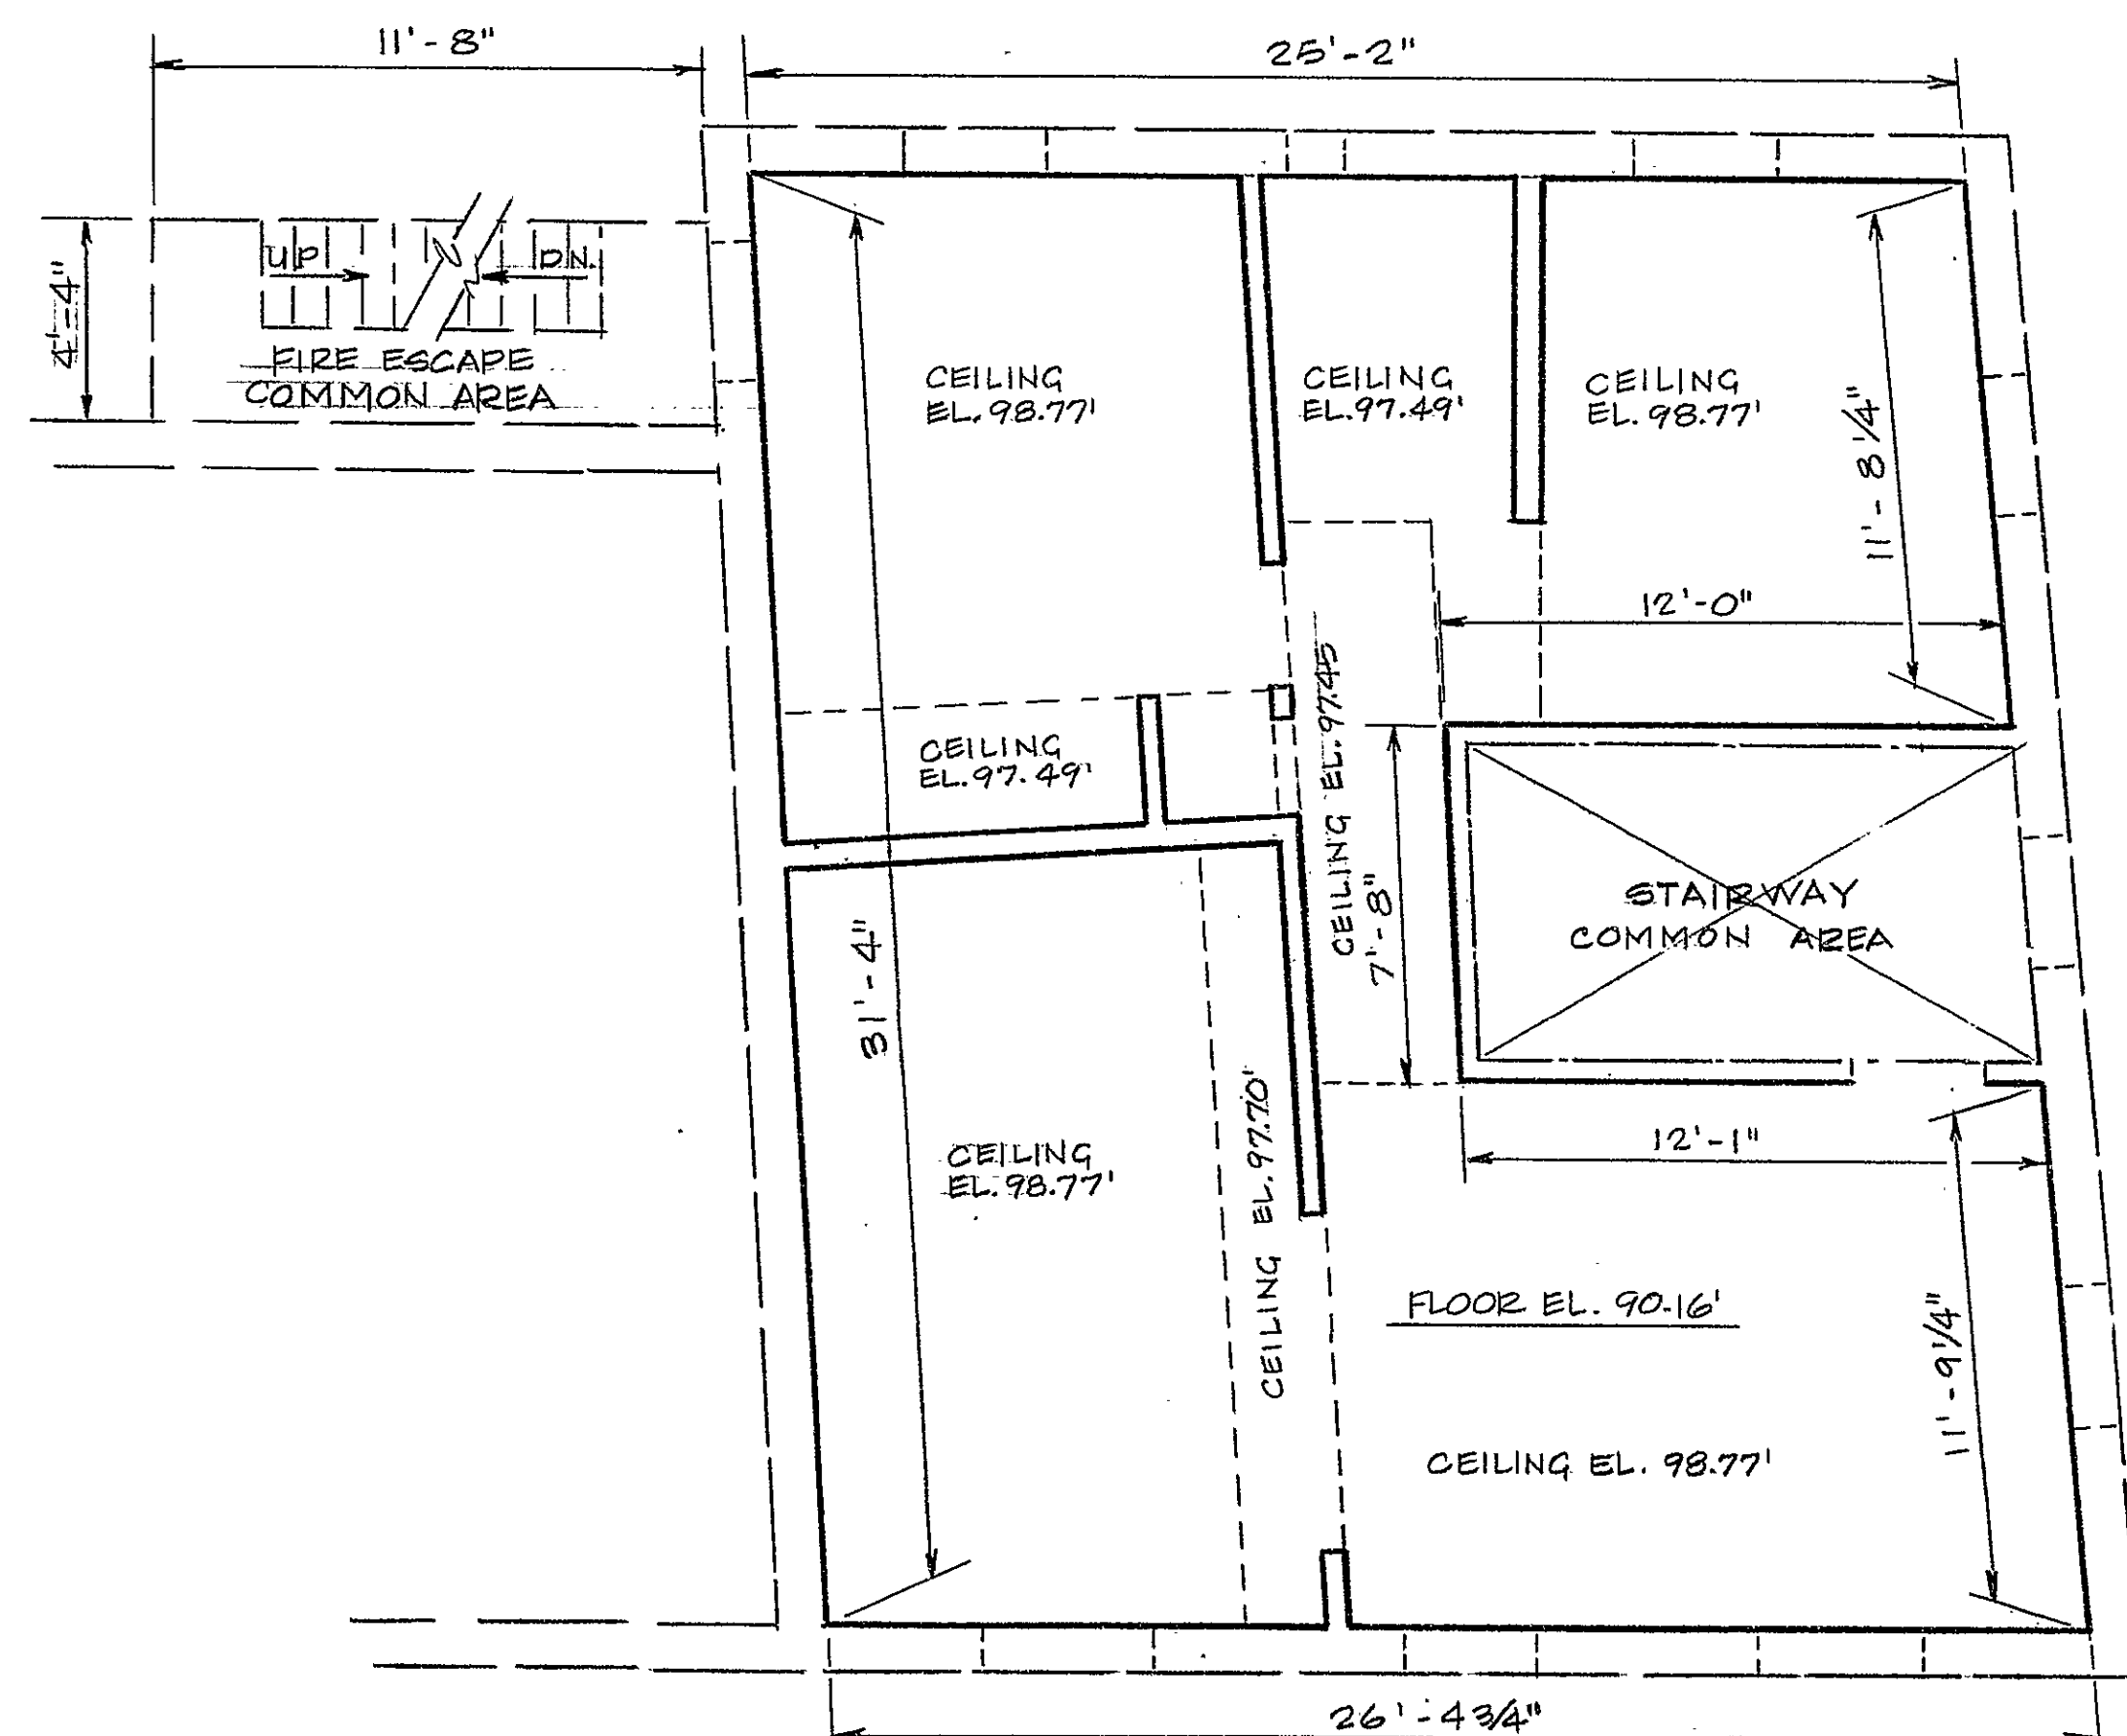

THIRD FLOOR
UNIT #286-D
AREA 716.3 S.F.

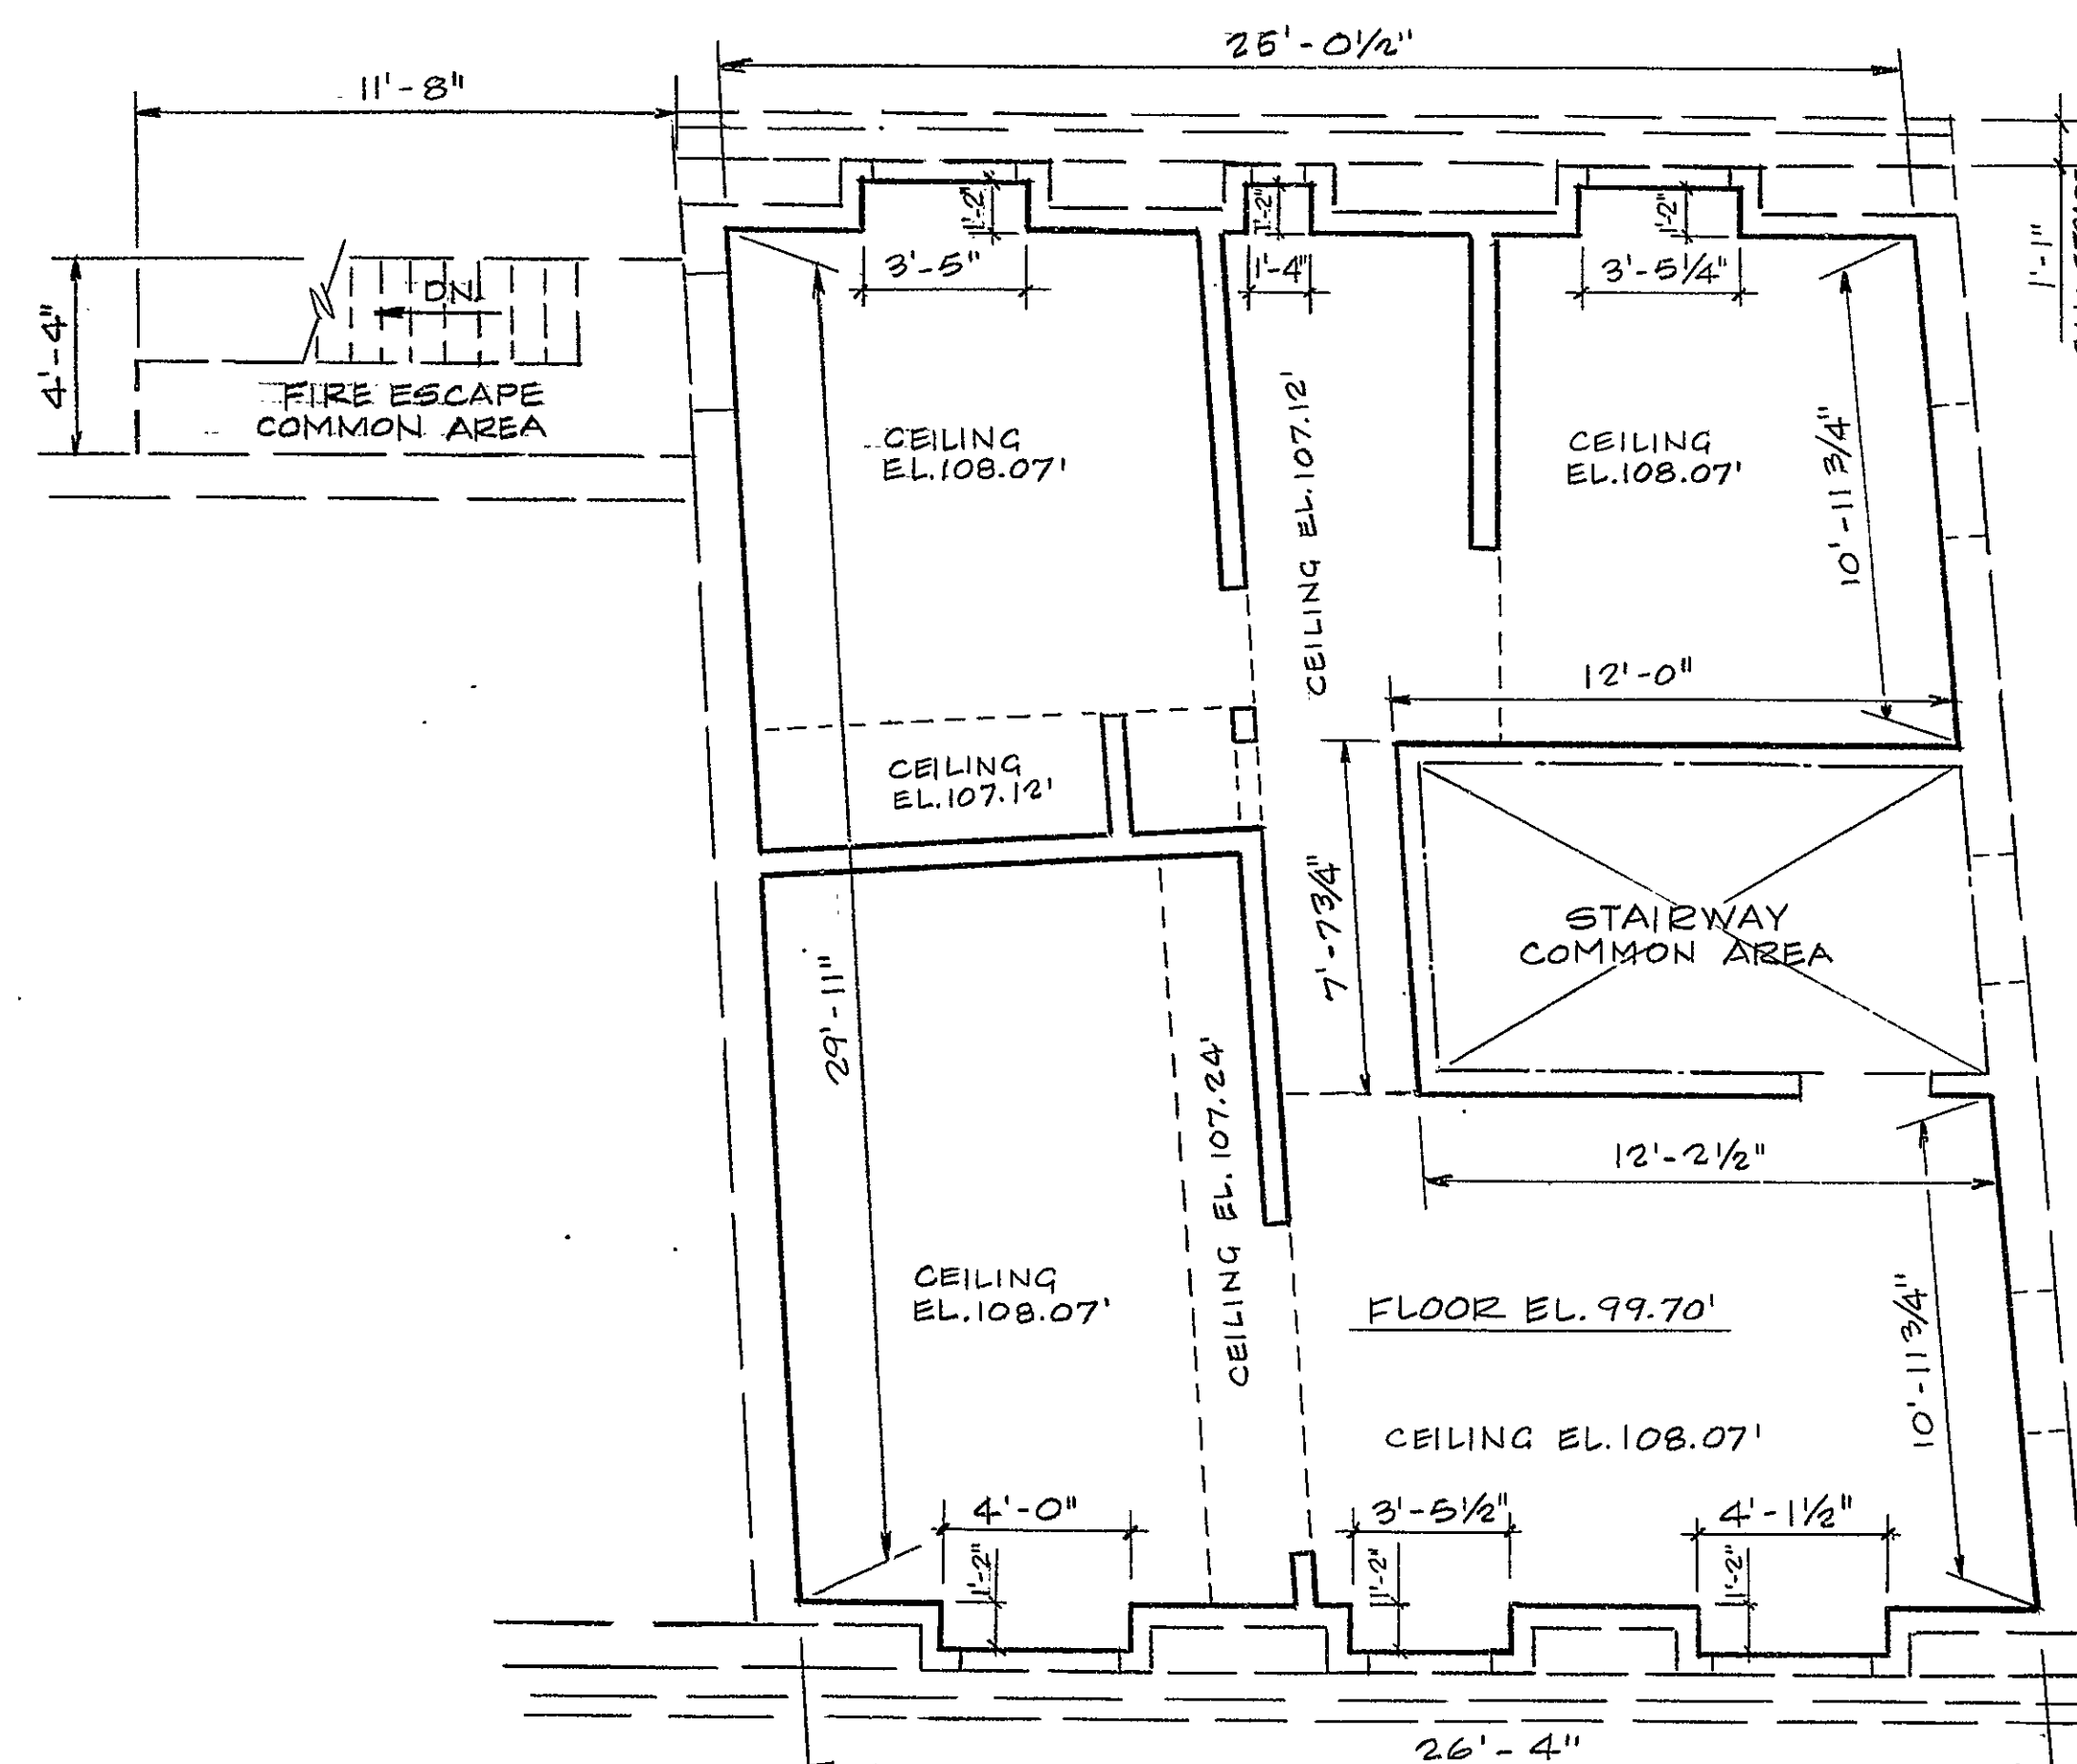

FOURTH FLOOR
UNIT #286-E
AREA 700.5 S.F.

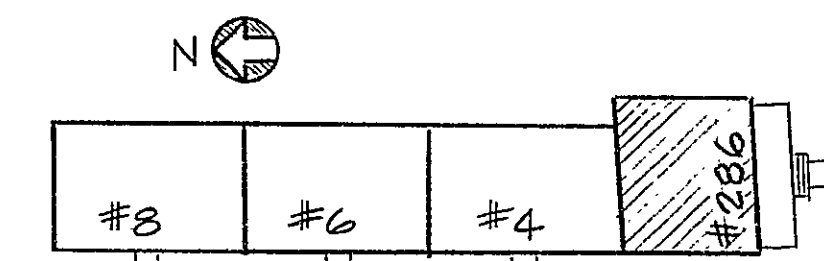

KEY PLAN
NOT TO SCALE

NOTE: THE PURPOSE OF THESE DRAWINGS IS TO SHOW APPROXIMATE DIMENSIONS, FLOOR AREA & LOCATION OF EACH UNIT. ELEVATIONS ARE TAKEN FROM CITY OF HARTFORD DATUM WITHIN UNITS SOLID BLACK OUTLINED SHAPES REPRESENT COMMON ELEMENTS (E.G. BEARING WALLS, COLUMNS, FLUES & DUCTS ECT.).

I HEREBY STATE THAT TO THE BEST OF MY KNOWLEDGE, INFORMATION AND BELIEF, THESE PLANS ARE AN ACCURATE COPY OF THAT PORTION OF THE PLANS FILED WITH THE OFFICE OF THE REGISTERED ARCHITECT, REVISION 1983, AS AMENDED OF THE CONNECTICUT OFFICE OF THE REGISTERED ARCHITECT.

LOUIS J. COLAVECCHIO, REGISTERED ARCHITECT
286 FARMINGTON AVE. # 4, 4, 8 HARTFORD, CONNECTICUT 06103
DATE: JULY 16, 1982
NOTARY PUBLIC

LEGEND
--- EXTERIOR WALLS OF BUILDING
--- UNIT BOUNDARY
--- COMMON AREA
--- STAIRWAY OR FLOOR ELEVATION CHANGE
--- BALCONY

SCALE IN FEET
0 1 2 3 4

JULY 16, 1982

GEORGETOWN MANOR
CONDOMINIUM
286 FARMINGTON AVE. # 4, 4, 8 MARSHALL ST.
HARTFORD, CONNECTICUT
LOUIS J. COLAVECCHIO AIA., ARCHITECT