
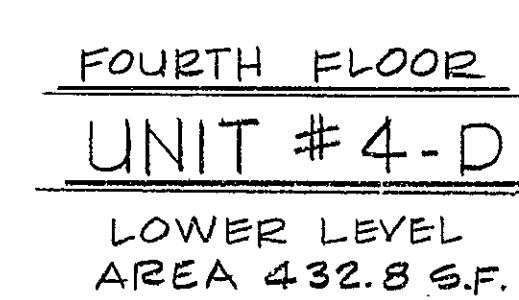
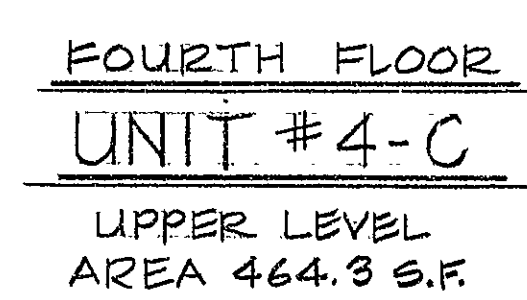
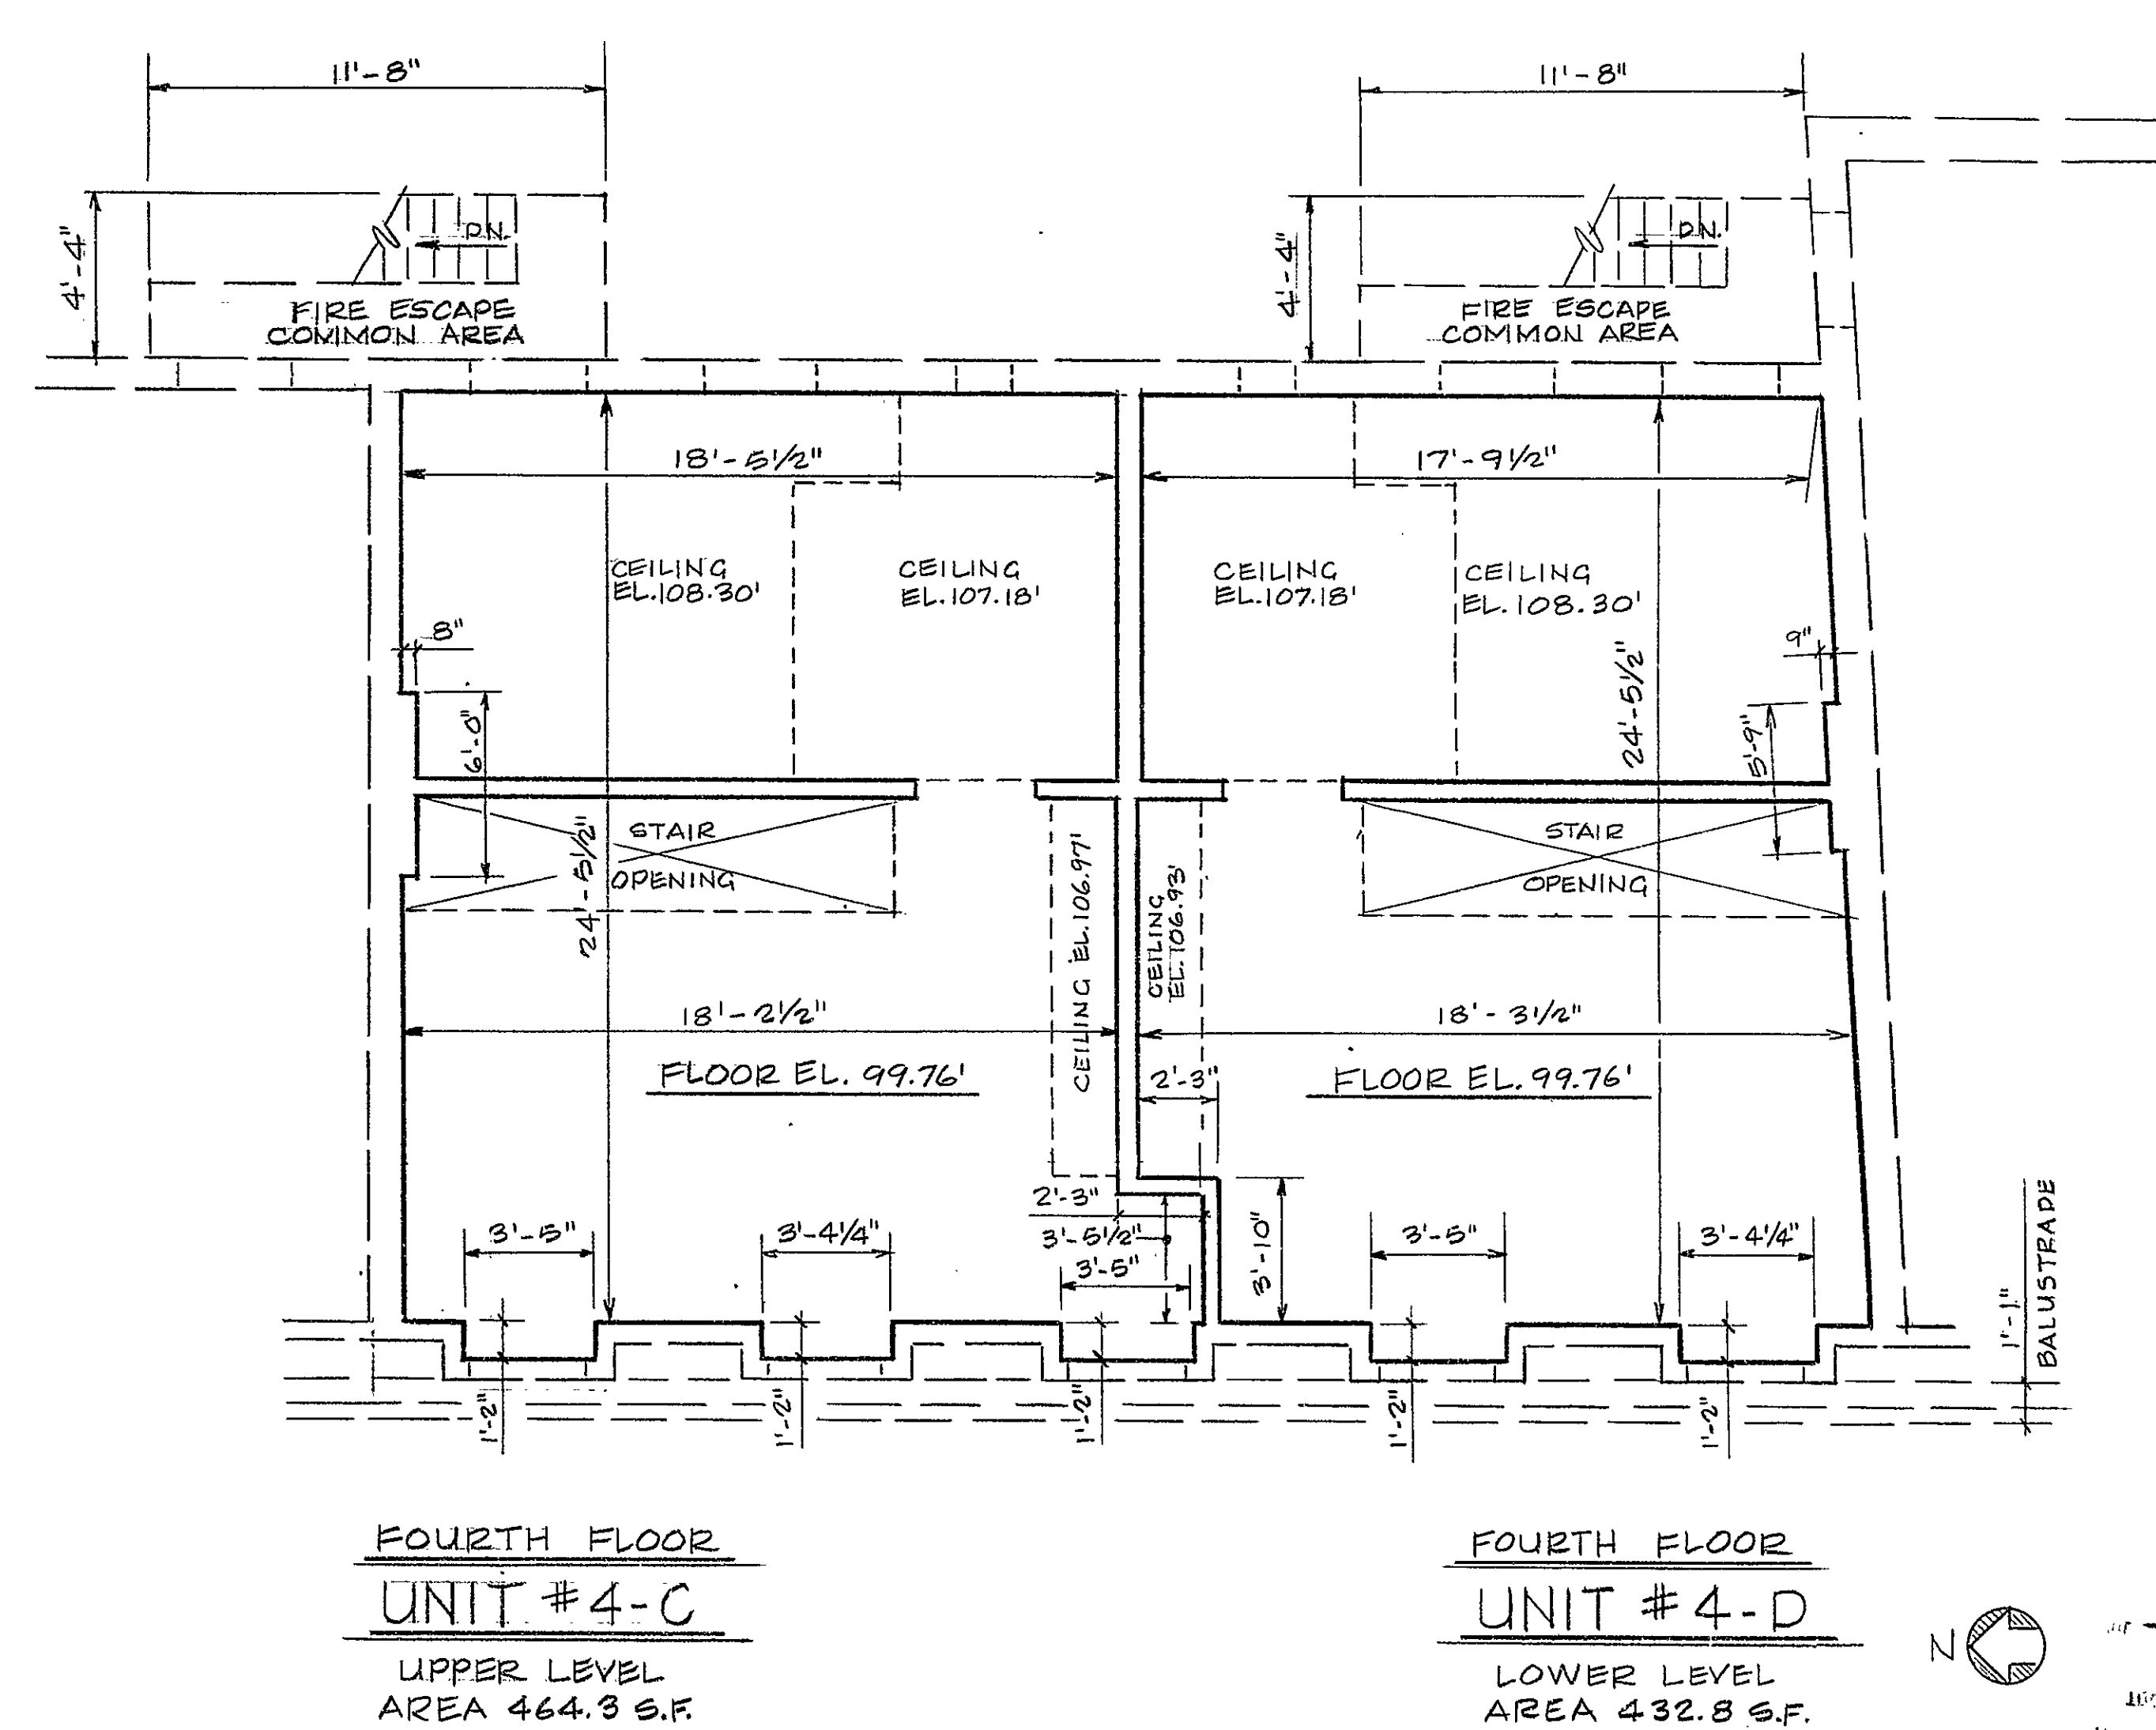
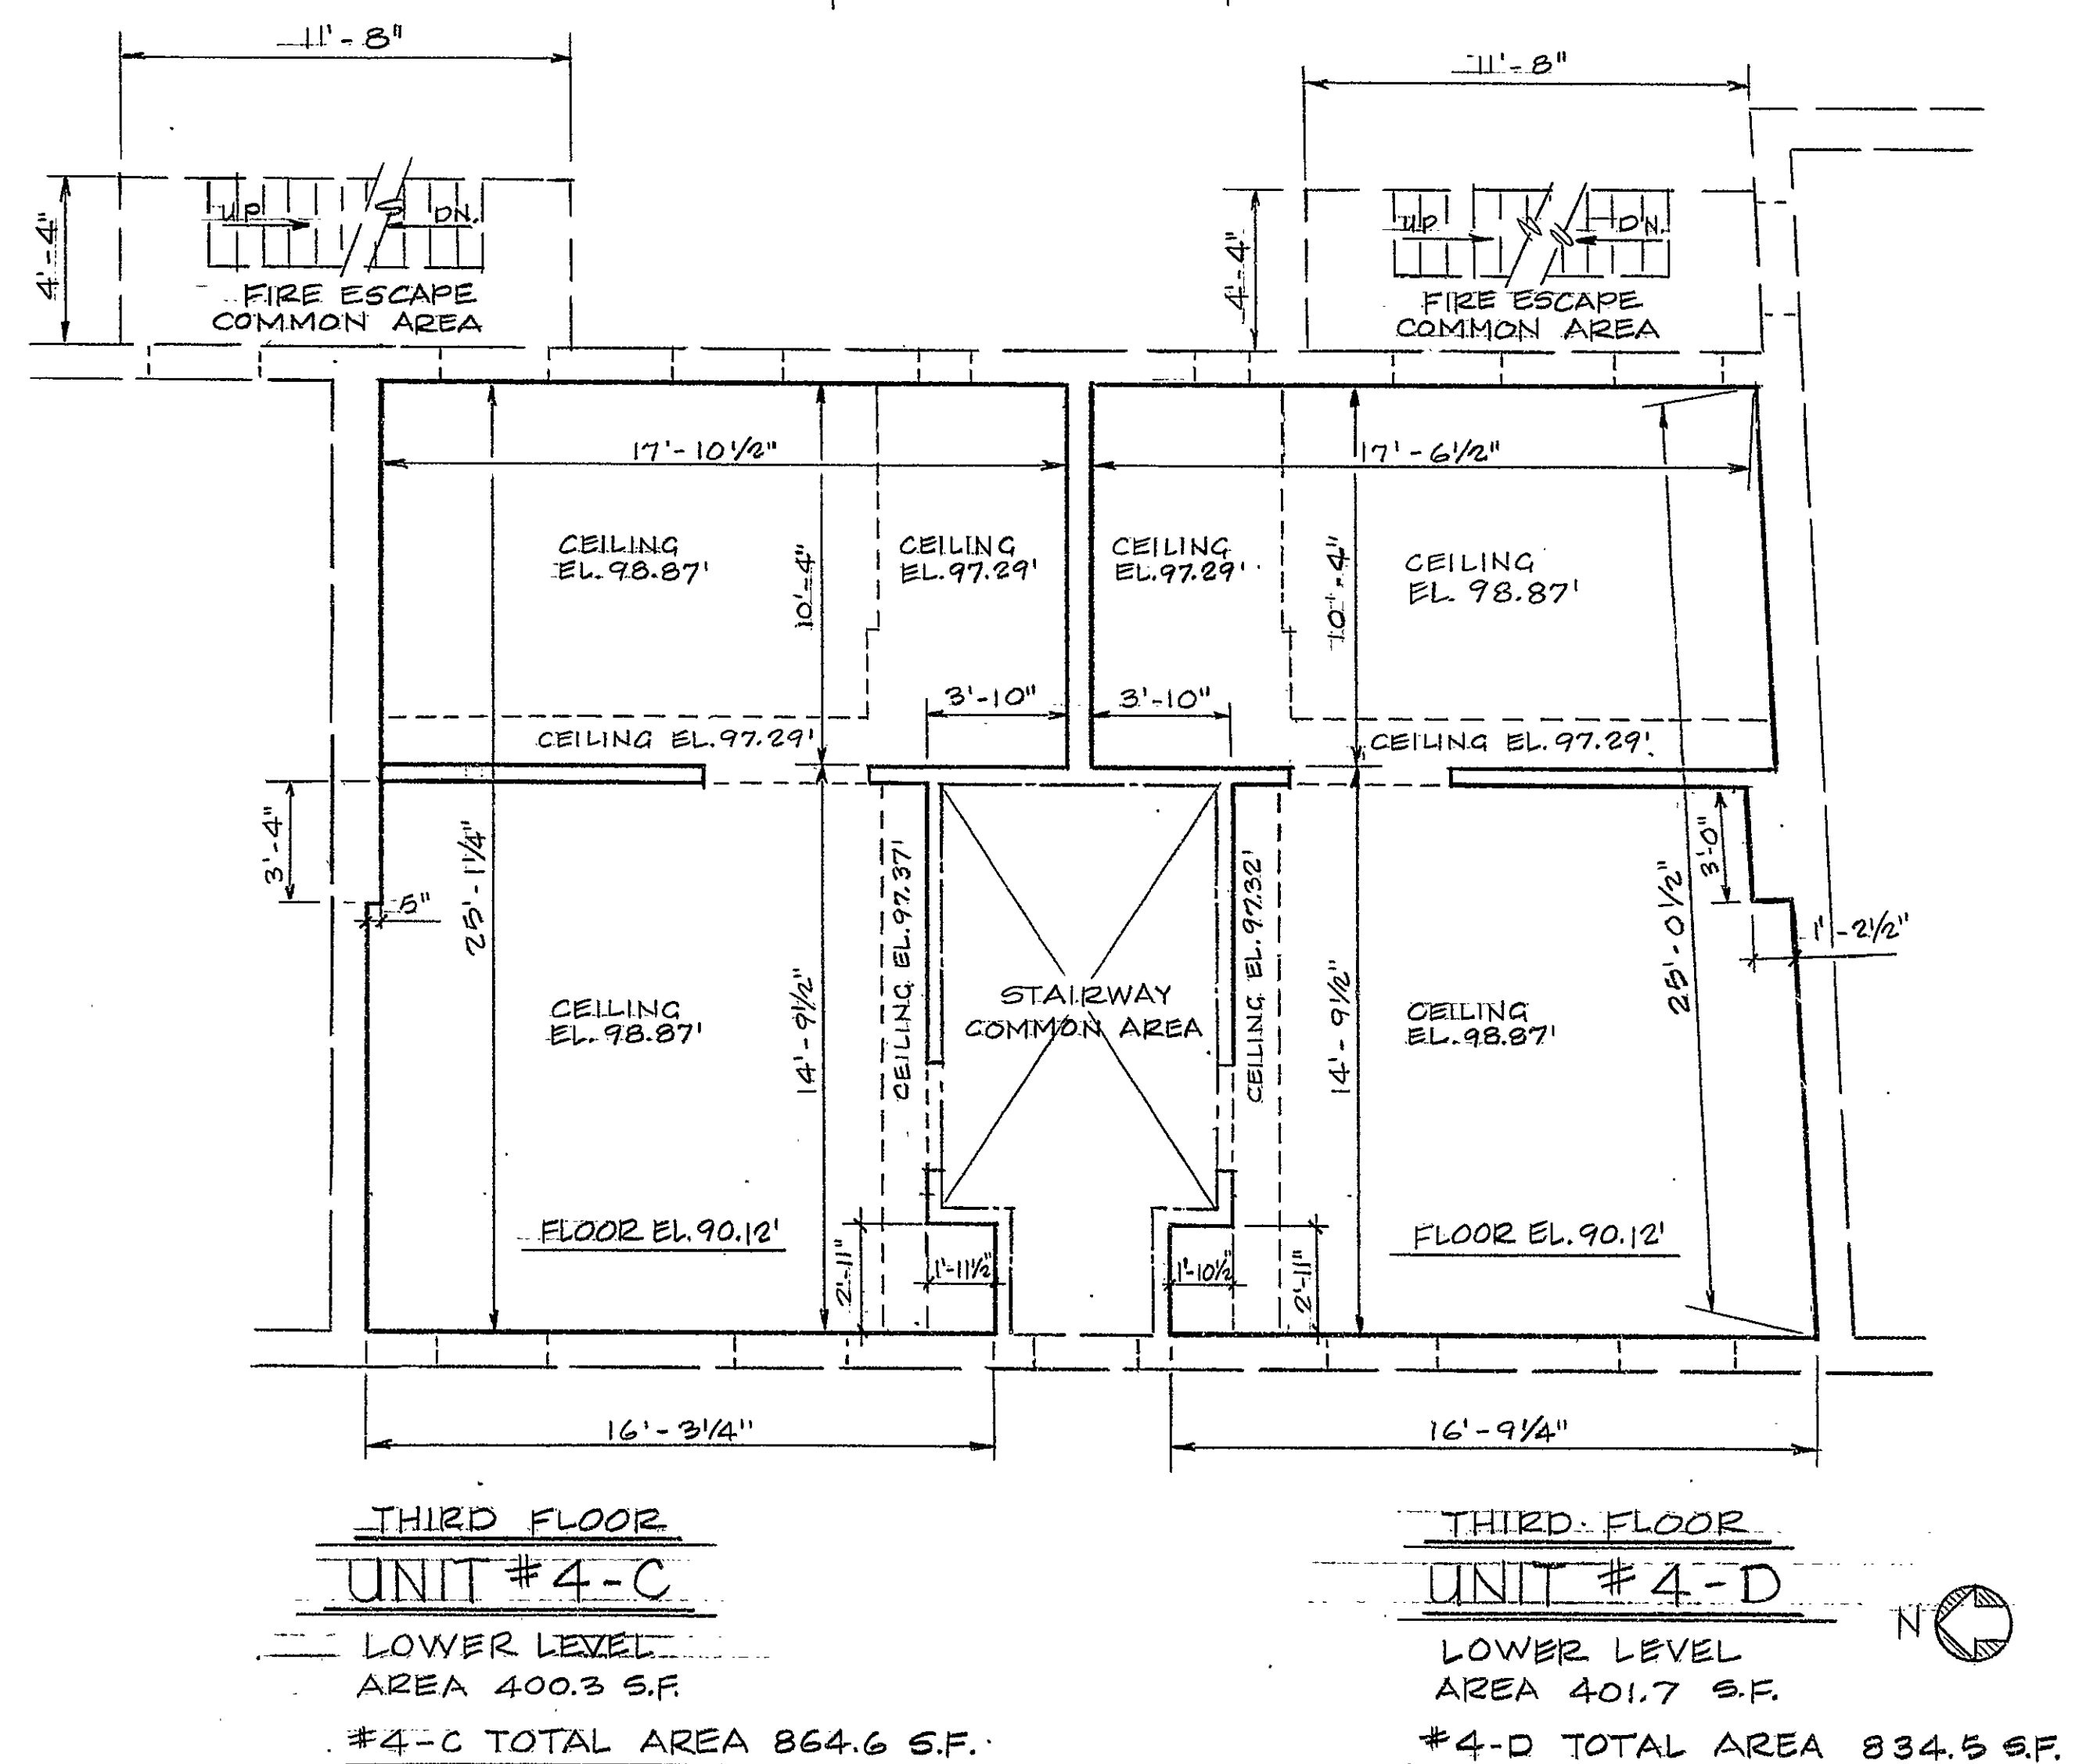
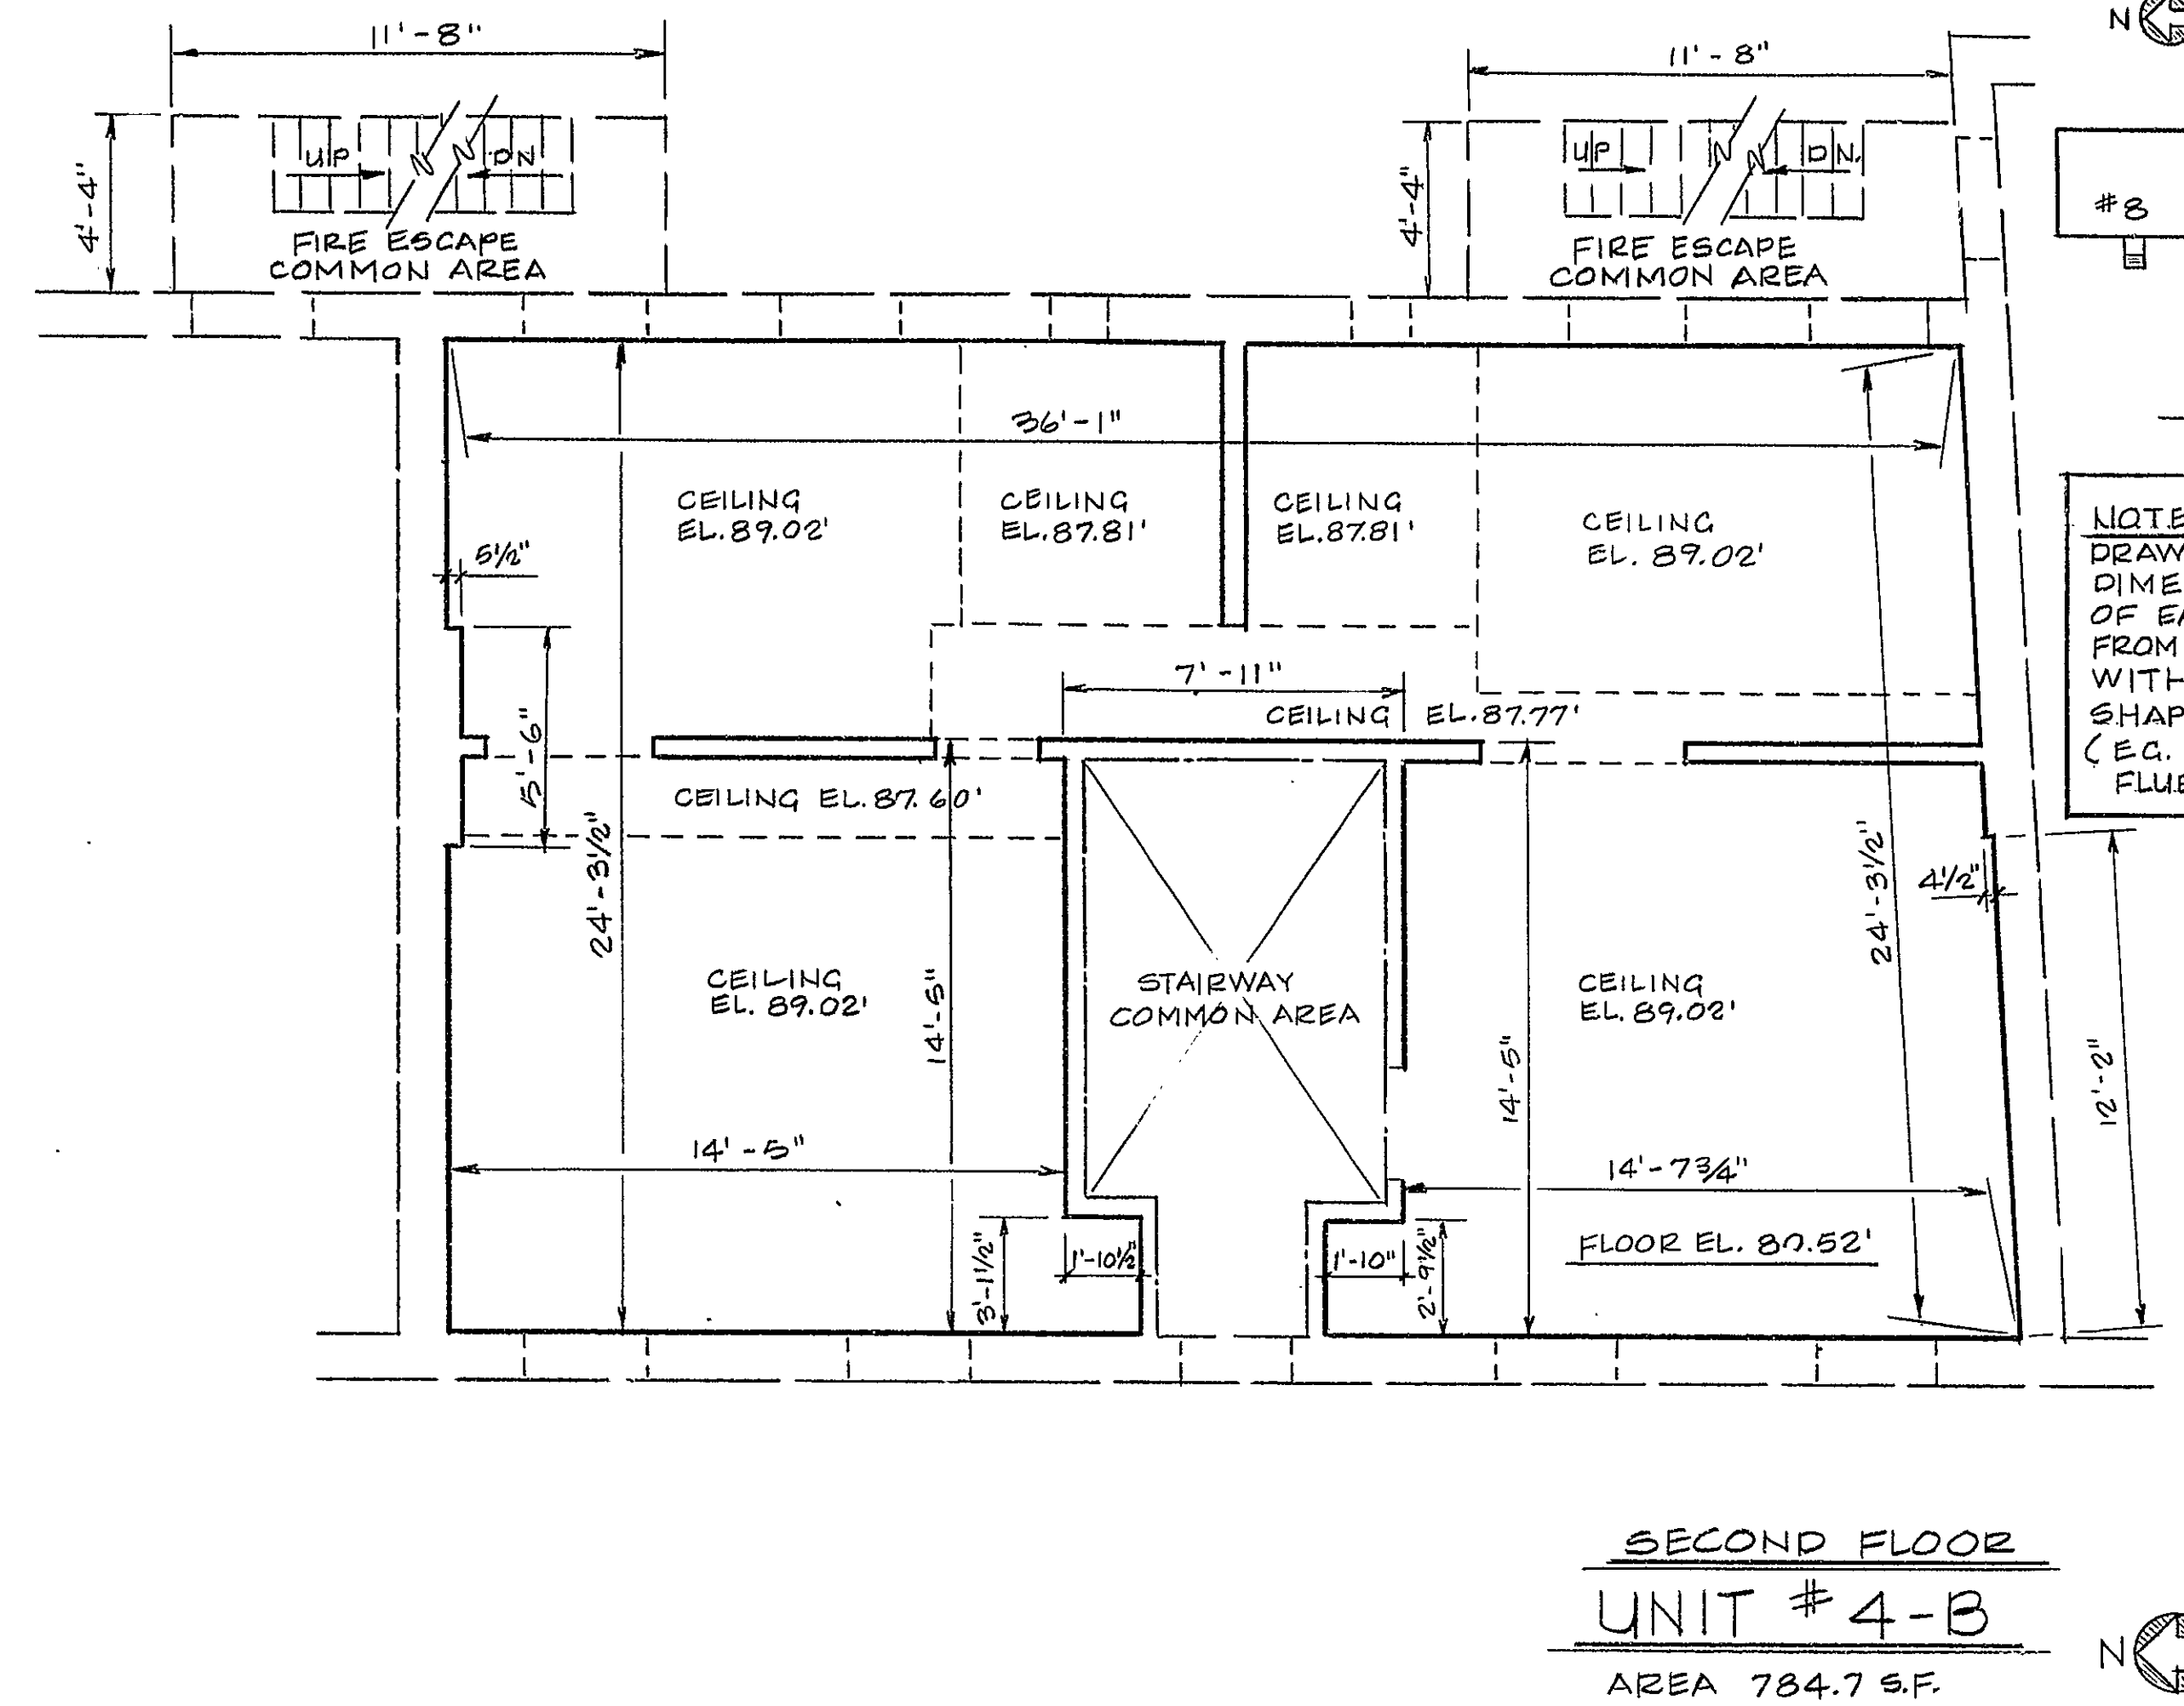


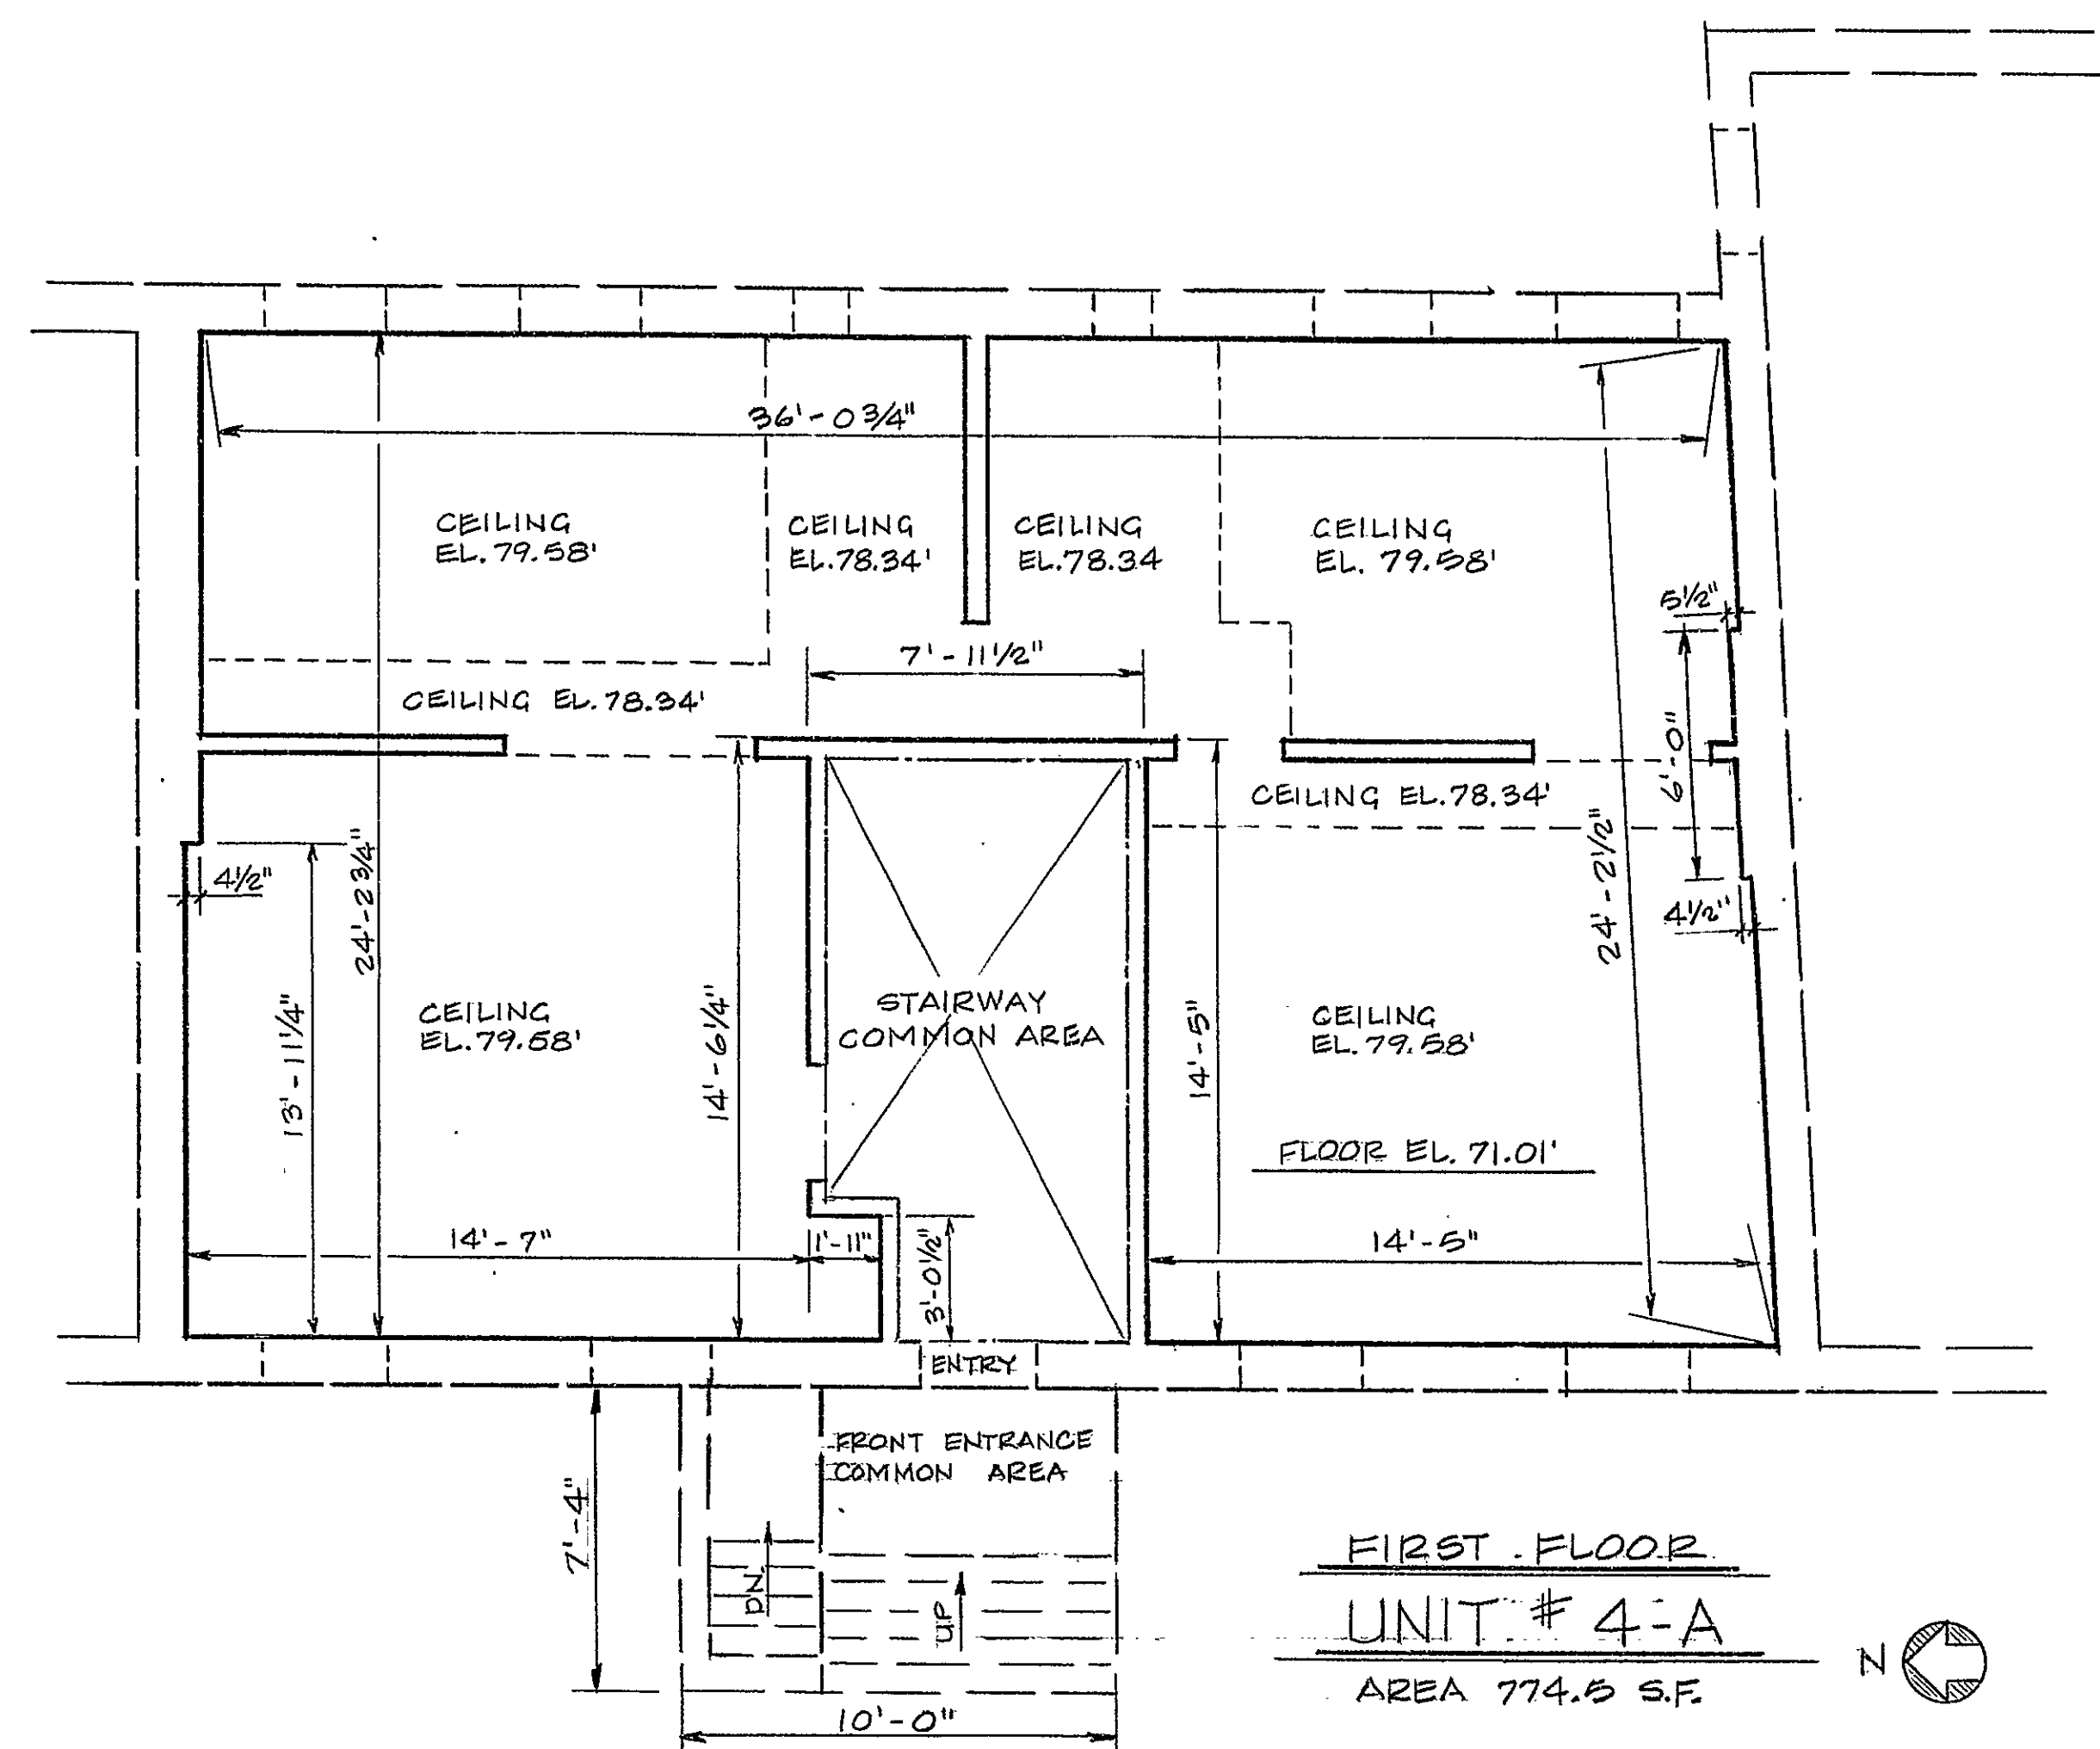

N

#8 #6 #4 #20C

MARSHALL ST.

KEY PLAN

NOT TO SCALE

NOTE: THE PURPOSE OF THESE DRAWINGS IS TO SHOW APPROXIMATE DIMENSIONS, FLOOR AREA & LOCATION OF EACH UNIT. ELEVATIONS ARE TAKEN FROM CITY OF HARTFORD DATUM. WITHIN UNITS SOLID BLACK OUTLINE SHAPES REPRESENT COMMON ELEMENTS (E.G. BEARING WALLS, COLUMNS, FLUES & DUCTS ECT.).

I HEREBY STATE THAT TO THE BEST OF MY KNOWLEDGE, INFORMATION AND BELIEF, THE ABOVE IS A TRUE AND CORRECT STATEMENT OF THE FACTS AND CIRCUMSTANCES WITHIN THE BUILDING OFFICE OF THE CITY OF HARTFORD, PURSUANT TO SECTION 19-396 OF THE CONNECTICUT GENERAL STATUTES, REVISION 1960, AS AMENDED.


PERSONALLY APPEARED BEFORE ME, LOUIS J. COLACIVICH AIA, ARCHITECT, SIGNER OF THE FOREGOING CERTIFICATE, AND BEING FULLY SWORN MADE SOLEMN OATH THAT THE STATEMENTS AND INFORMATION CONTAINED HEREIN WERE TRUE TO THE BEST OF HIS KNOWLEDGE, INFORMATION AND BELIEF, SUBSCRIBED AND SIGNED TO BEFORE ME THIS 17 DAY OF APRIL, 1962.

NOTARY PUBLIC *George A. Kelly* MY COMMISSION EXPIRES 3/31/63

LEGEND

----	EXTERIOR WALLS OF BUILDING.
-----	UNIT BOUNDARY
- - - - -	COMMON AREA
----	CEILING OR FLOOR ELEVATION CHANGE

TITLE BLOCK
JULY 16, 1982
SCALE IN FEET
0 1 2 4

GEORGETOWN MANOR
CONDOMINIUM
286 FARMINGTON AVE. & 4th, B MARSHALL ST.
HARTFORD, CONNECTICUT
LOUIS J. COLAVECCHIO A.I.A., ARCHITECT

3

Condo Eliza Chan FF #1

