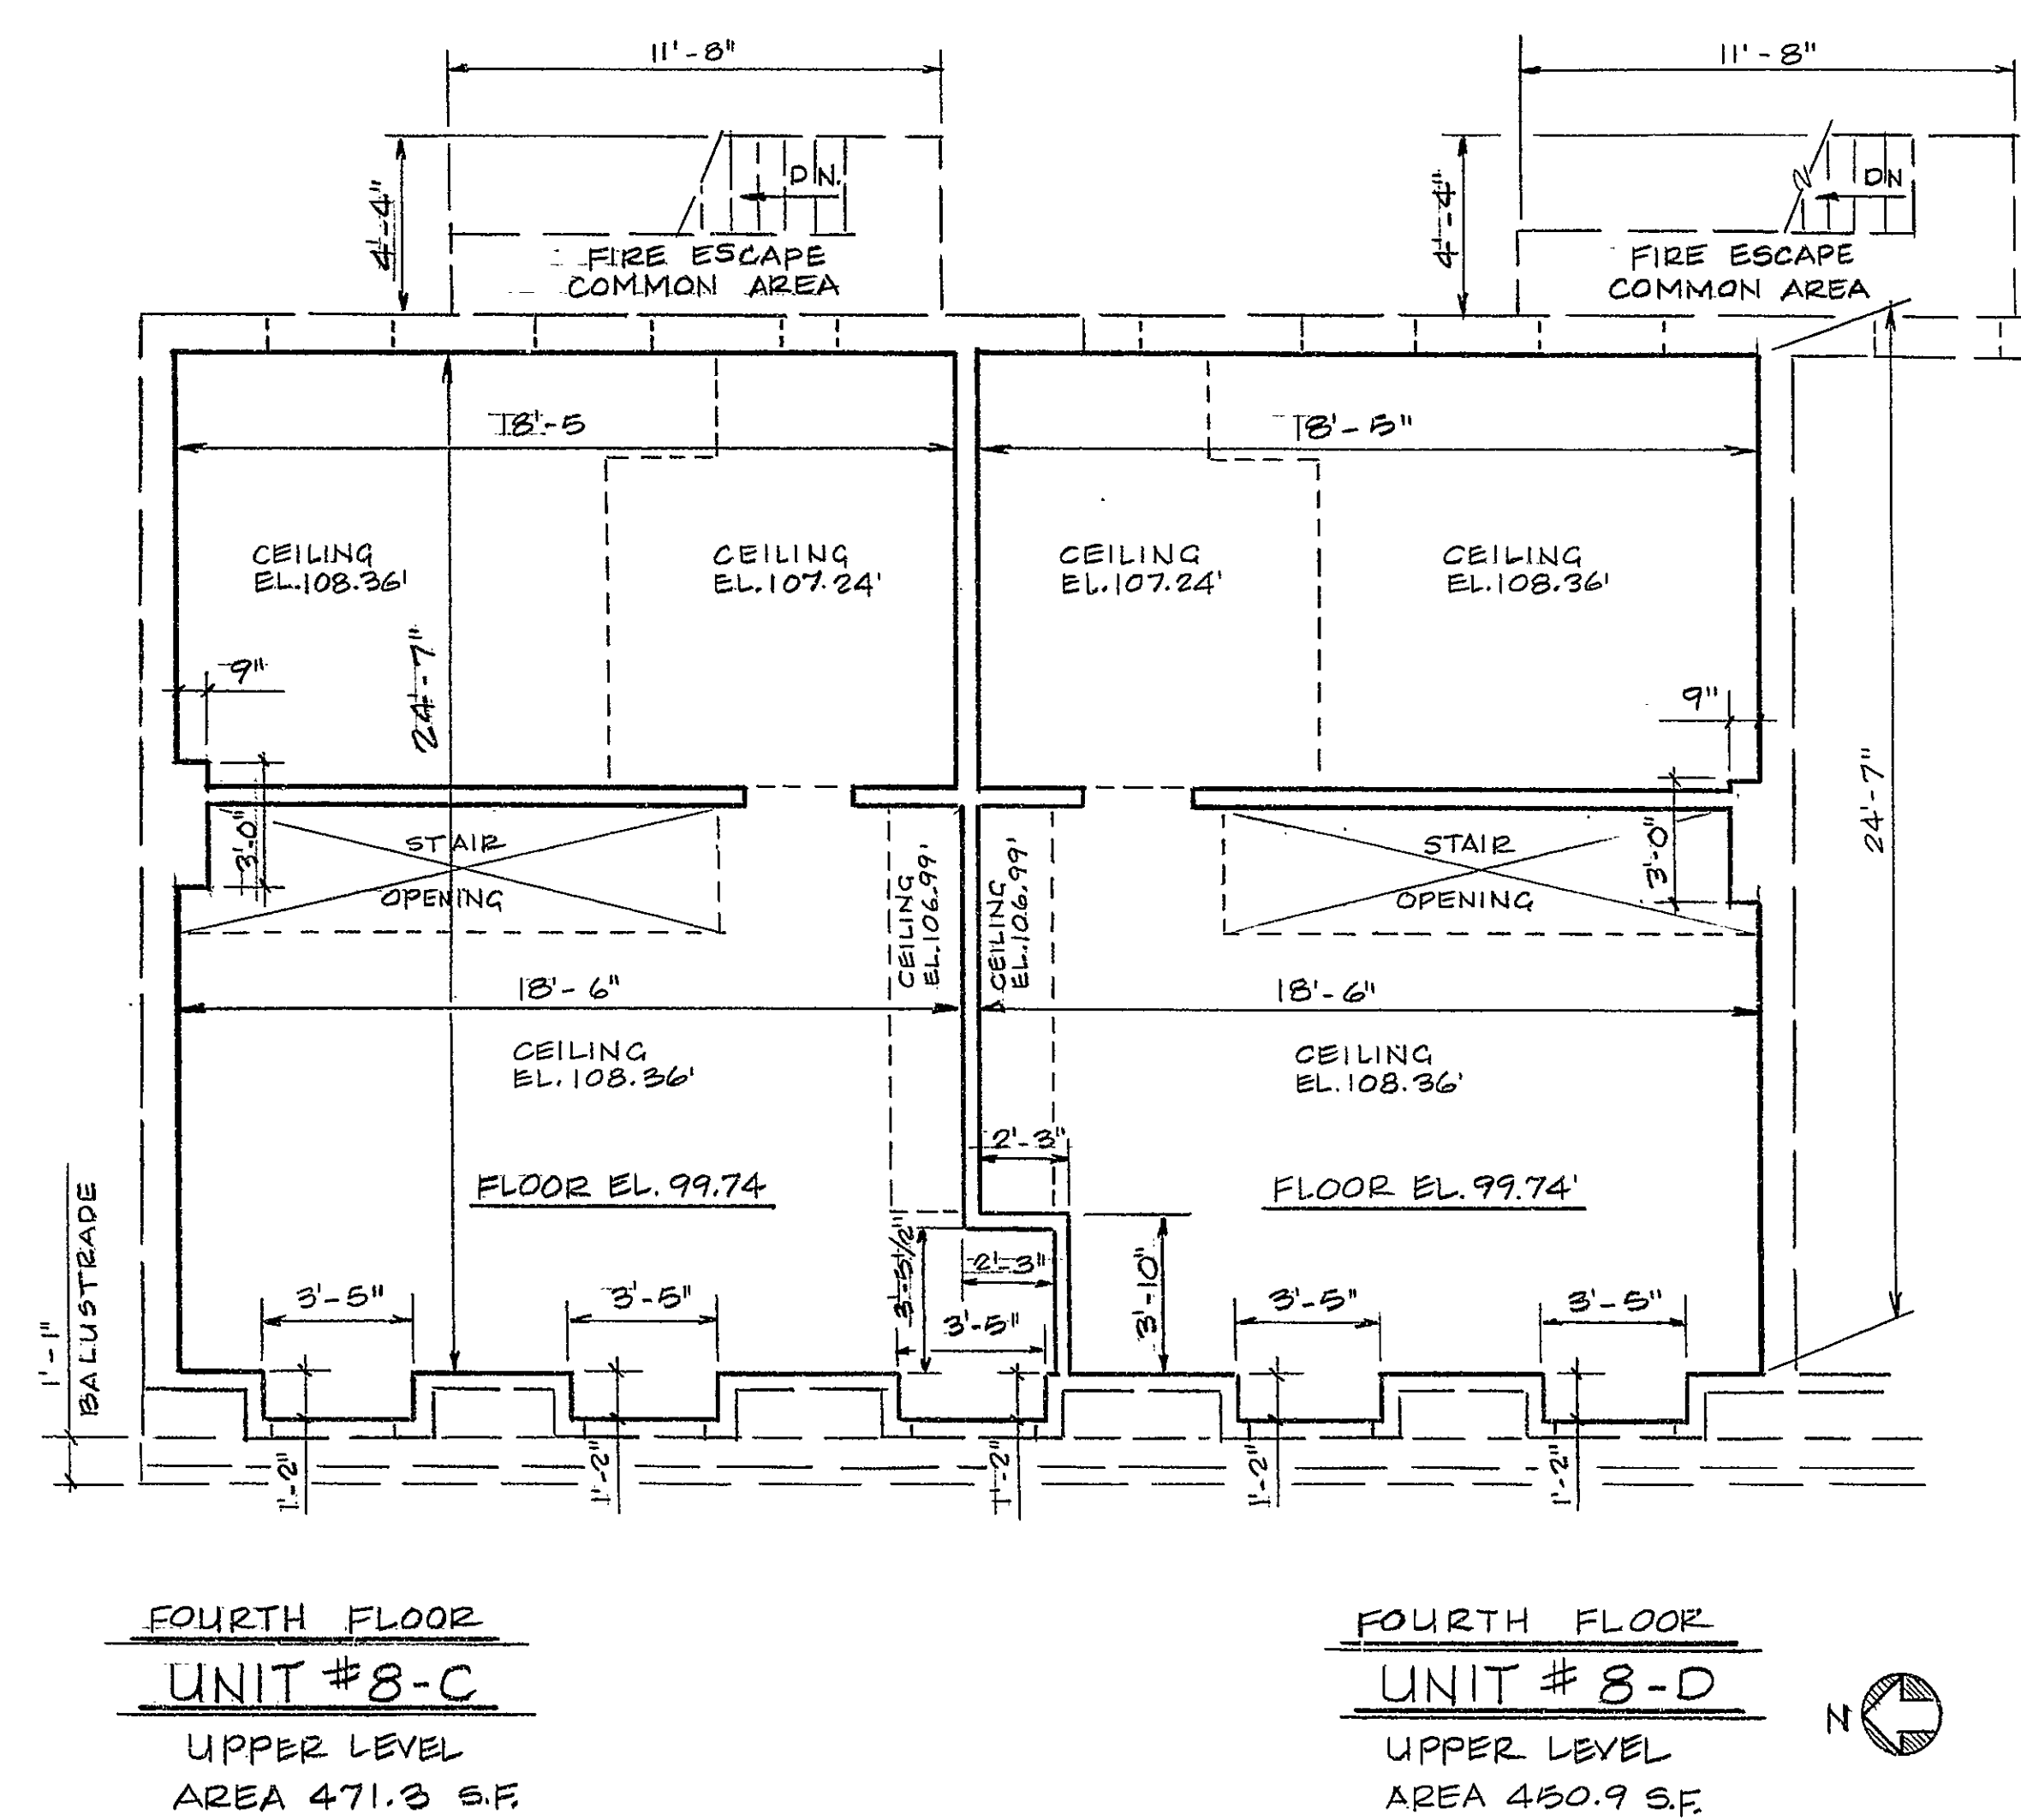
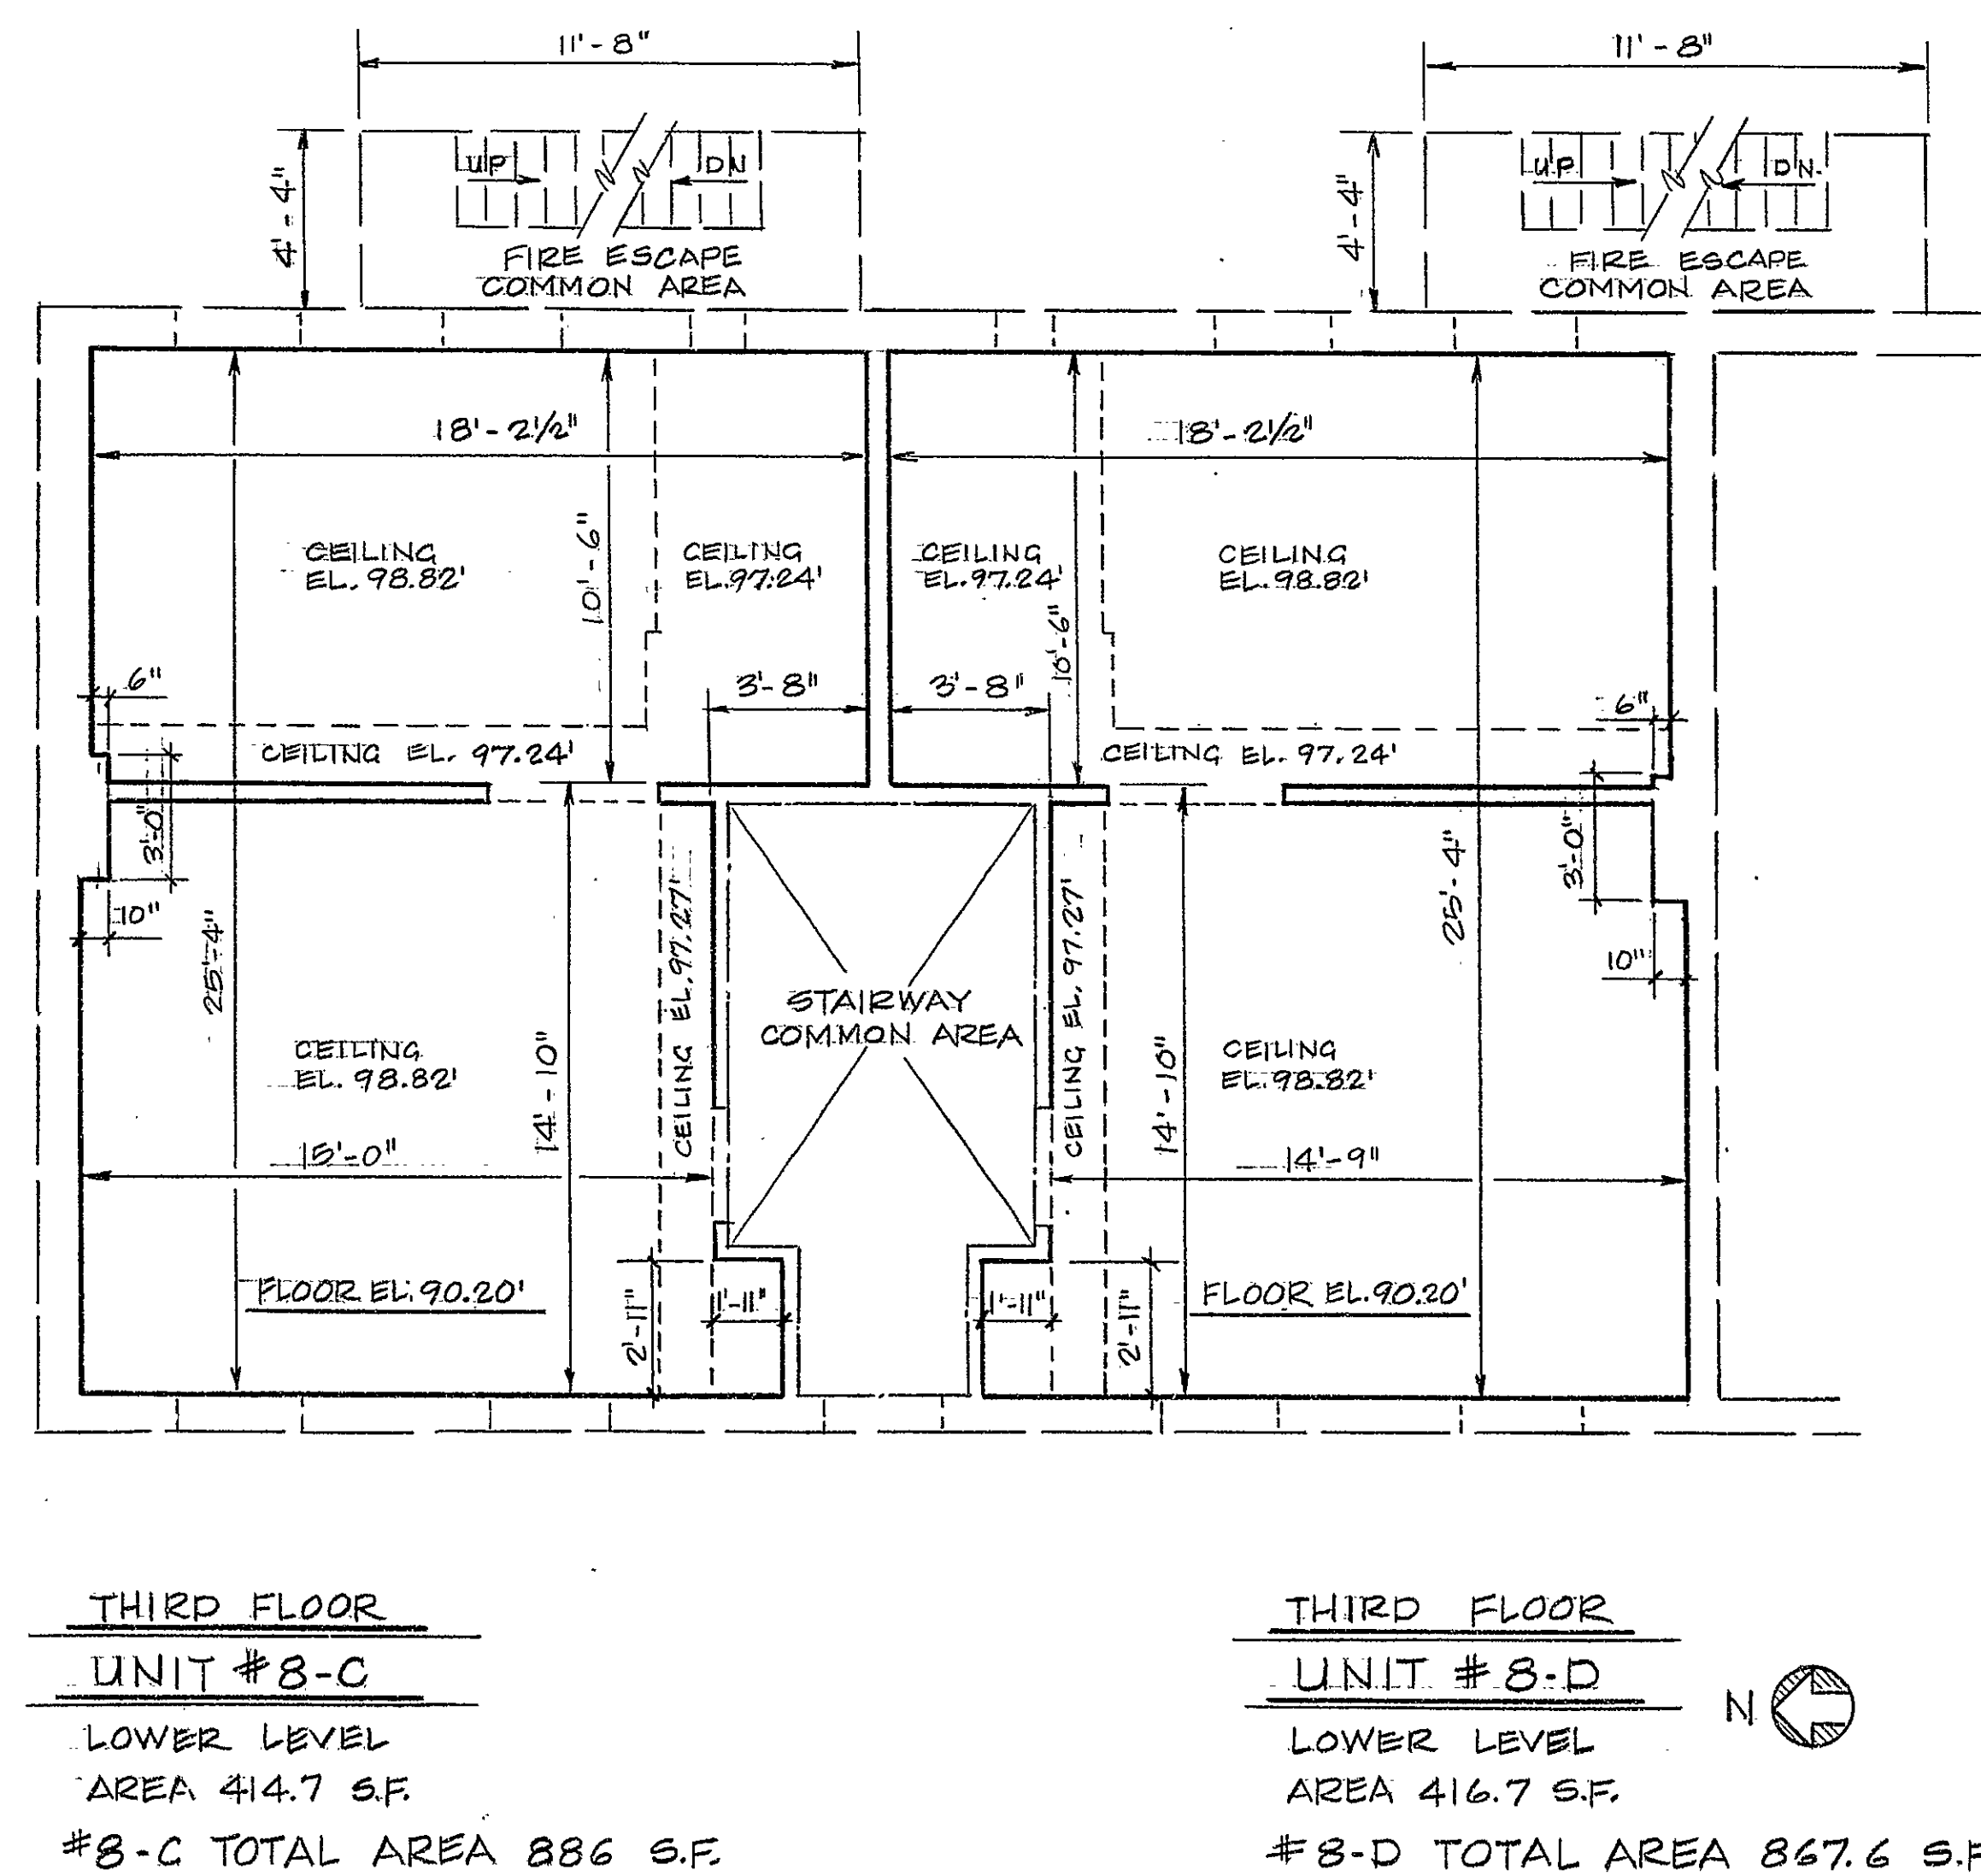
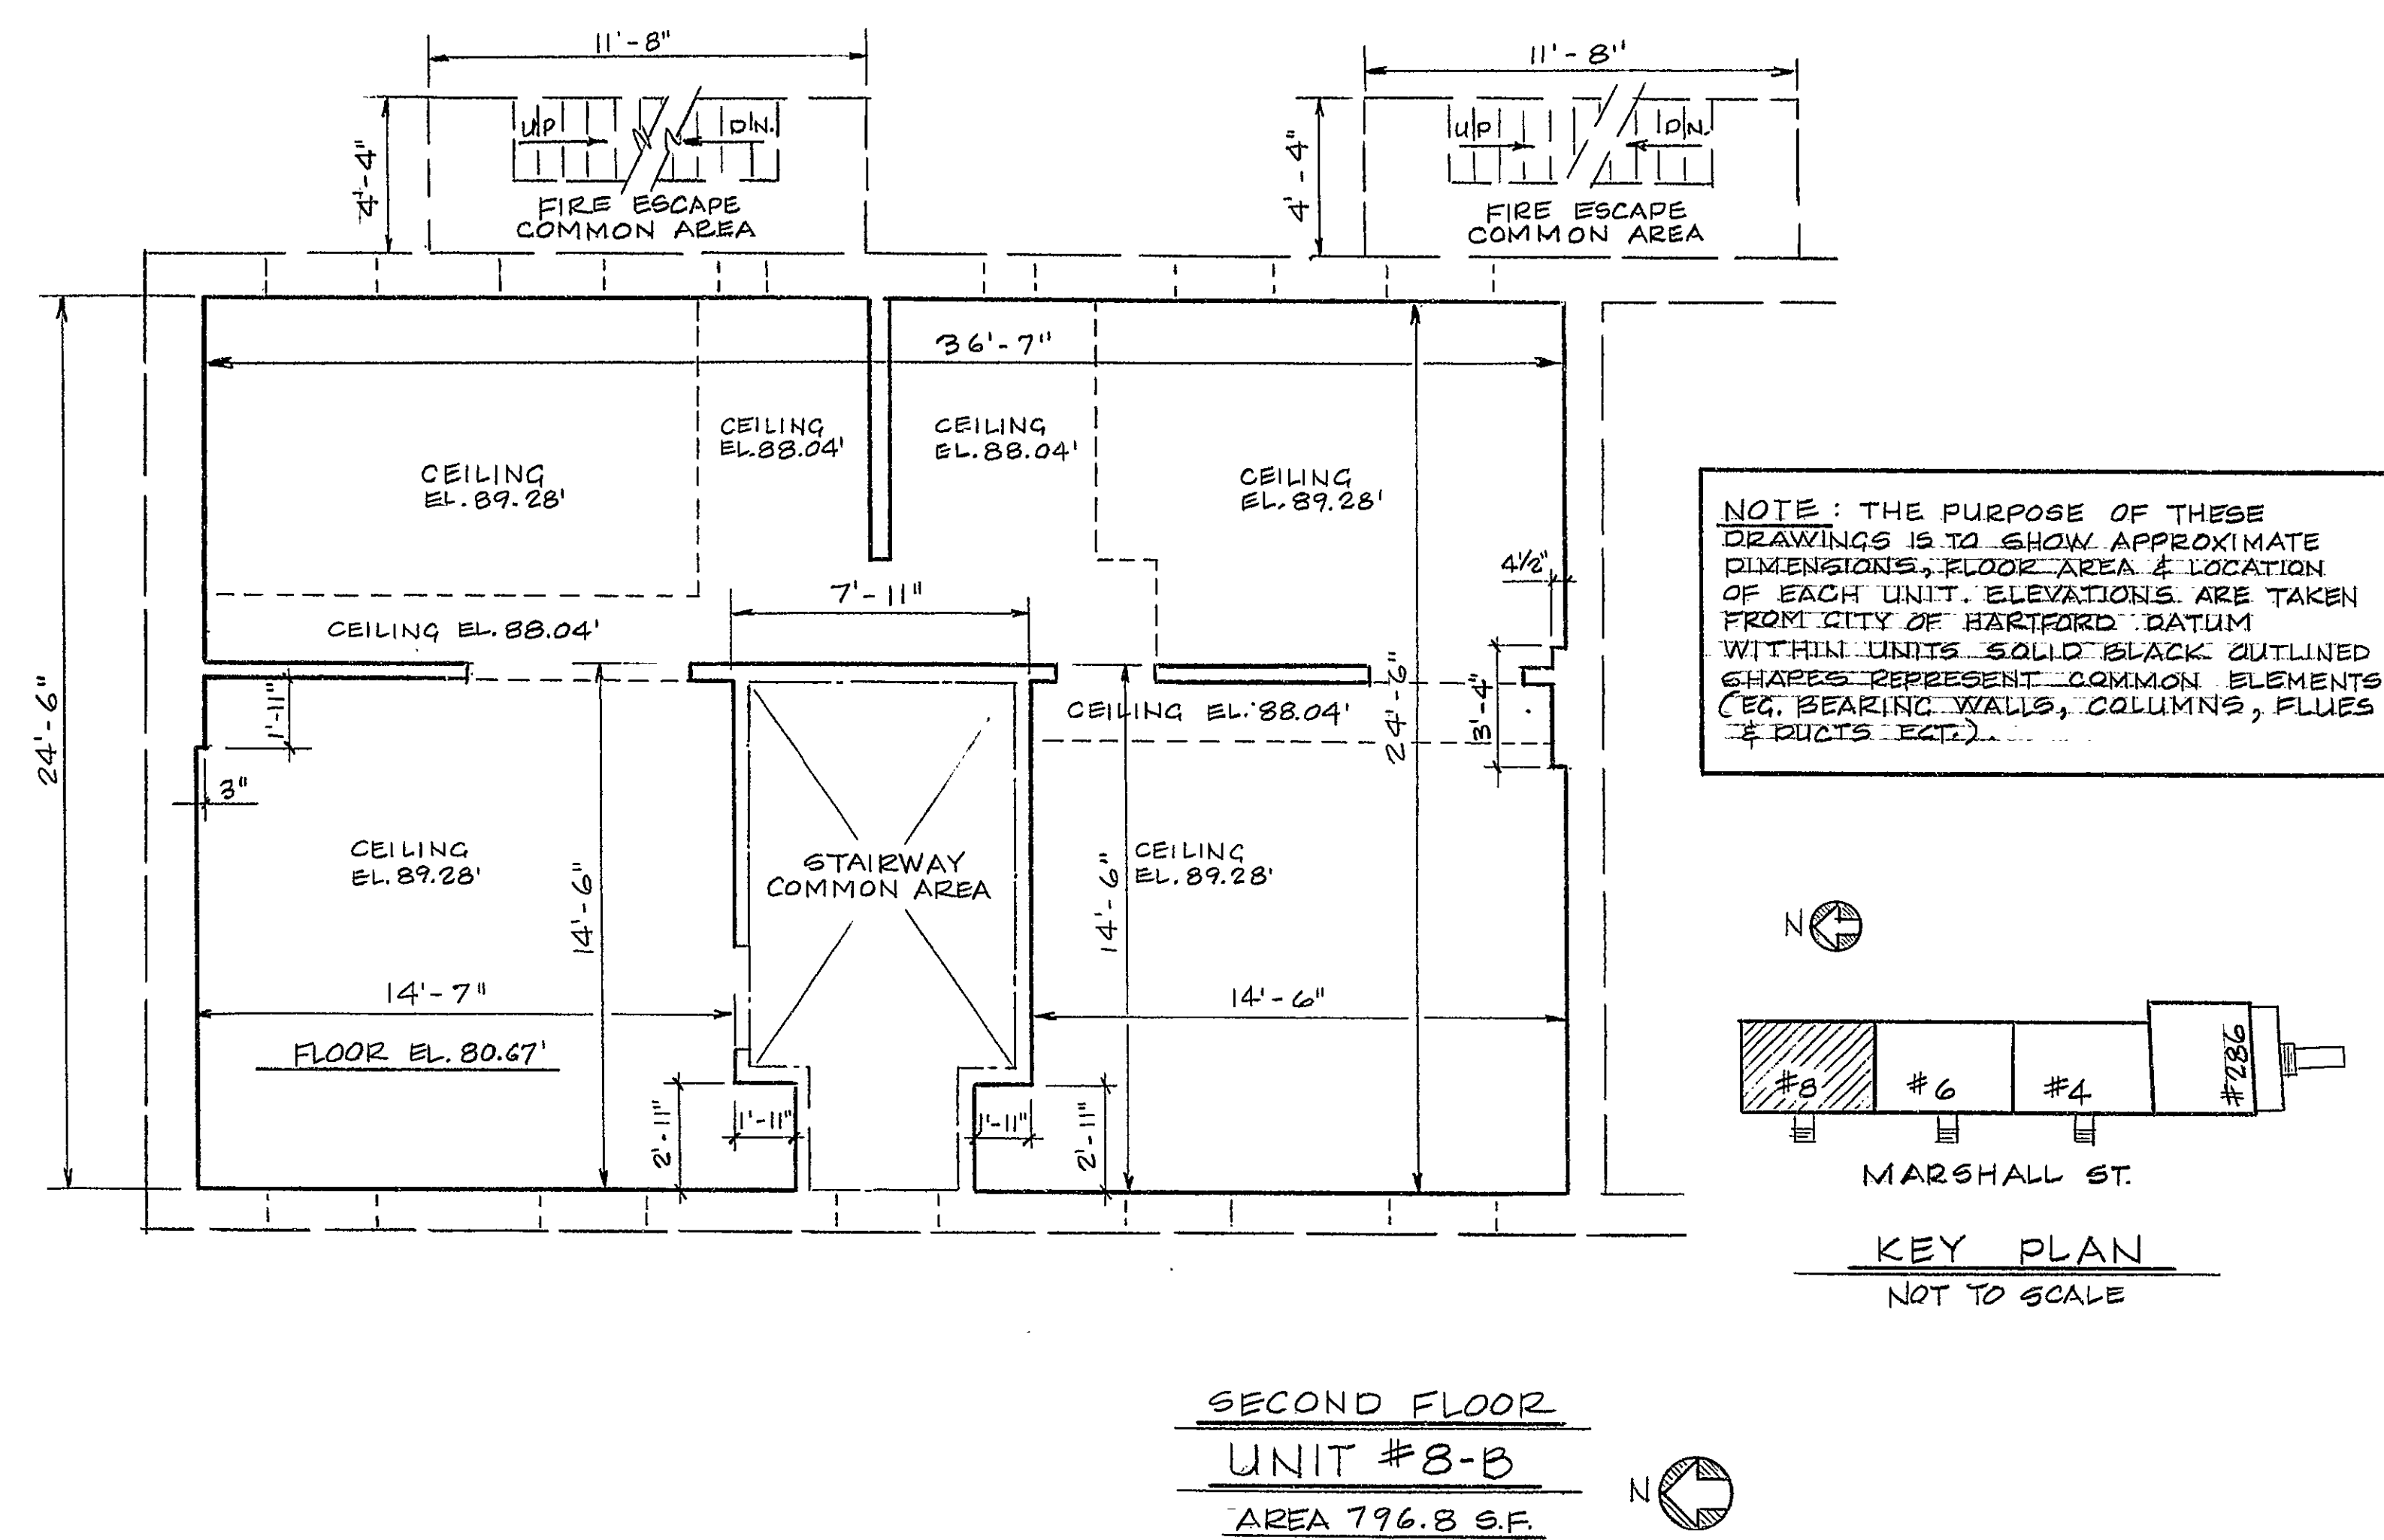
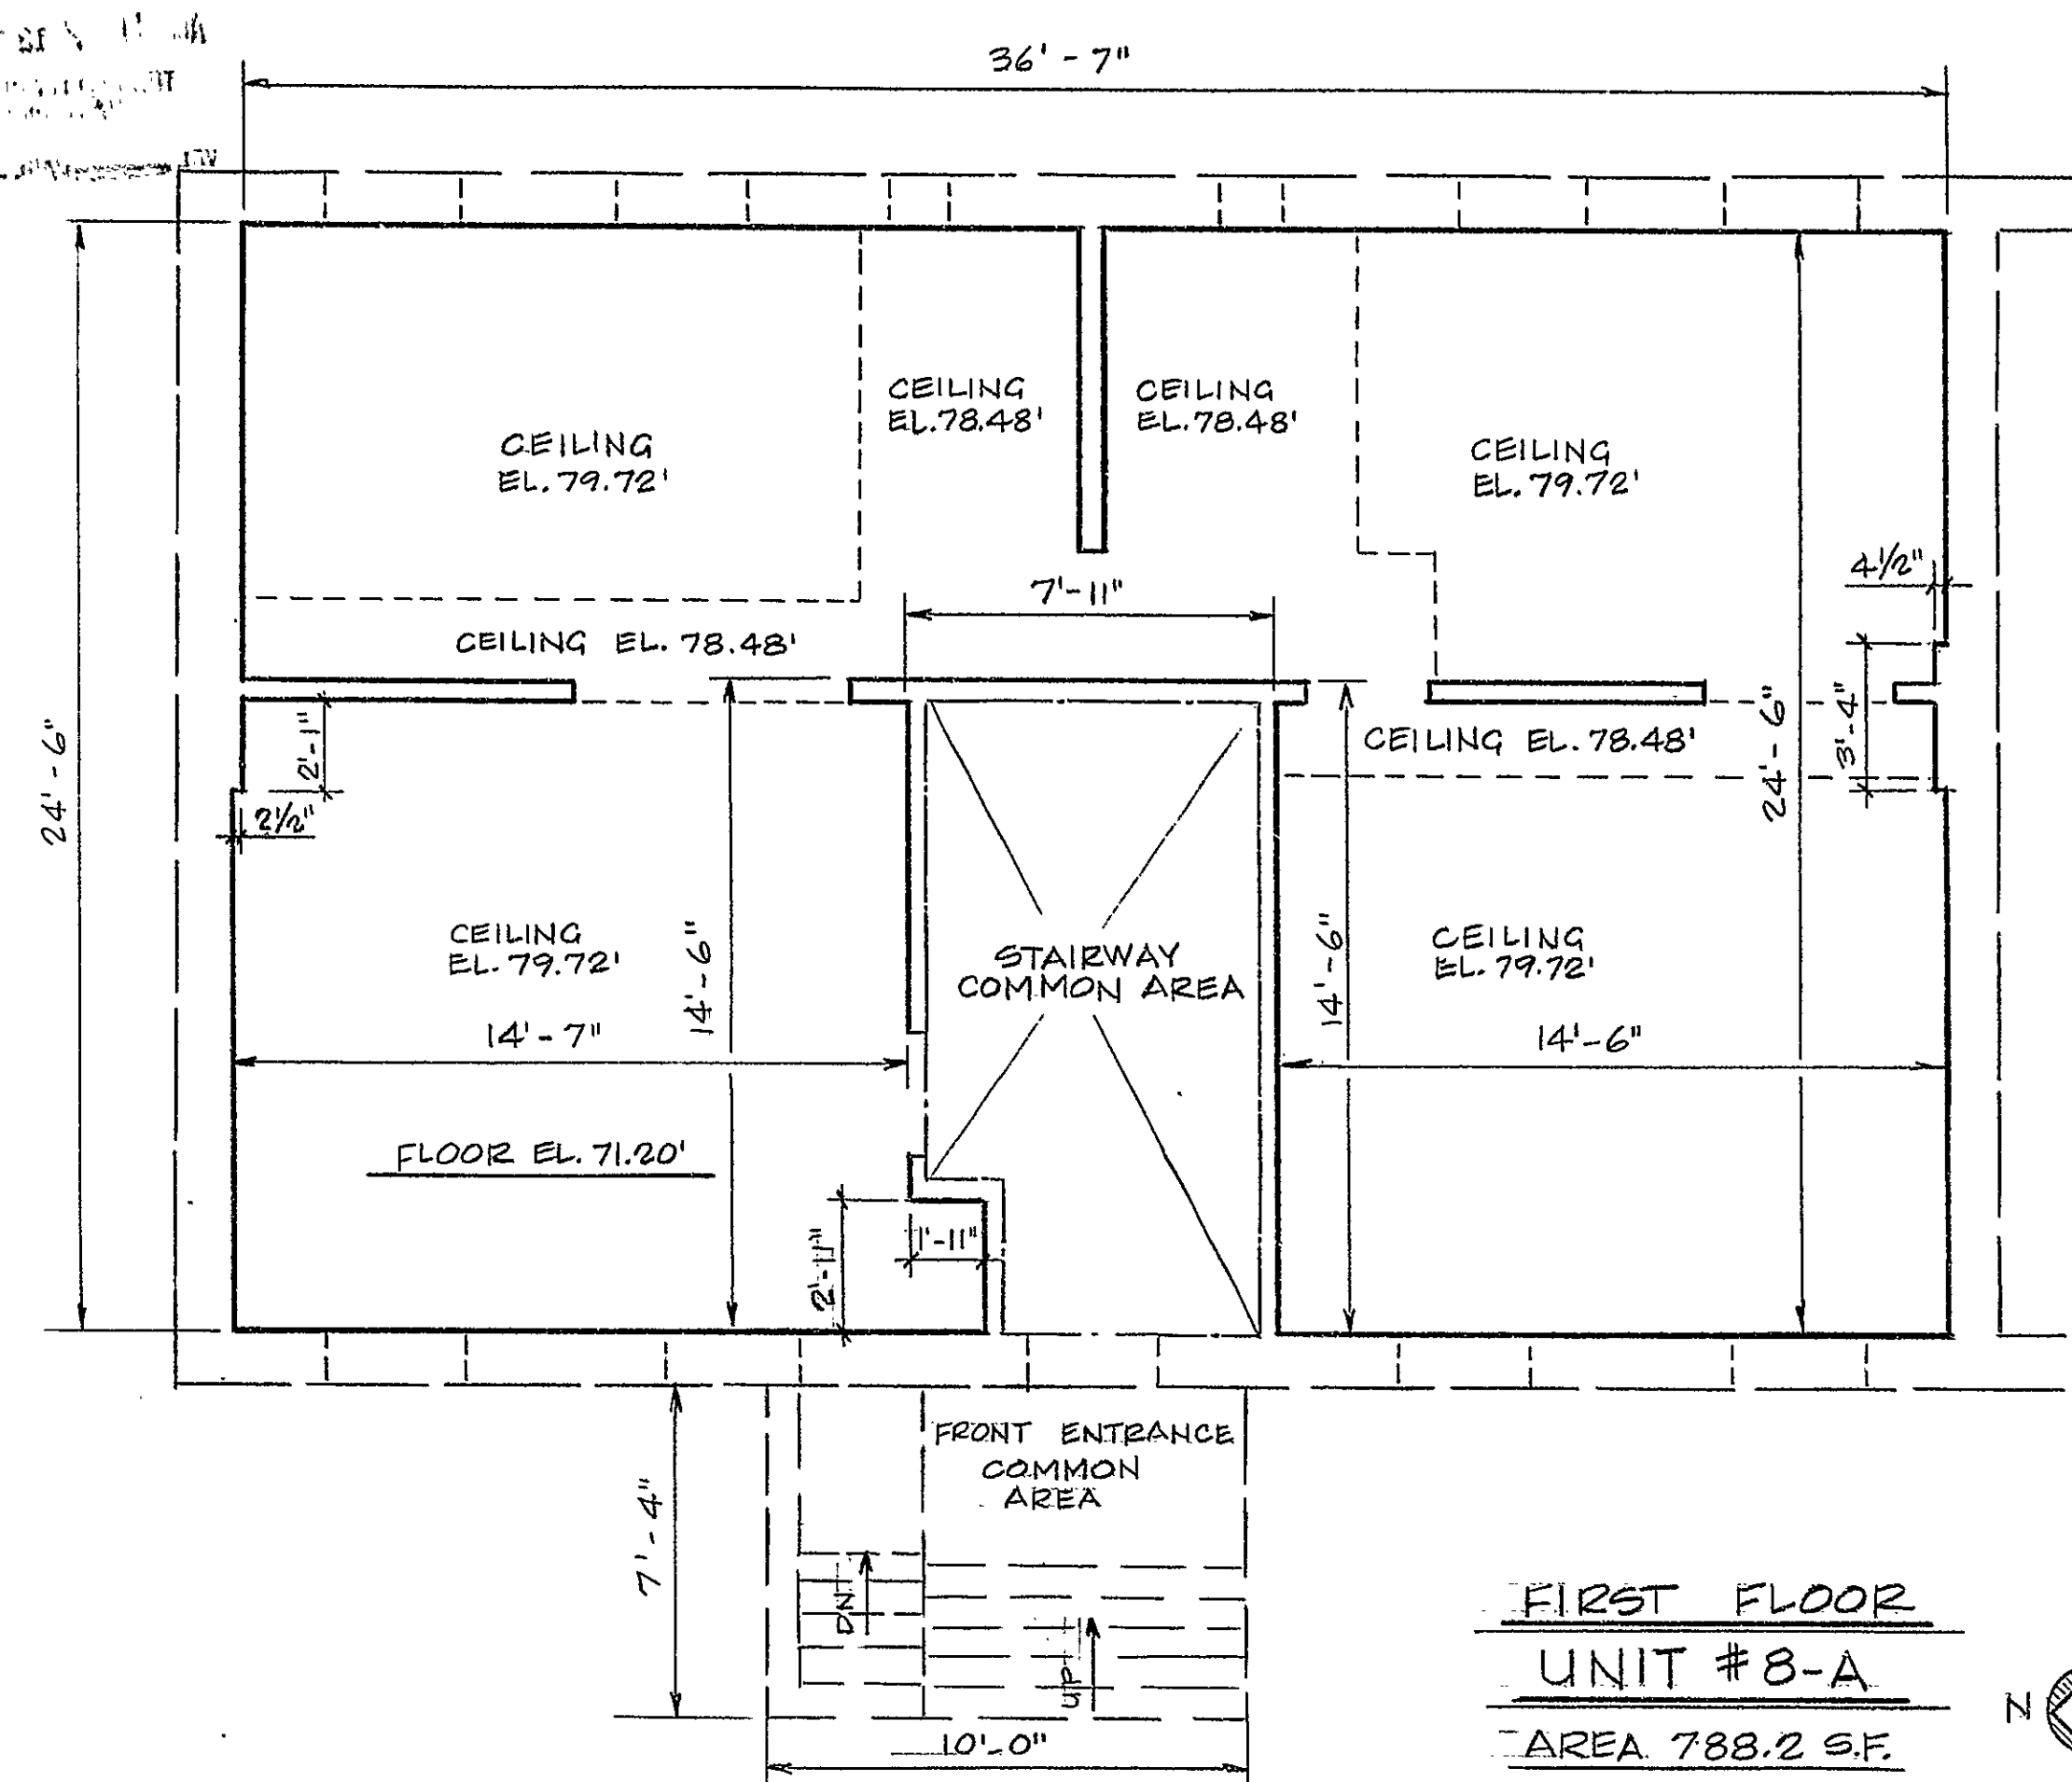


NOTE : THE PURPOSE OF THESE DRAWINGS IS TO SHOW APPROXIMATE DIMENSIONS, FLOOR AREA & LOCATION OF EACH UNIT. ELEVATIONS ARE TAKEN FROM CITY OF HARTFORD DATUM WITHIN UNITS. SOLID BLACK OUTLINED SHAPES REPRESENT COMMON ELEMENTS (EG. BEARING WALLS, COLUMNS, FLUES & DUCTS EGT.).

MARSHALL ST.
KEY PLAN
NOT TO SCALE

FARMINGTON AVE

LEGEND

---	EXTERIOR WALLS OF BUILDING.
---	UNIT BOUNDARY
---	COMMON AREA
---	CEILING OR FLOOR ELEVATION CHANGE

SCALE IN FEET

GEORGETOWN MANOR
CONDOMINIUM
286 FARMINGTON AVE. # 4, 6, 8
HARTFORD, CONNECTICUT
LOUIS J. COLAVECCHIO A.I.A., ARCHITECT

5

0	1	2	4	8	NOTARY PUBLIC --	James

21	
----	--