


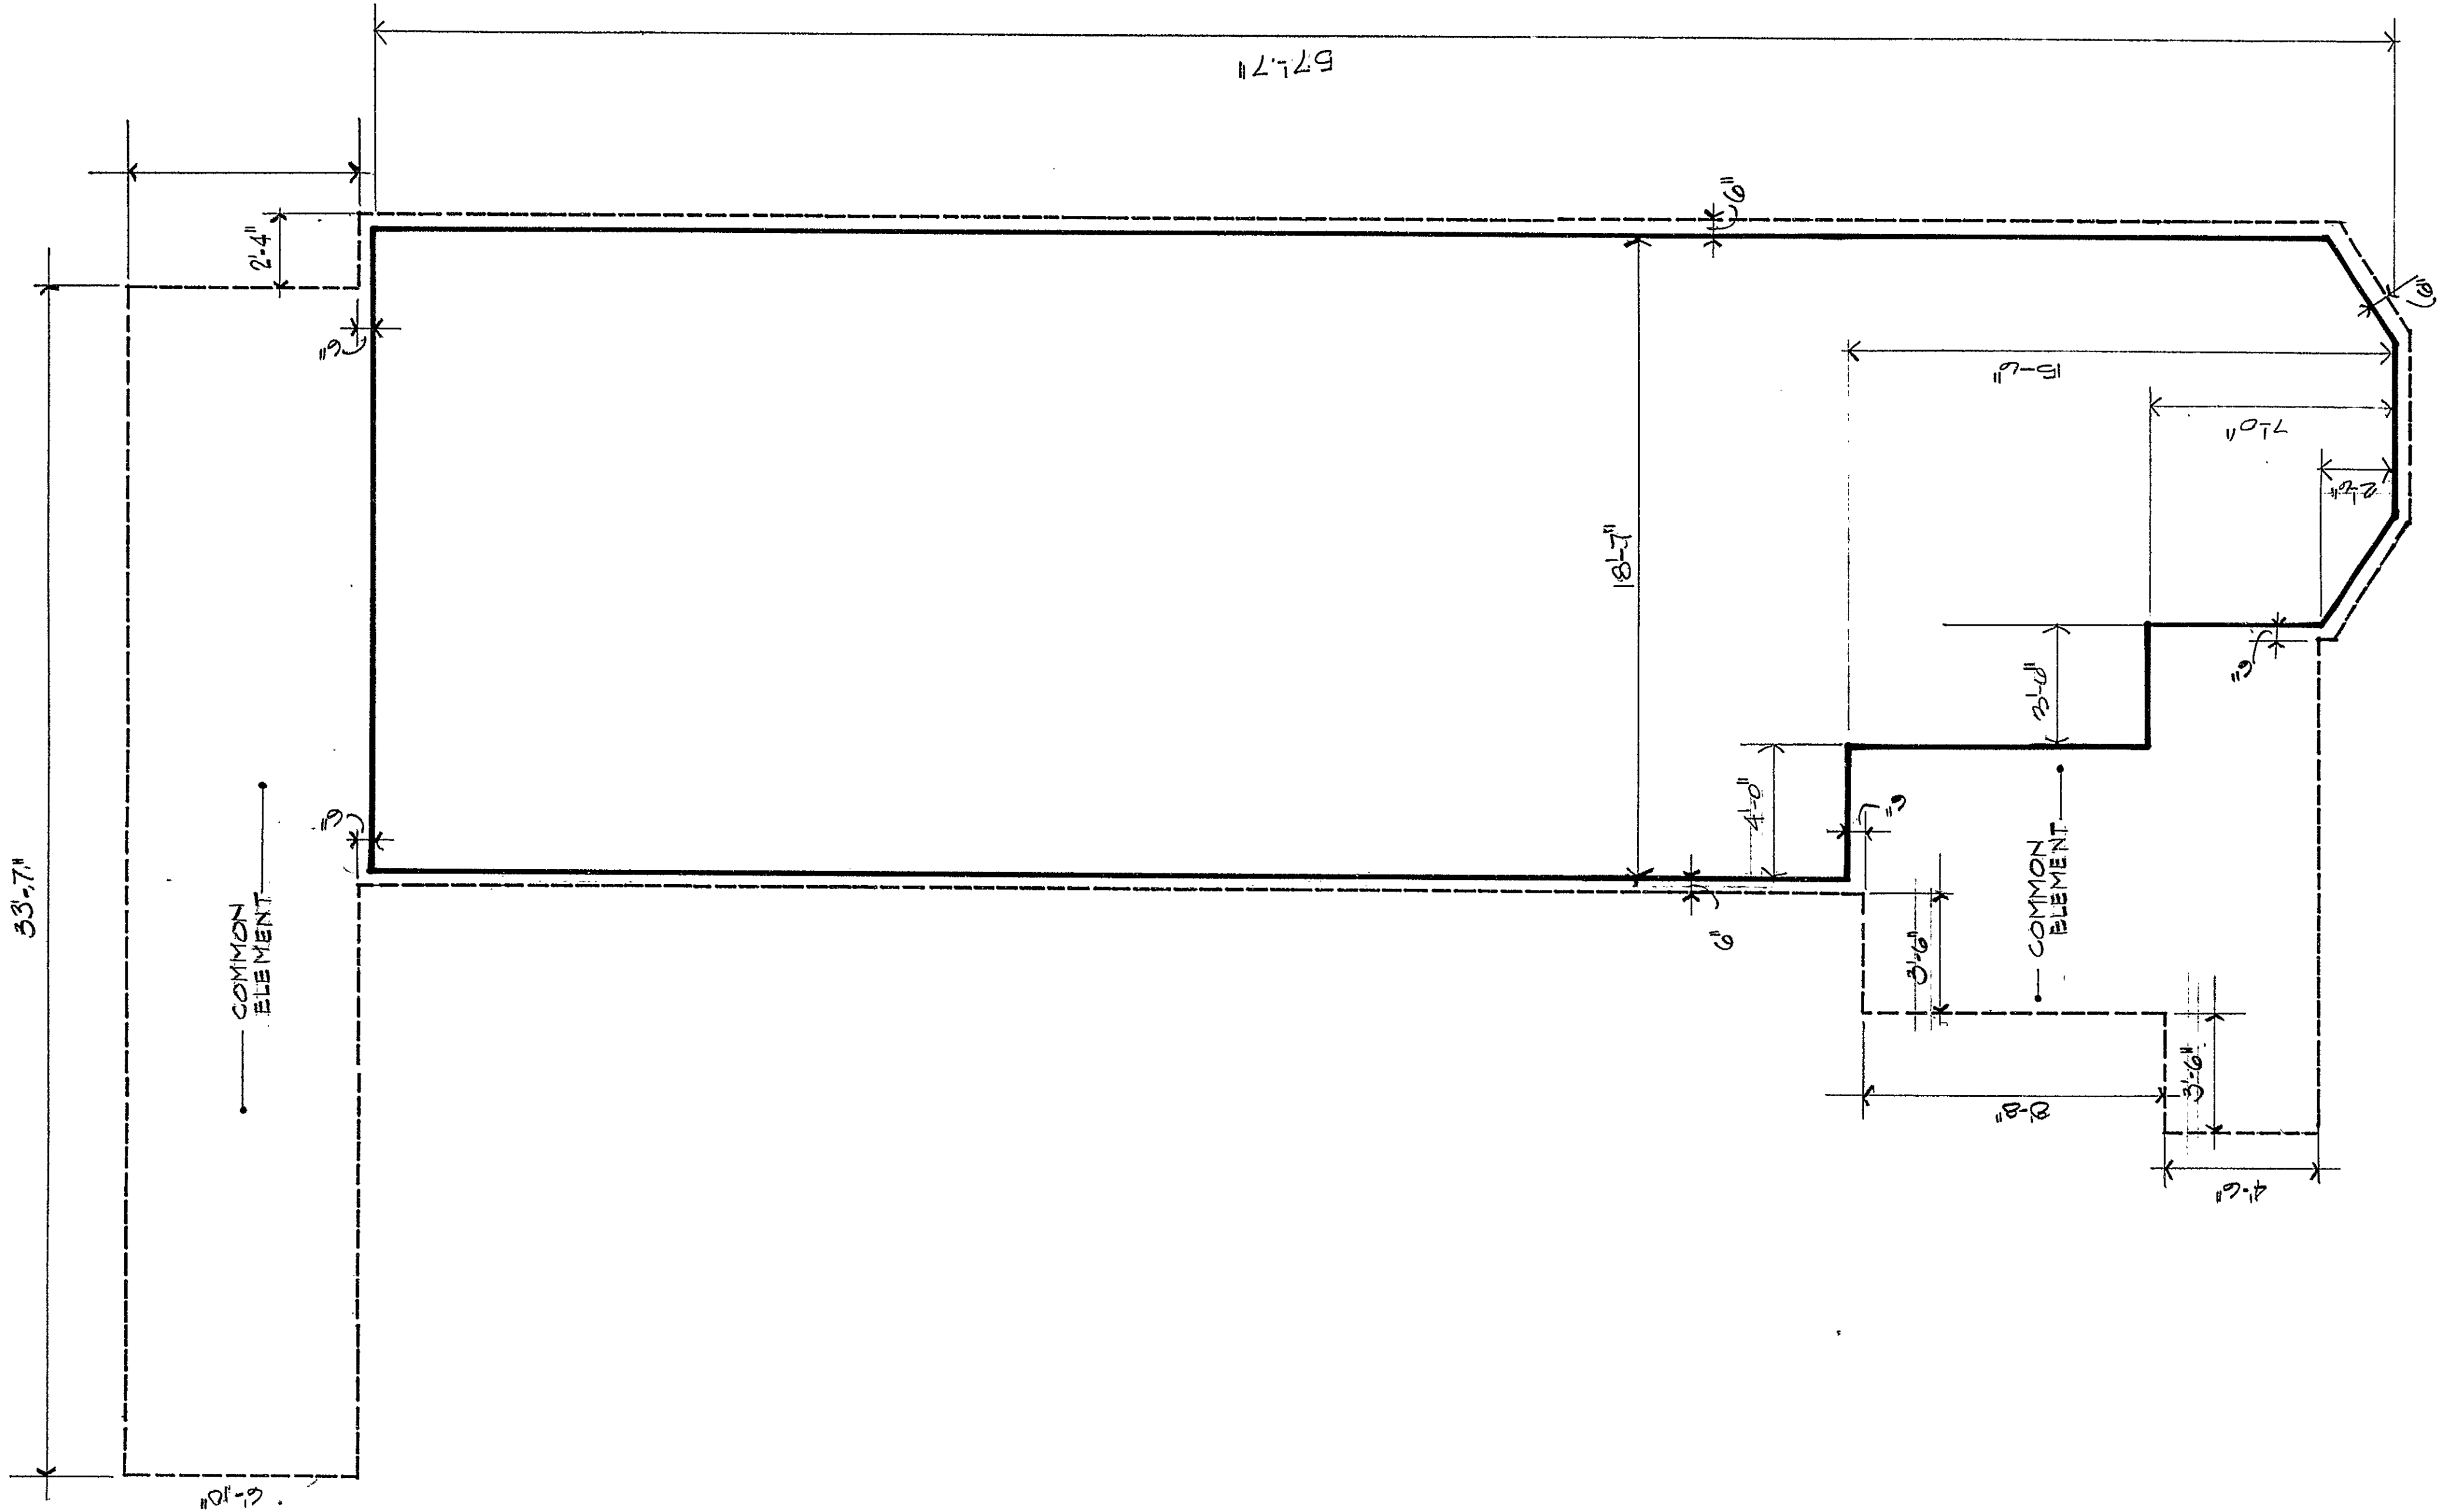

B		5 of 6	
units 2, 3, 5		no. of rooms	
CAPITOL AVENUE CONDOMINIUMS		4	
CAPITOL AVE		interior boundaries	
HARTFORD CONN		exterior conditions	
project		scale	
9'-0"		1010	
floor height		square footage	

CERTIFIED TO BE AN ACCURATE COPY OF THE ORIGINAL AS SHOWN TO THE CITY OF HARTFORD BUILDING DEPARTMENT.

DOUGLAS MOSER - ARCHITECT
DATE: 10/1/91

STATE OF CONNECTICUT
COUNTY OF TOLLAND ss:
I, DOUGLAS MOSER, ARCHITECT
WHO HAS SOLEMNLY AFFIRMED TO THE TRUTH OF THE STATEMENT TO WHICH HIS NAME IS SUBSCRIBED.

Commissioner of the Superior Court

Condo Floor Plan #22

