


RECEIVED
CITY OF HARTFORD
BUILDING DEPARTMENT
DATE: 10/1/91

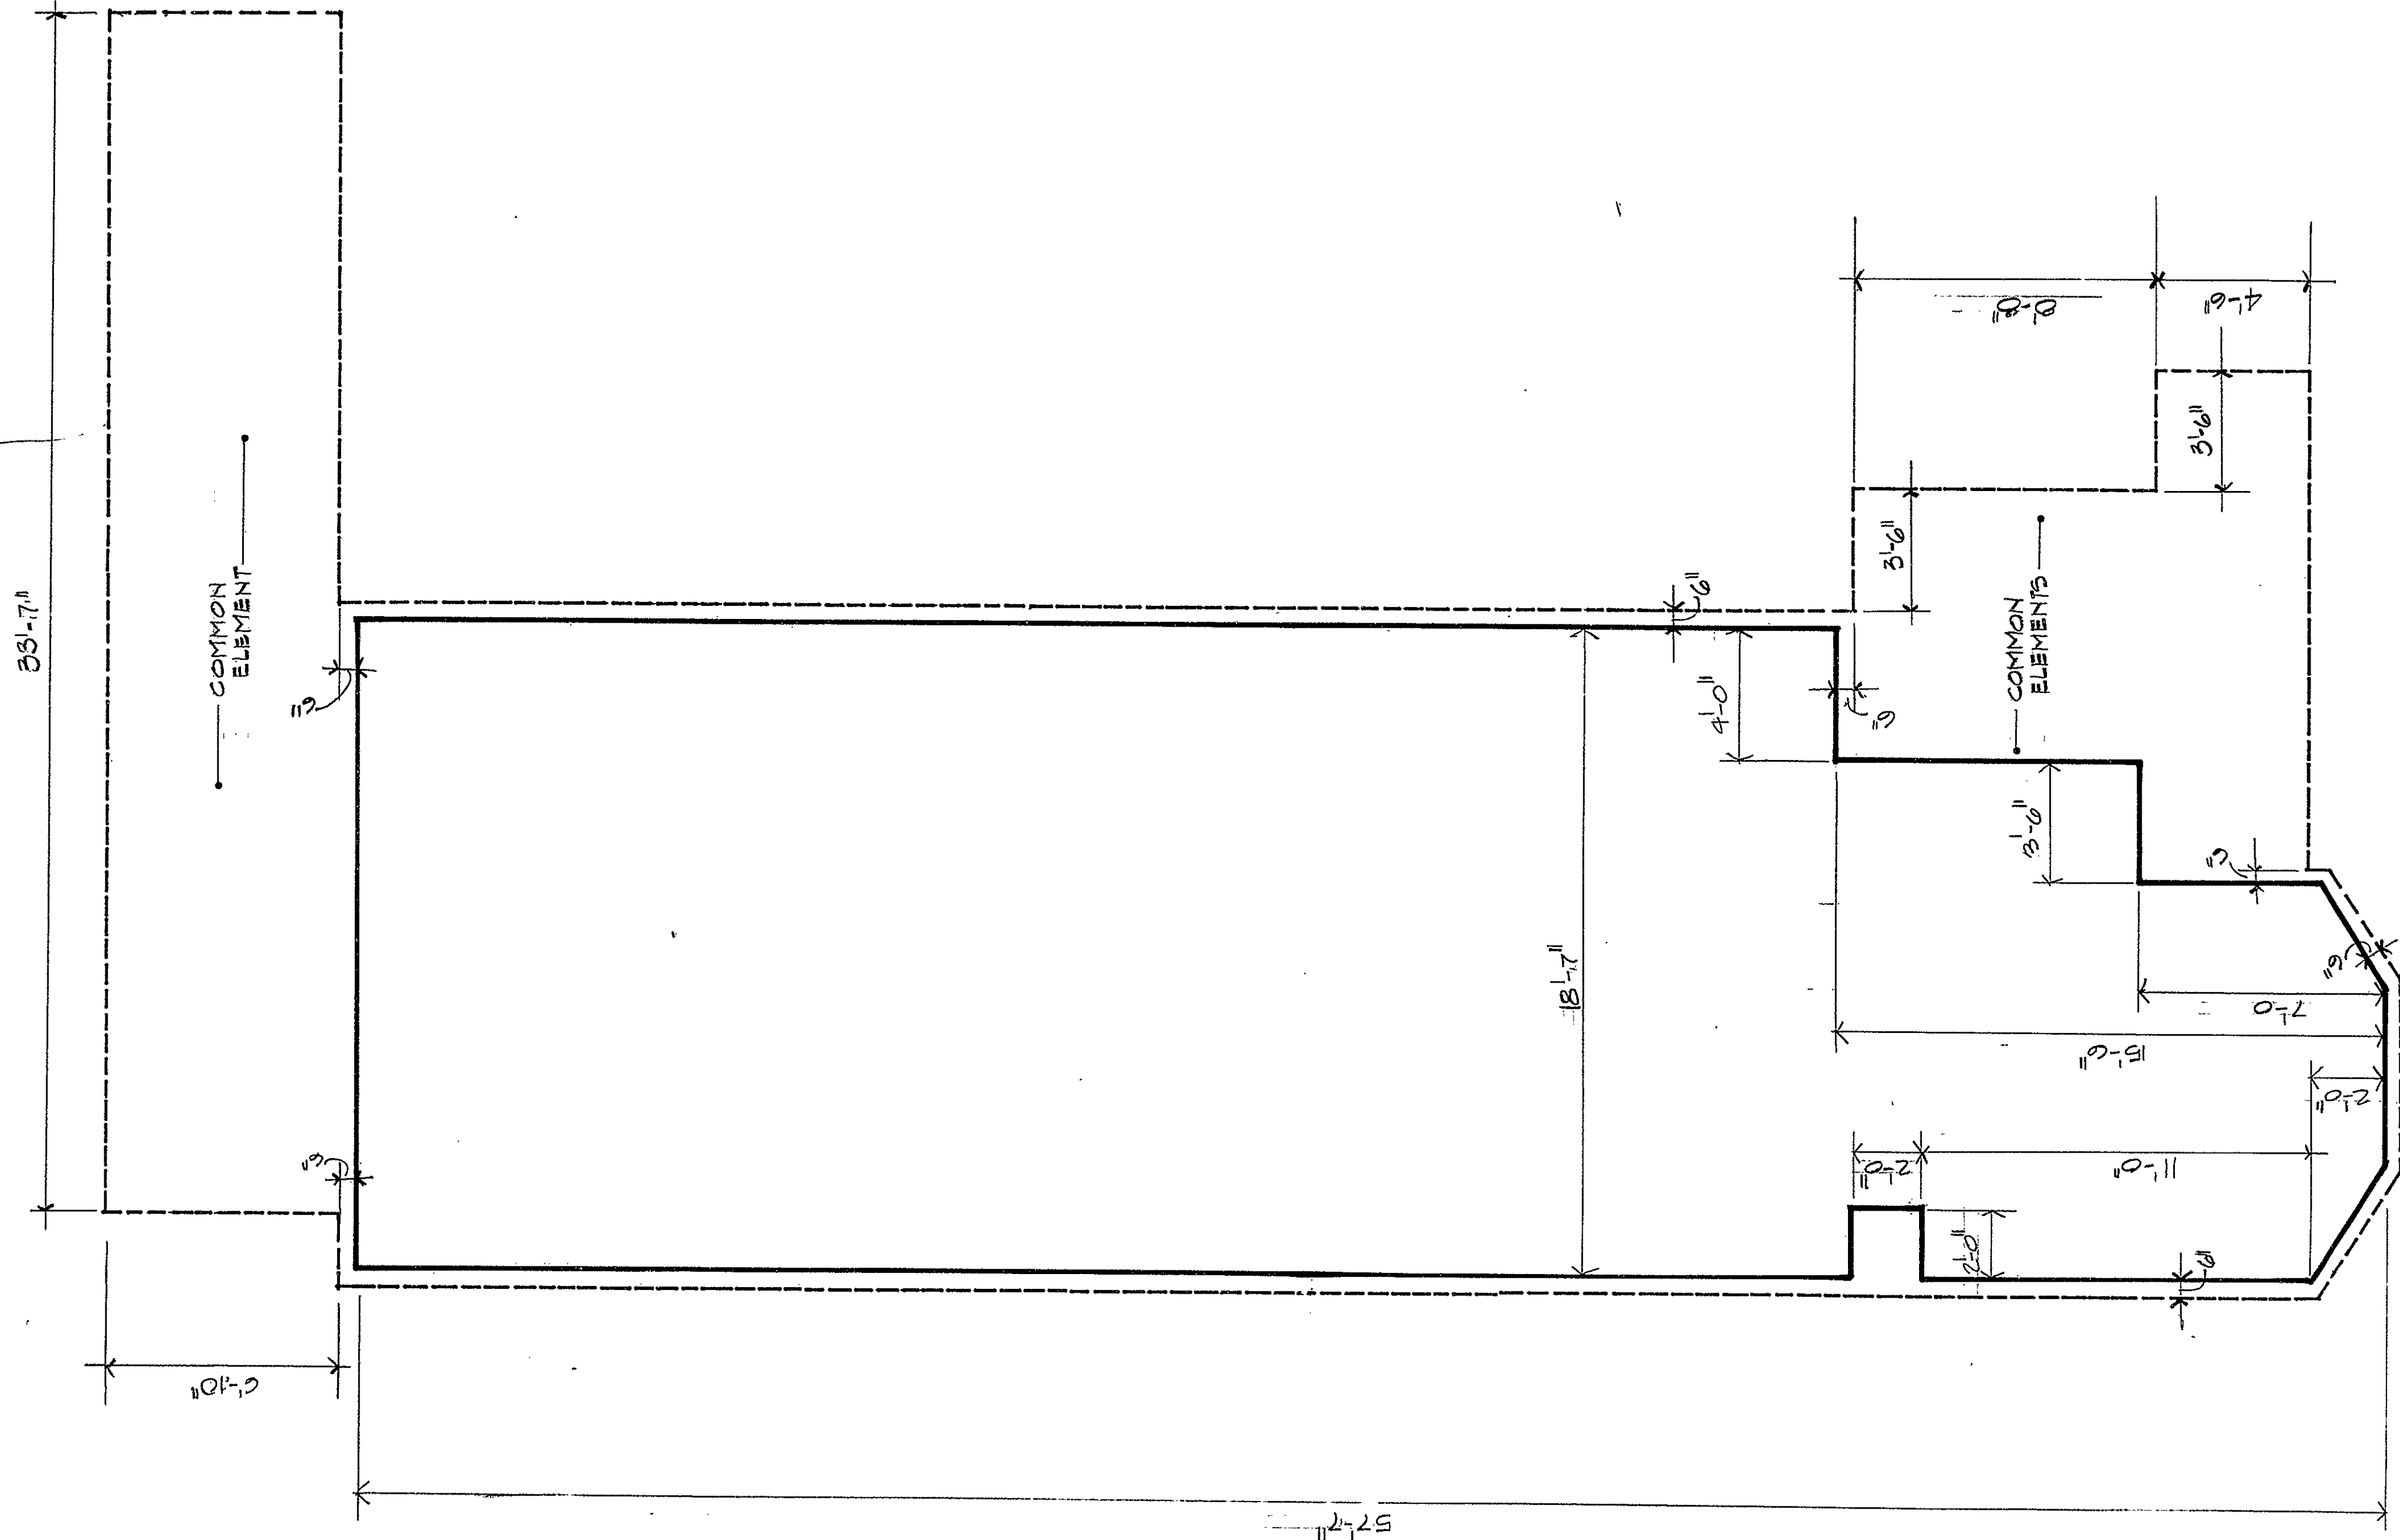

Condo Floor Plan # 22

CERTIFIED TO BE AN ACCURATE COPY OF THE RECORDS ON FILE WITH THE CITY OF HARTFORD BUILDING DEPARTMENT.
DOUGLAS MOSER - ARCHITECT
DATE: 10/1/91
VERIFICATION
STATE OF CONNECTICUT
COUNTY OF TOLLAND ss:
VERNON, CONNECTICUT
PERSONALLY APPEARED DOUGLAS MOSER
WHO HAS SOLEMNLY AFFIRMED TO THE TRUTH OF THE STATEMENT TO WHICH HIS NAME IS SUBSCRIBED.
DANIEL A. ROBERTS
COMMISSIONER OF THE SUPERIOR COURT

9'-0"	1010	1' 2' 3' 4' 5'	10'	no. of rooms	4	6 of 6	B
floor height	square footage	scale	key	Interior boundaries	exterior conditions	no. of rooms	Unit 1, 4, 5