


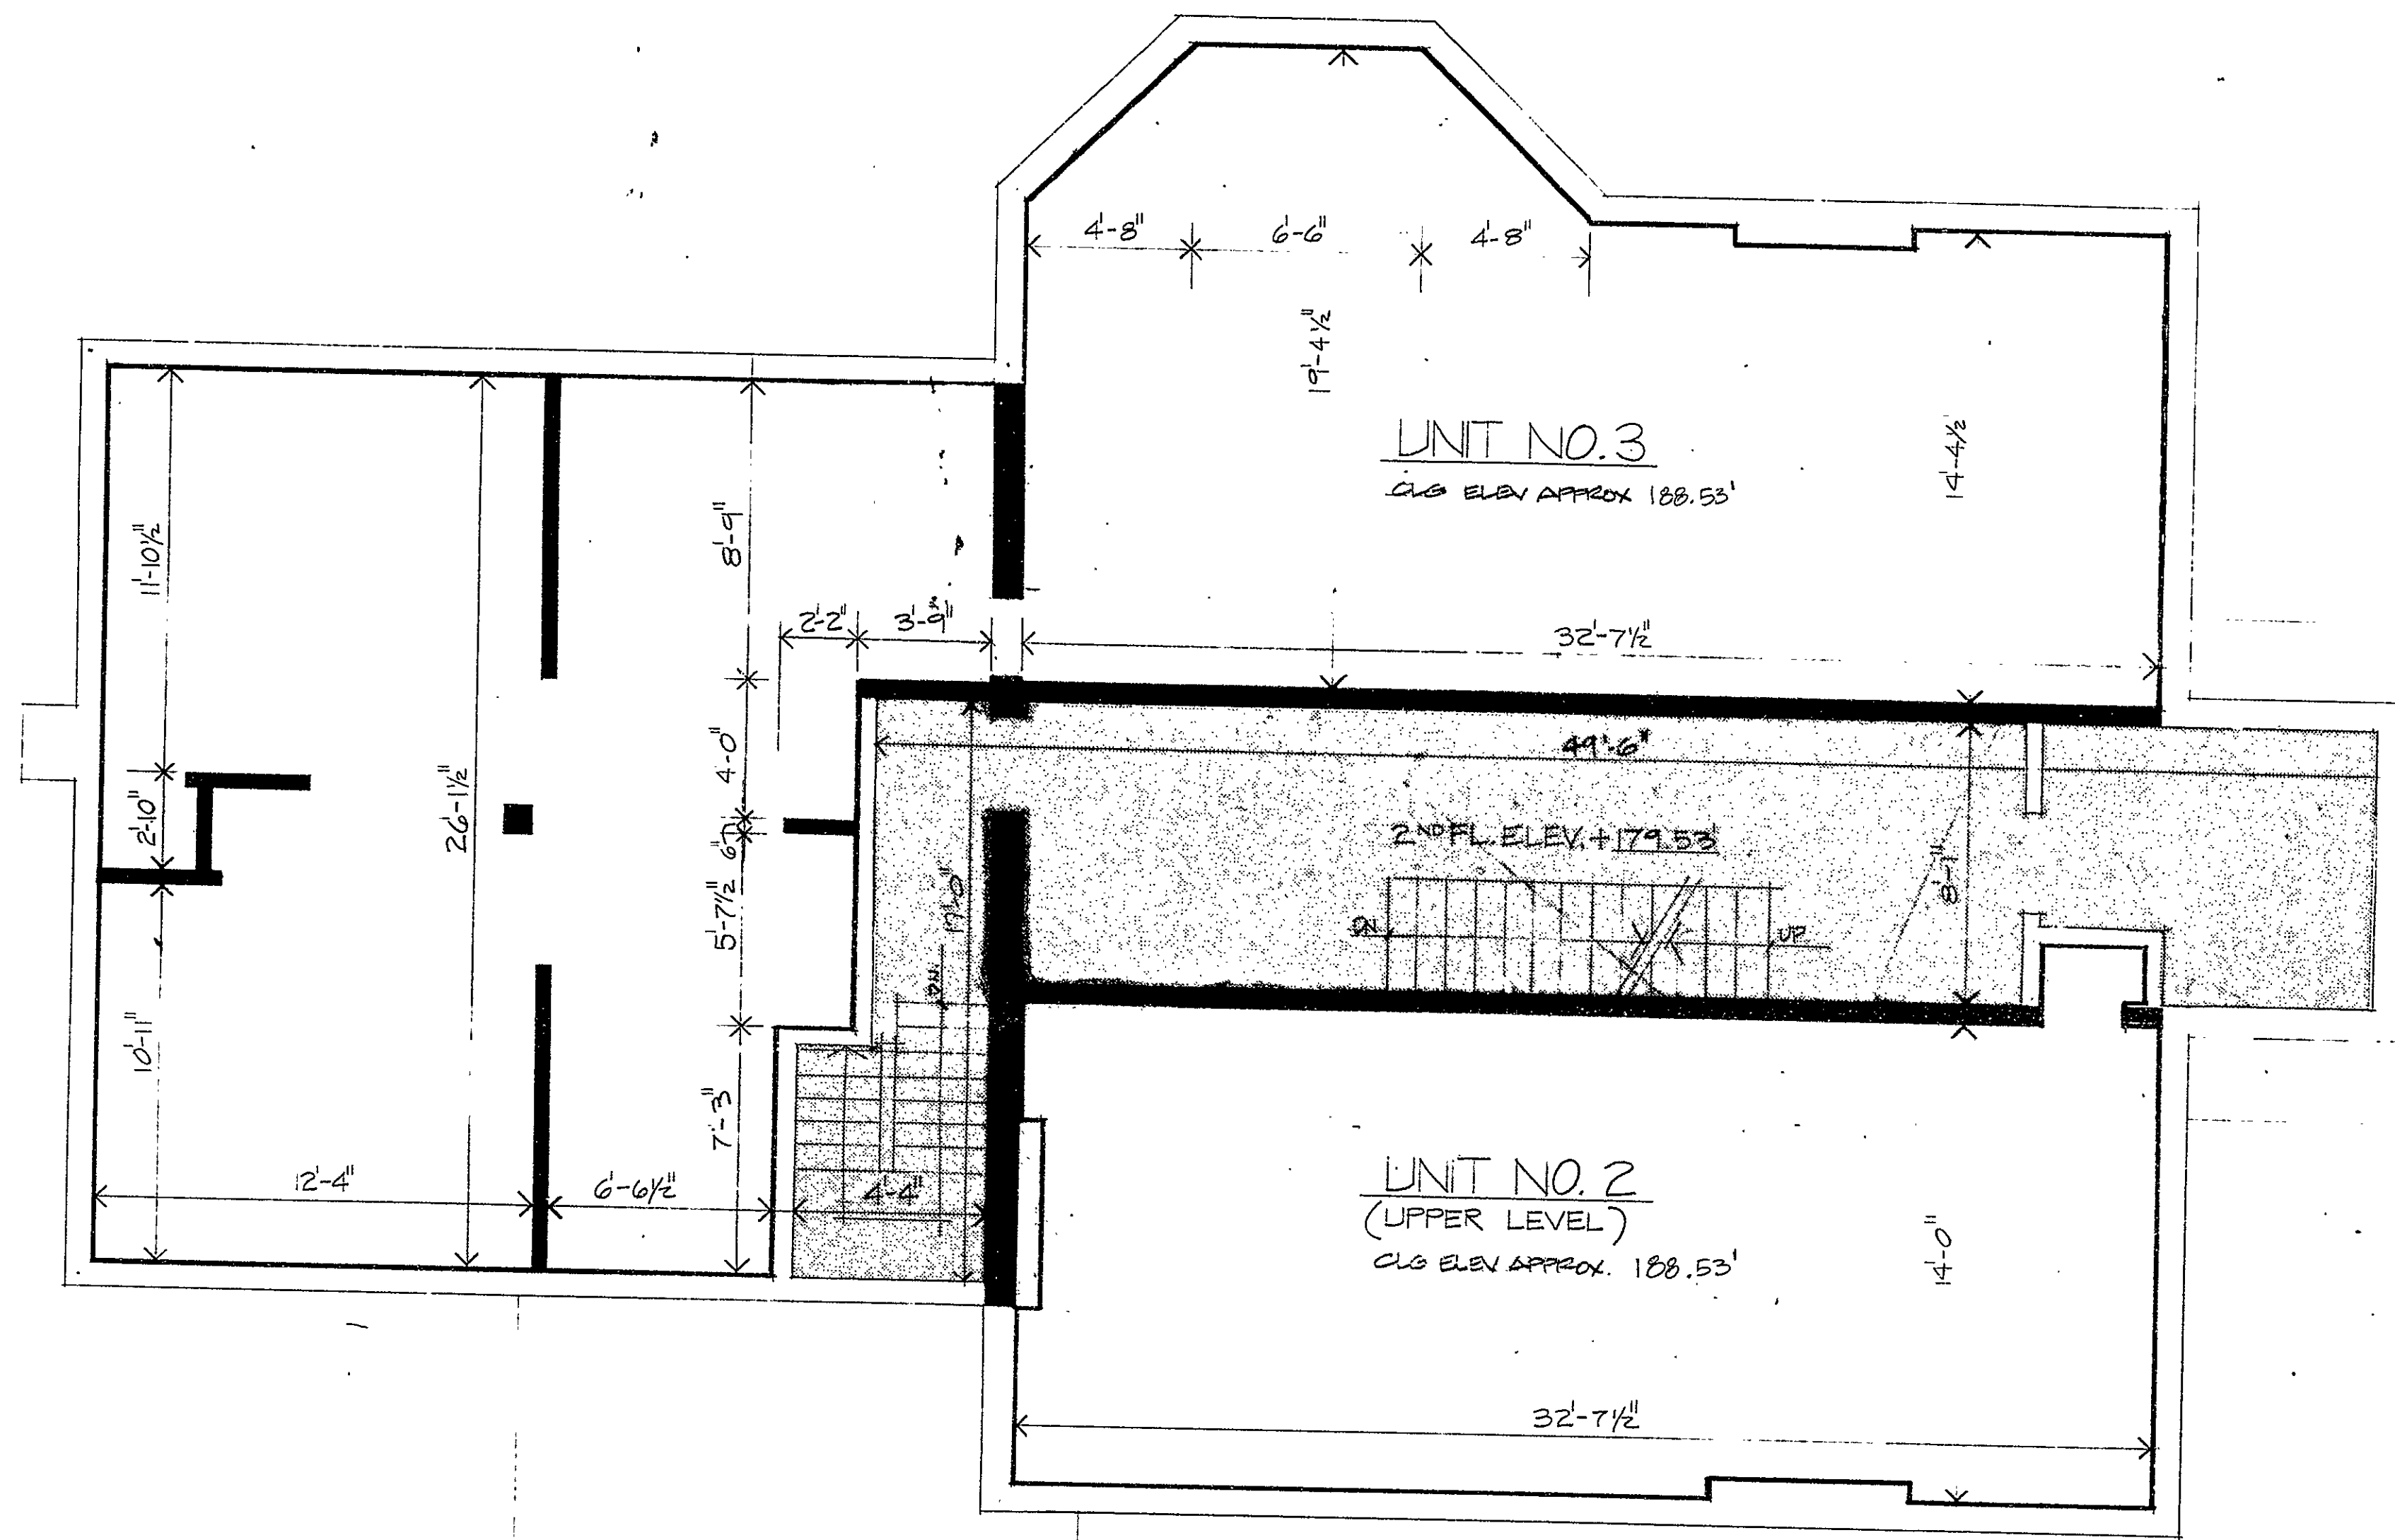

SECOND FLOOR PLAN
SCALE: 1/4" = 1'-0"

AREA OF UNIT
UNIT 3 1127.58 SF.

LEGEND

- BEARING WALLS
- LIMIT OF UNIT
- COMMON ELEMENT (SHADED AREA)

0 INCHES 1 2 3 4

23-1

RECEIVED BY
DATE
TIME
BY



FAIRFELD - 0.5E
A CONVERSION CONDO UNIT

STATE OF CONNECTICUT
COUNTY OF HARTFORD
SS WEST HARTFORD
PERSONALLY APPEARED LEN GELBAND, SOLE OF THE FOREGOING
DATE AND BEING FULLY SWORN, MADE SOLEMN OATH TO THE
OFFICE OF THE CLERK OF THE SUPERIOR COURT OF THE
STATE OF CONNECTICUT, COUNTY OF HARTFORD, JUDICIAL DISTRICT OF THE
SOUTHWEST, THAT HE IS THE OWNER OF THE ABOVE DESCRIBED
CONDO UNIT #23.

Condo # 23

DATE: 13 MARCH 1980
I CERTIFY THAT THESE
DRAWINGS ARE AN ACCURATE
COPY OF PLANS FILED WITH
THE BUILDING DEPT. OF
THE CITY OF HARTFORD
Len Gelband

ARCHITECTS
VANCEBAND
EX-3 T F-1
SEE 2 OF 4
363 Park Road, West Hartford, CT 06119

23
10 MARCH 1980 THU 1980