

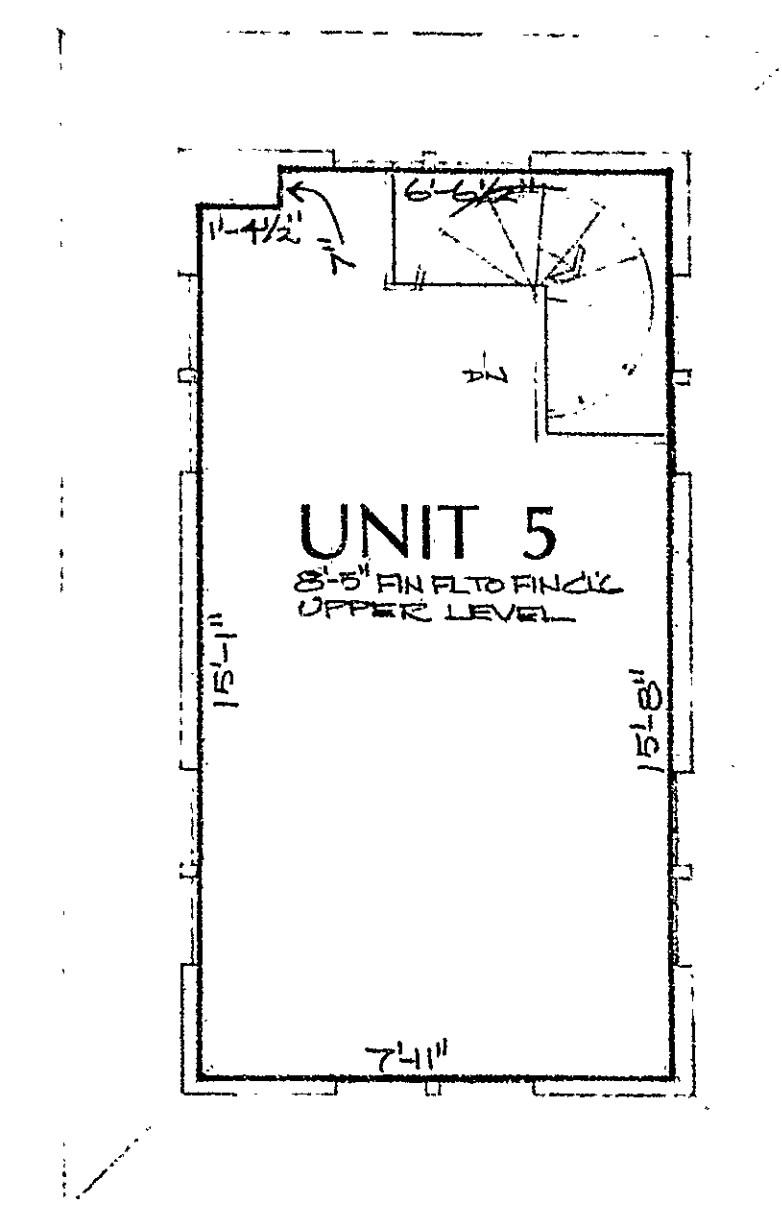


RECEIVED BY
 JUN 18 4 53 AM '82
 TOWN & CITY CLERK
 HARTFORD
 VOL PAGE

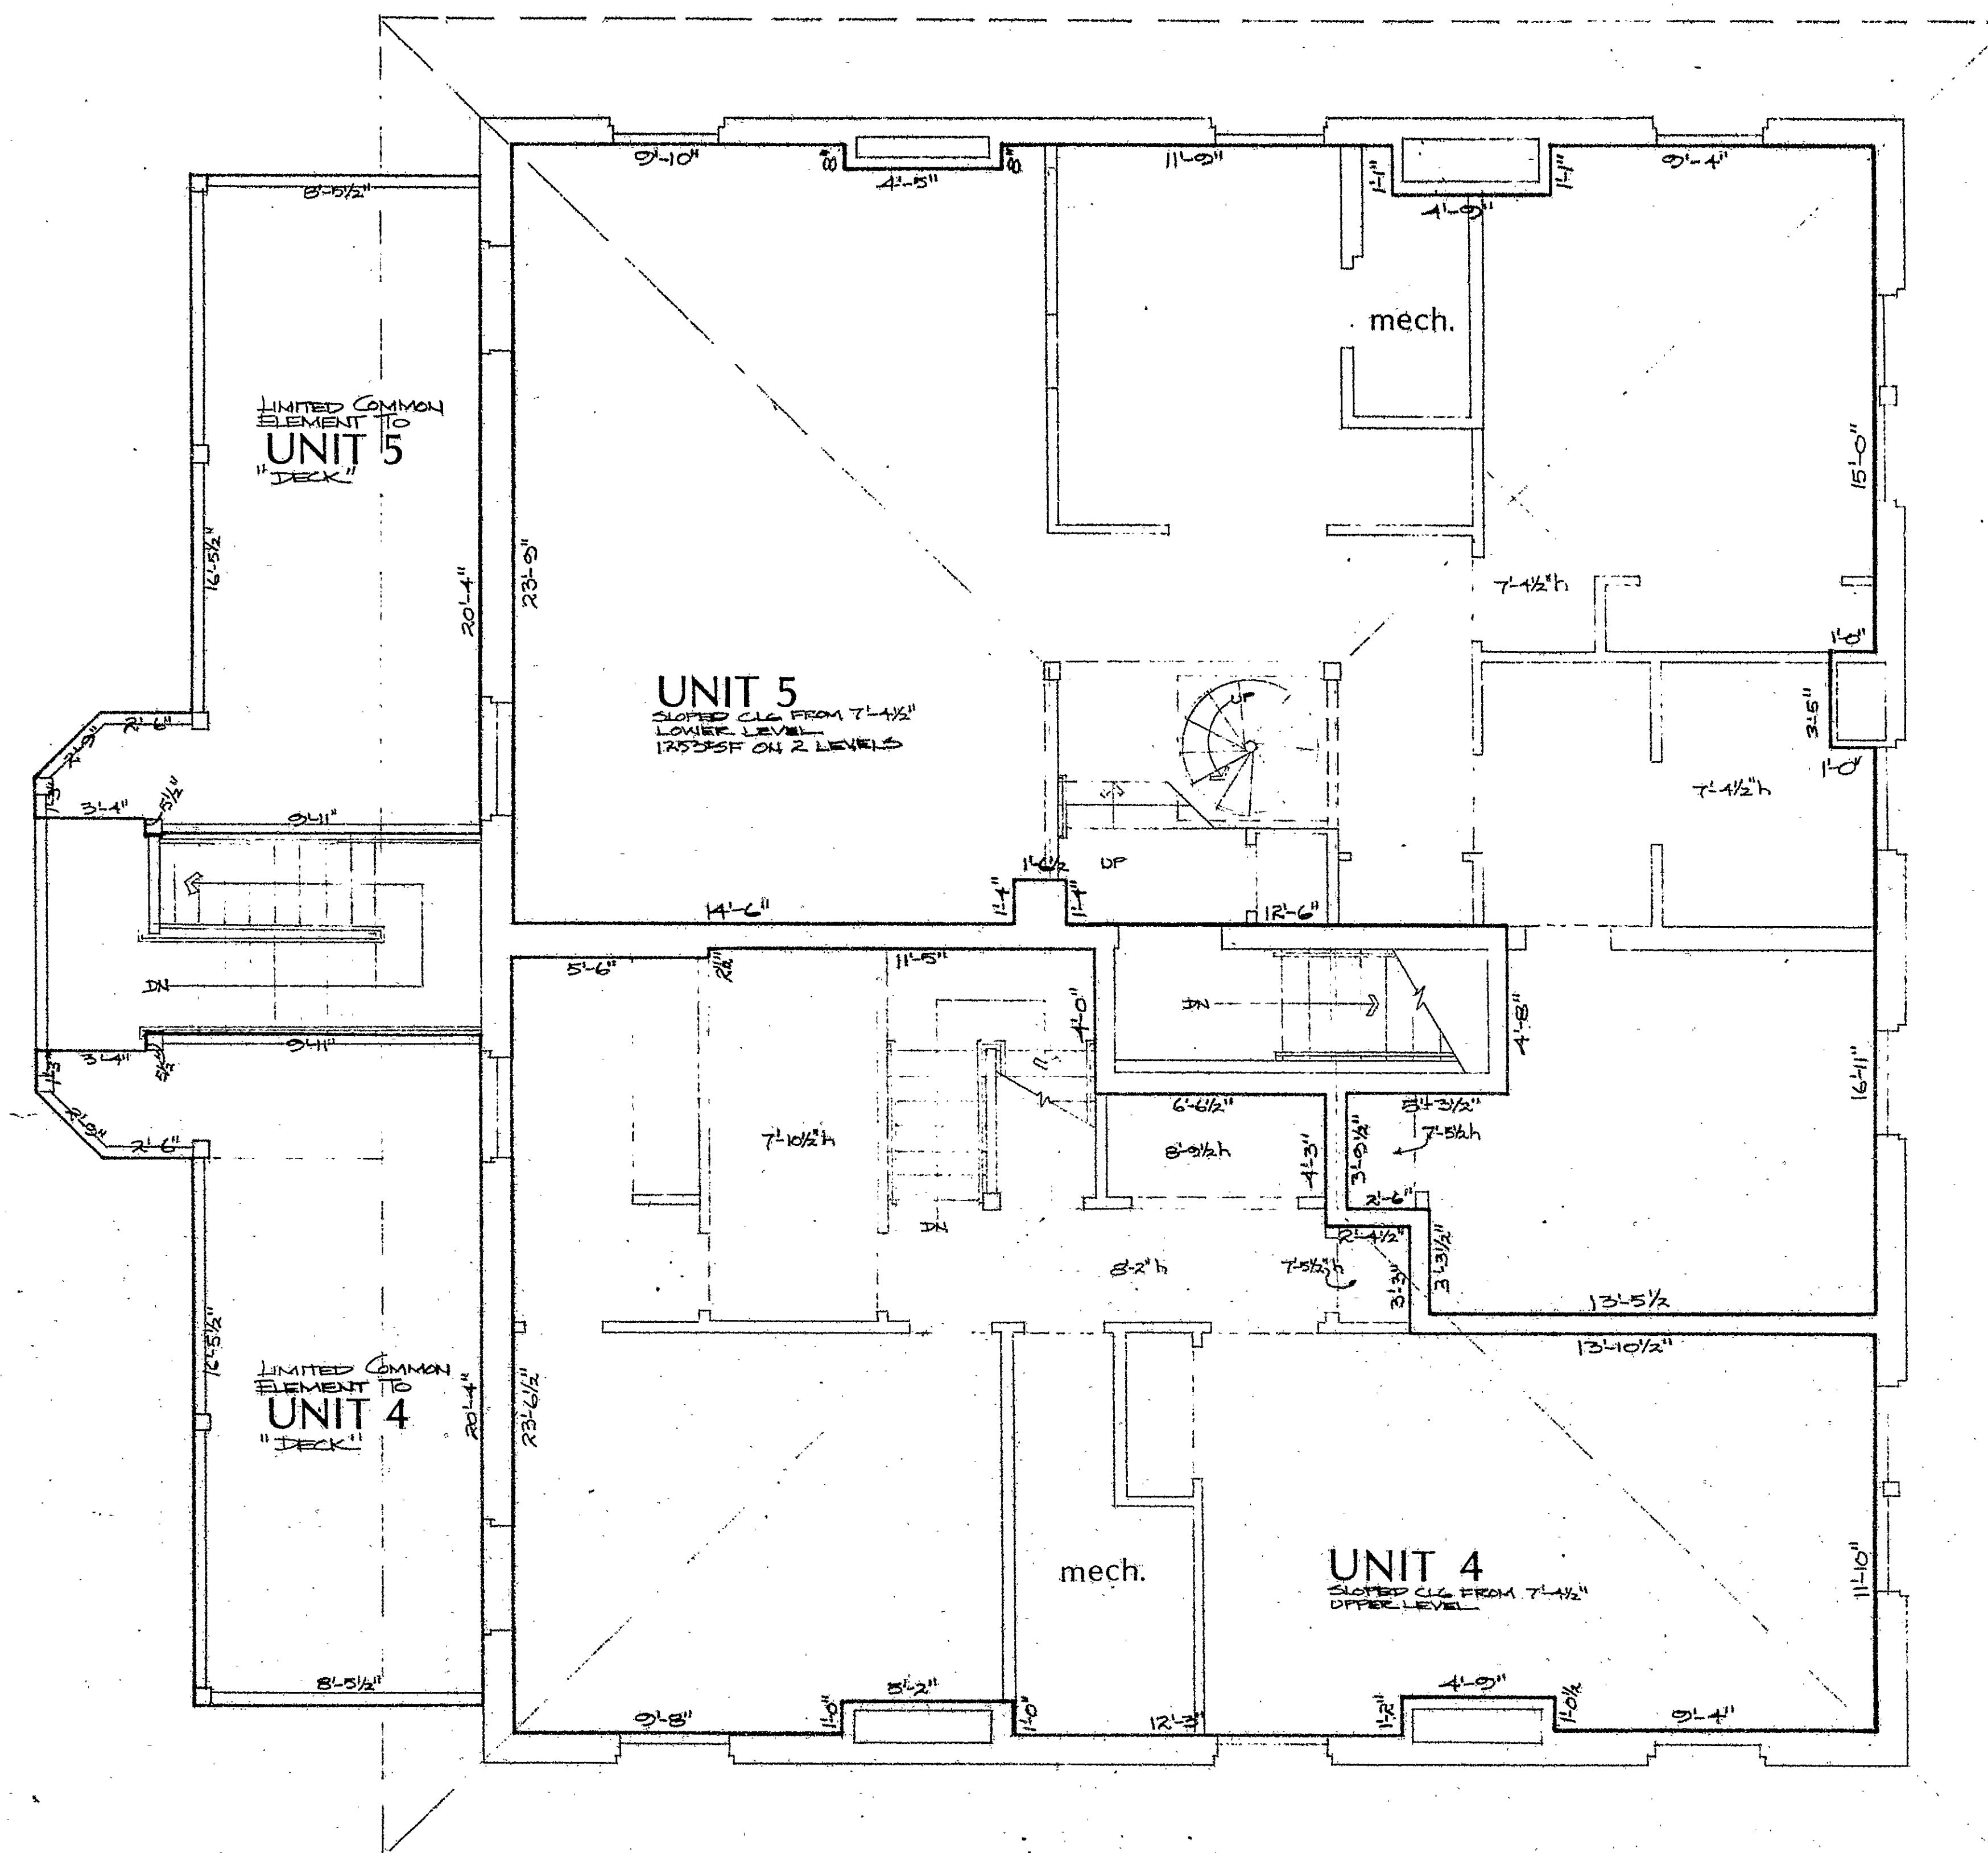

NOTE: THESE PLANS FOR THE BUILDING ARE AN ACCURATE COPY OF PORTIONS OF THE PLANS ON FILE WITH THE BUILDING OFFICIAL APPOINTED PER STATE TO SECTION 12-326

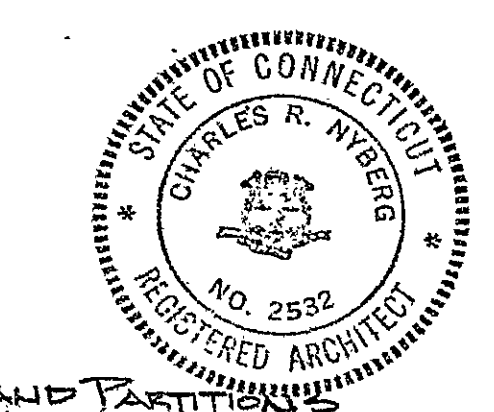

NOTE: ALL WALLS AND PARTITIONS WHICH ARE NOT SPECIFICALLY DIMENSIONED CAN BE DIMENSIONED BY REFERENCE TO SCALE 1/4"=1'-0"

Condo Floor Plan #30

