



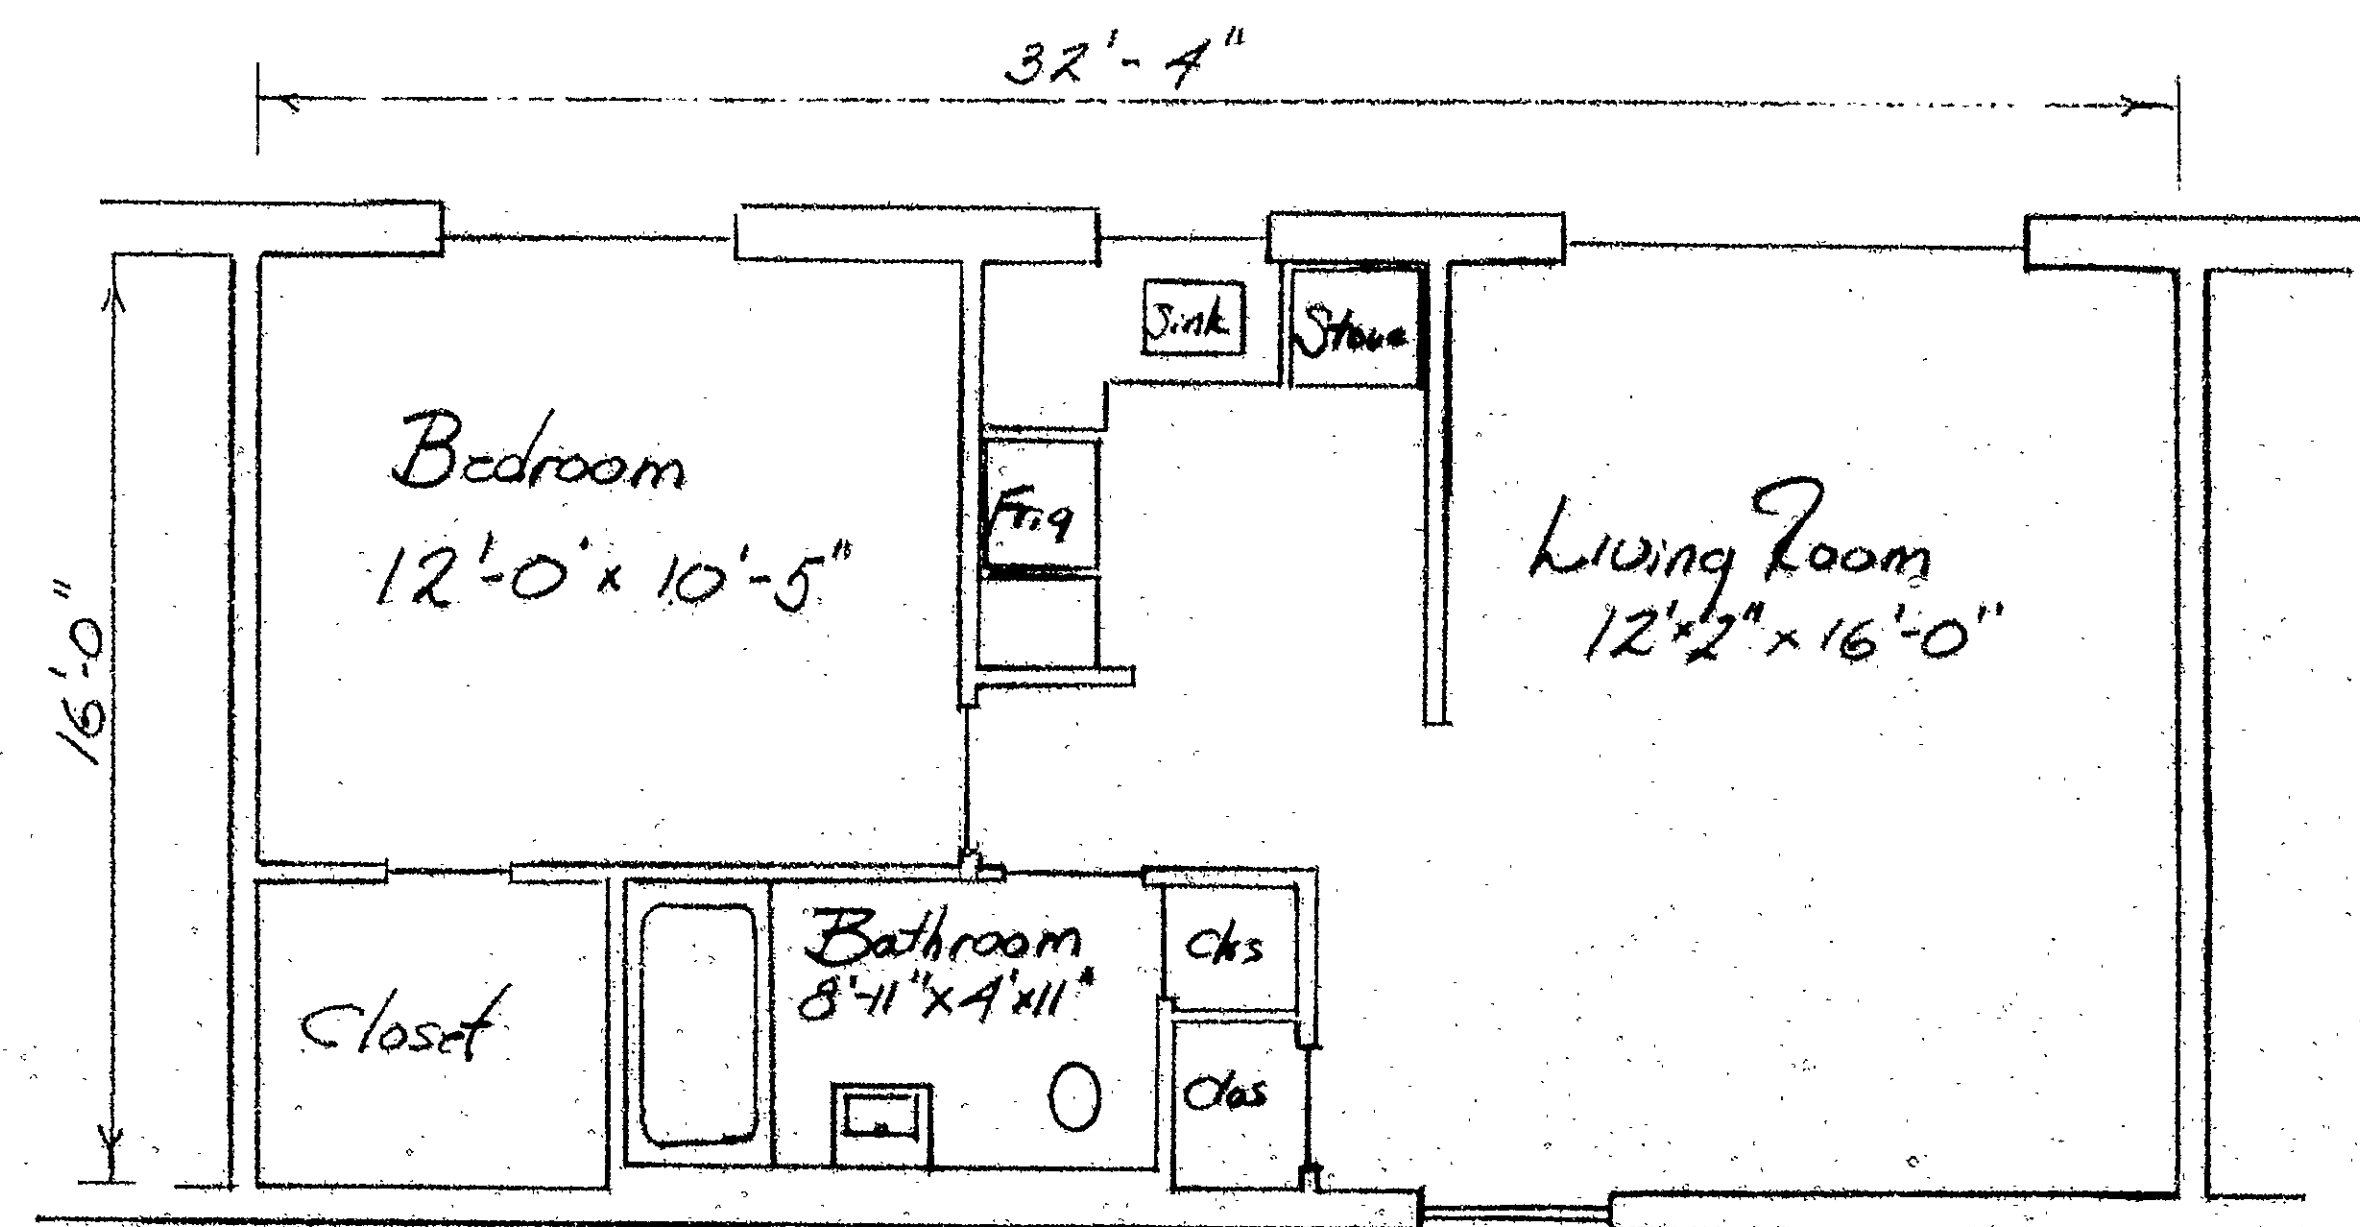

FLOOR PLAN ~ L4

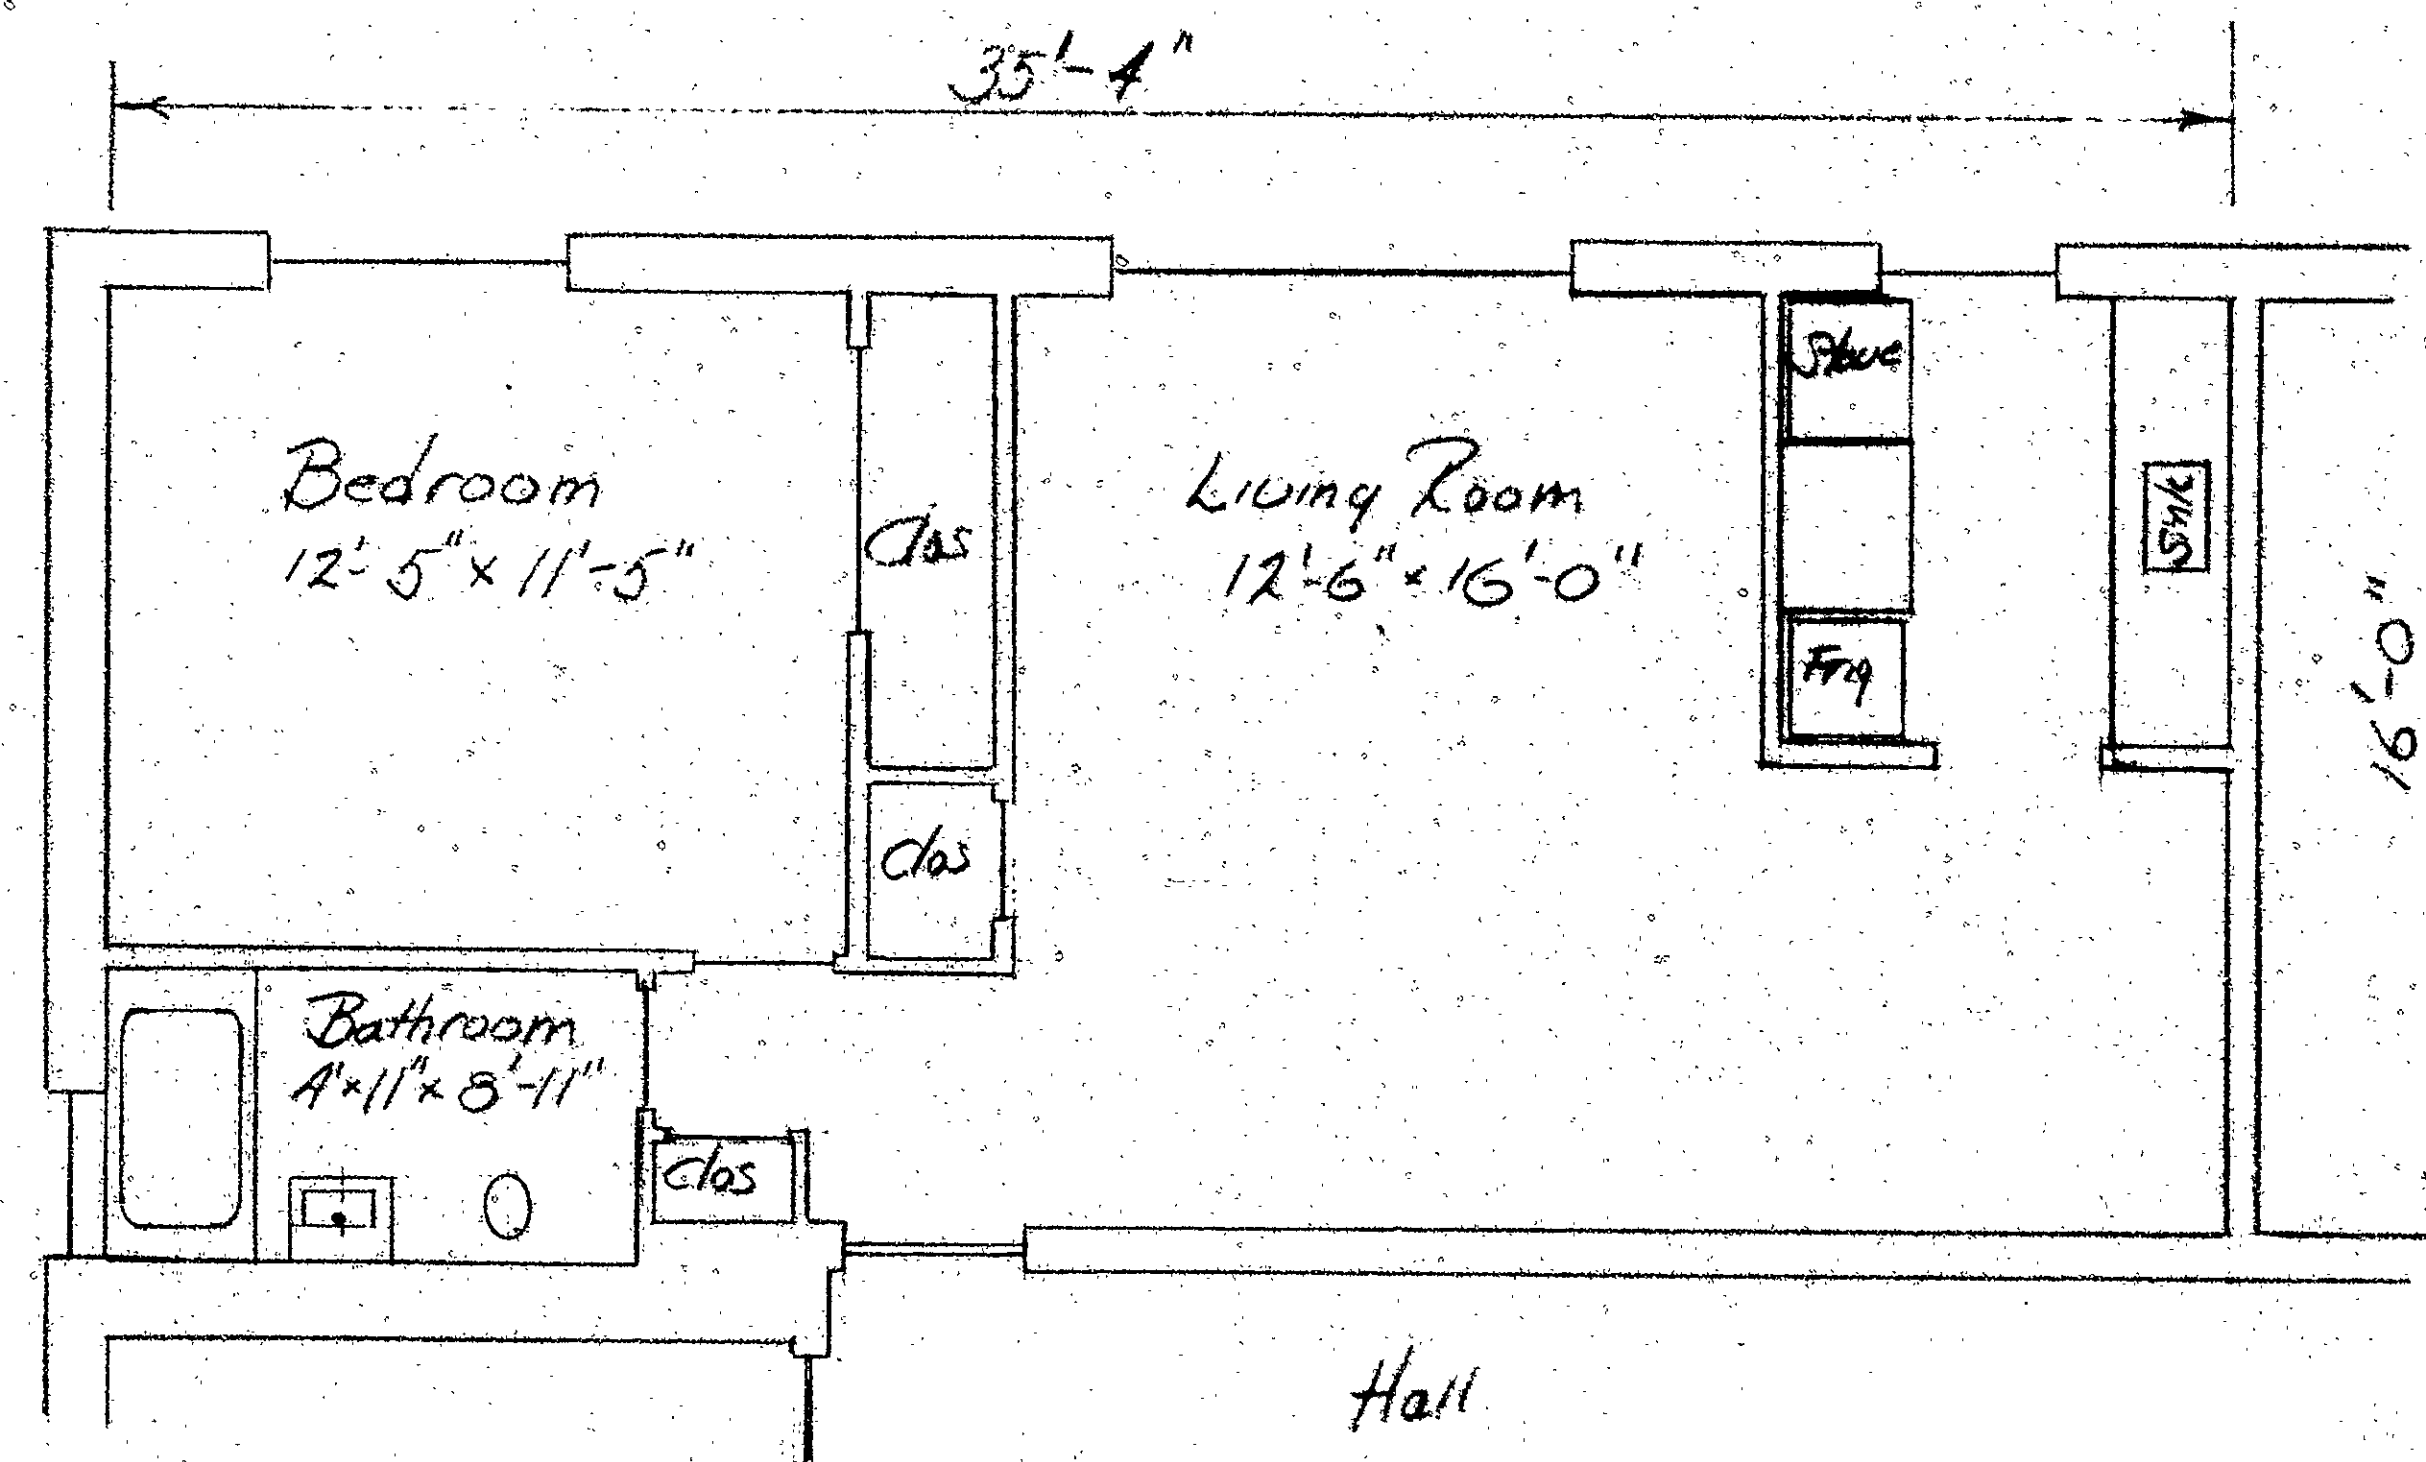

FLOOR PLAN ~ L3

I certify that these plans conform to those on file at the Building Department of the City of Hartford
 Robert J. Isabelle

3 of 5

I certify this plan substantially correct
 Robert J. Isabelle PE 5985

AETNA GARDENS CONDOMINIUM


Elevs by Igor Vechesloff PE+LS

NOTES

ELEVATIONS ~ Based on MDC Datum

UNIT	FLOOR	CEILING
~Basement	55.08	63.43
~Entrance	60.35	—
First Floor	64.75	72.38
Second Floor	73.50	81.10
Third Floor	82.30	90.05

530 WETHERSFIELD AVE
 INDIVIDUAL UNIT FLOOR PLAN ~ TYPICAL
 HARTFORD, CONN Nov 17, 1981
 SCALE 1/4" = 1'-0" Robert J. Isabelle PE

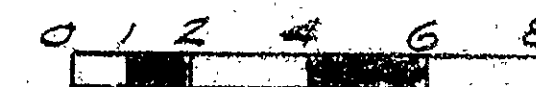

Condo Floor Plan #31