



RECEIVED BY
 JAN 12 1982
 TOWN & CITY CLERK
 HARTFORD
 VOL. _____ PAGE _____

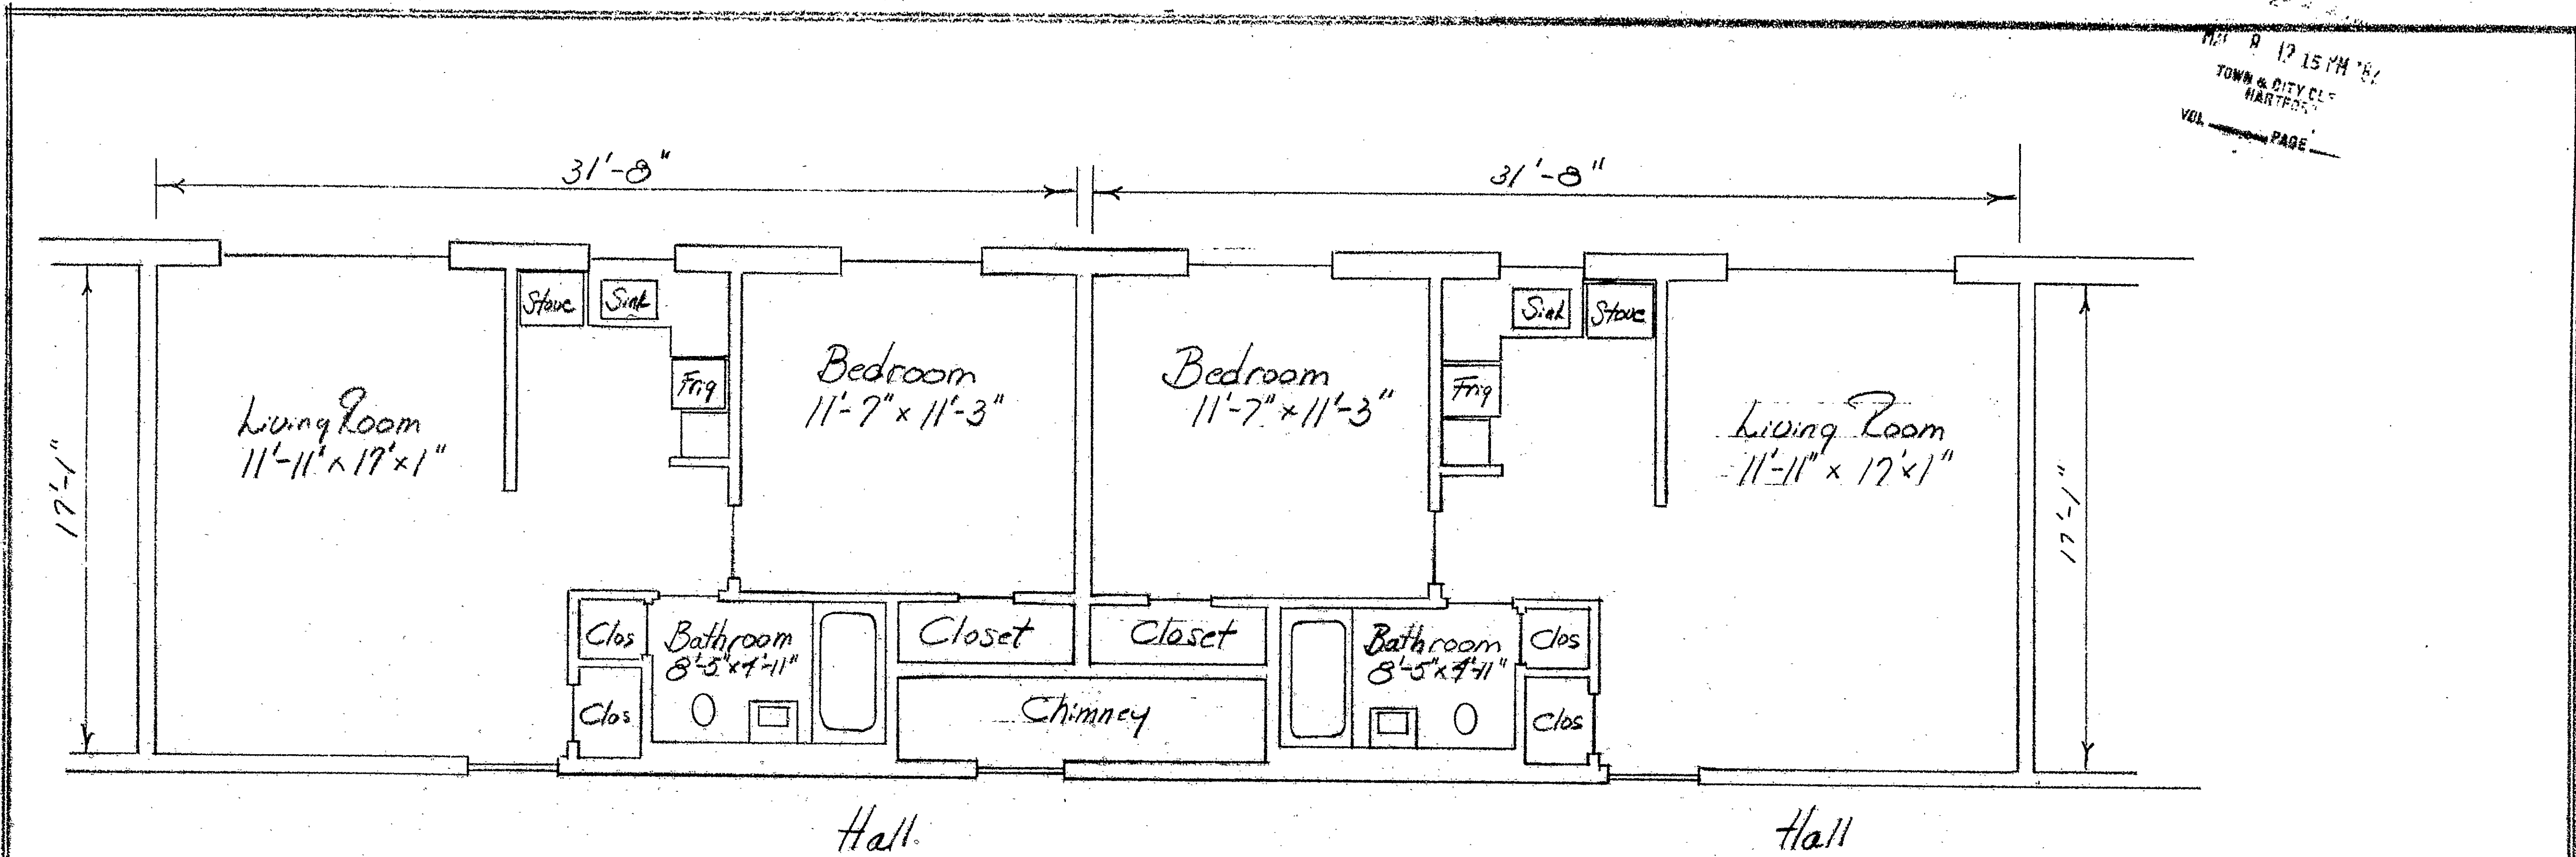

FLOOR PLAN A5-B5-C5

FLOOR PLAN A3-B3-C3

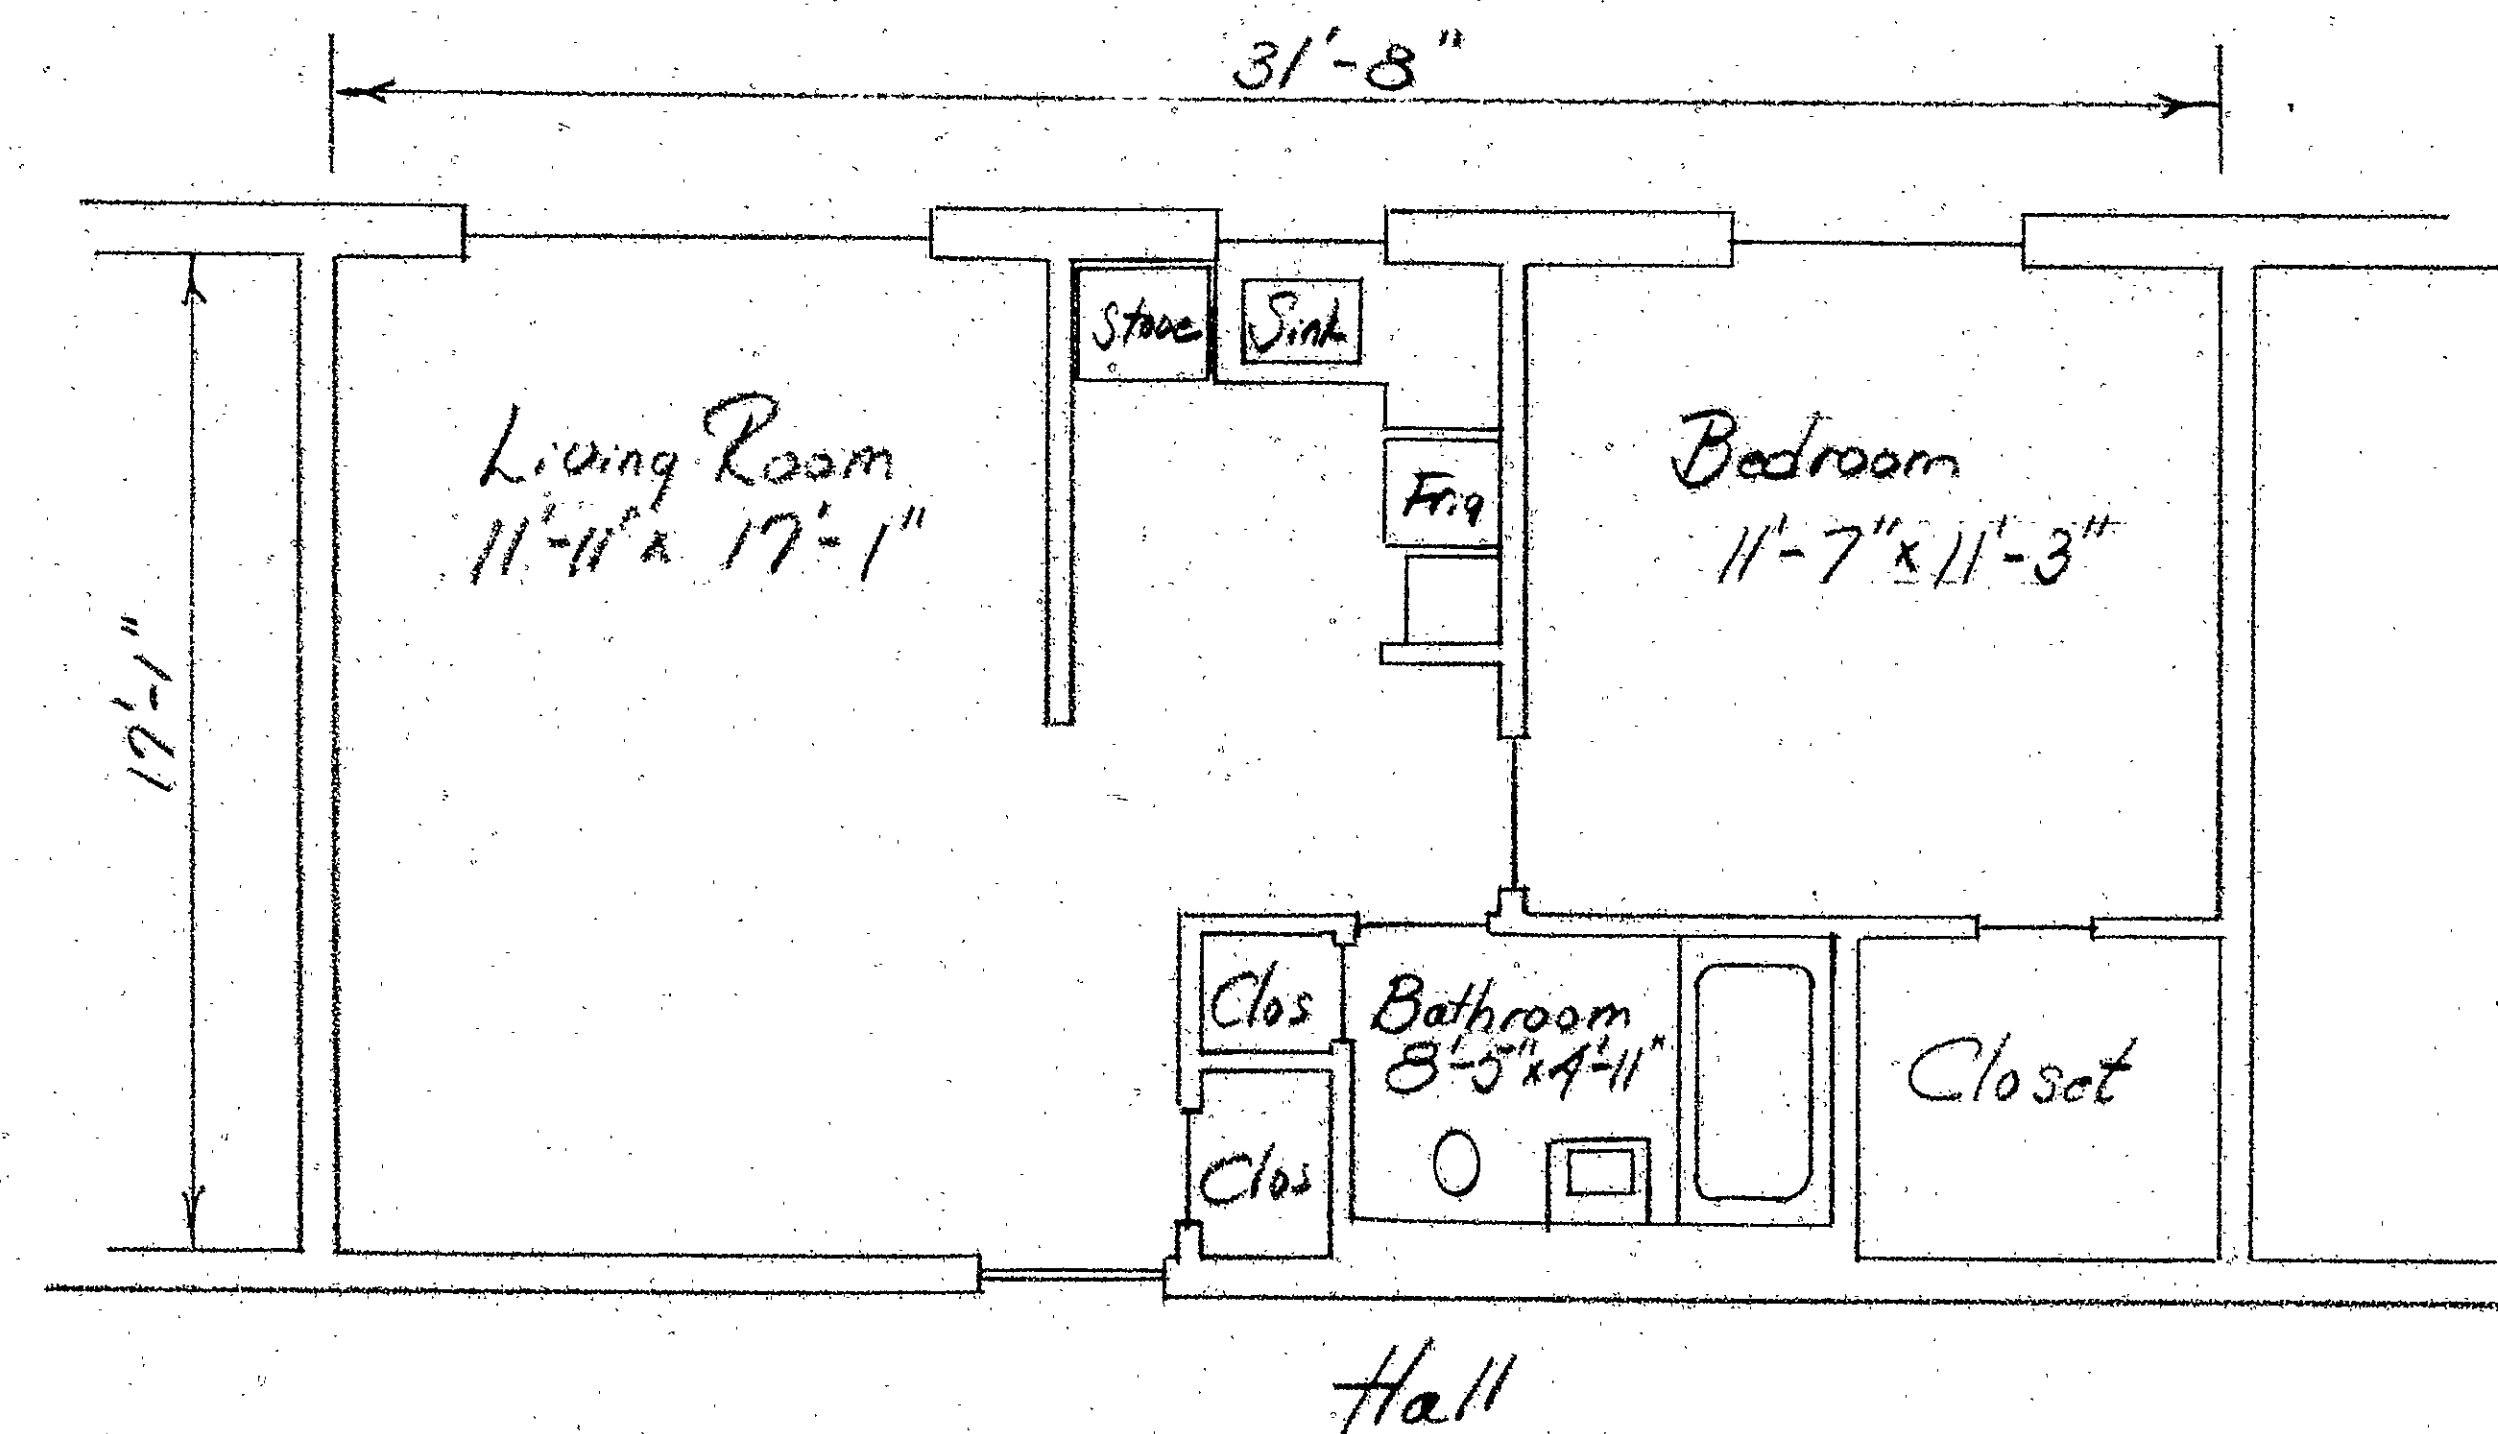

FLOOR PLAN A1-A2-A6-B1-B2-B6-C1-C2-C6

AETNA GARDENS CONDOMINIUM
 530 WETHERSFIELD AVE
 INDIVIDUAL UNIT FLOOR PLANS-TYPICAL
 HARTFORD, CONN JAN 12, 1982
 SCALE 1/4" = 1'-0" Robert J. Isabelle PE

I certify this plan substantially correct
 Robert J. Isabelle PE

I certify that these plans conform to those on
 file at the Building Department of the City of
 Hartford. Robert Isabelle

5 of 5
 Condo Floor Plan # 31

