
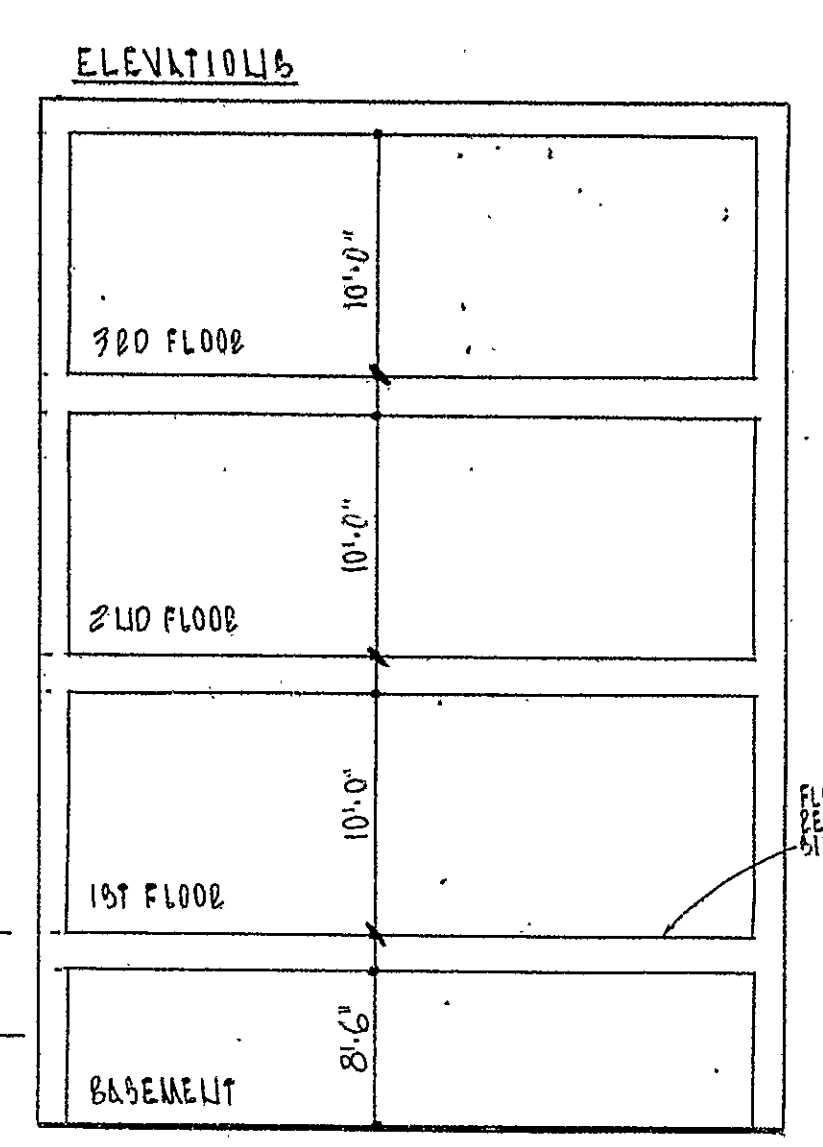
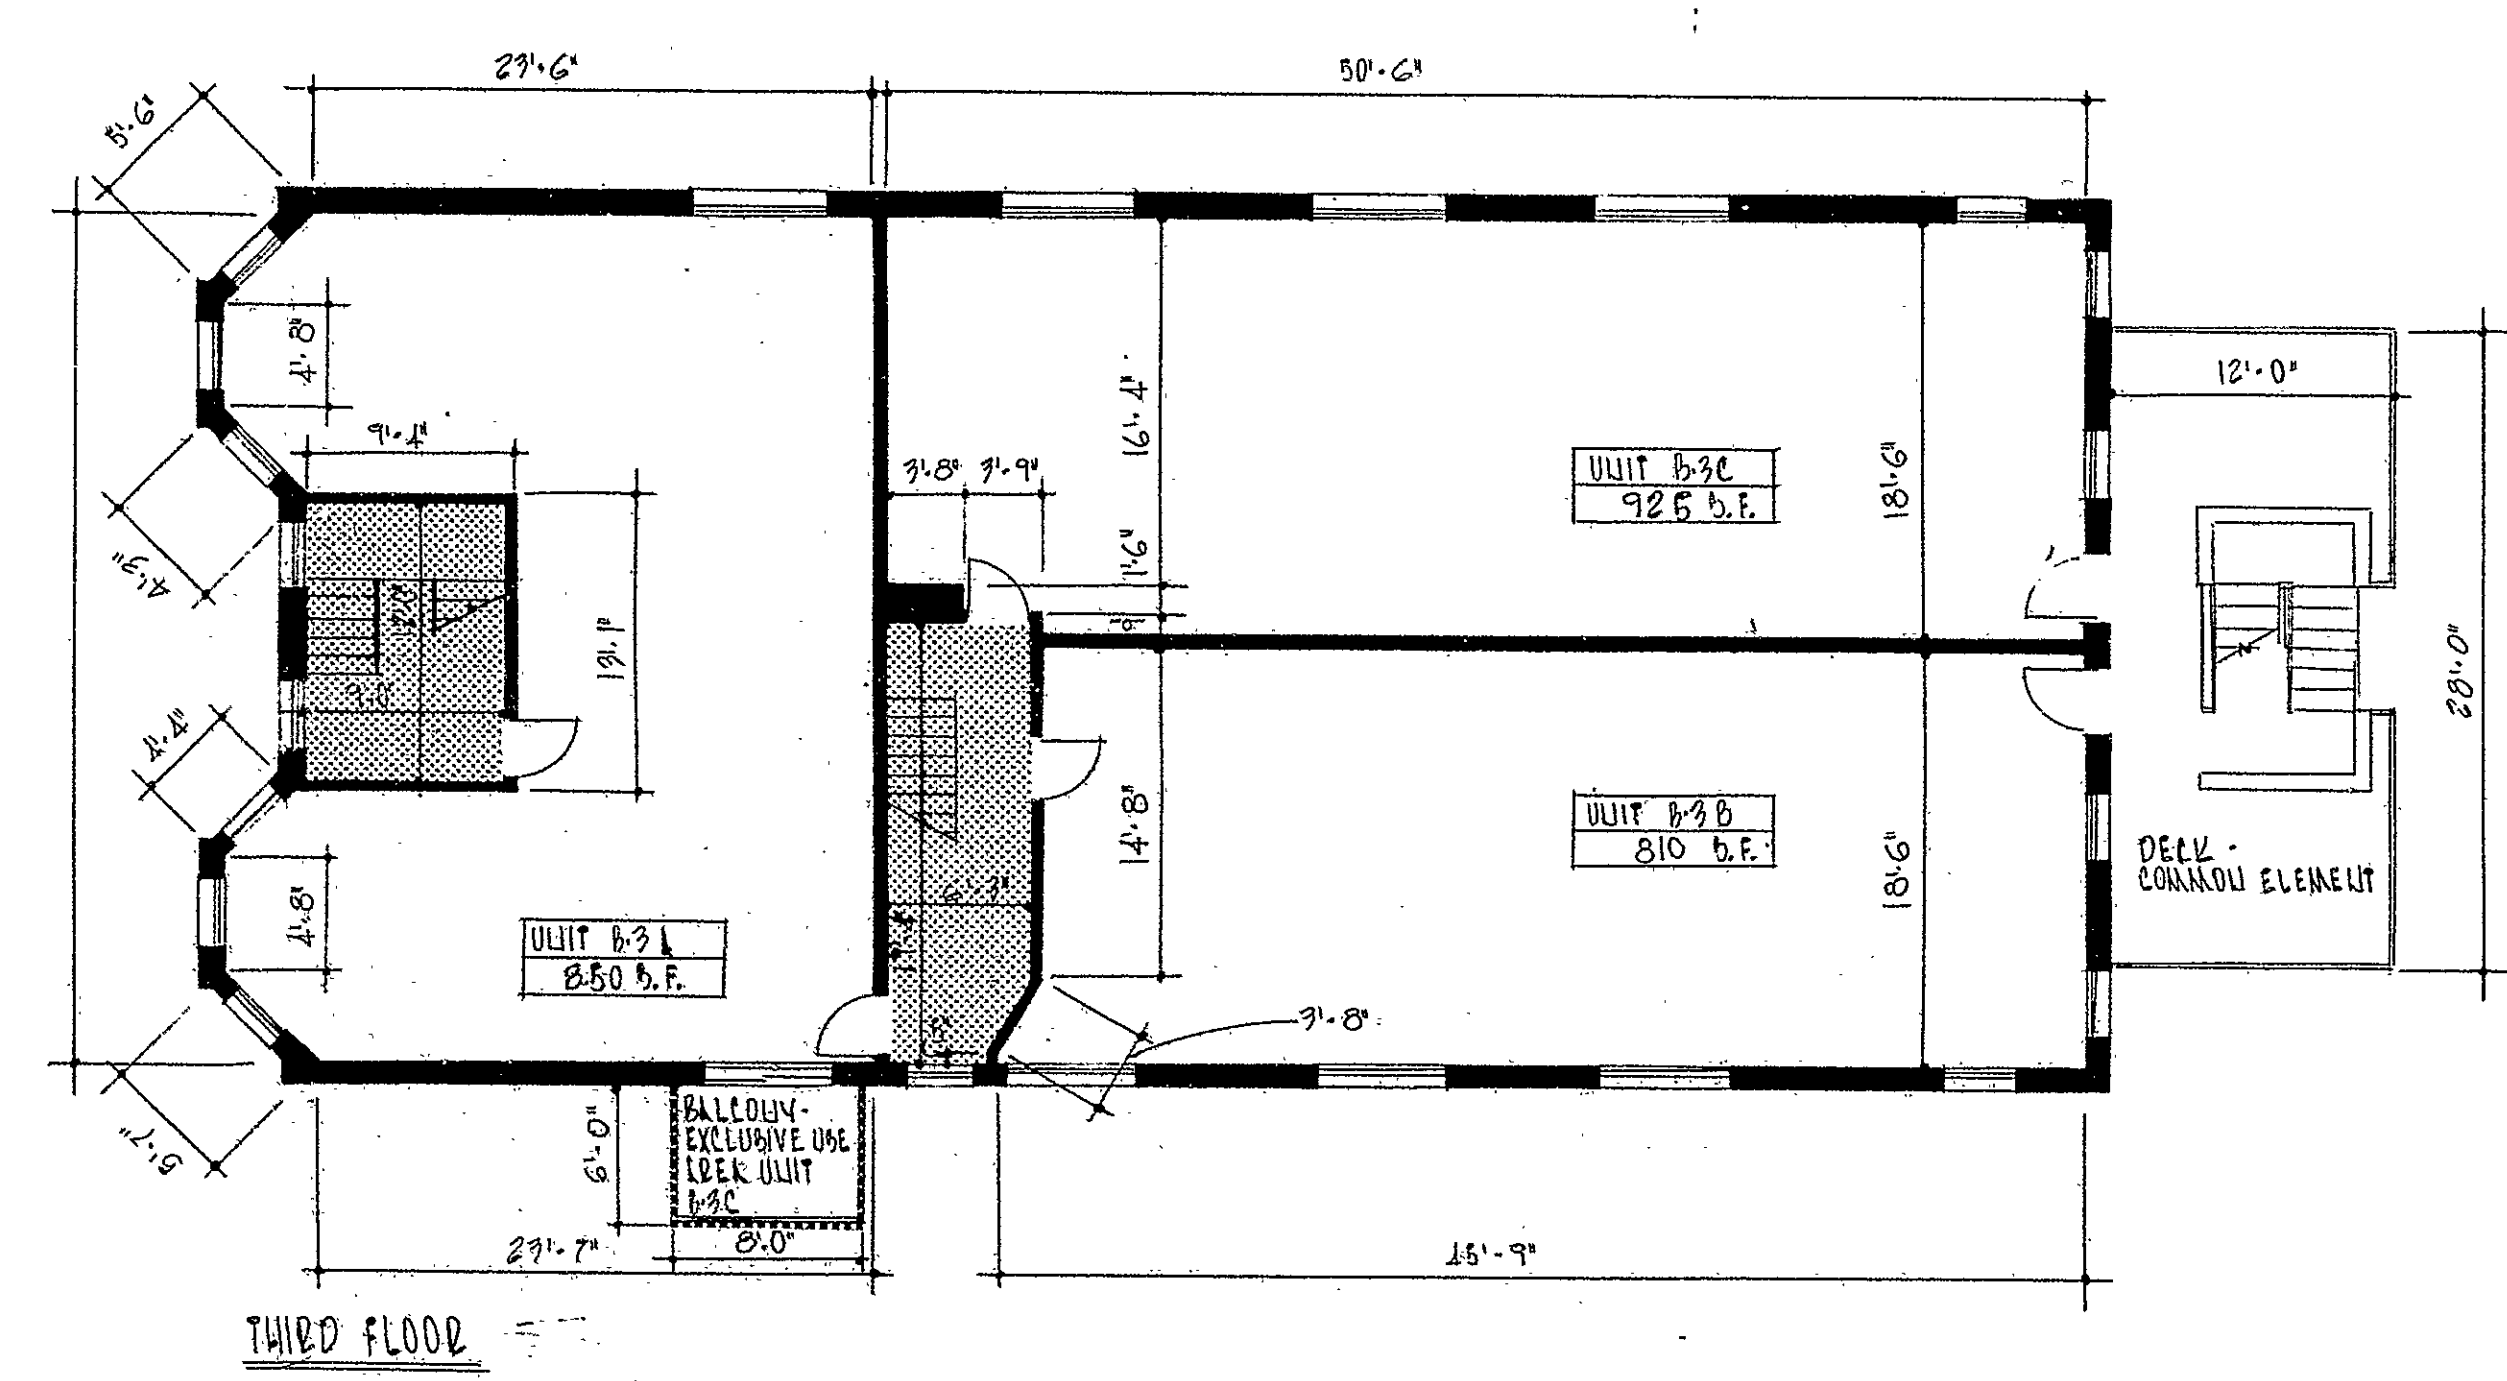
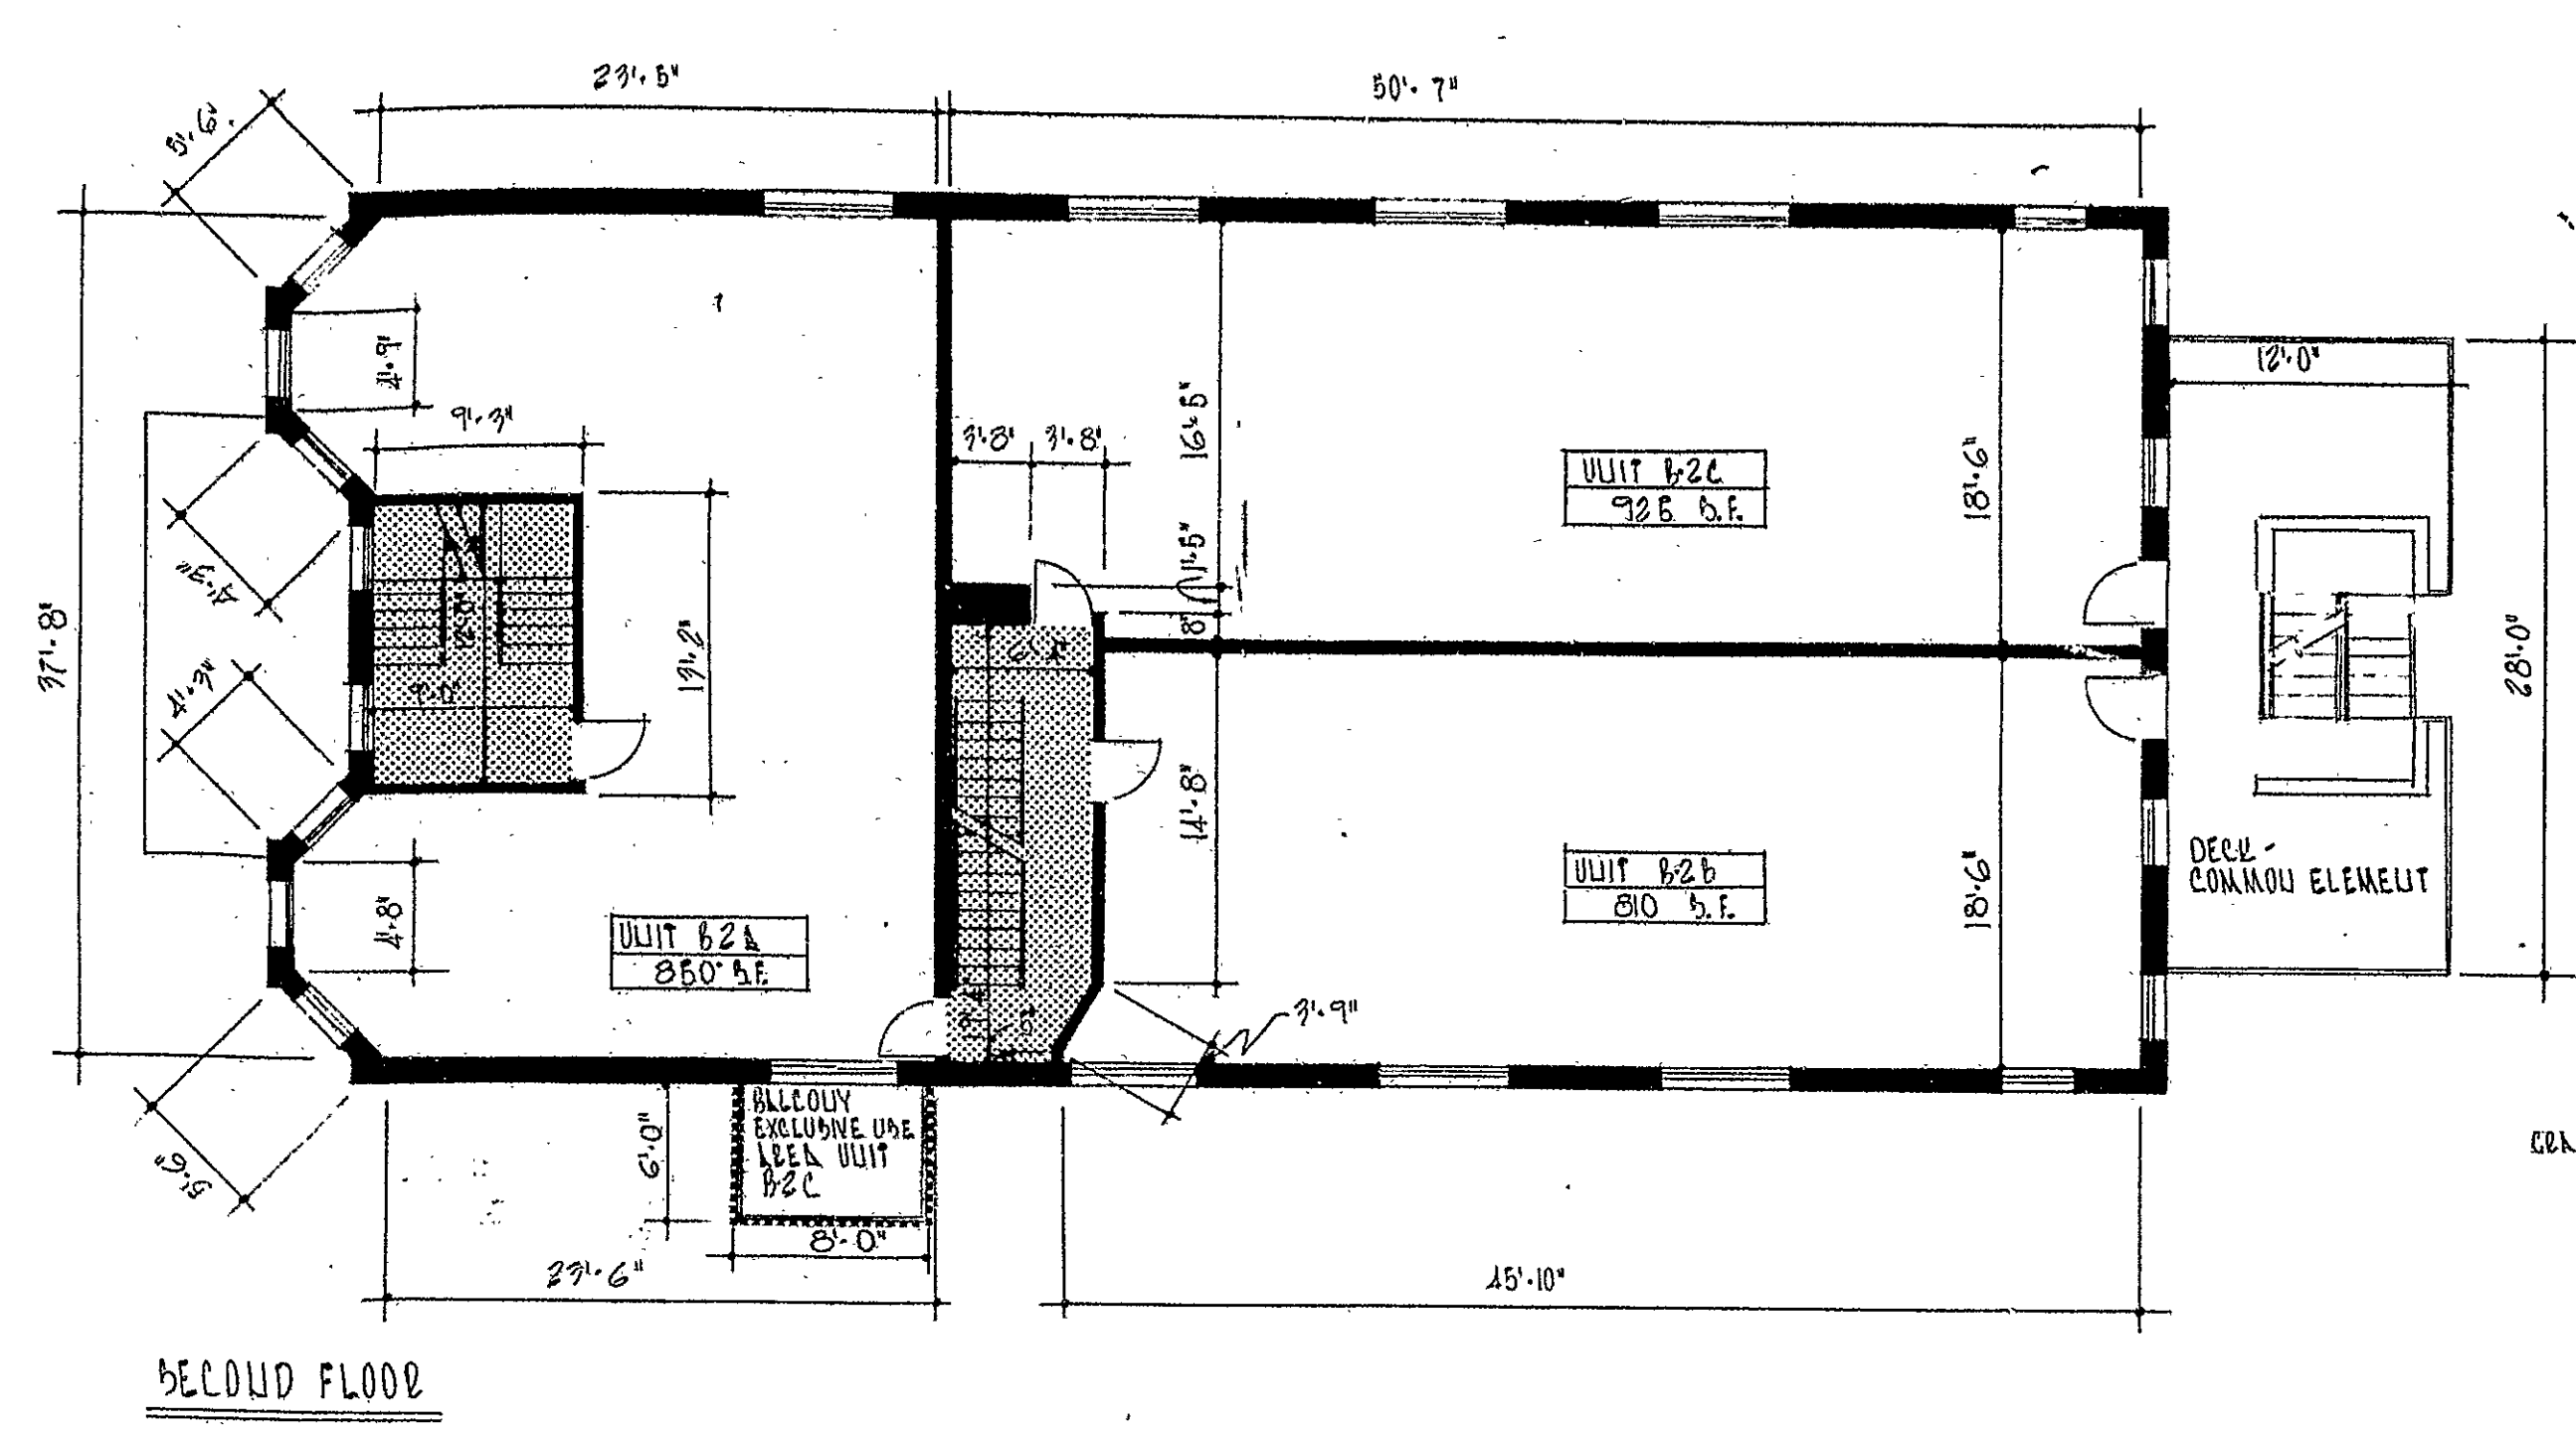
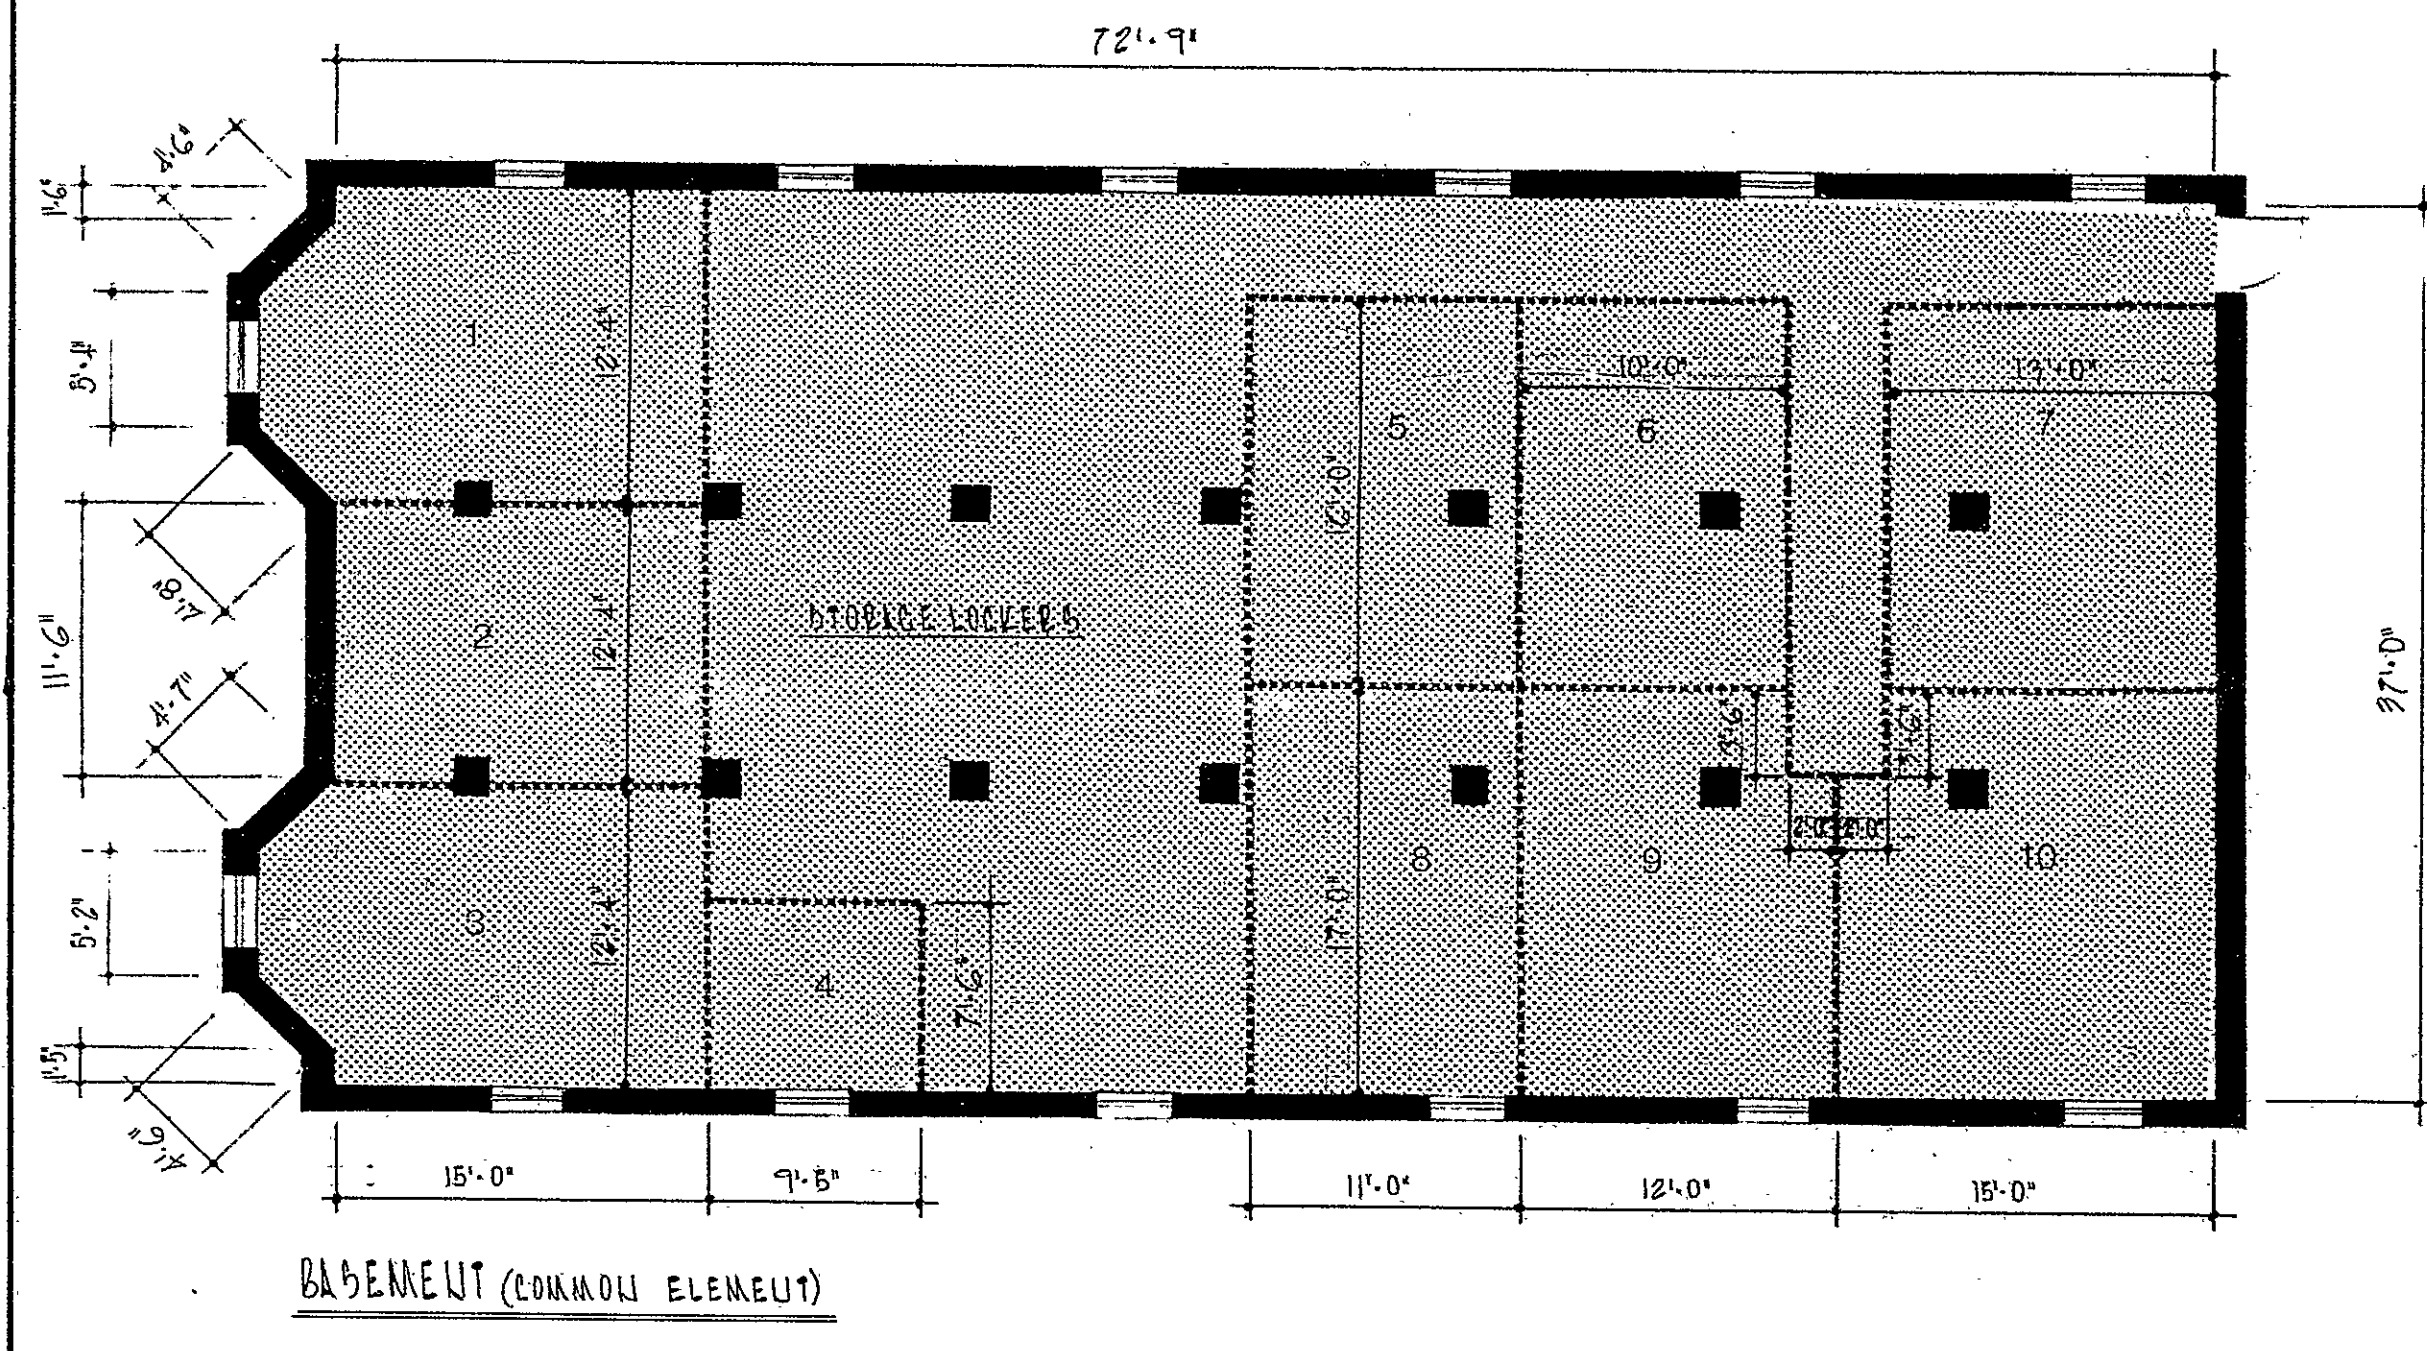



Project Plan # 34

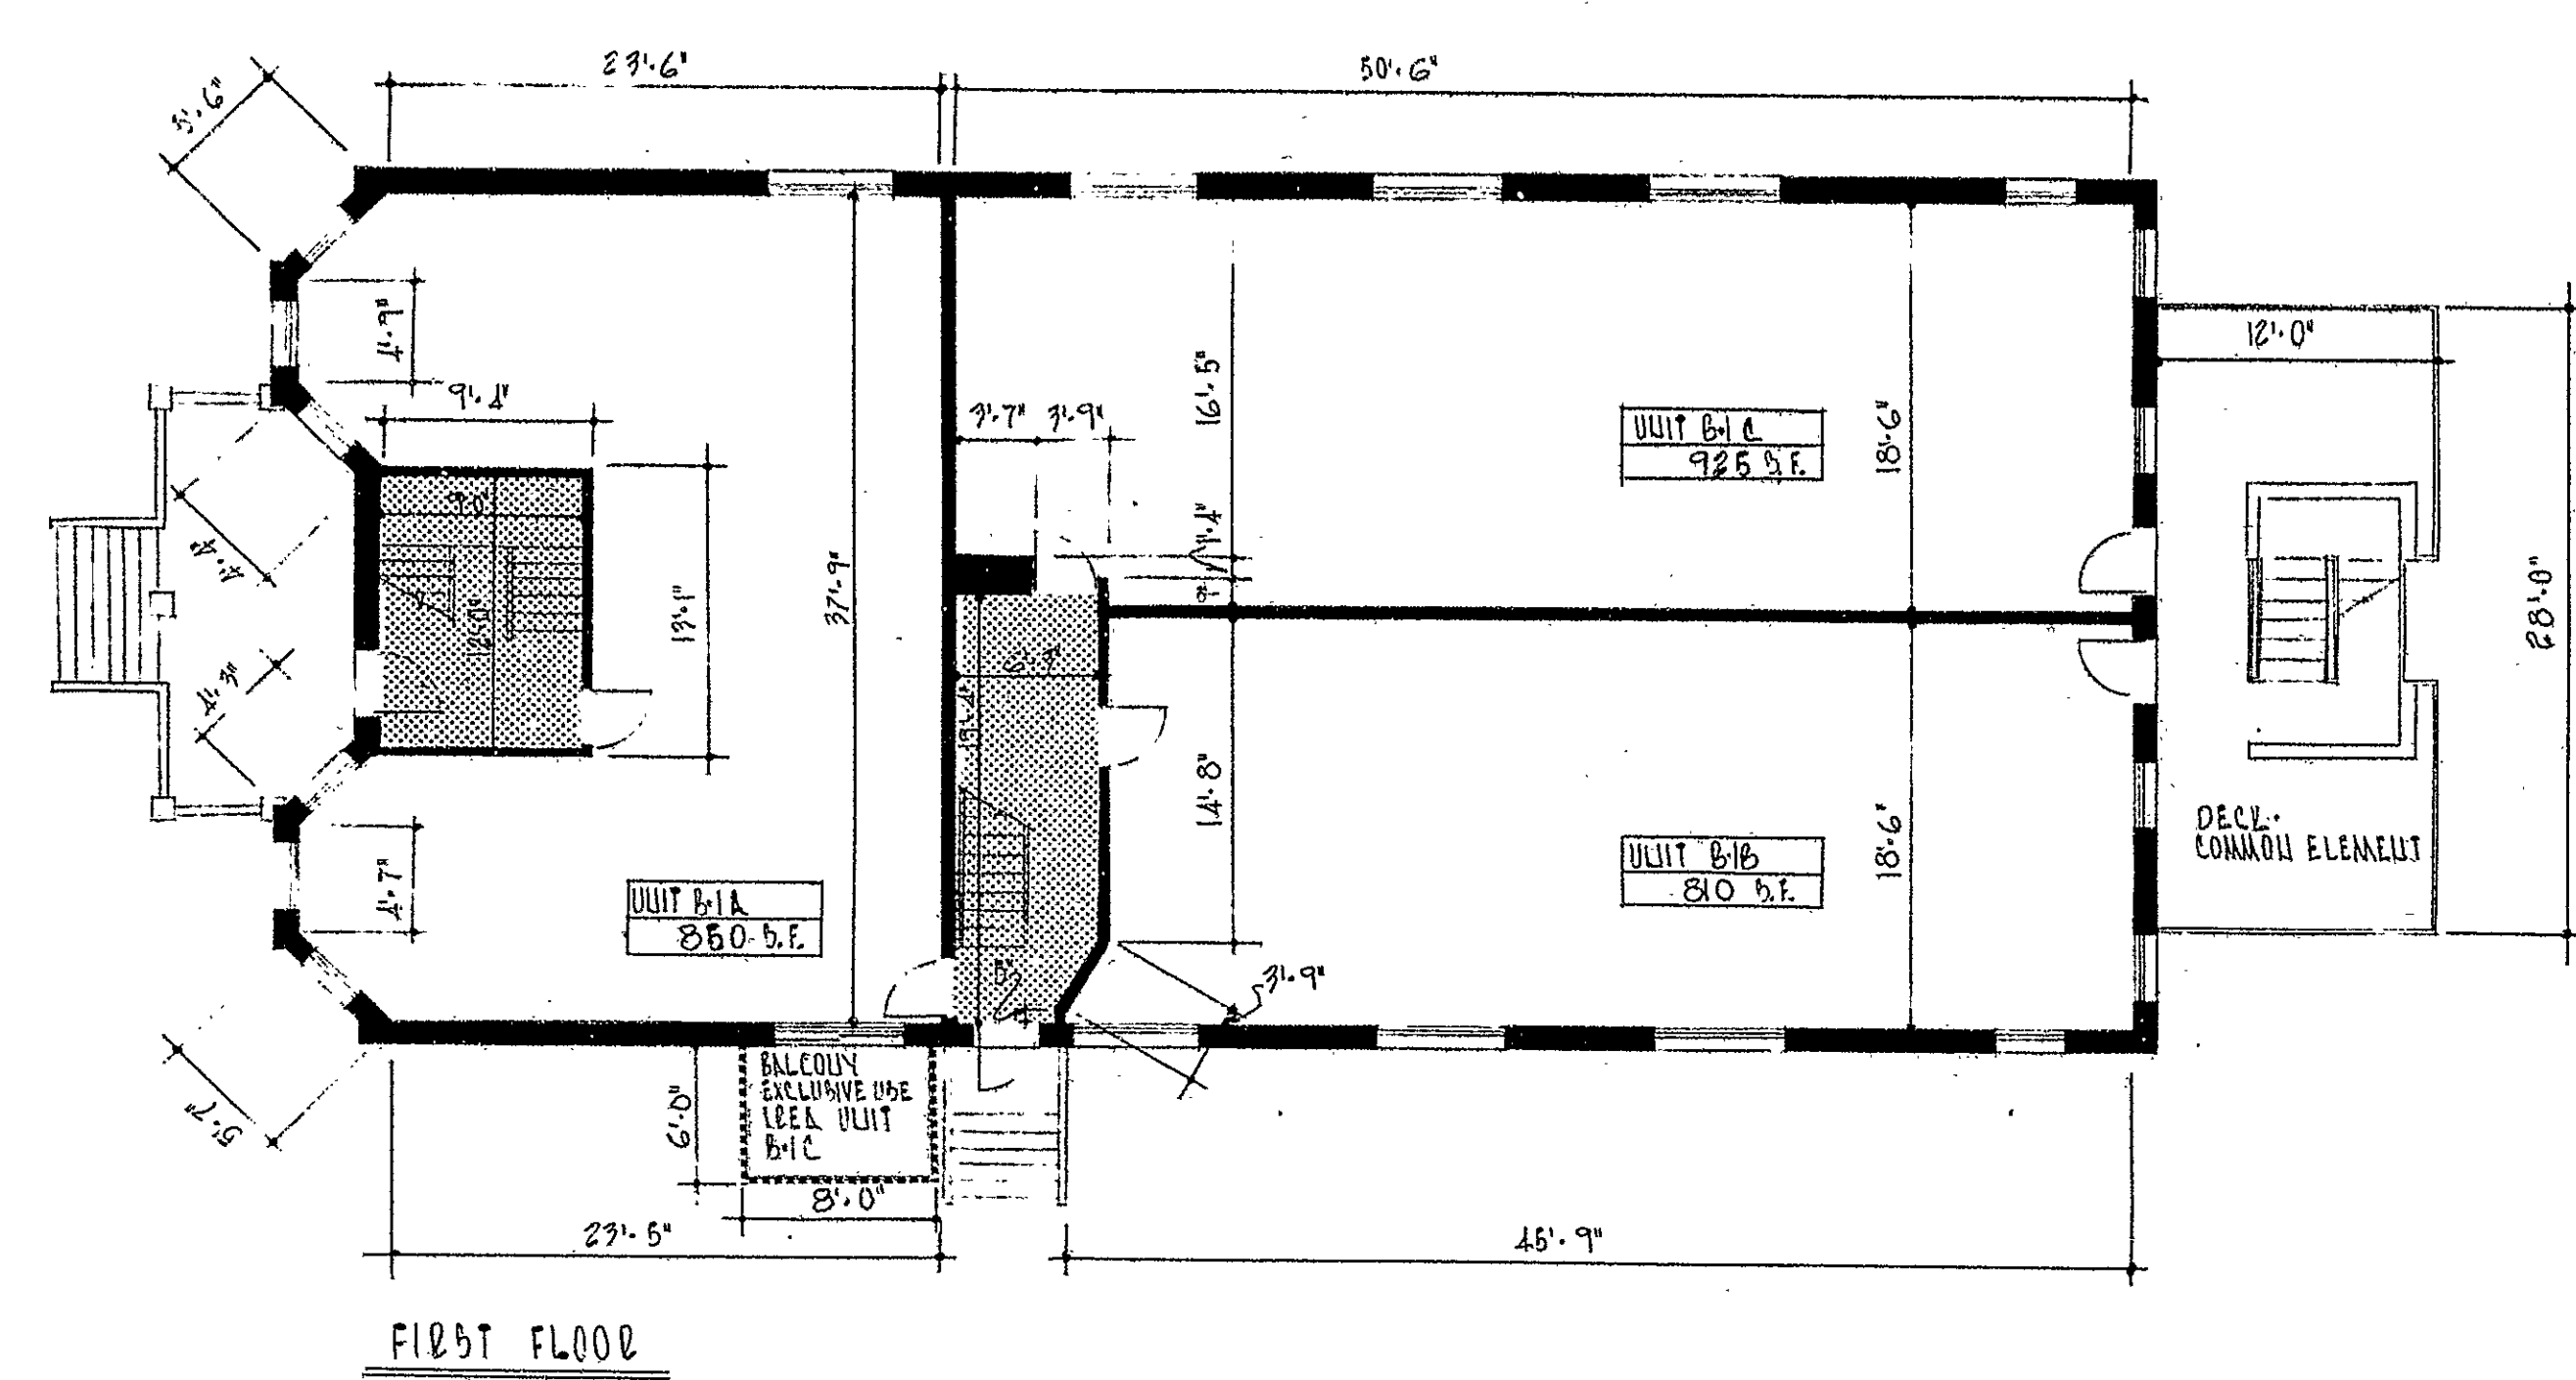

SECTIONAL SECTION
NOT TO SCALE
ELEVATIONS TAKEN FROM SURVEY BY LEO KACHALOFF, P.E.
LTD. L.S.D. LAND SURVEYOR, DIVISION 18, JULY 11, 1990

Abbreviations and Symbols

- common area
- unit demising wall
- partition within demised unit
- bounding for areas of exclusive use

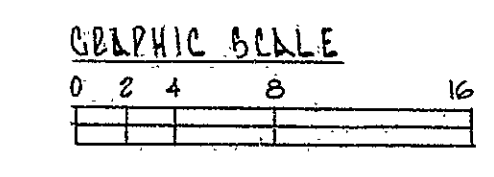

BUILDING B-52-54 ATWOOD STREET

Atwood Street Condominium

