
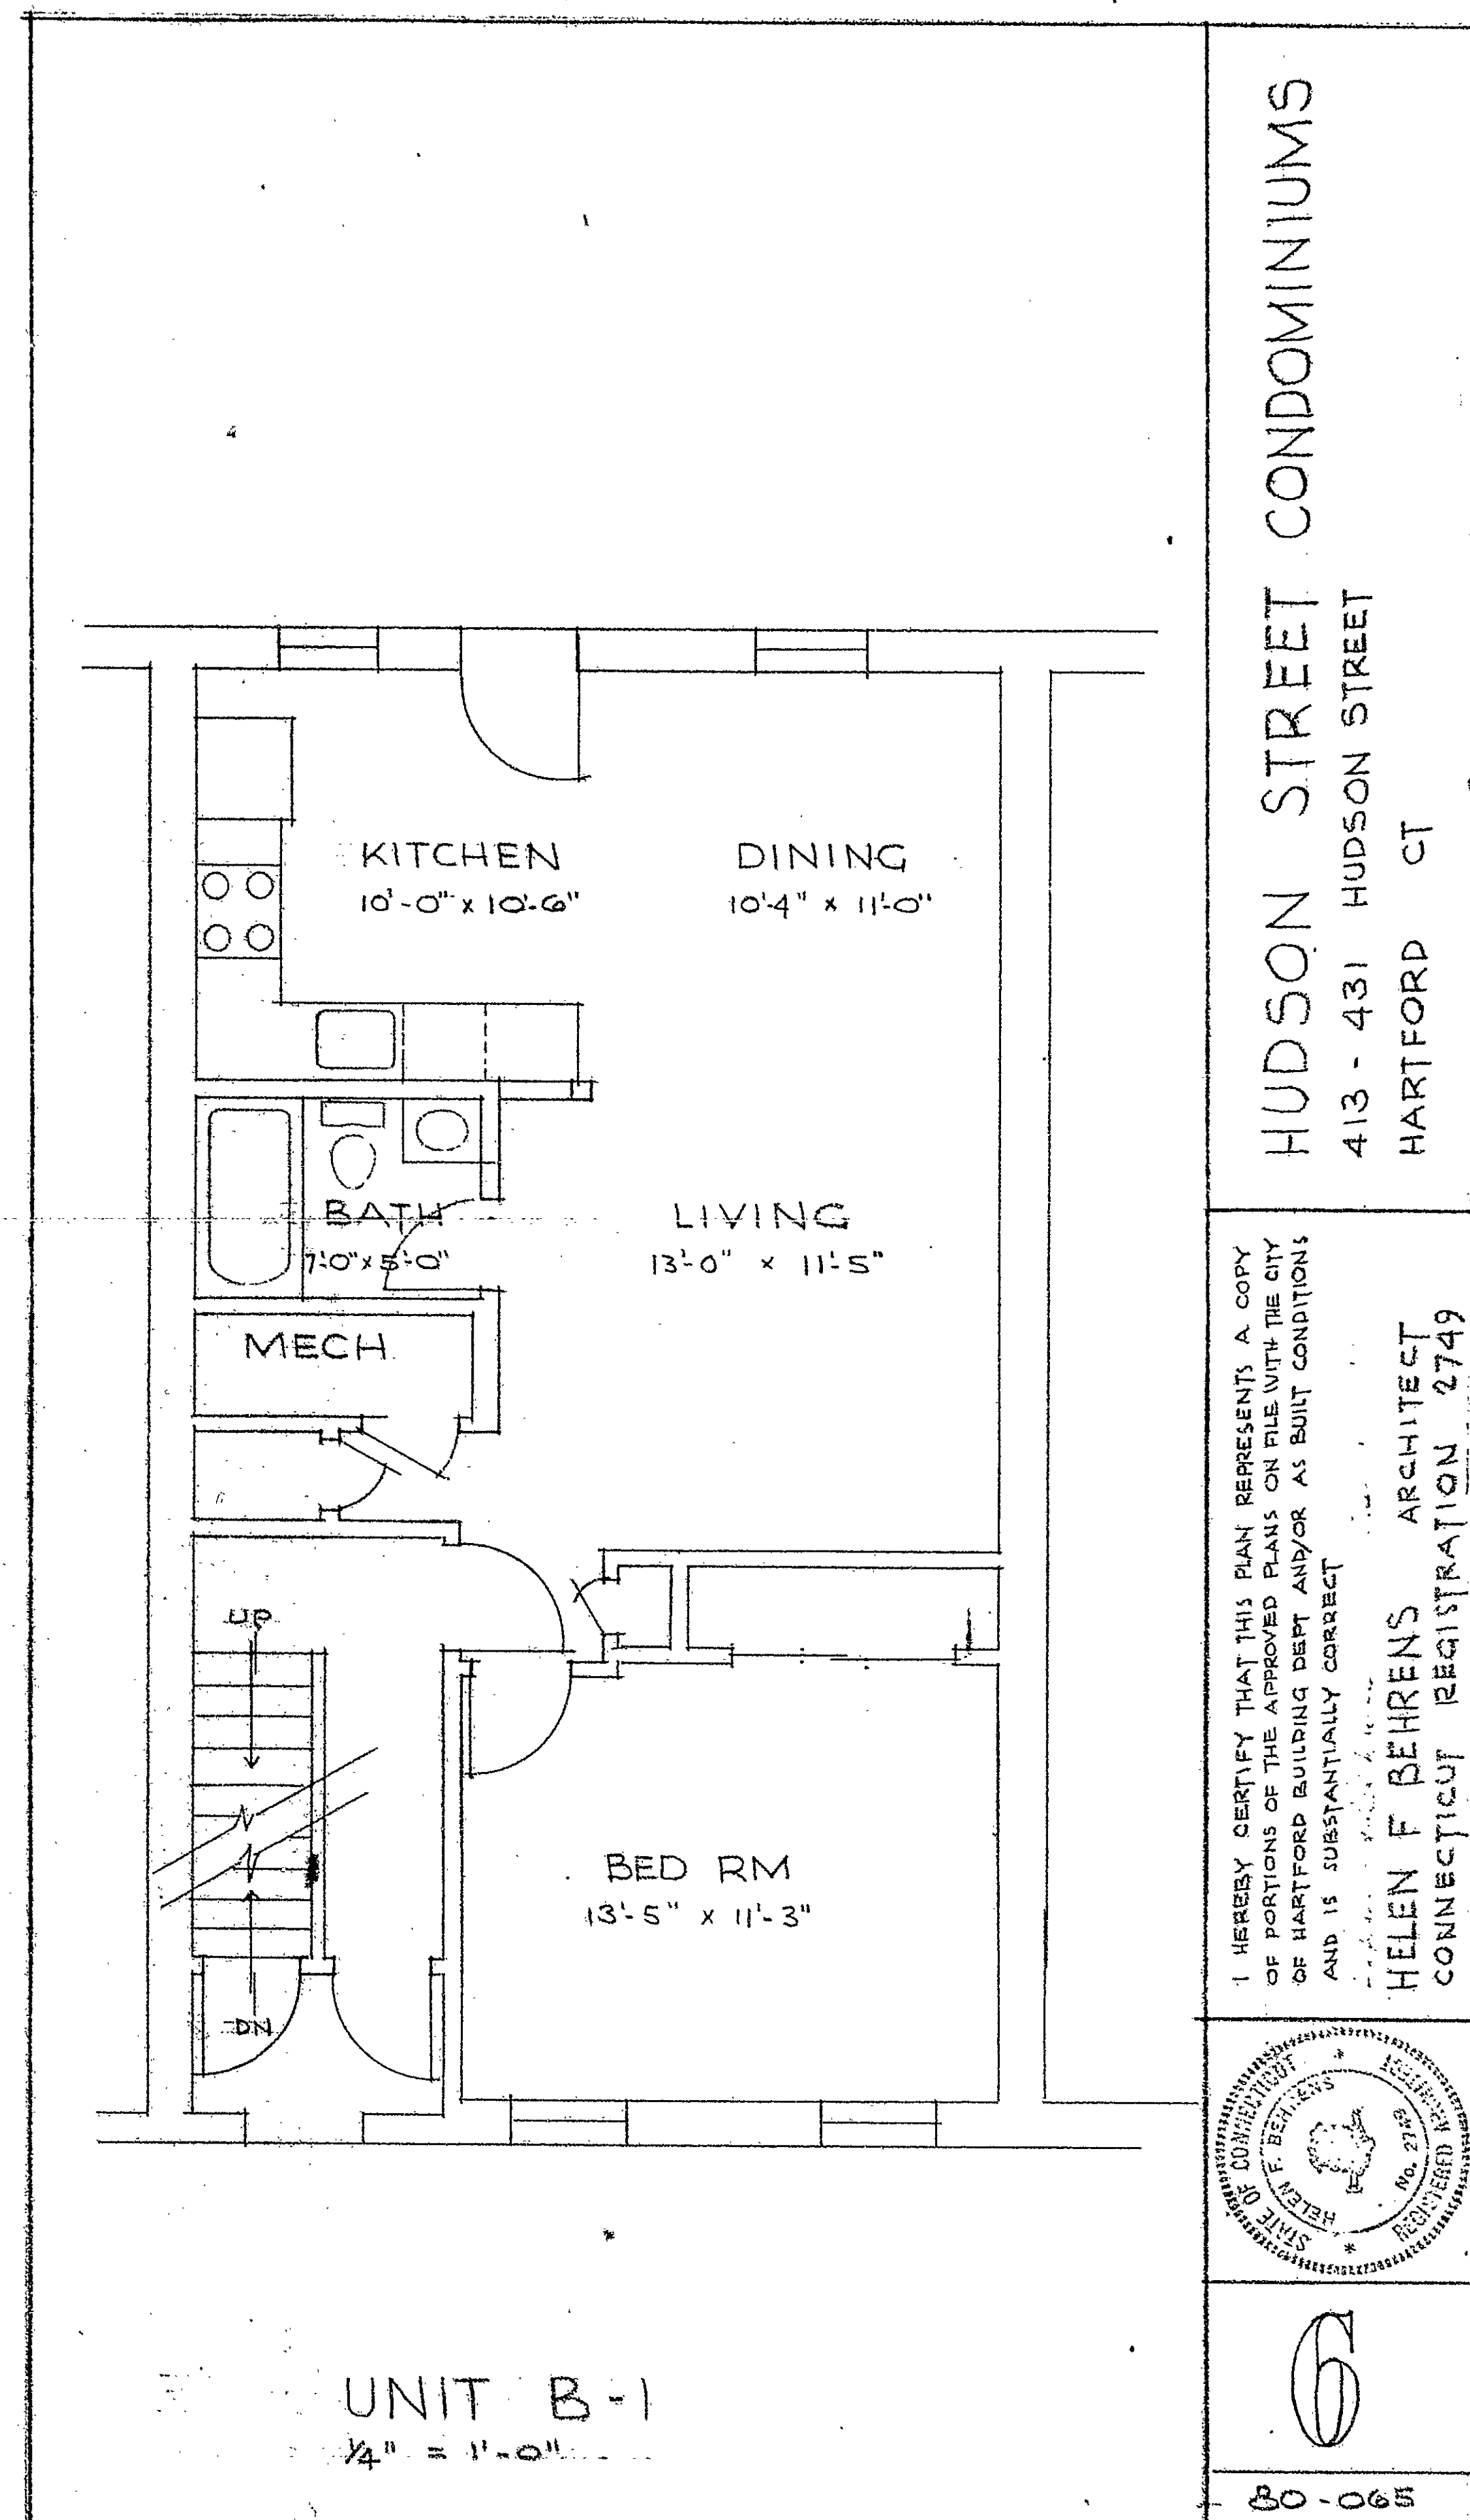


RECEIVED BY
DATE
TOWN & CITY CLERK
PAGE 104

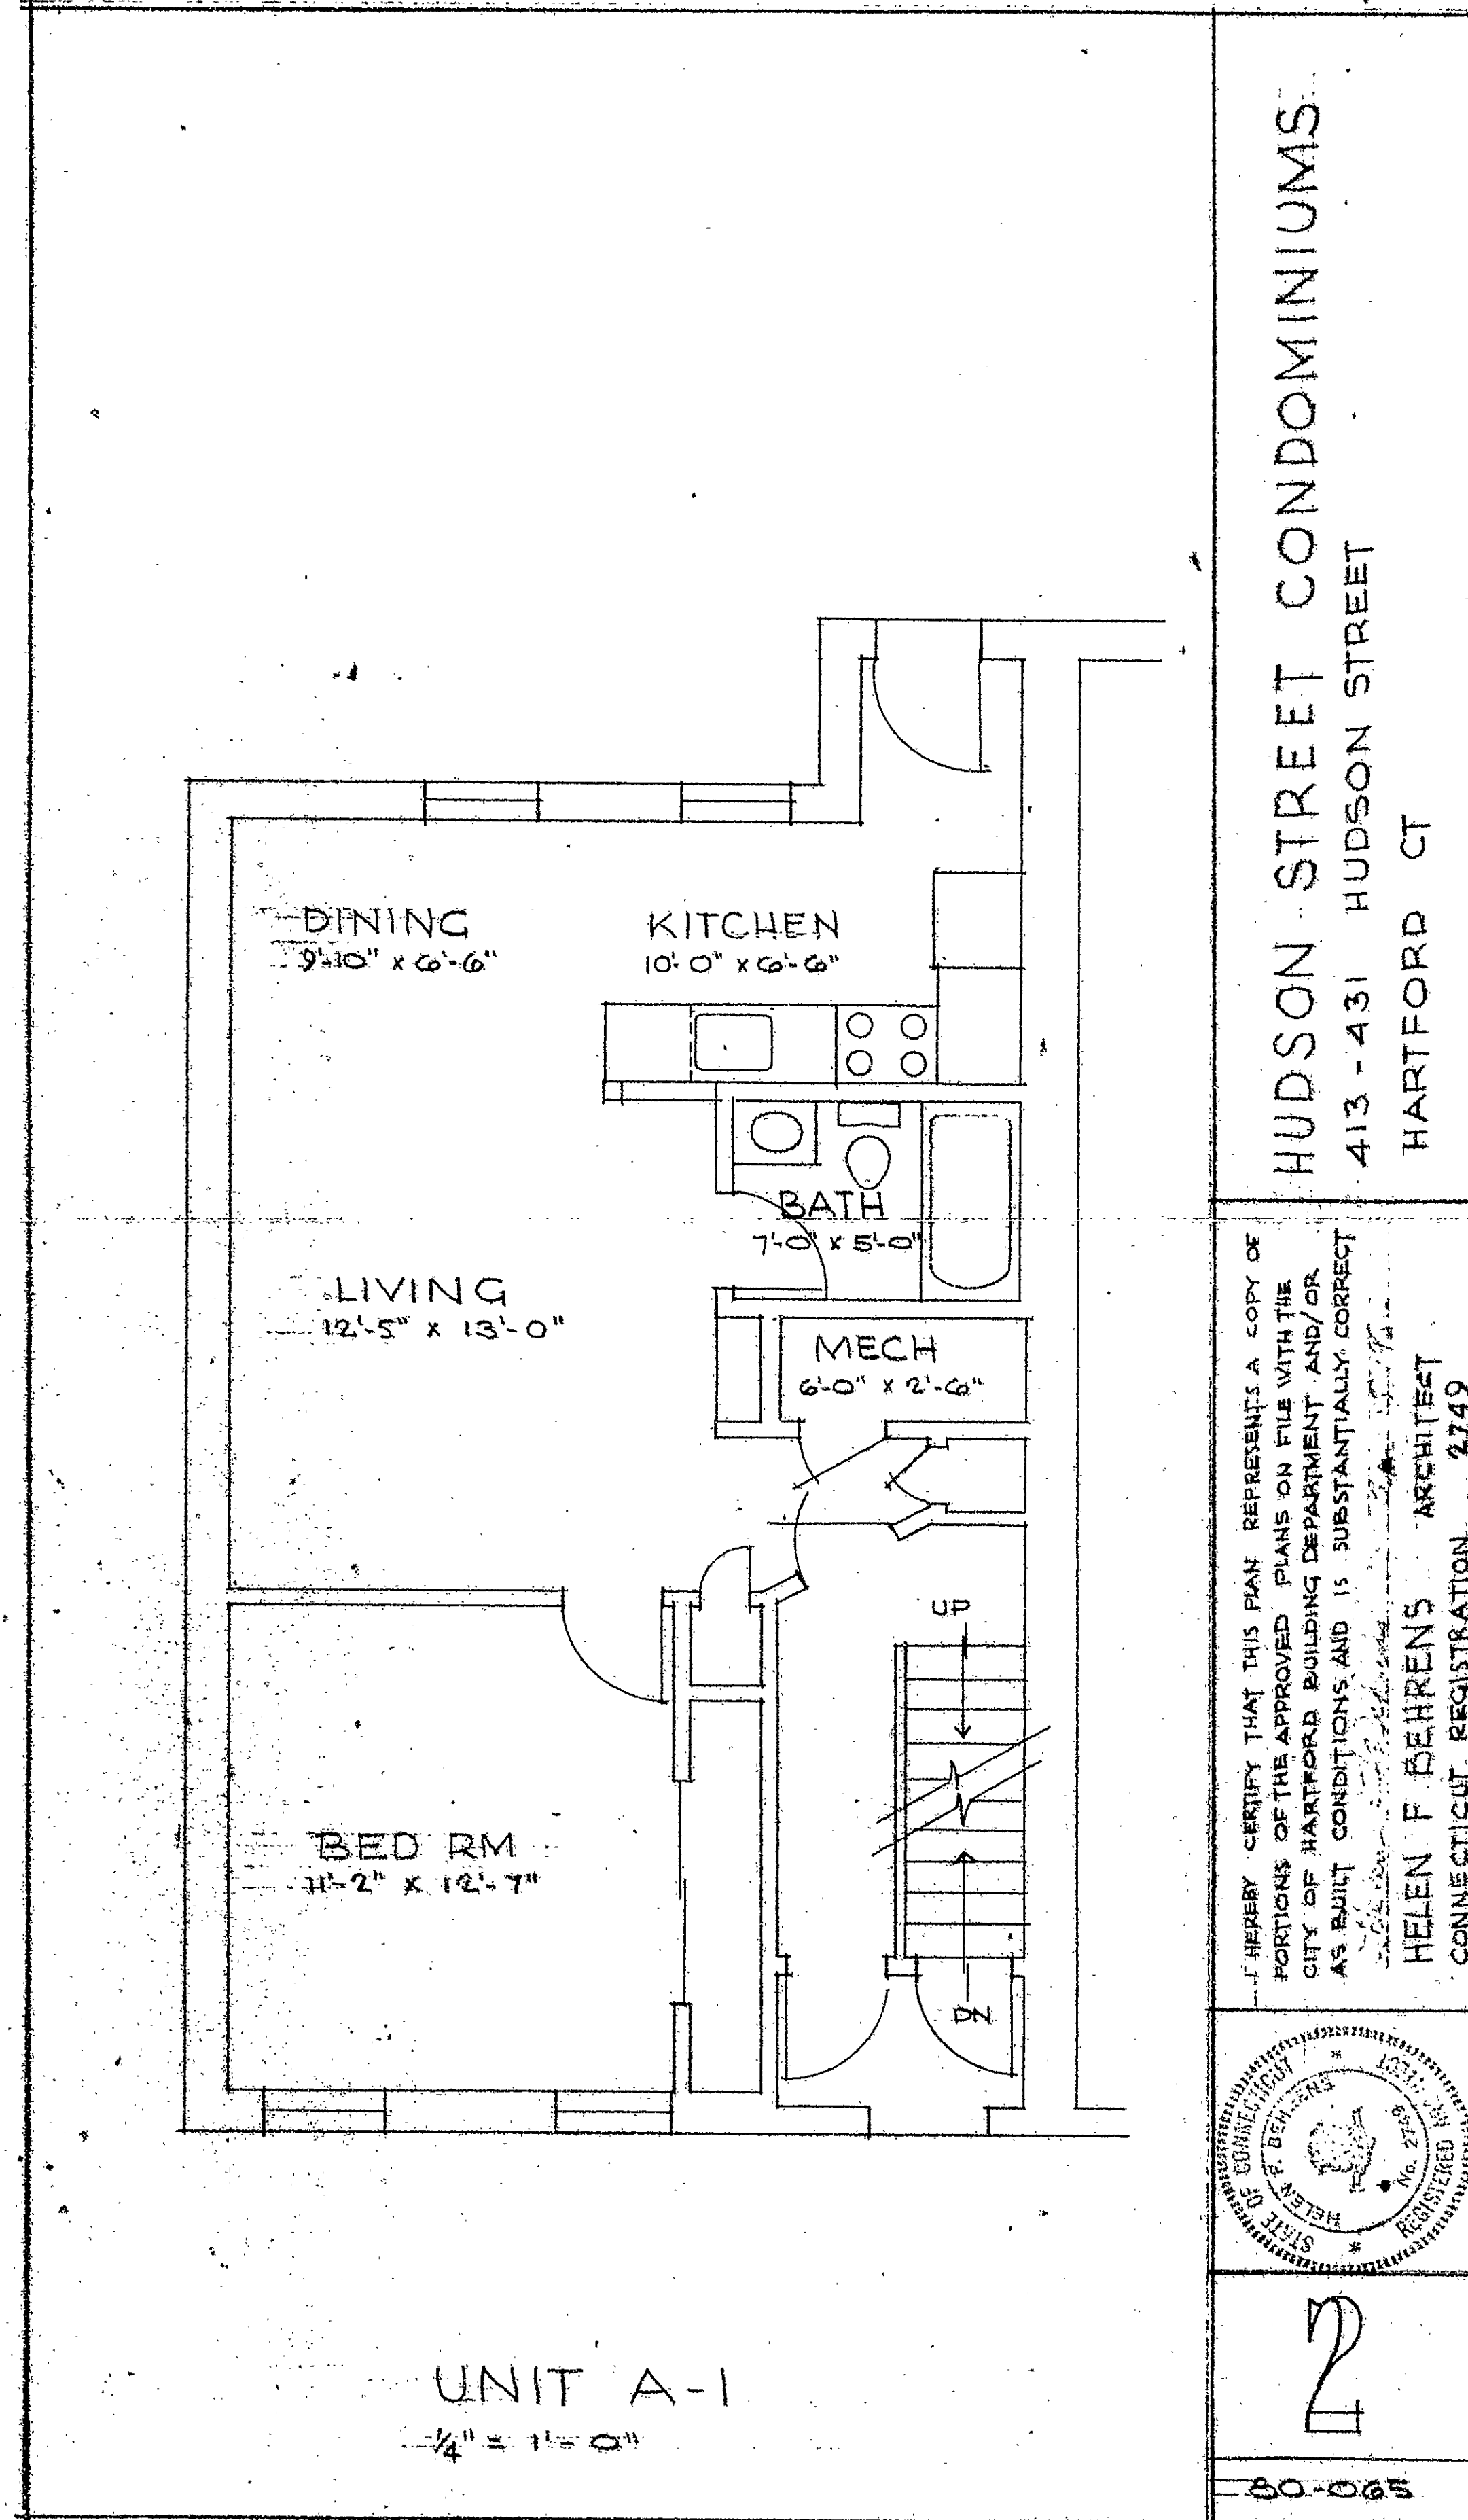

0 INCHES 1 2 3 4

Ends Floor Plan # 37