



RECEIVED BY
 12/24/74 12:20 PM
 1000 A. CITY CLERK
 1000 A. 7030

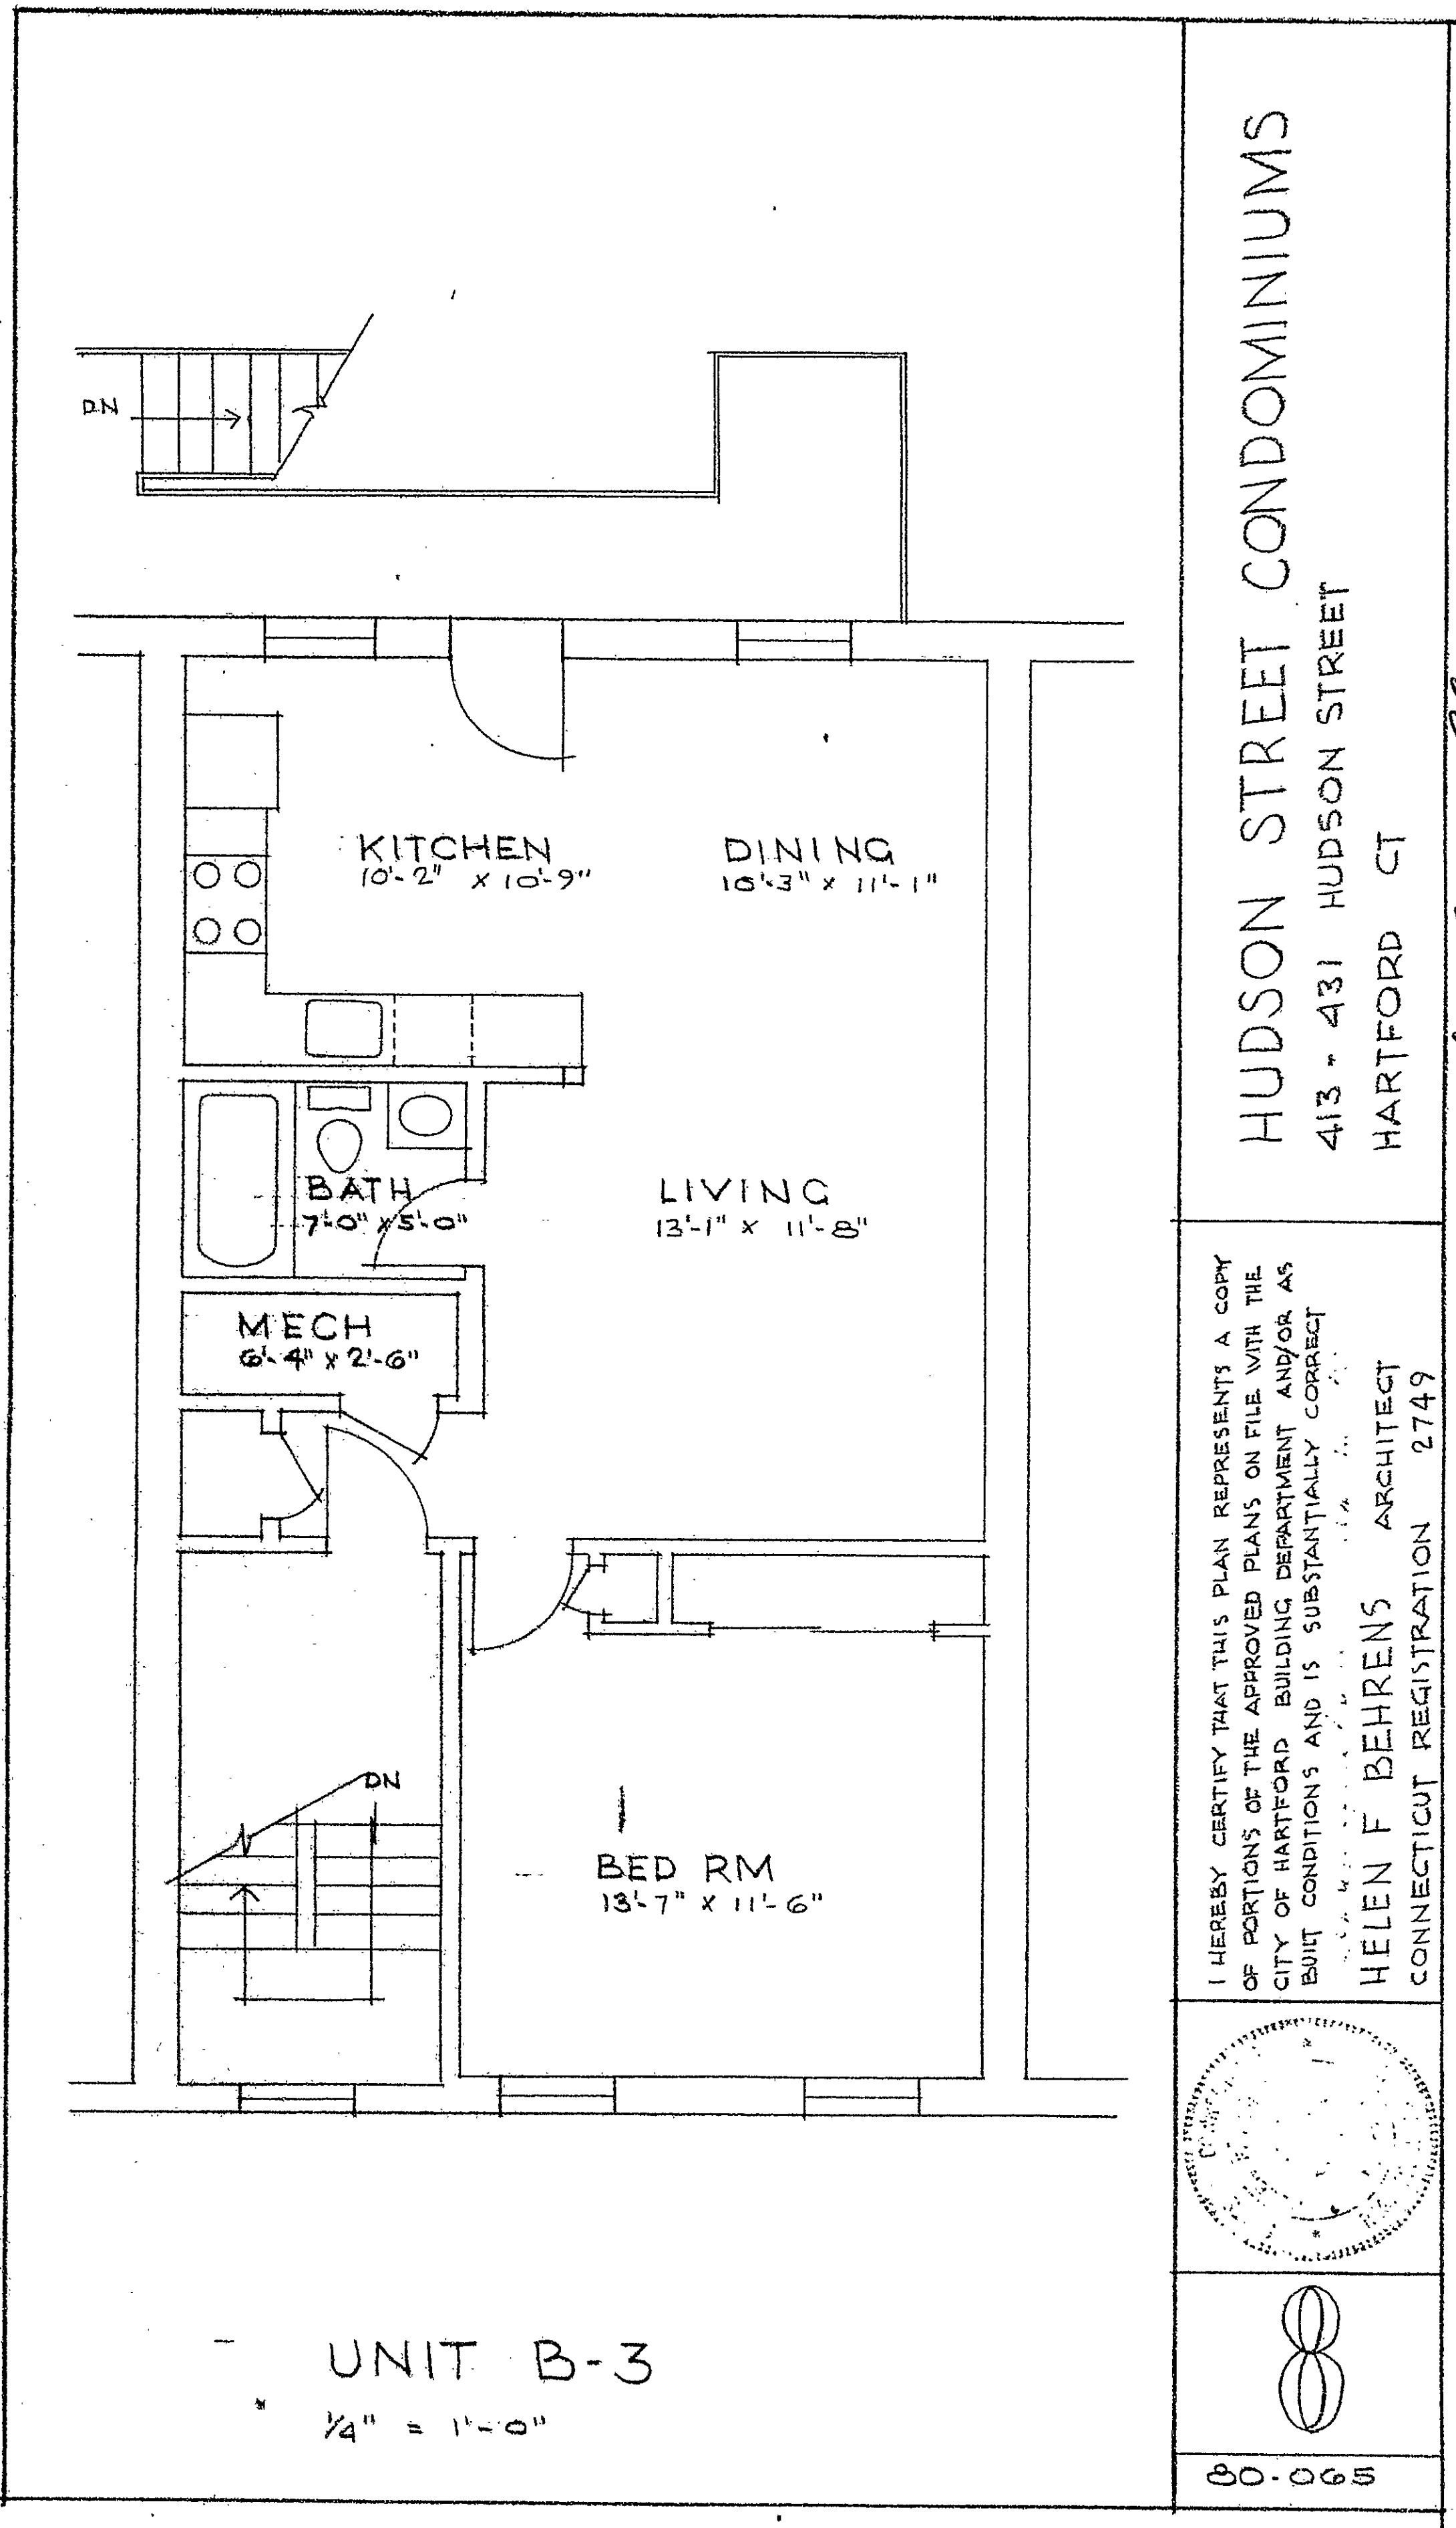

Unit Floor Plan #37

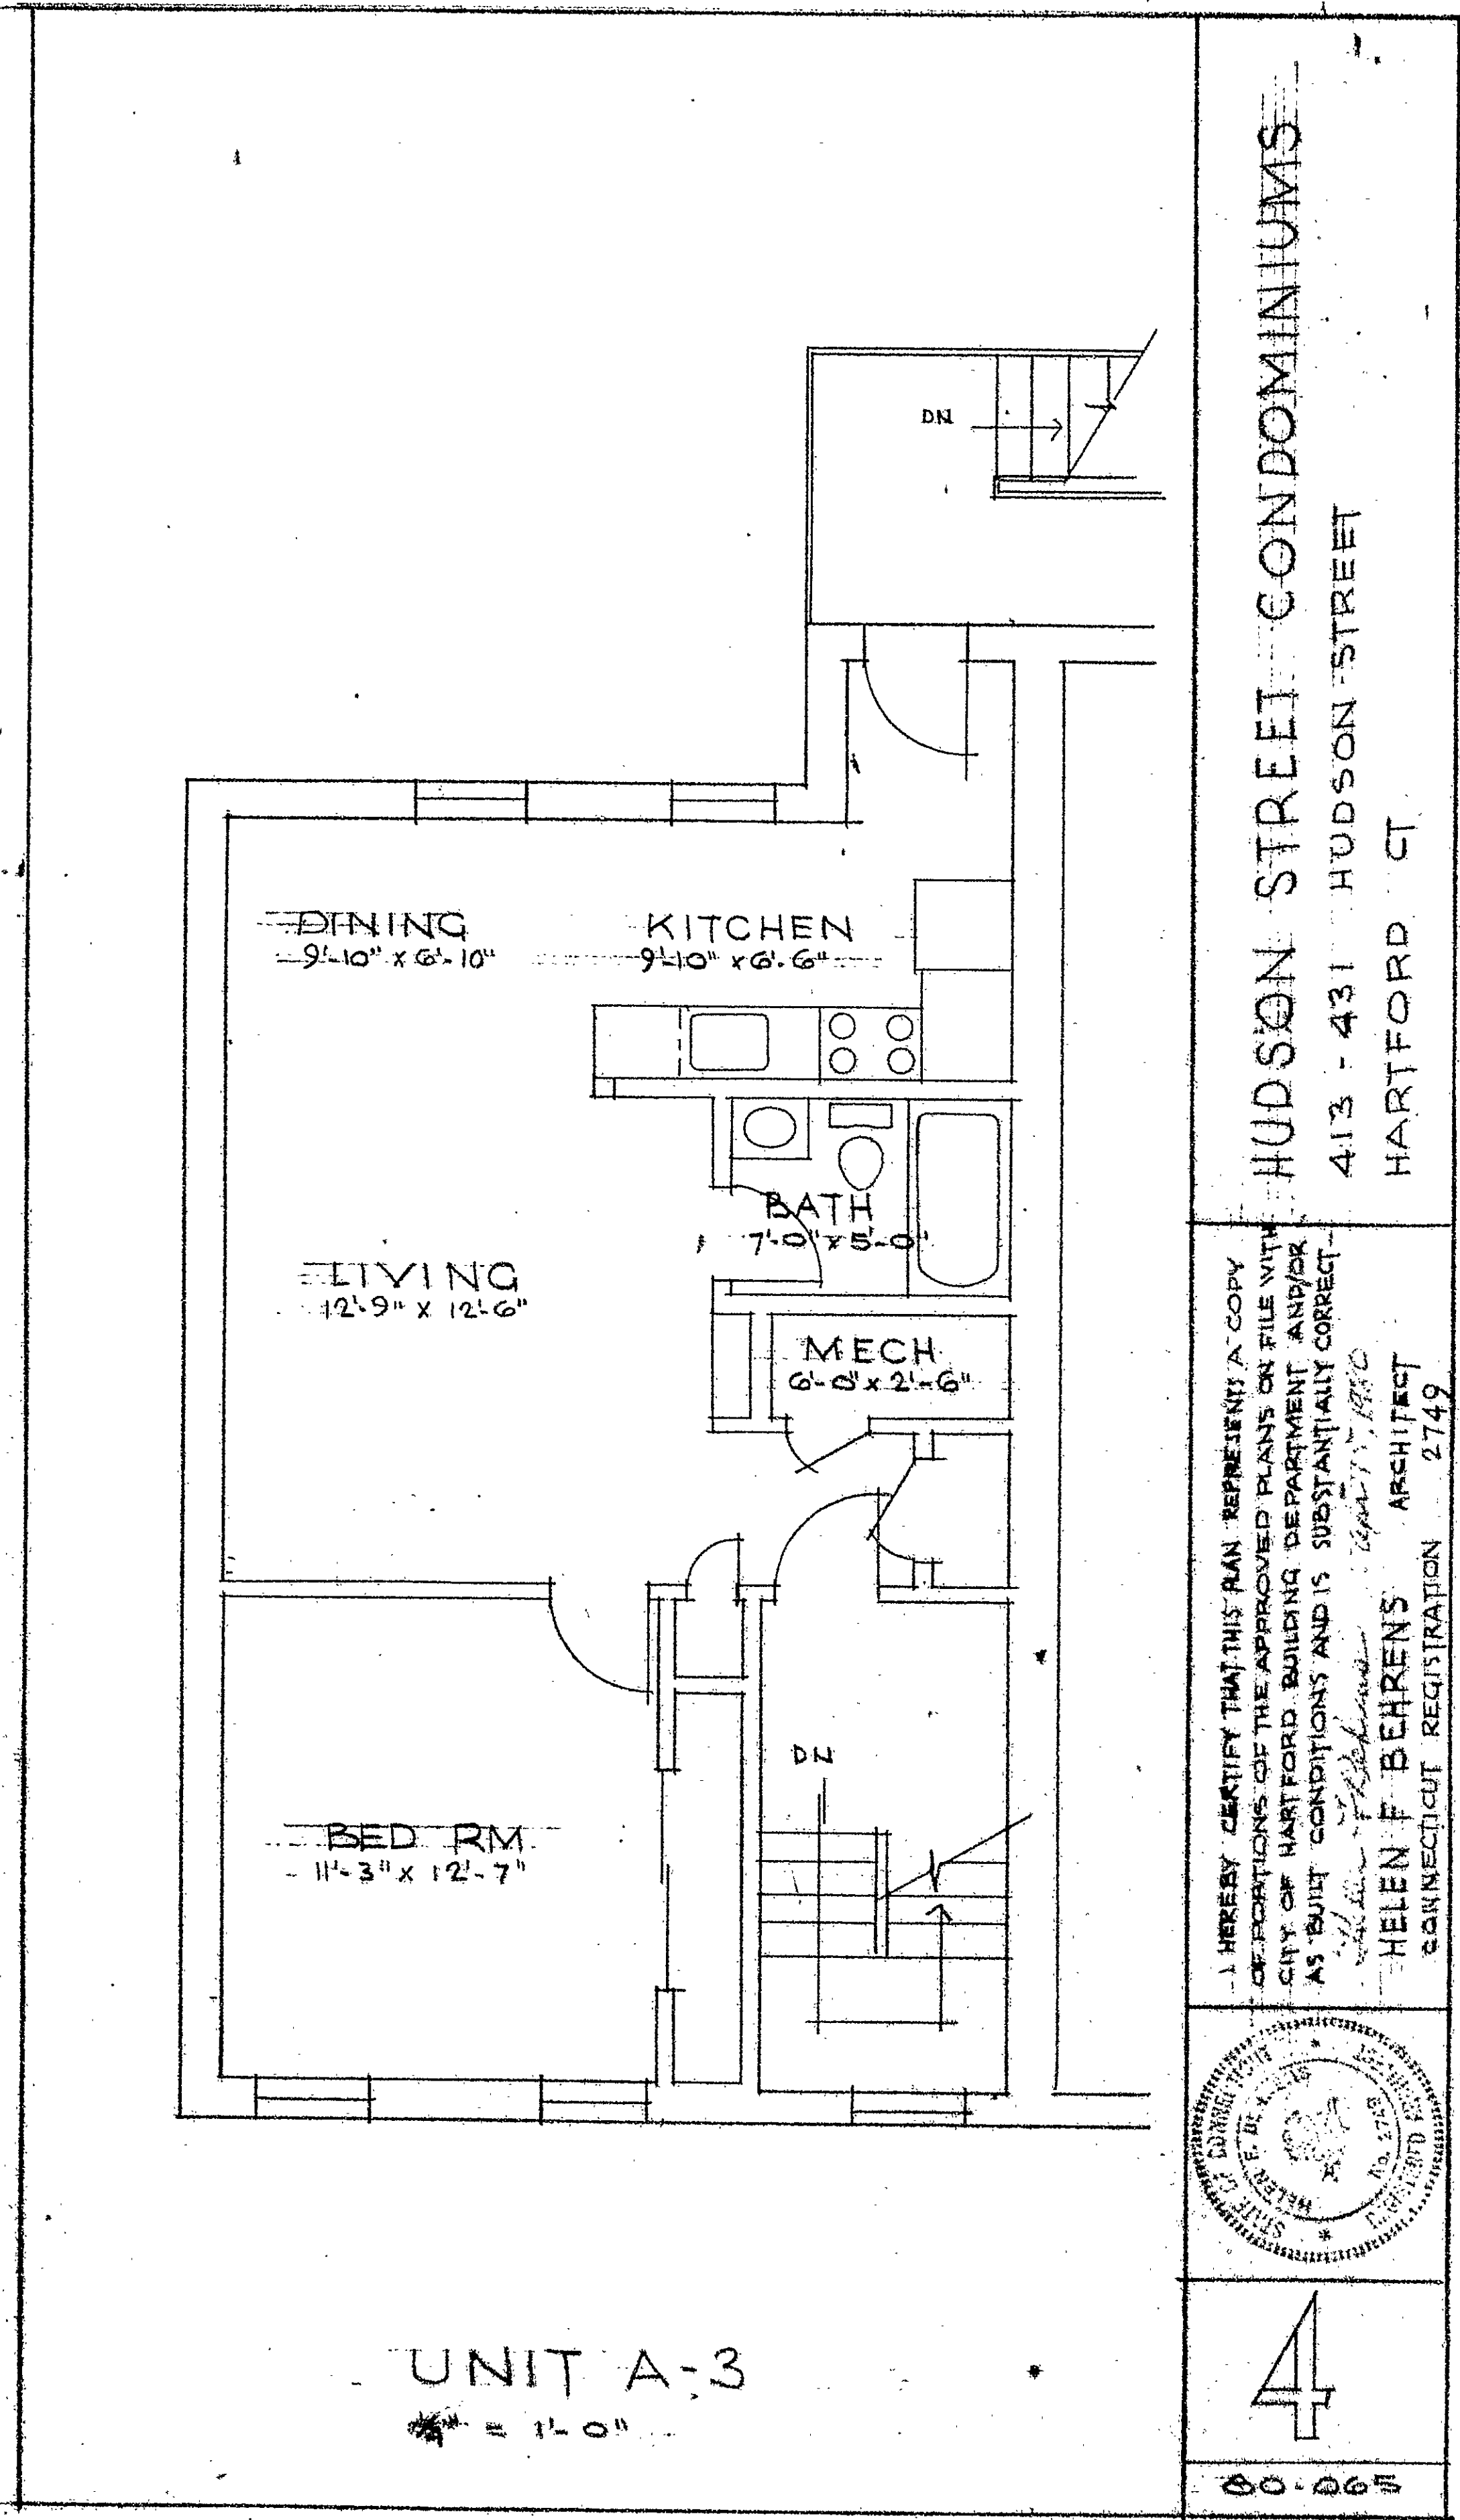