
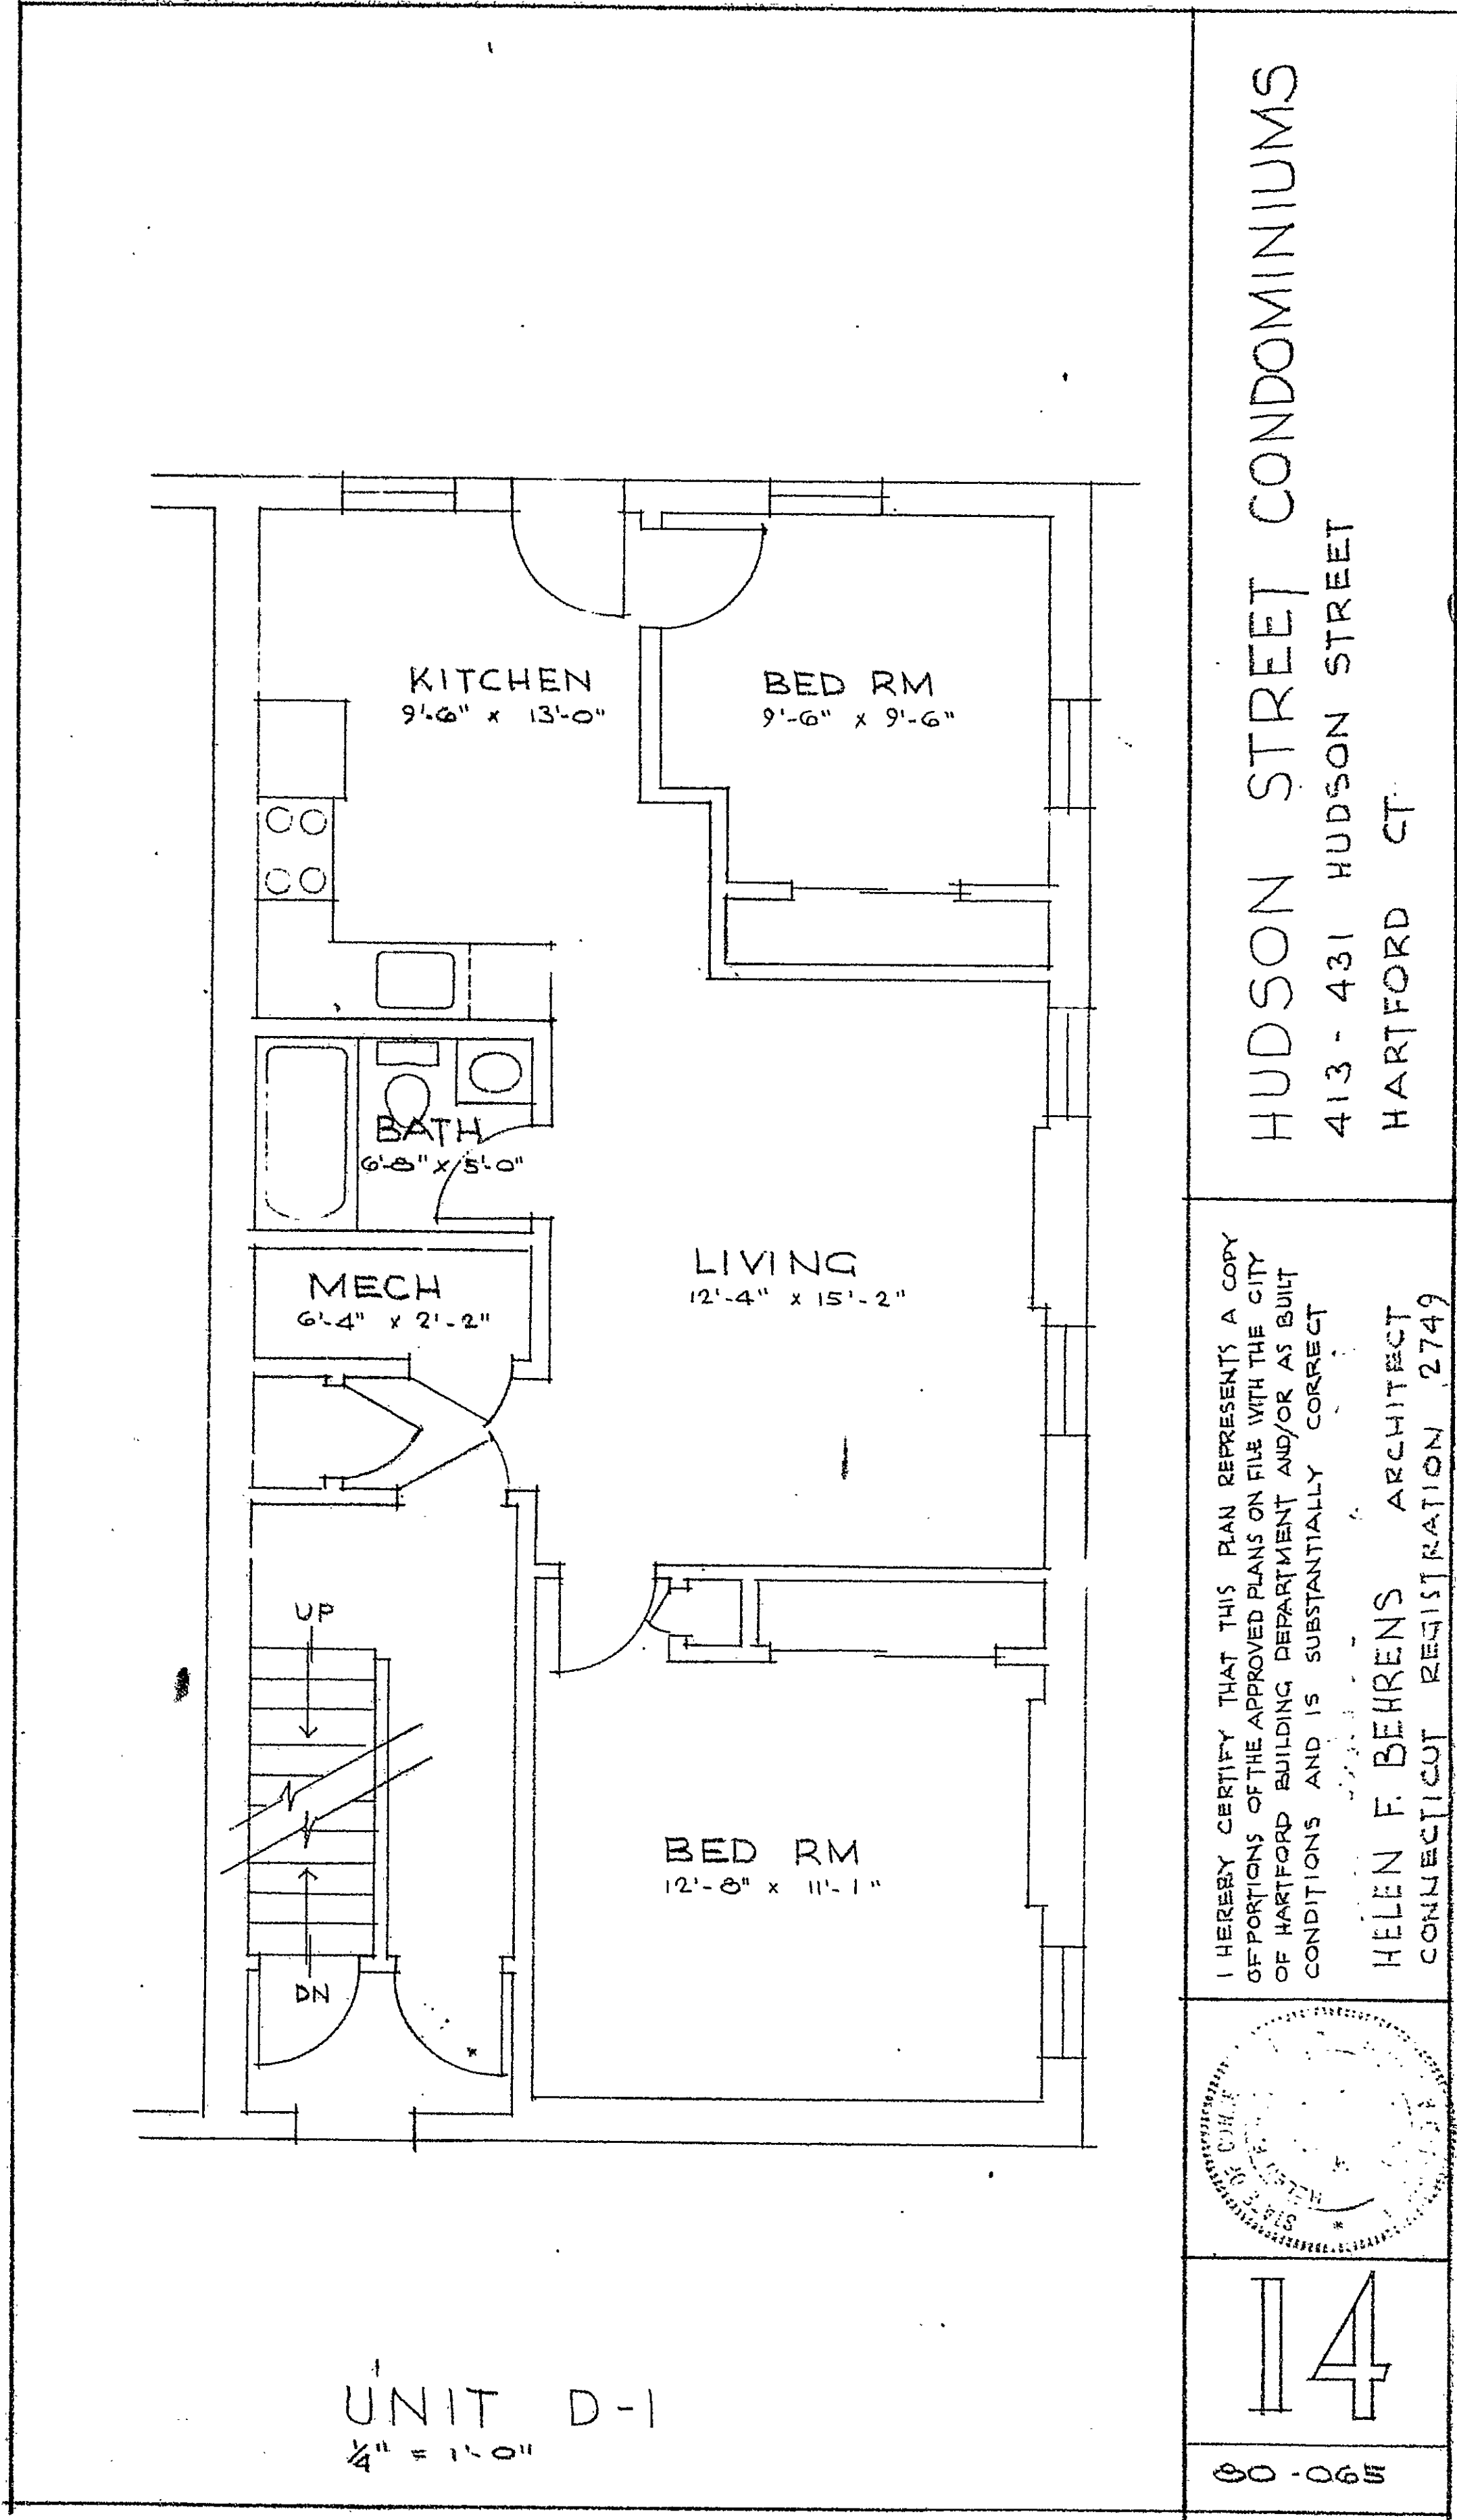


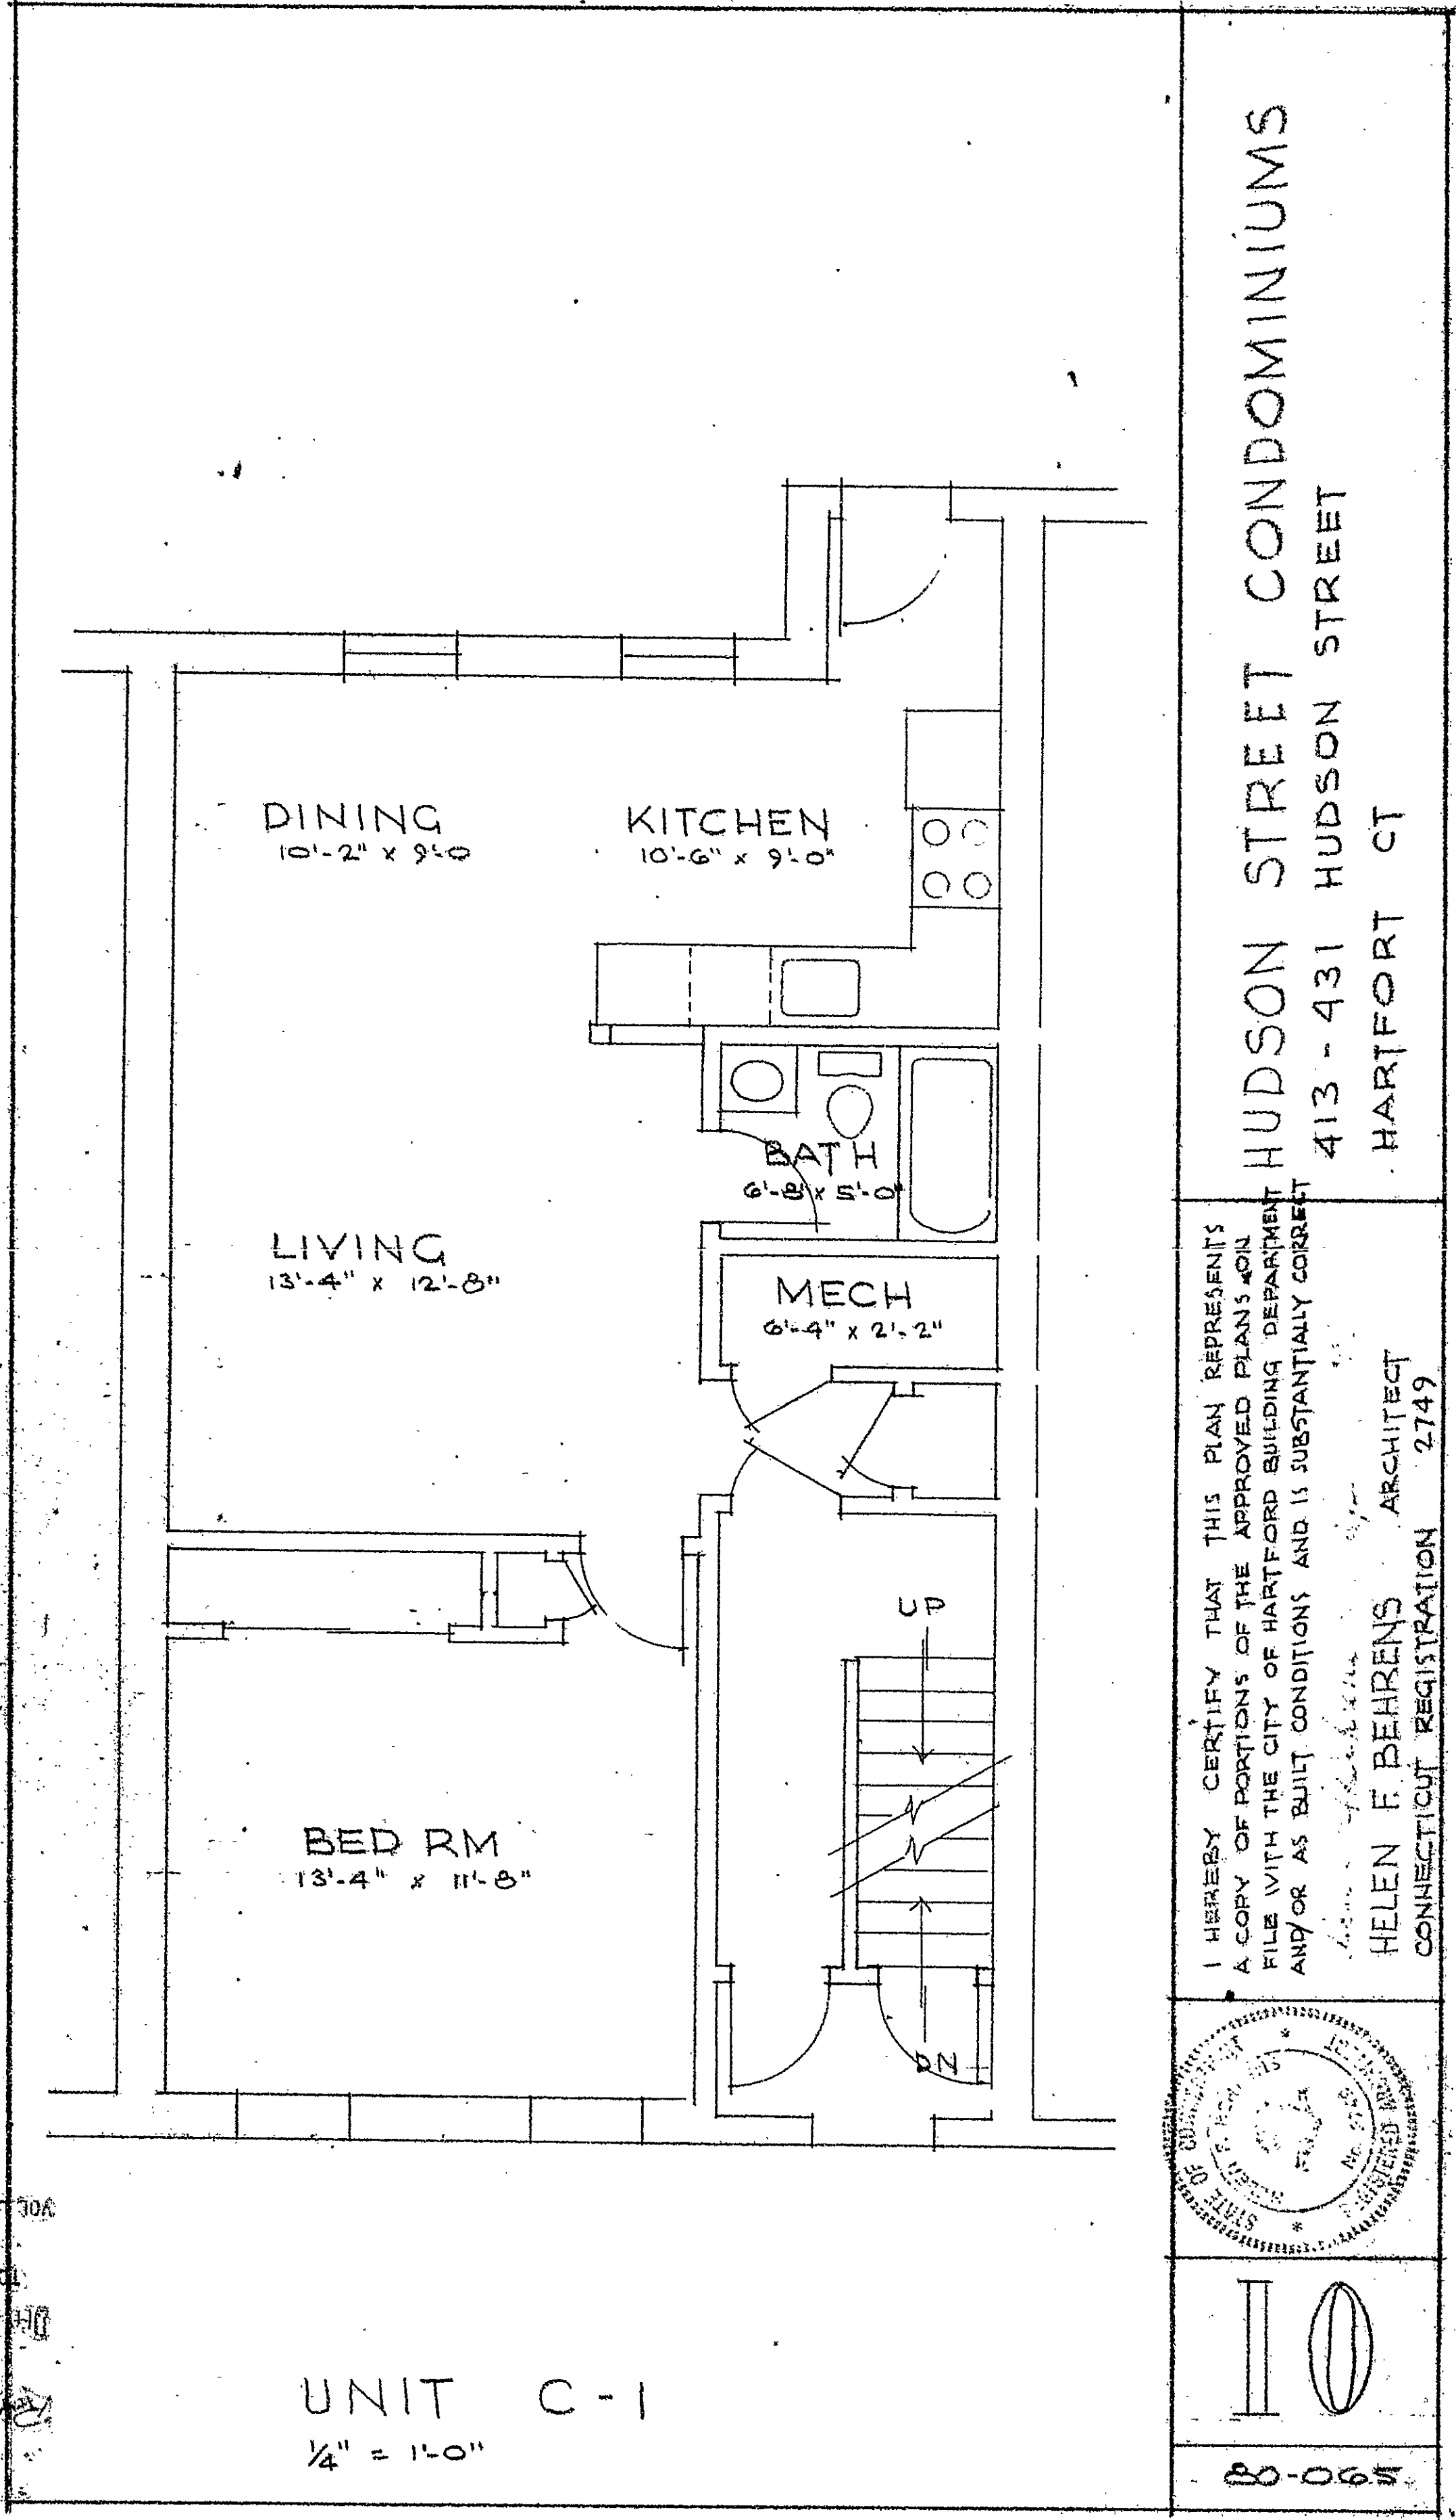

*Condo Floor Plan # 37*