
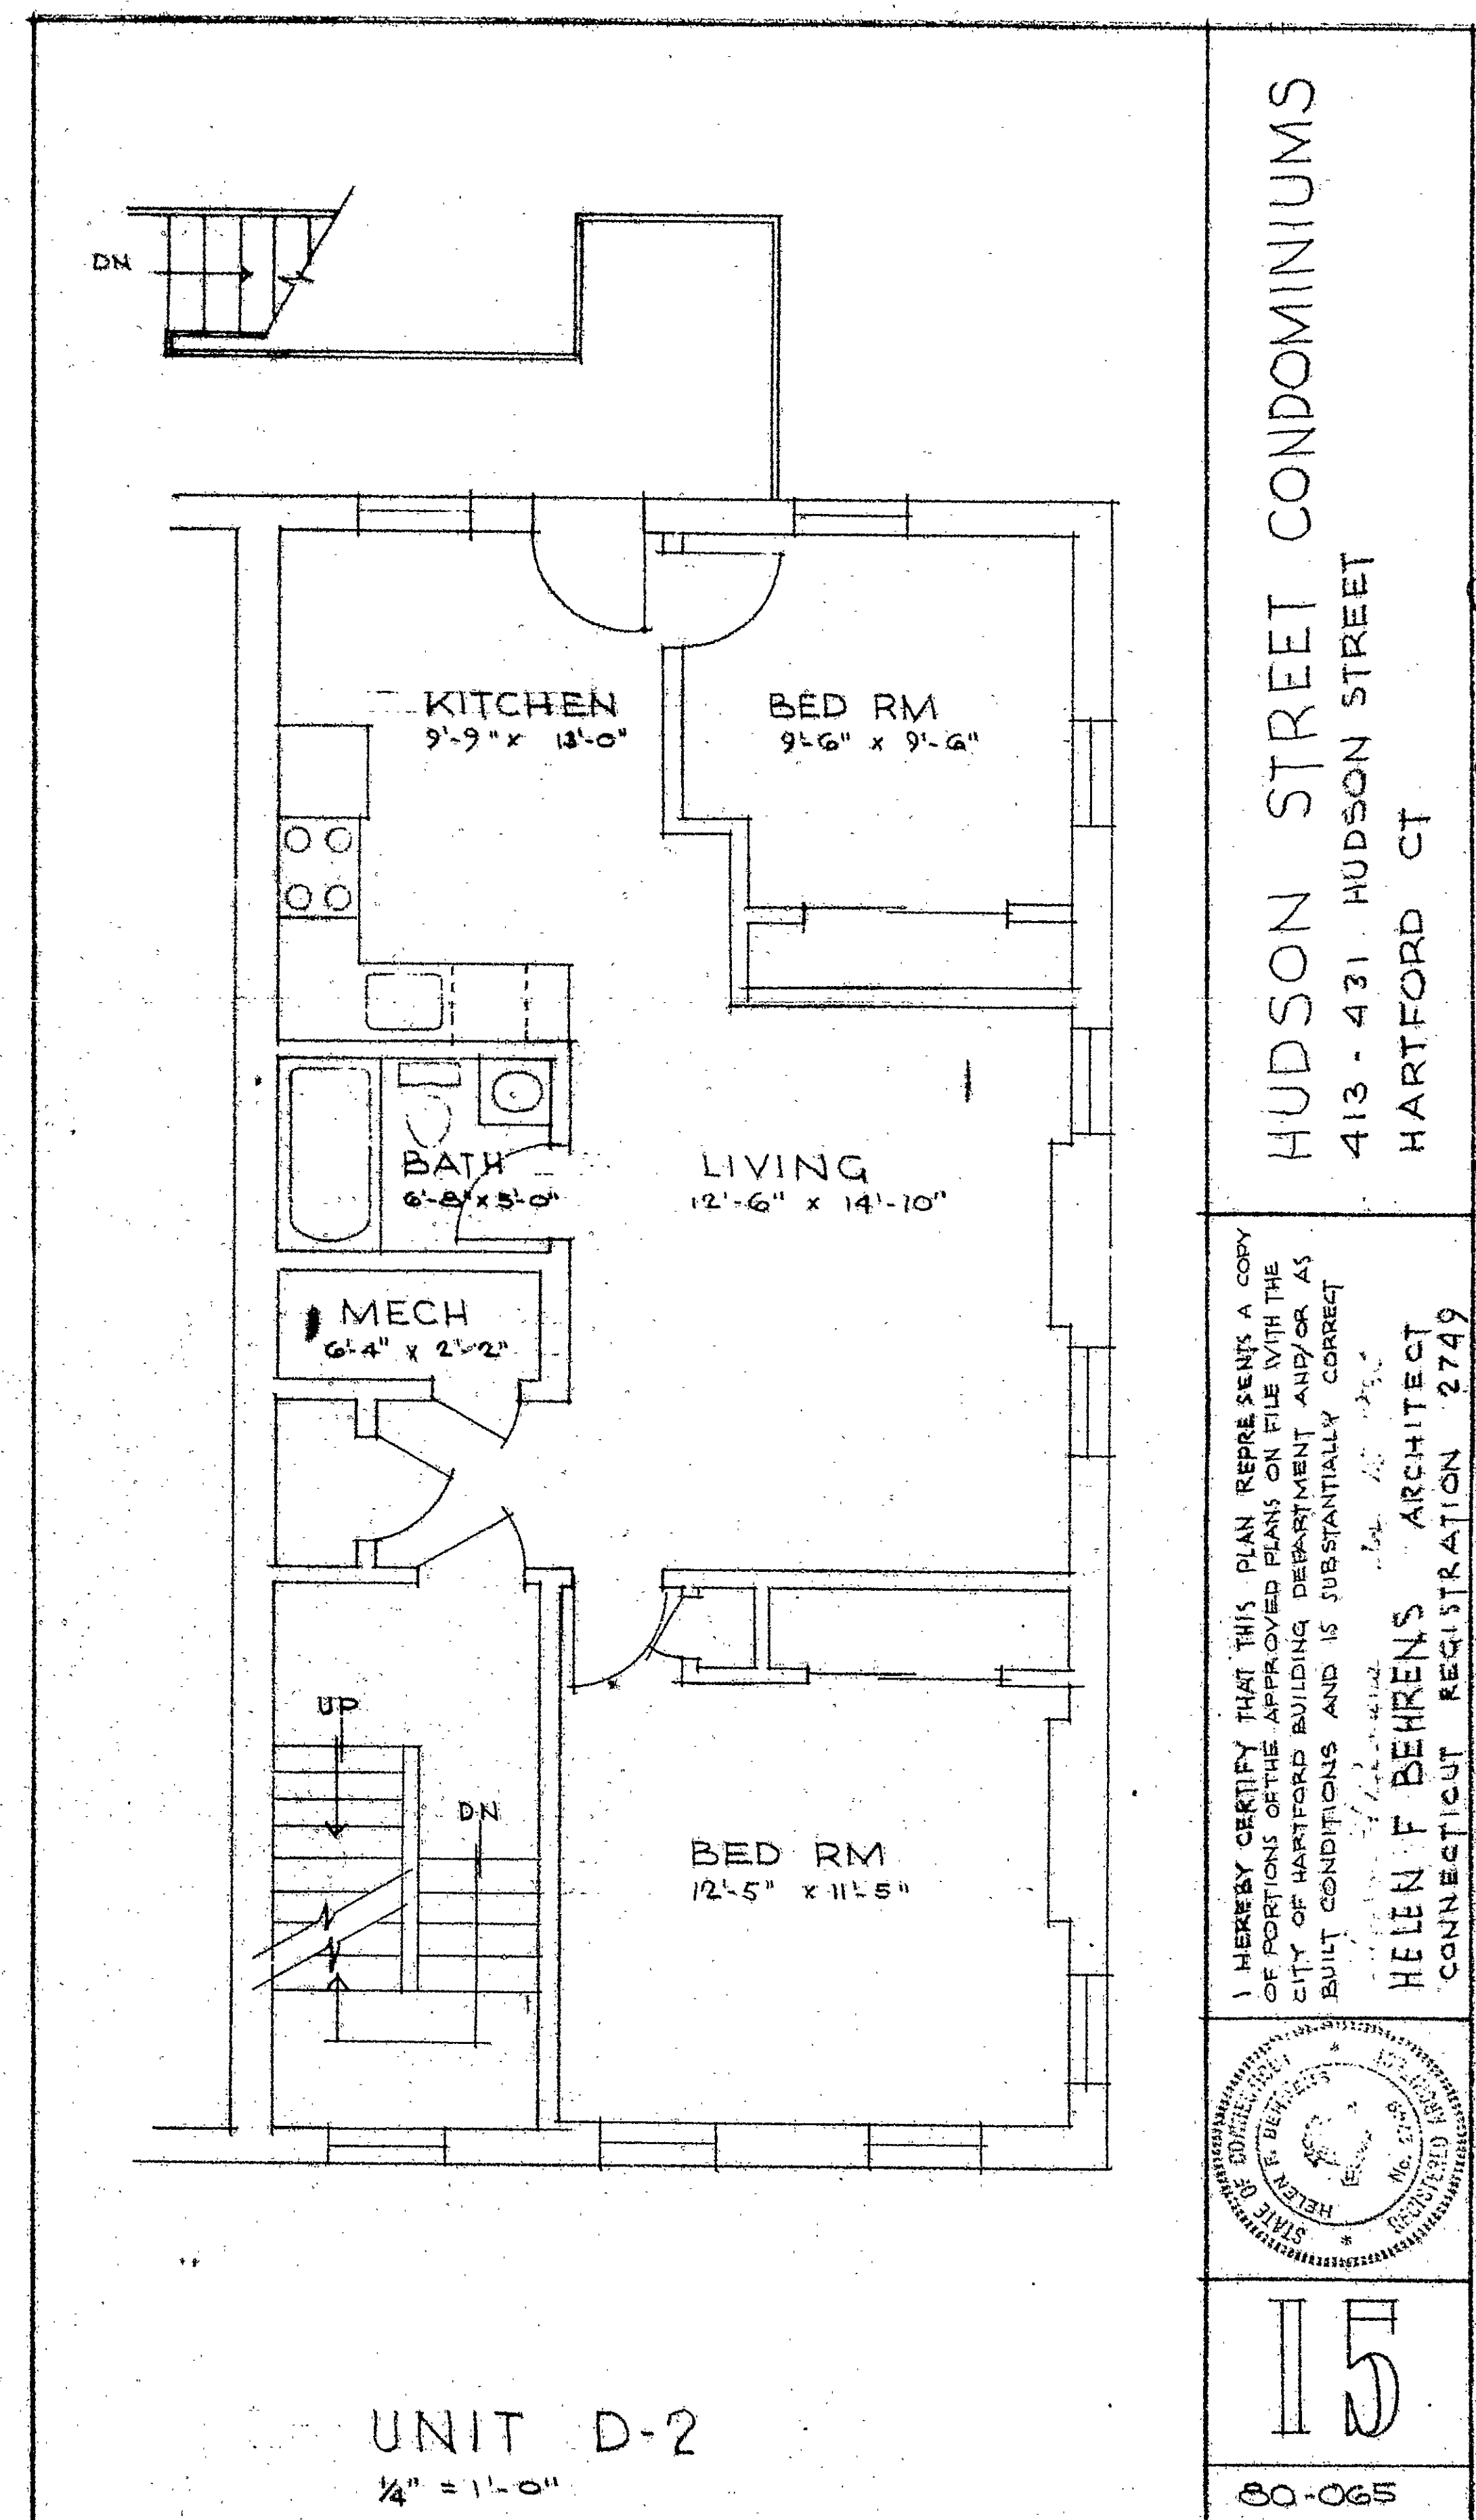


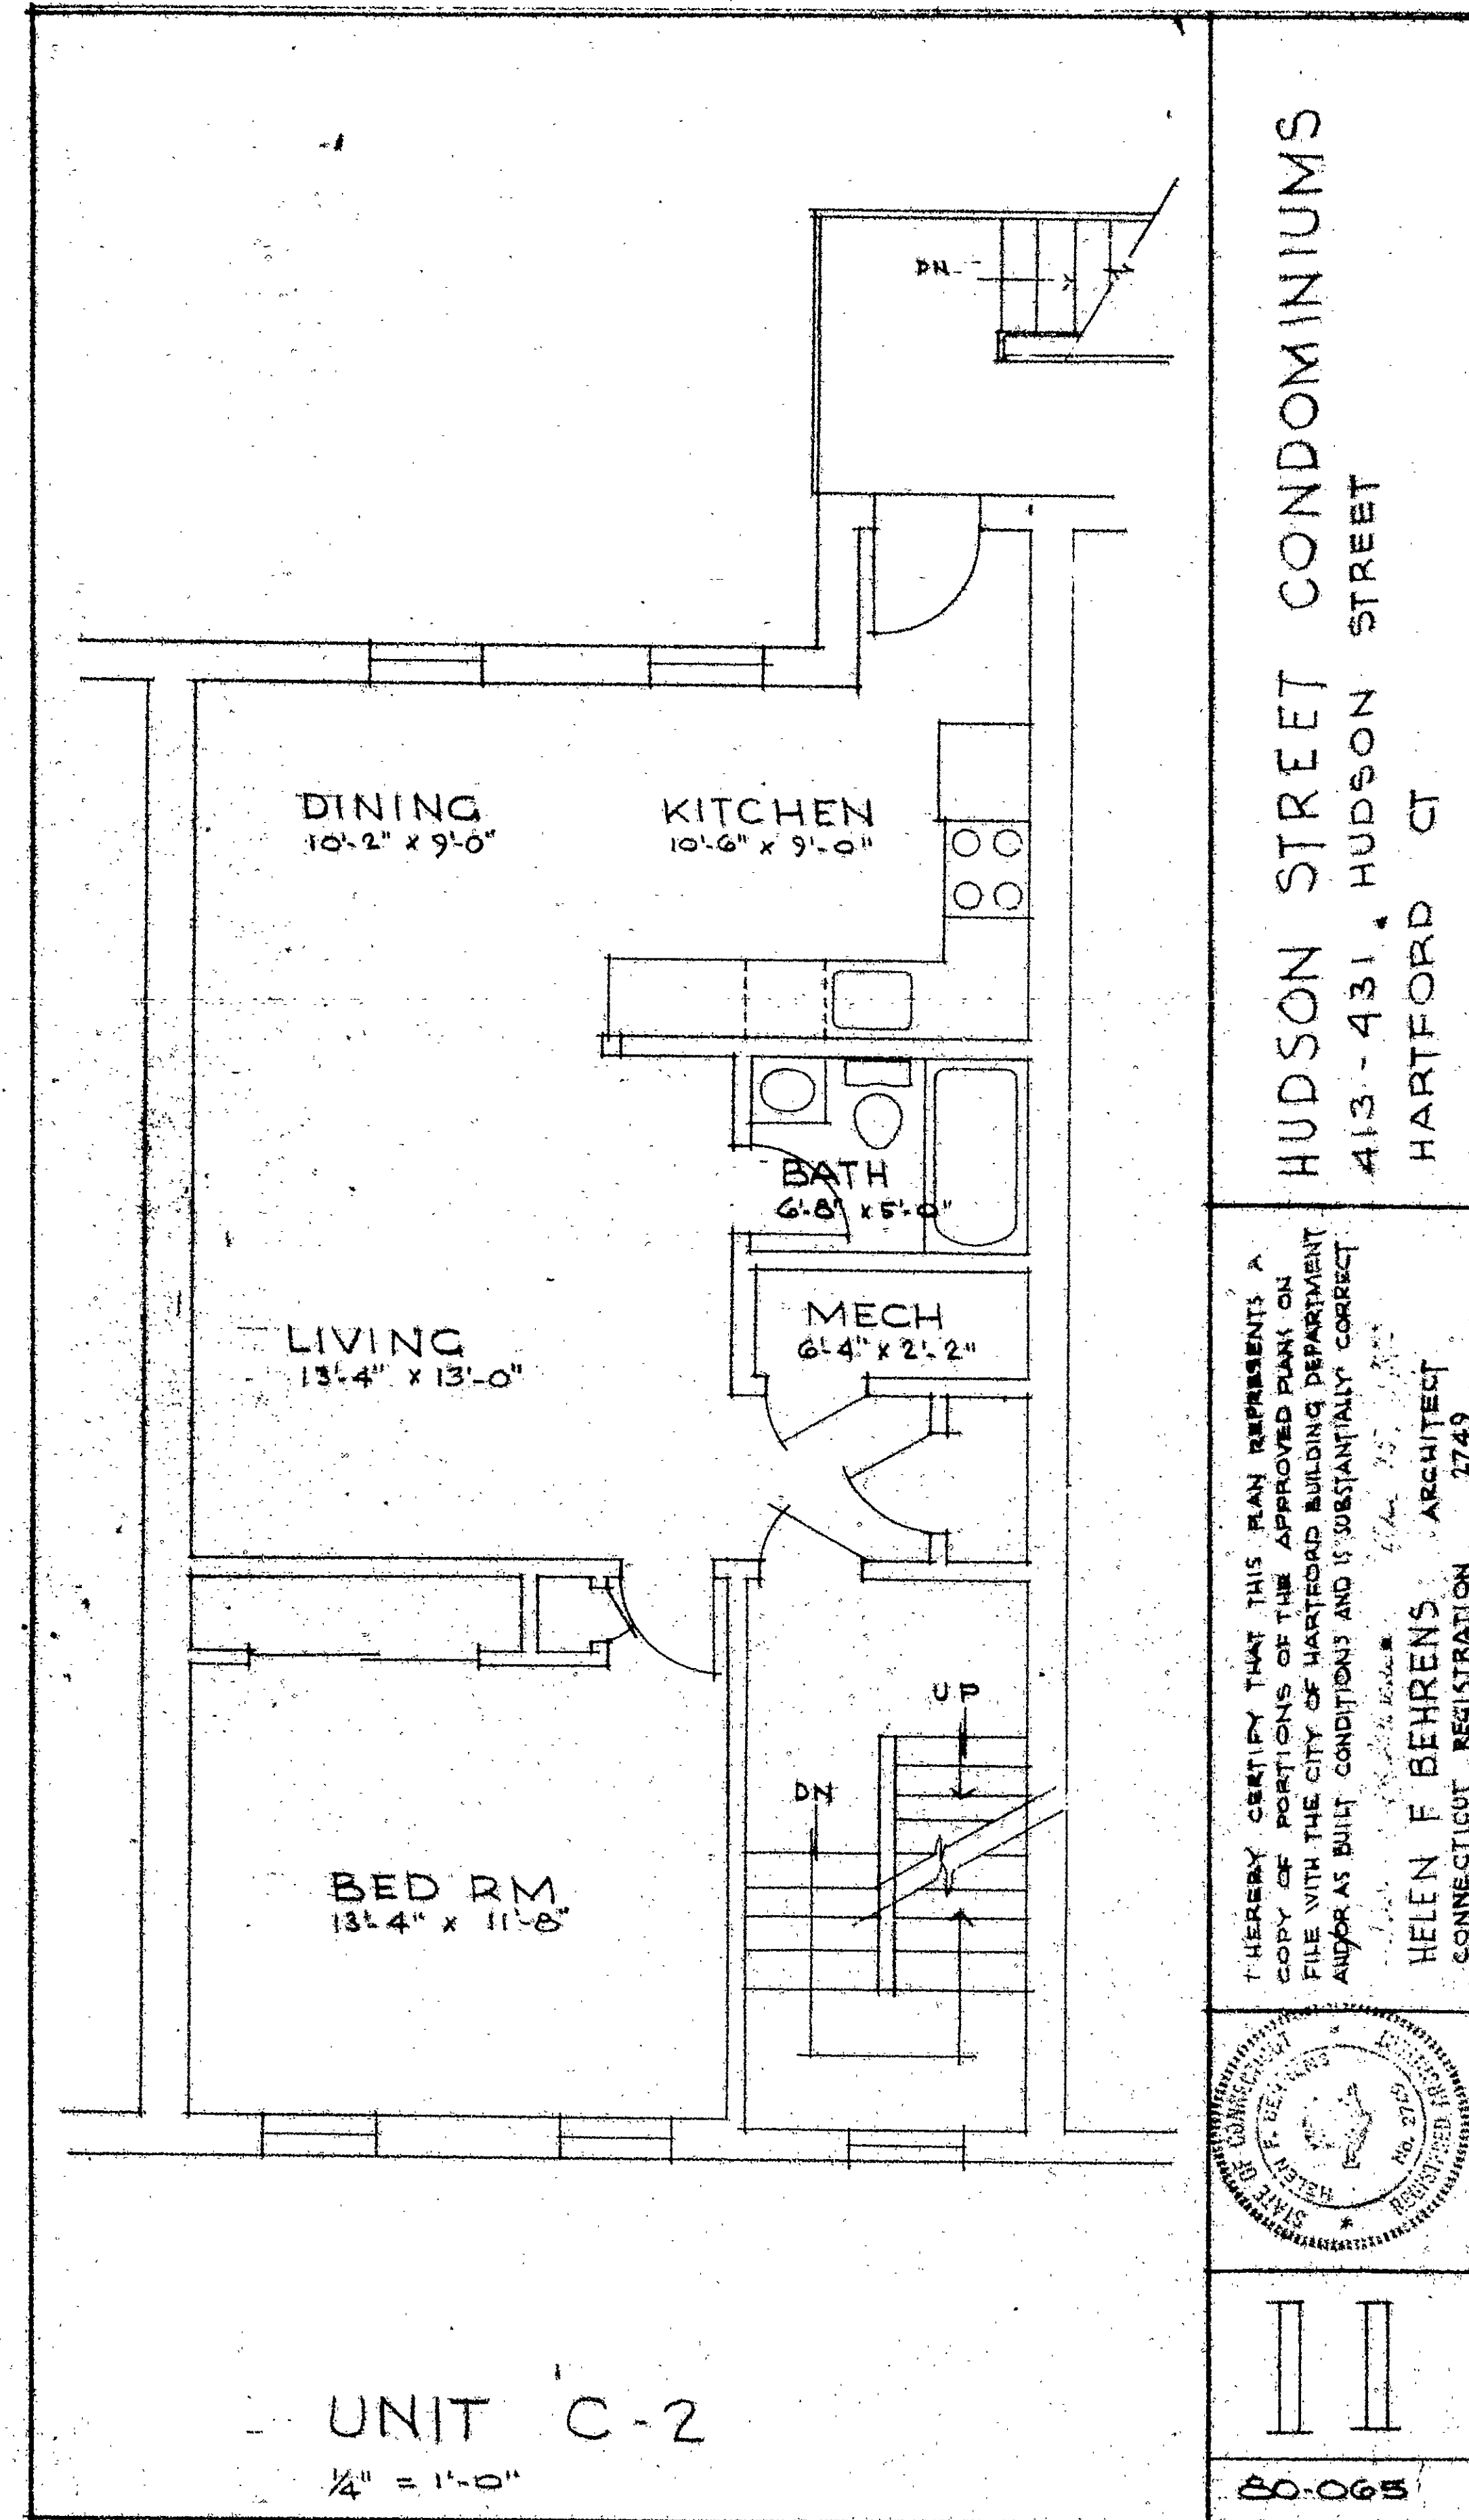

*Condo Floor Plan #37*