
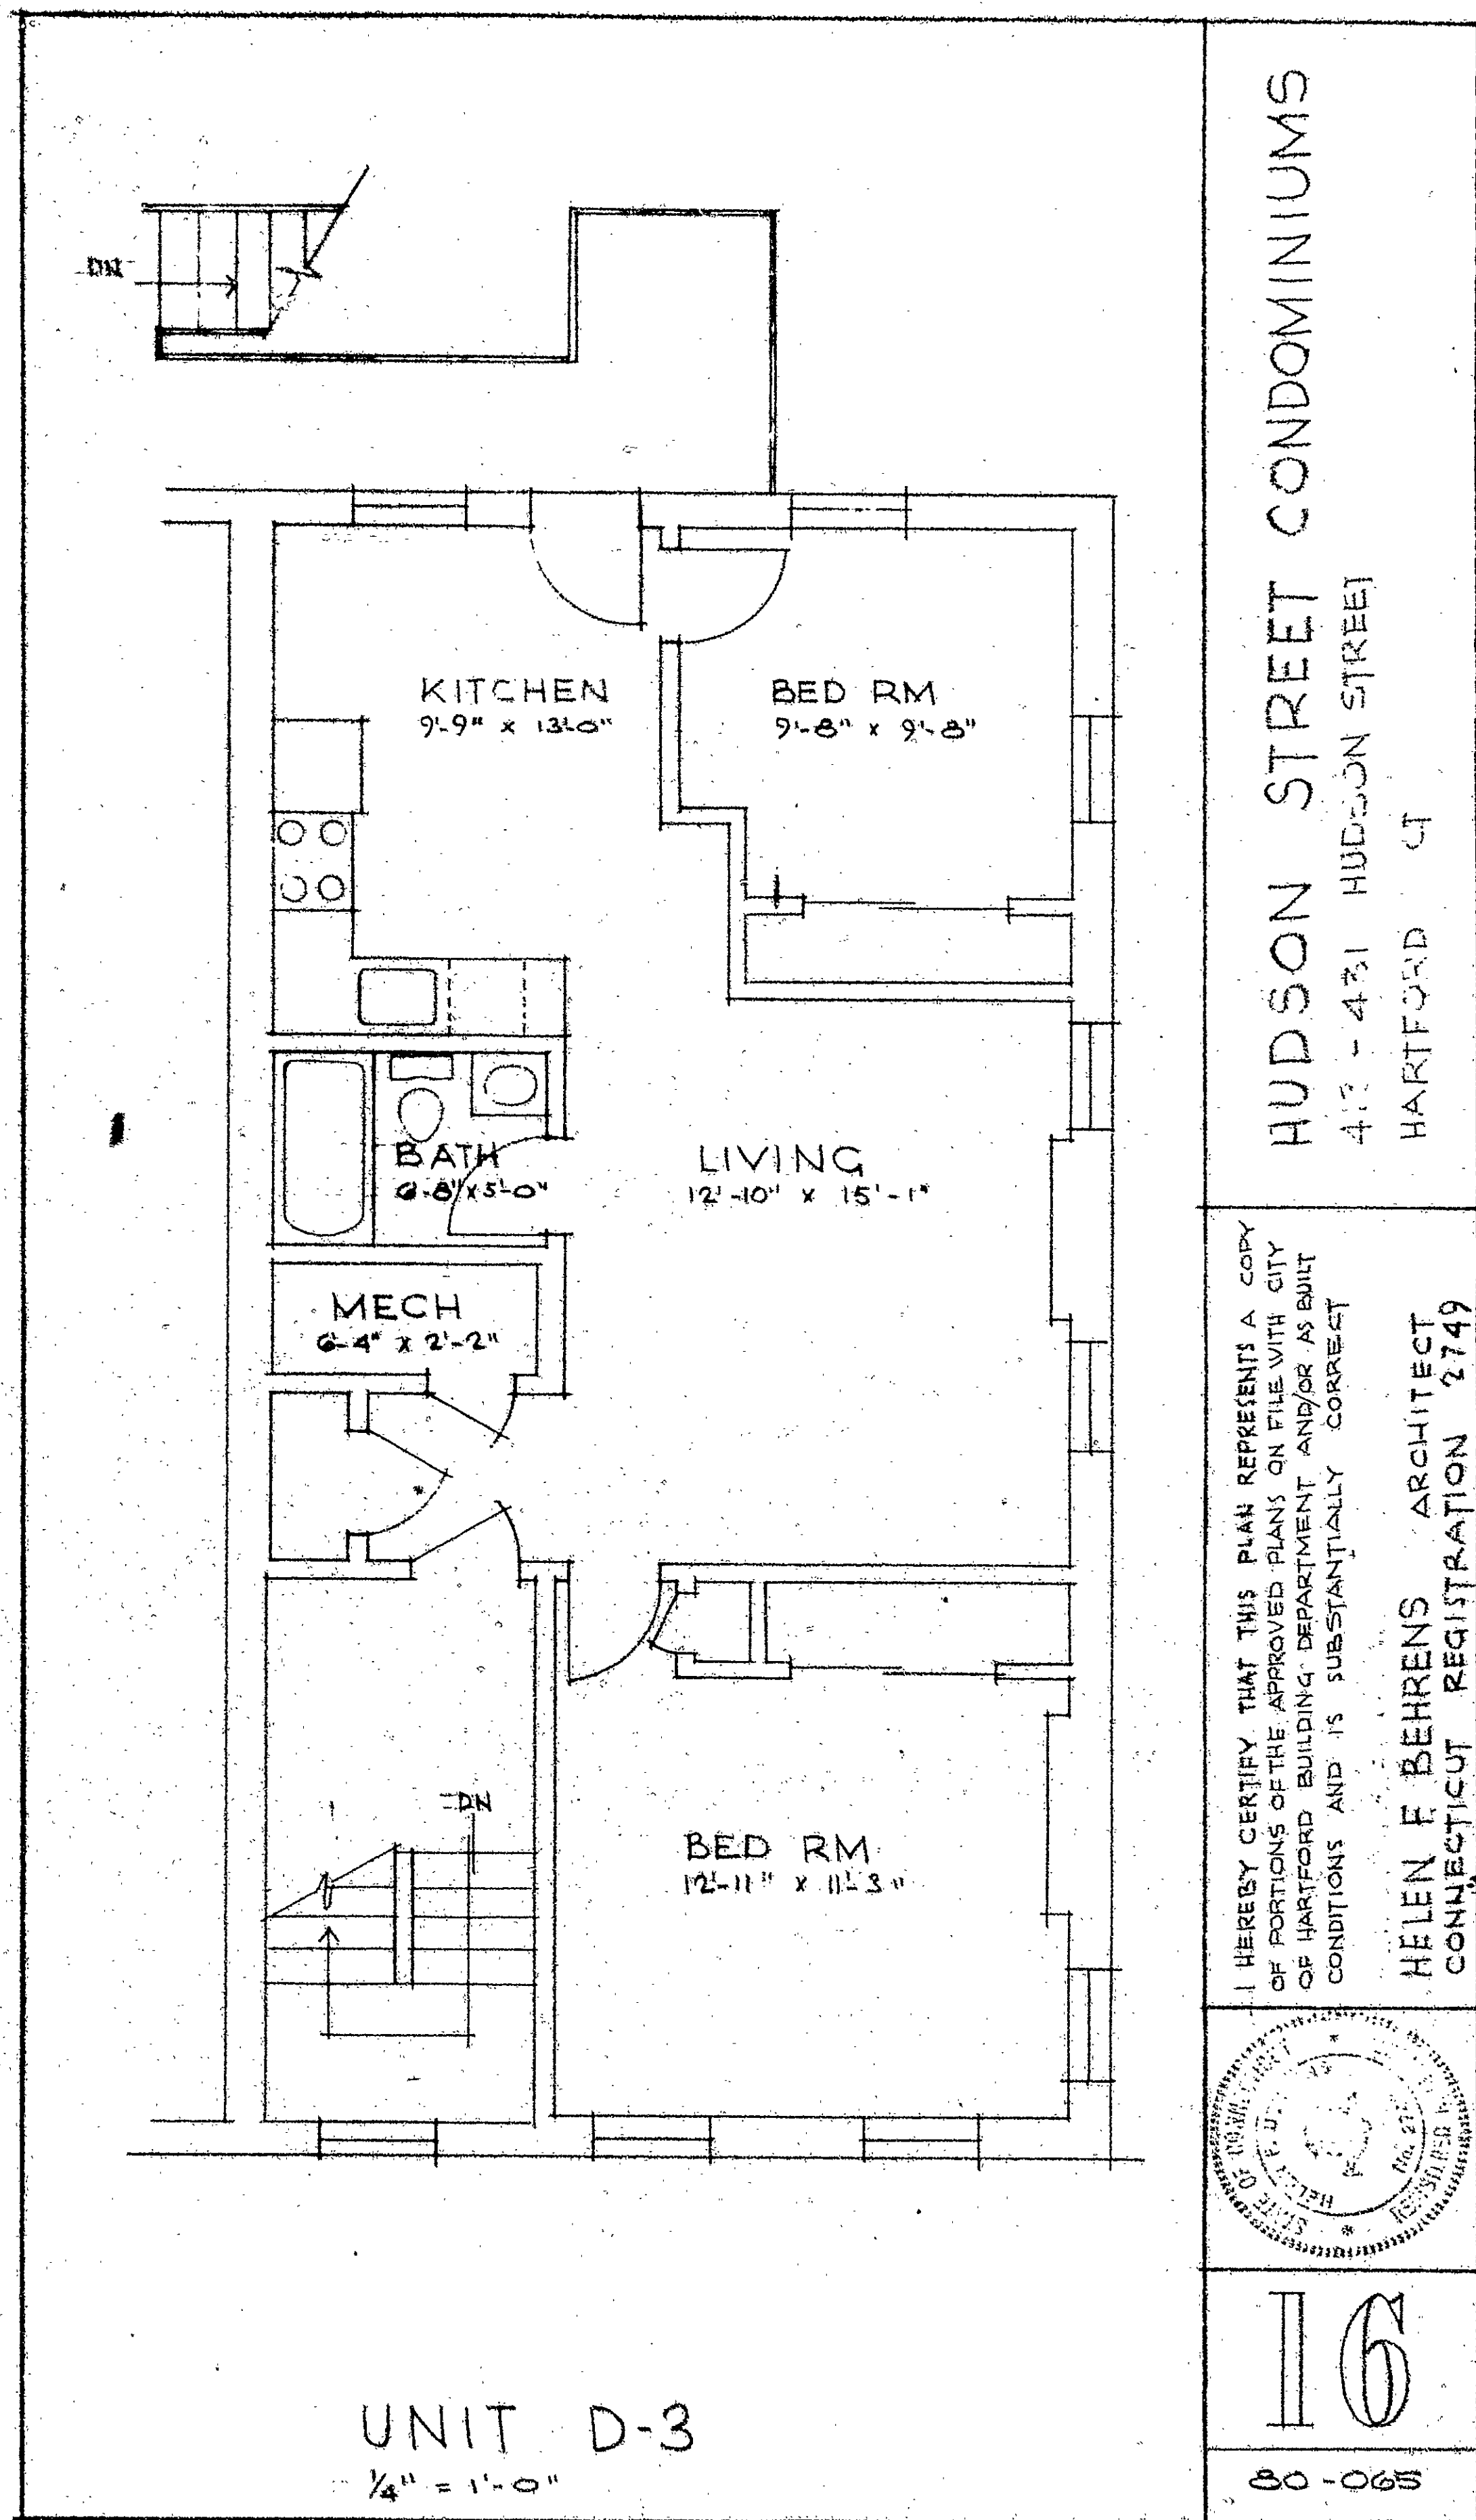


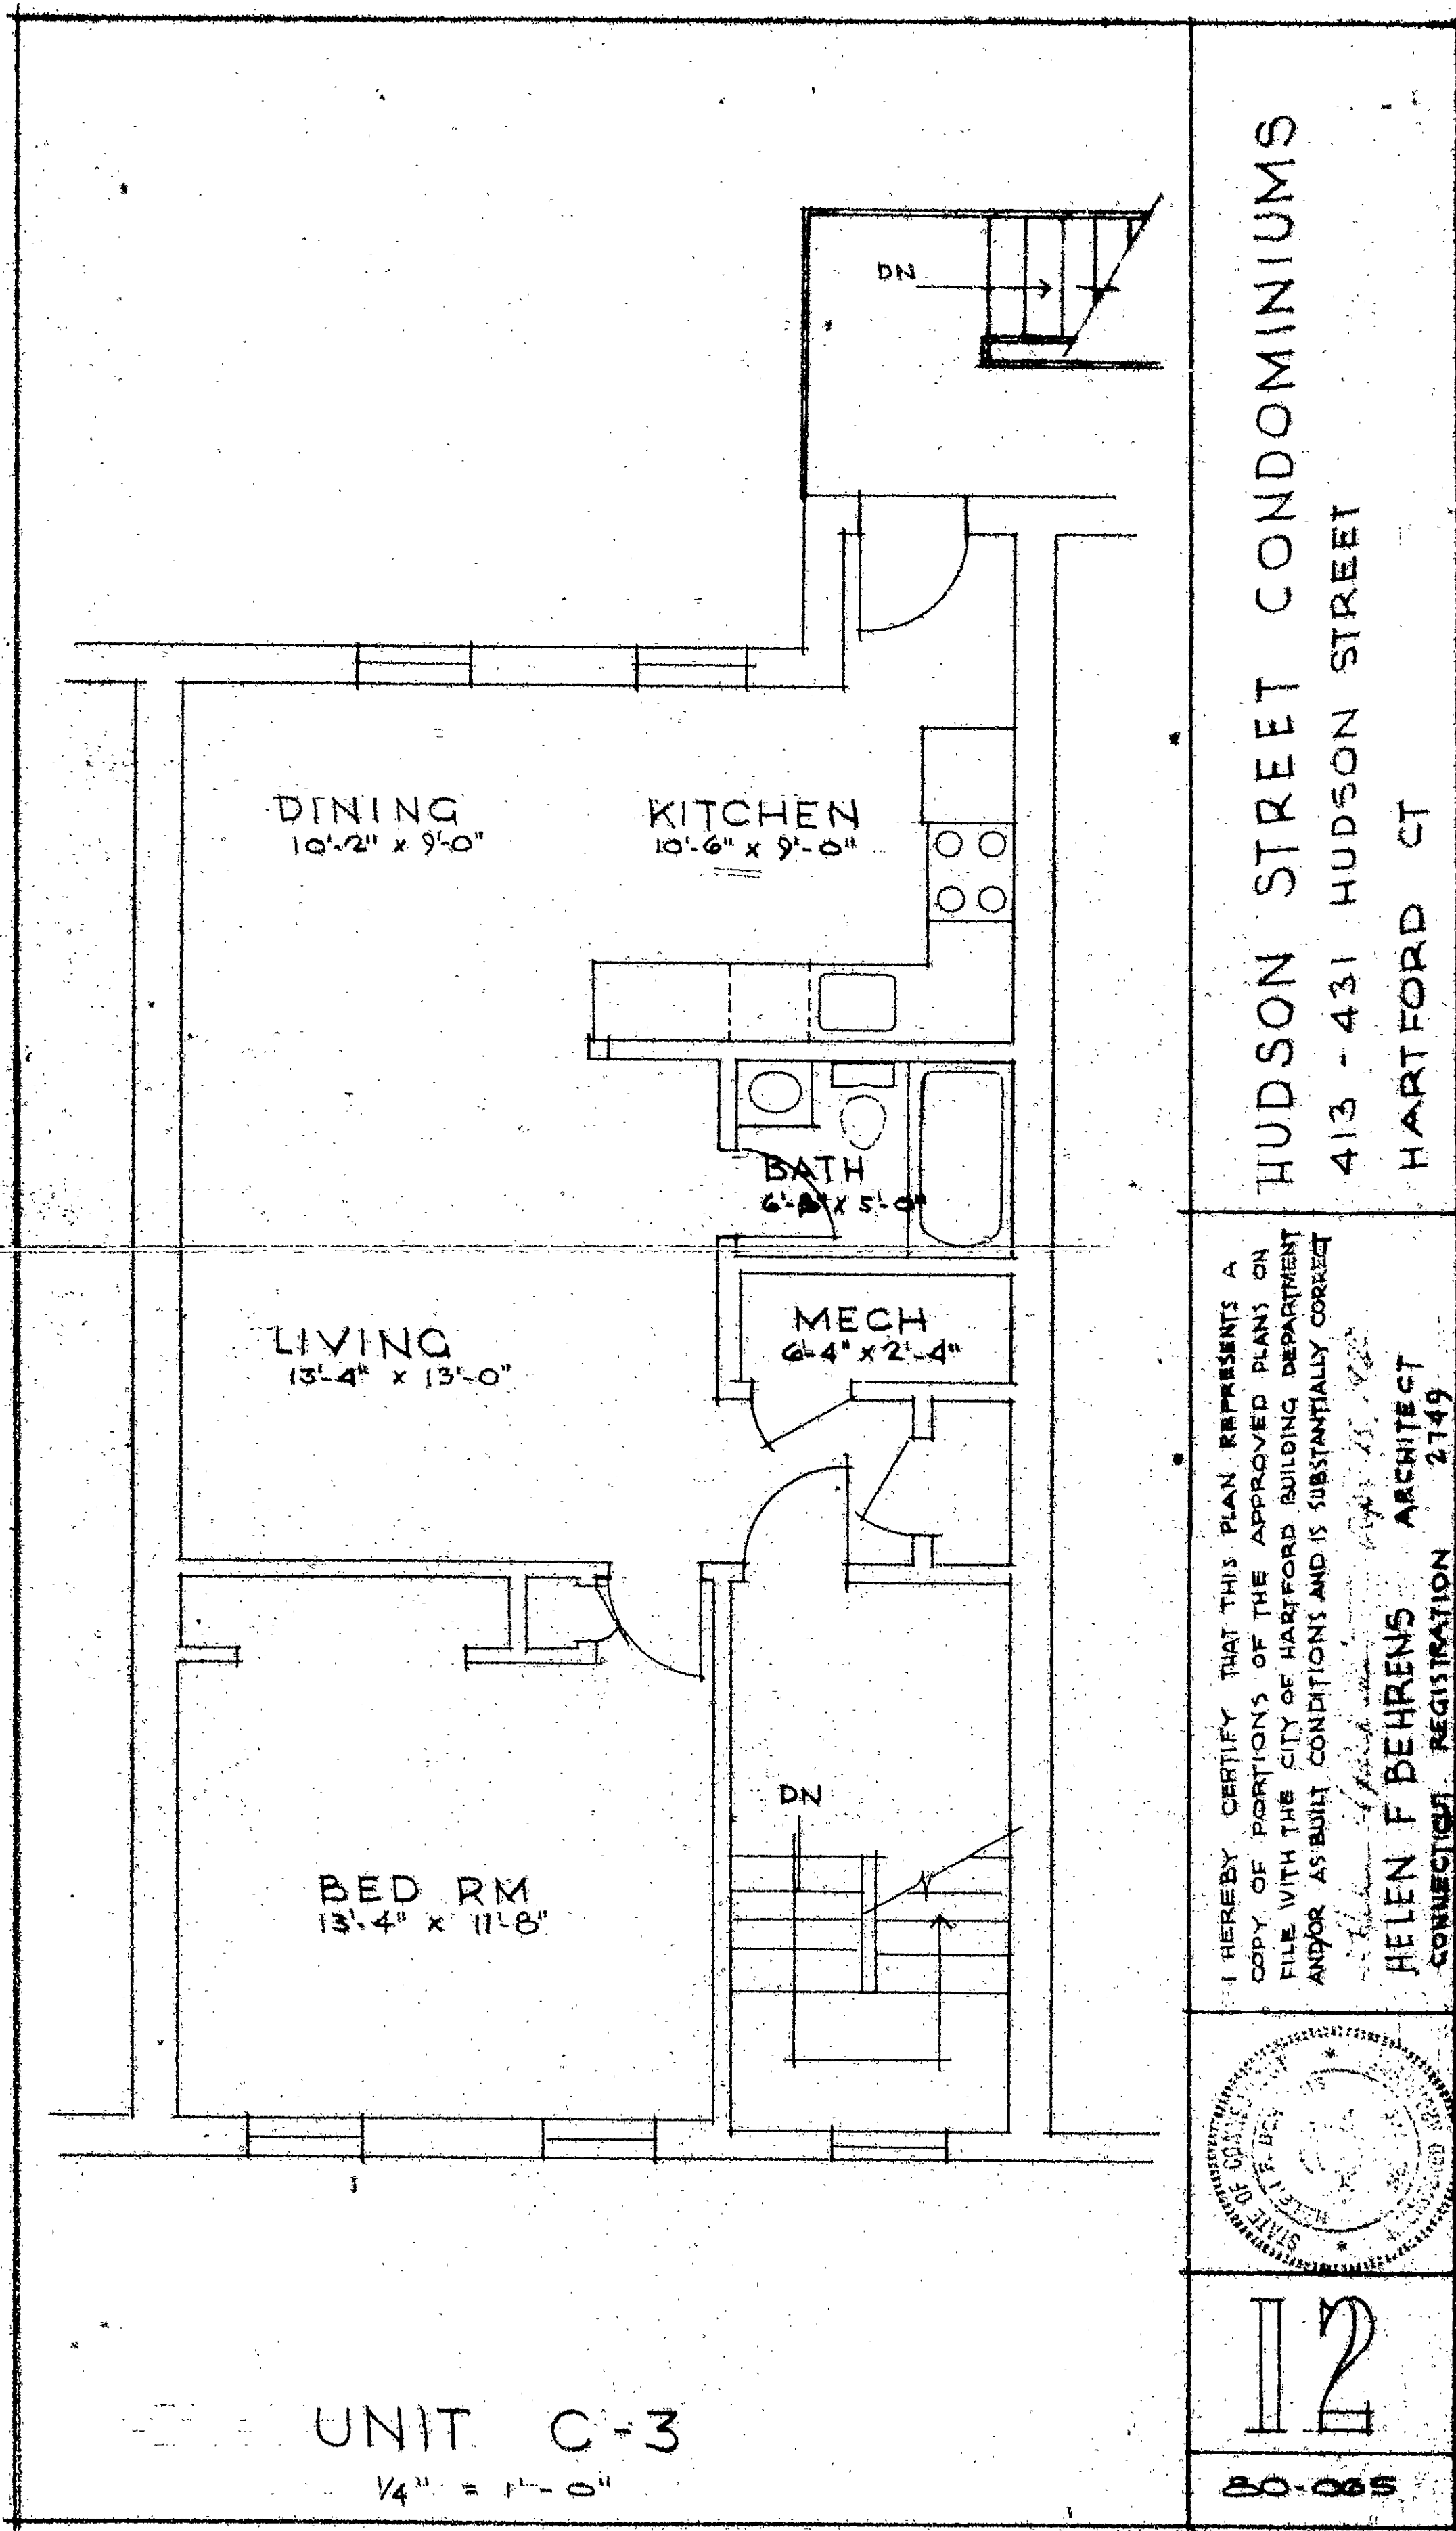

Condo Floor Plan #37