

SHEET TITLE _____


BUILDING NORTH-FIRST FLOOR

THE LINDEN, A CONDOMINIUM
2&10 CAPITOL AVE. & 1-7 LINDEN PLACE
HARTFORD, CT.


DATE _____
DECEMBER 15, 1980
SCALE _____

- PATTERNS WALL OR BALDING
- UNIT BOUNDARY
- LIMITED COMMON ELEMENTS
- CALLING OR FLOOD
- EVAPORATION


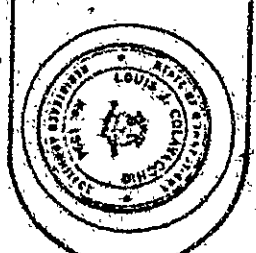


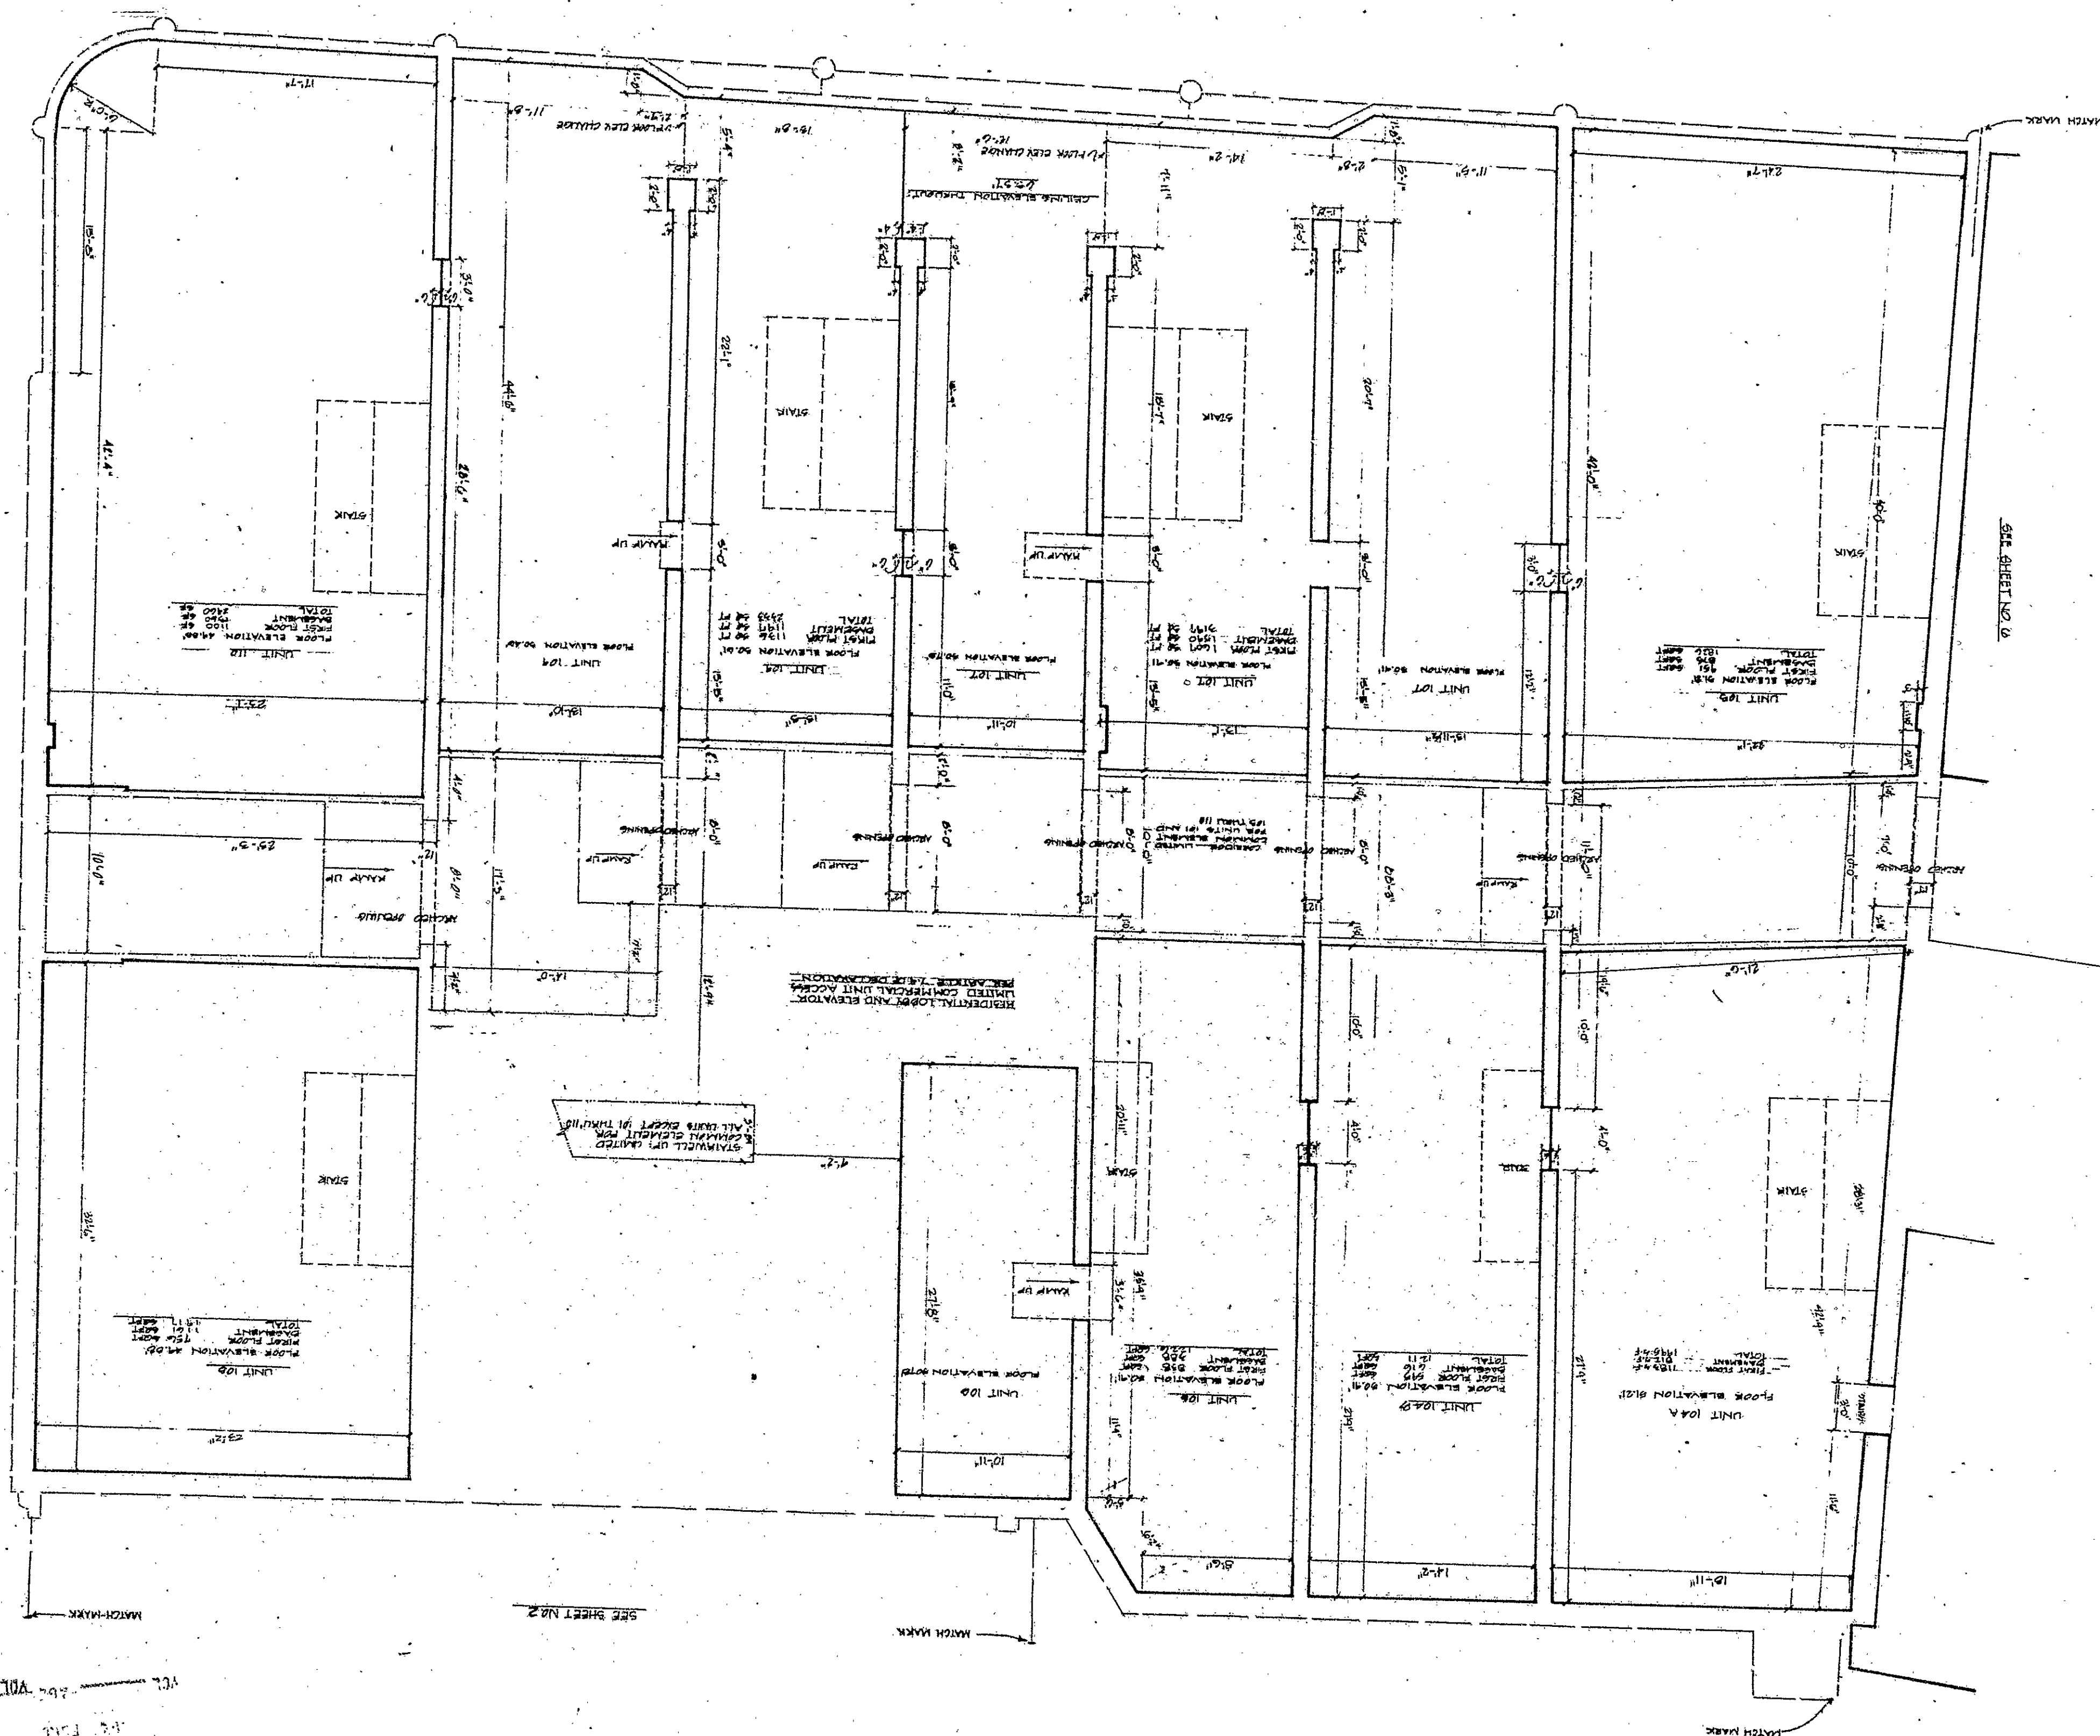[illegible]


RECEIVED BY
JAN 31 11 PM '81
TOWN & CITY CLERK
HARTFORD
PAGE 401

