


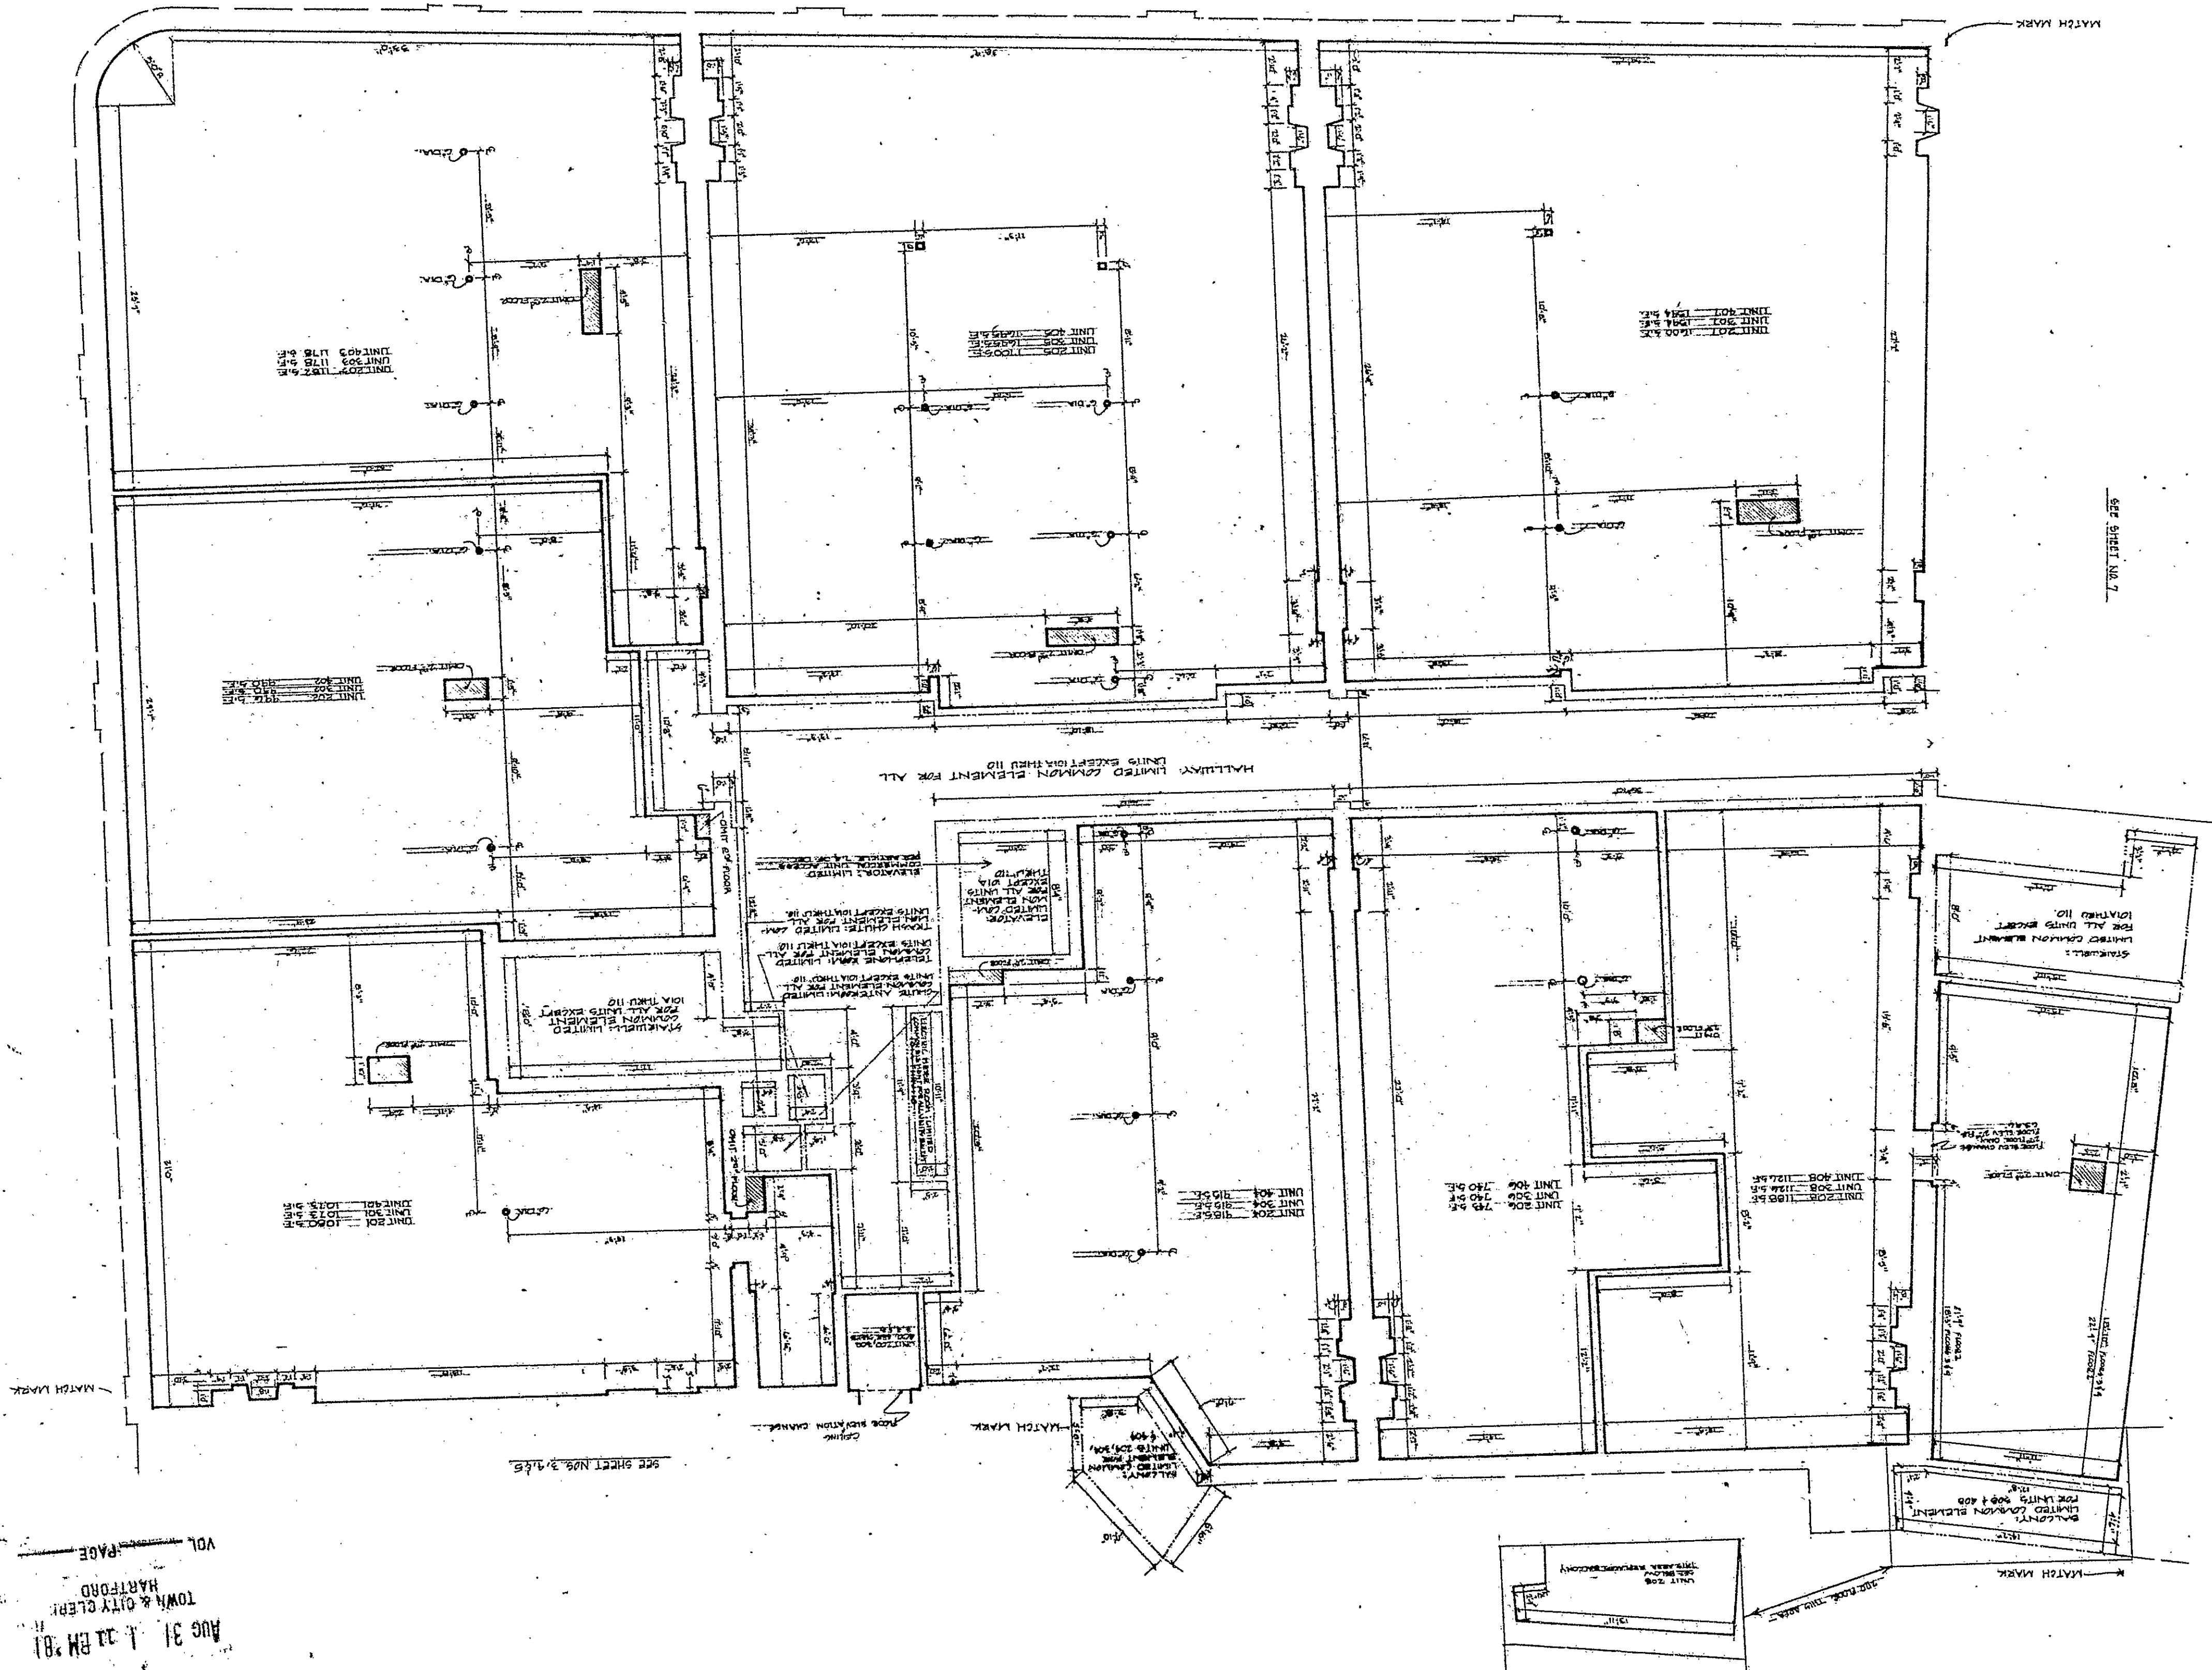





THE LINDEN, A CONDOMINIUM
2&10 CAPITOL AVE. & 1-7 LINDEN PLACE
HARTFORD, CT.


TOWN & CITY CLERK
AUG 31 1 22 PM '81

Consolidated Plans 7-1482