40-5

EASI FILE CORP. IRVINE CA

40

EFH 34

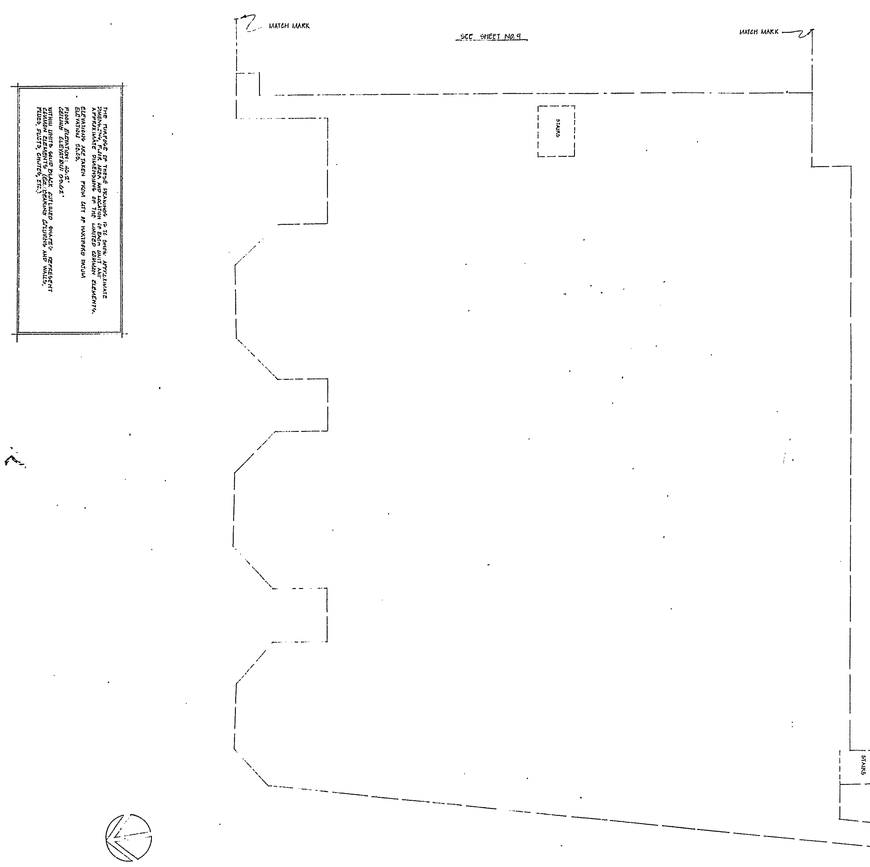

THE PURPOSE OF THESE DRAWINGS IS TO SHOW APPROXIMATE DIMENSIONS OF THE LIMITED COMMON ELEMENTS.

- DIMENSIONS ARE TAKEN FROM CUT OF UNFINISHED INCLUDE
- CEILING FLOOR
- CEILING FLOOR
- WITHIN WHICH MAY EXIST CUTLAWAY SHAFTS, OFFSETS, PIPES, DUCTS, CONDUITS, ETC.

RECEIVED BY
AUG 31 1 10 PM '8
TOWN & CITY CLERK
HARTFORD

VOL. ____ PAGE ____

SHEET 1

SHEET TITLE ....
TOWNHOUSES - B'SMT

THE LINDEN, A CONDOMINIUM

2&10 CAPITOL AVE. & 1-7 LINDEN PLACE
HARTFORD, CT.

DATE
DECEMBER 15, 1980
REVISED DATE AUG 31 1981

SCALE

EXTERIOR WALL OF BUILDING
UNIT BOUNDARY
LIMITED COMMON ELEMENT BOUNDARY
CEILING OR FLOOR ELEVATION CHANGE

I HEREBY CERTIFY THAT THESE PLANS ARE AN ACCURATE COPY OF THAT PORTION OF THE PLANS FILED WITH THE BUILDING OFFICIAL OF THE TOWN OF HARTFORD PURSUANT TO "SECTION 47-79 OF THE CONNECTICUT GENERAL STATUTES REVISION 1958, AS AMENDED."

[illegible] ARCHITECT
[illegible] BROOKS INC. LOUIS J. CORAVECCHIO (LAA) ARCHITECT, SIGNING OF THE FOREGOING DRAWINGS AND SAID SEAL HAVING BEEN AFFIXED HERETO AND THAT THE PROPERTY TO WHICH SITE PLANS IN DUPLICATE ARE IN TOWN OF HARTFORD, STATE OF CONNECTICUT, WHICH IS DESCRIBED AS FOLLOWS: [illegible]
NOTARY PUBLIC Margaret H. Silber MY COMMISSION EXPIRES 3/31/87

40