


RECEIVED
CITY OF HARTFORD
JAN 13 1986
SSC

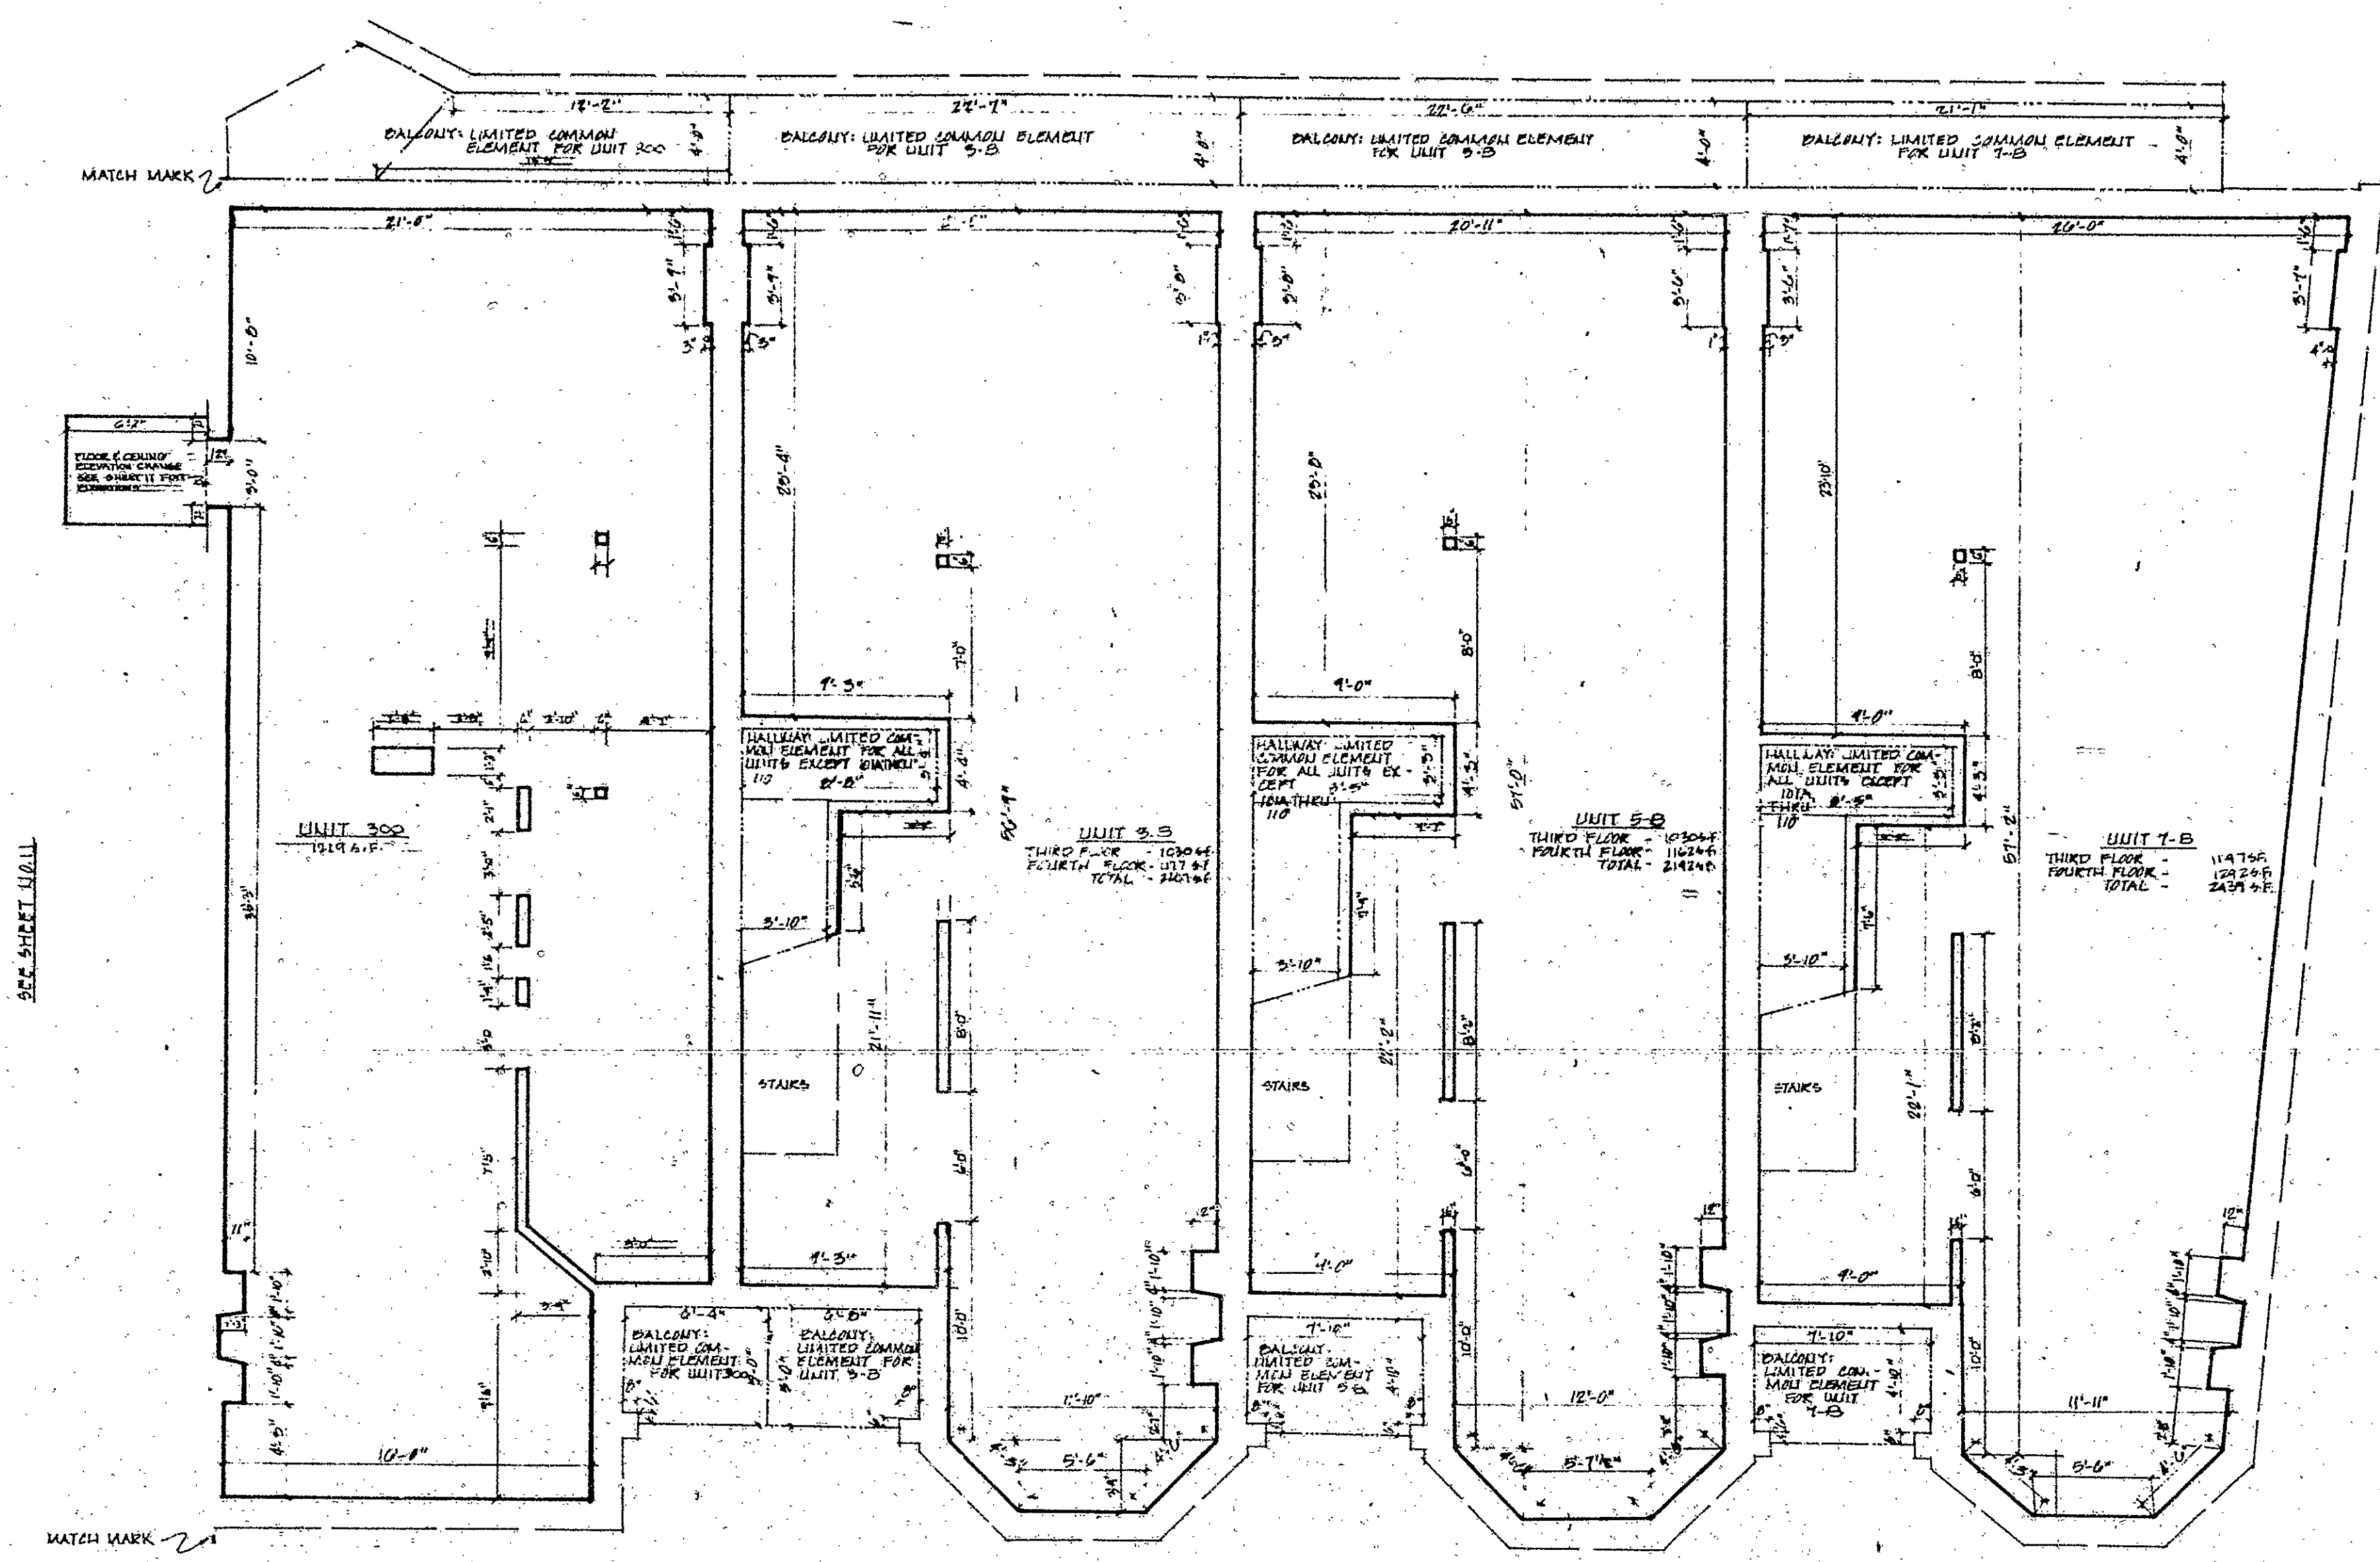

THE PURPOSE OF THESE DRAWINGS IS TO SHOW APPROXIMATE
DIMENSIONS FROM A LOCATION OF EACH UNIT AND THE
ELEVATIONS.
FLOOR ELEVATION: 10.41'
CEILING ELEVATION: 10.10'
ELEVATIONS ARE TAKEN FROM CITY OF HARTFORD DATA.

THE LINDEN, A CONDOMINIUM
2&10 CAPITOL AVE. & 1-7 LINDEN PLACE
HARTFORD, CT.

DATE: DECEMBER 15, 1980
SCALE: 1/4" = 1'-0"

SHEET TITLE: TOWNHOUSES - THIRD FLOOR

4

CONDOMINIUM DEVELOPER: [Signature]
ARCHITECT: [Signature]
ENGINEER: [Signature]
DATE: 12/15/80

Condo Plan # 40