


DATE: 12/18/83
 DRAWN BY: [Signature]
 CHECKED BY: [Signature]
 PROJECT: 2810 CAPITOL AVE. 1-7 LINDEN PL.

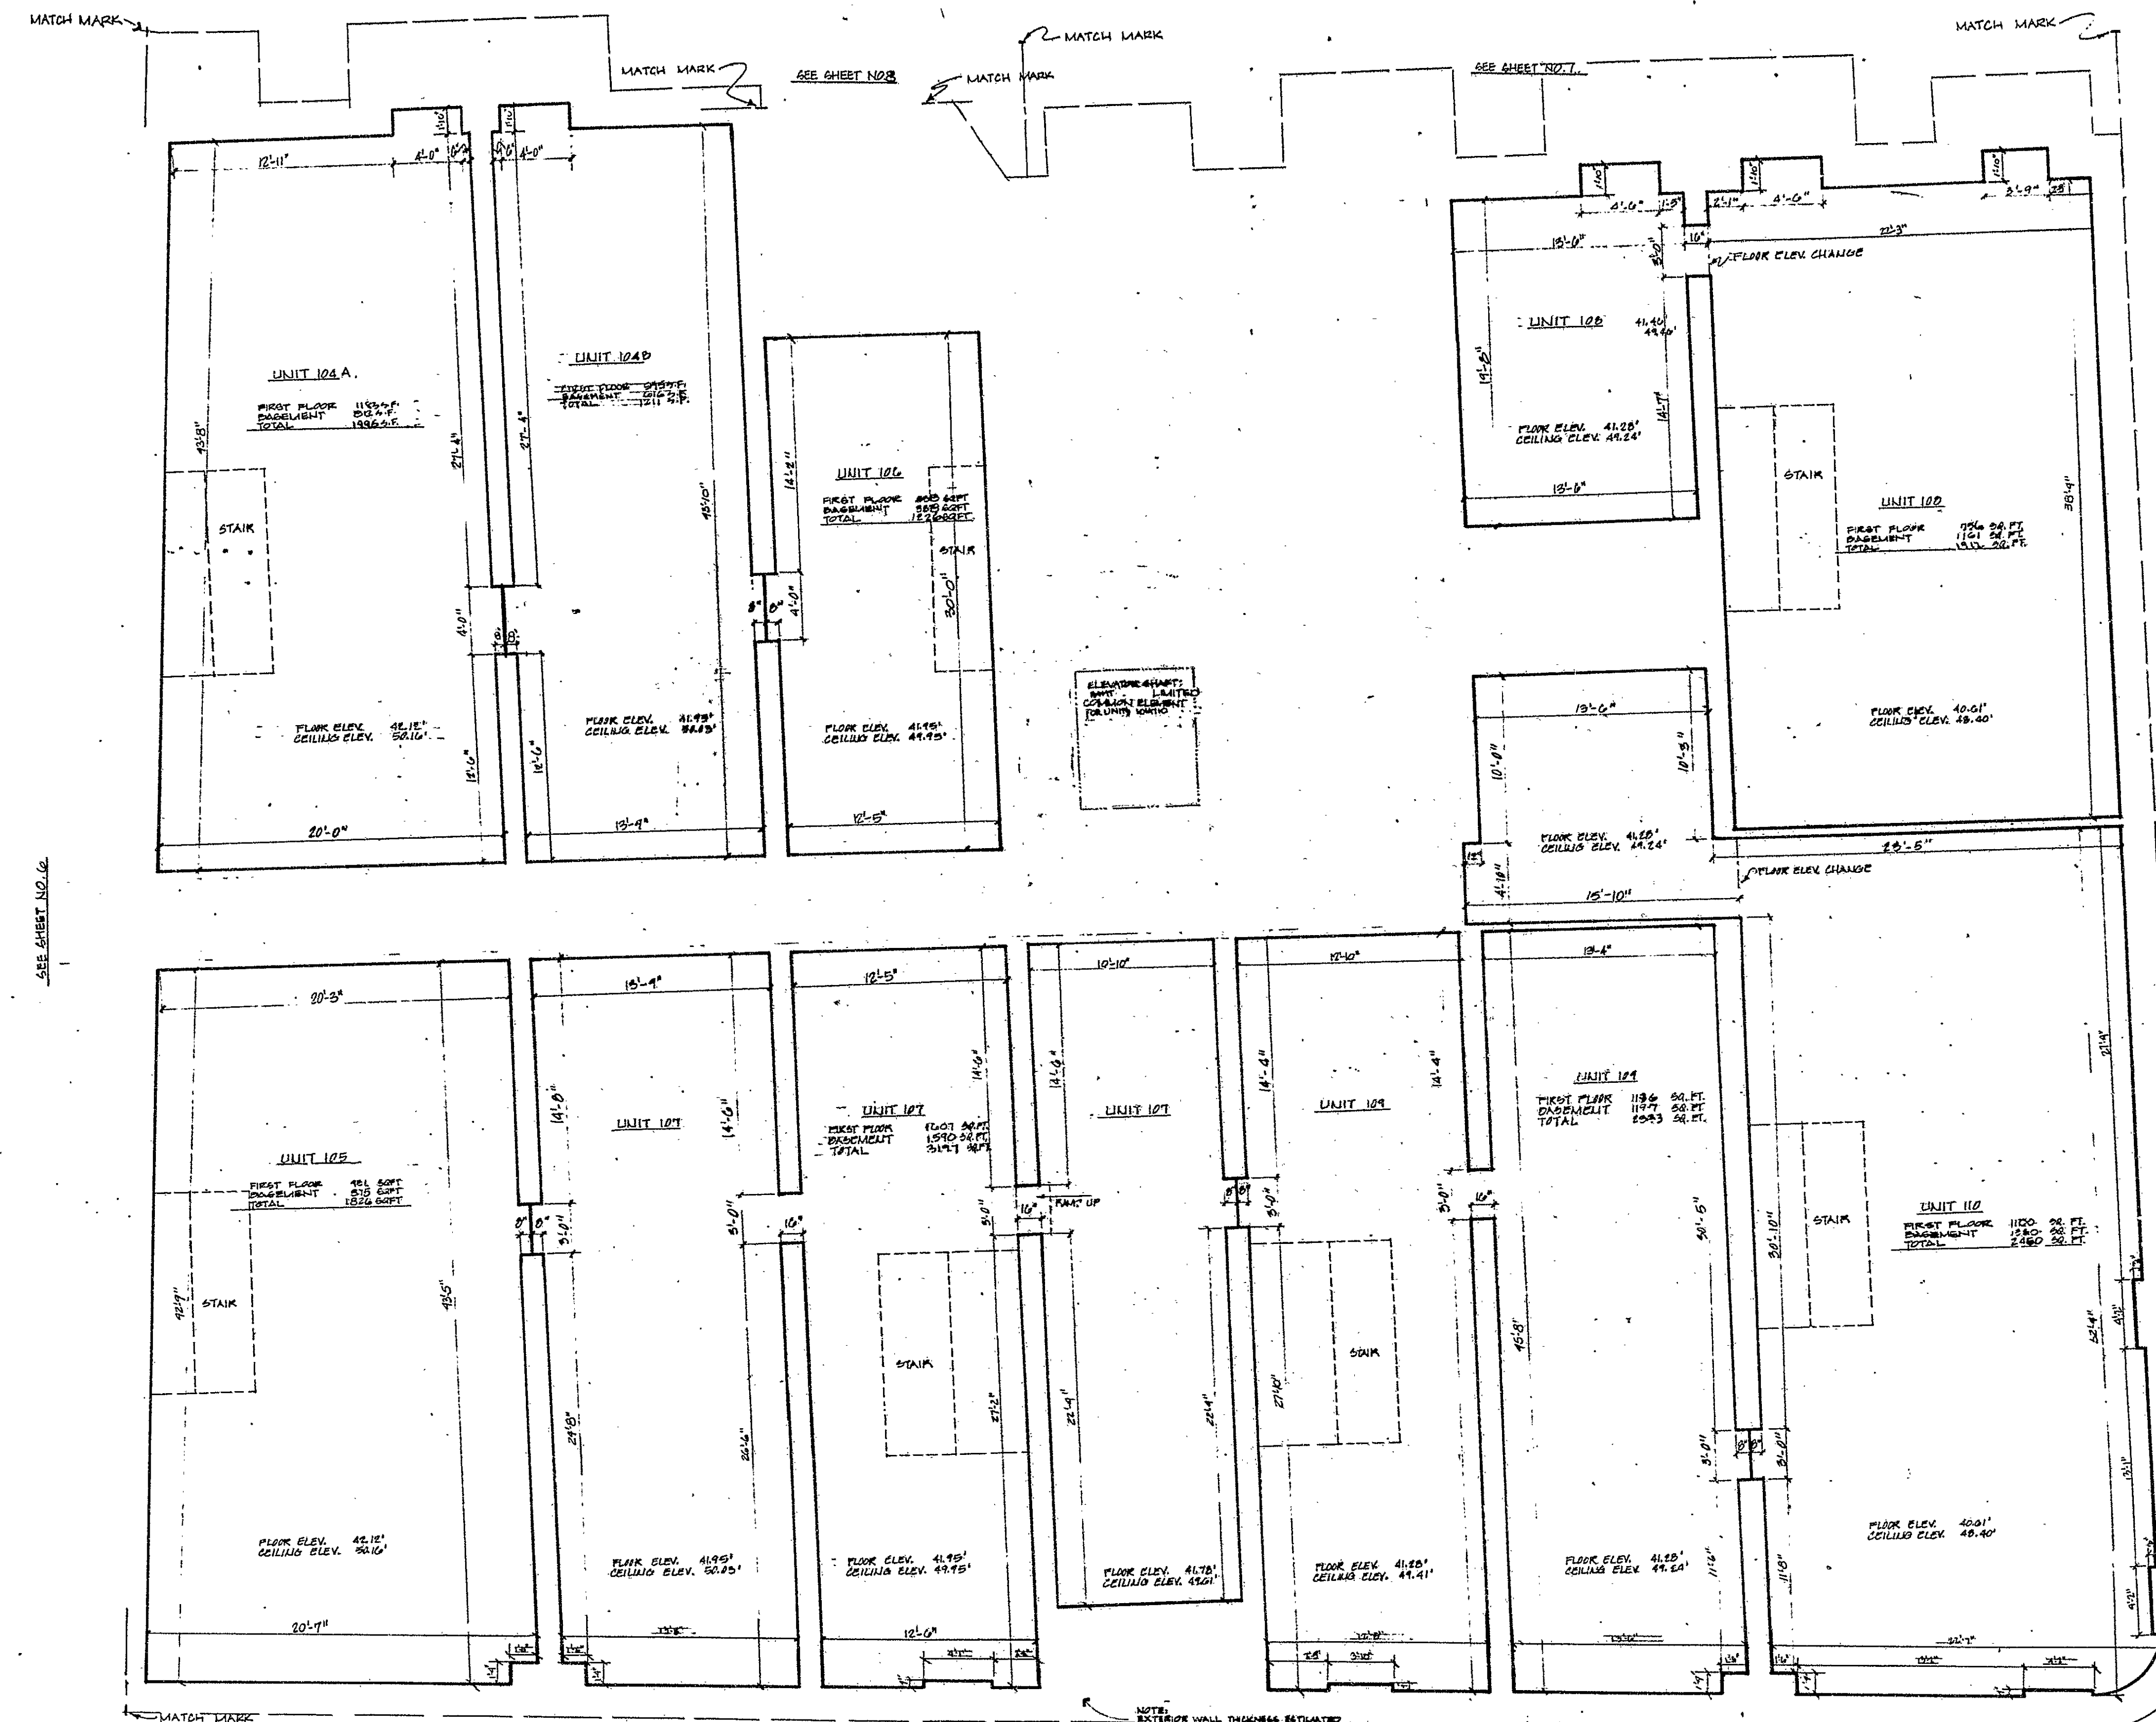

THE PURPOSE OF THESE DRAWINGS IS TO SHOW APPROXIMATE DIMENSIONS, FLOOR AREA, LOCATION OF WALL, UNIT, AND LOCATION AND APPROXIMATE DIMENSIONS OF THE LIMITED COMMON ELEMENTS.

ELEVATIONS ARE TAKEN FROM CITY OF HARTFORD DATUM.

WITHIN UNITS, SOLID BLACK OUTLINED CHARACTERS REPRESENT COMMON ELEMENTS (E.G. BATHING, CLOSET, HALL, PLUMB, CASE, CHUTE, ETC.).

DATE: 12/18/83
 SCALE: 1/8" = 1'-0"

THE LINDEN, A CONDOMINIUM
 2810 CAPITOL AVE. & 1-7 LINDEN PL.
 HARTFORD, CT.


SHEET: 9

04

Condo Plan # 40