
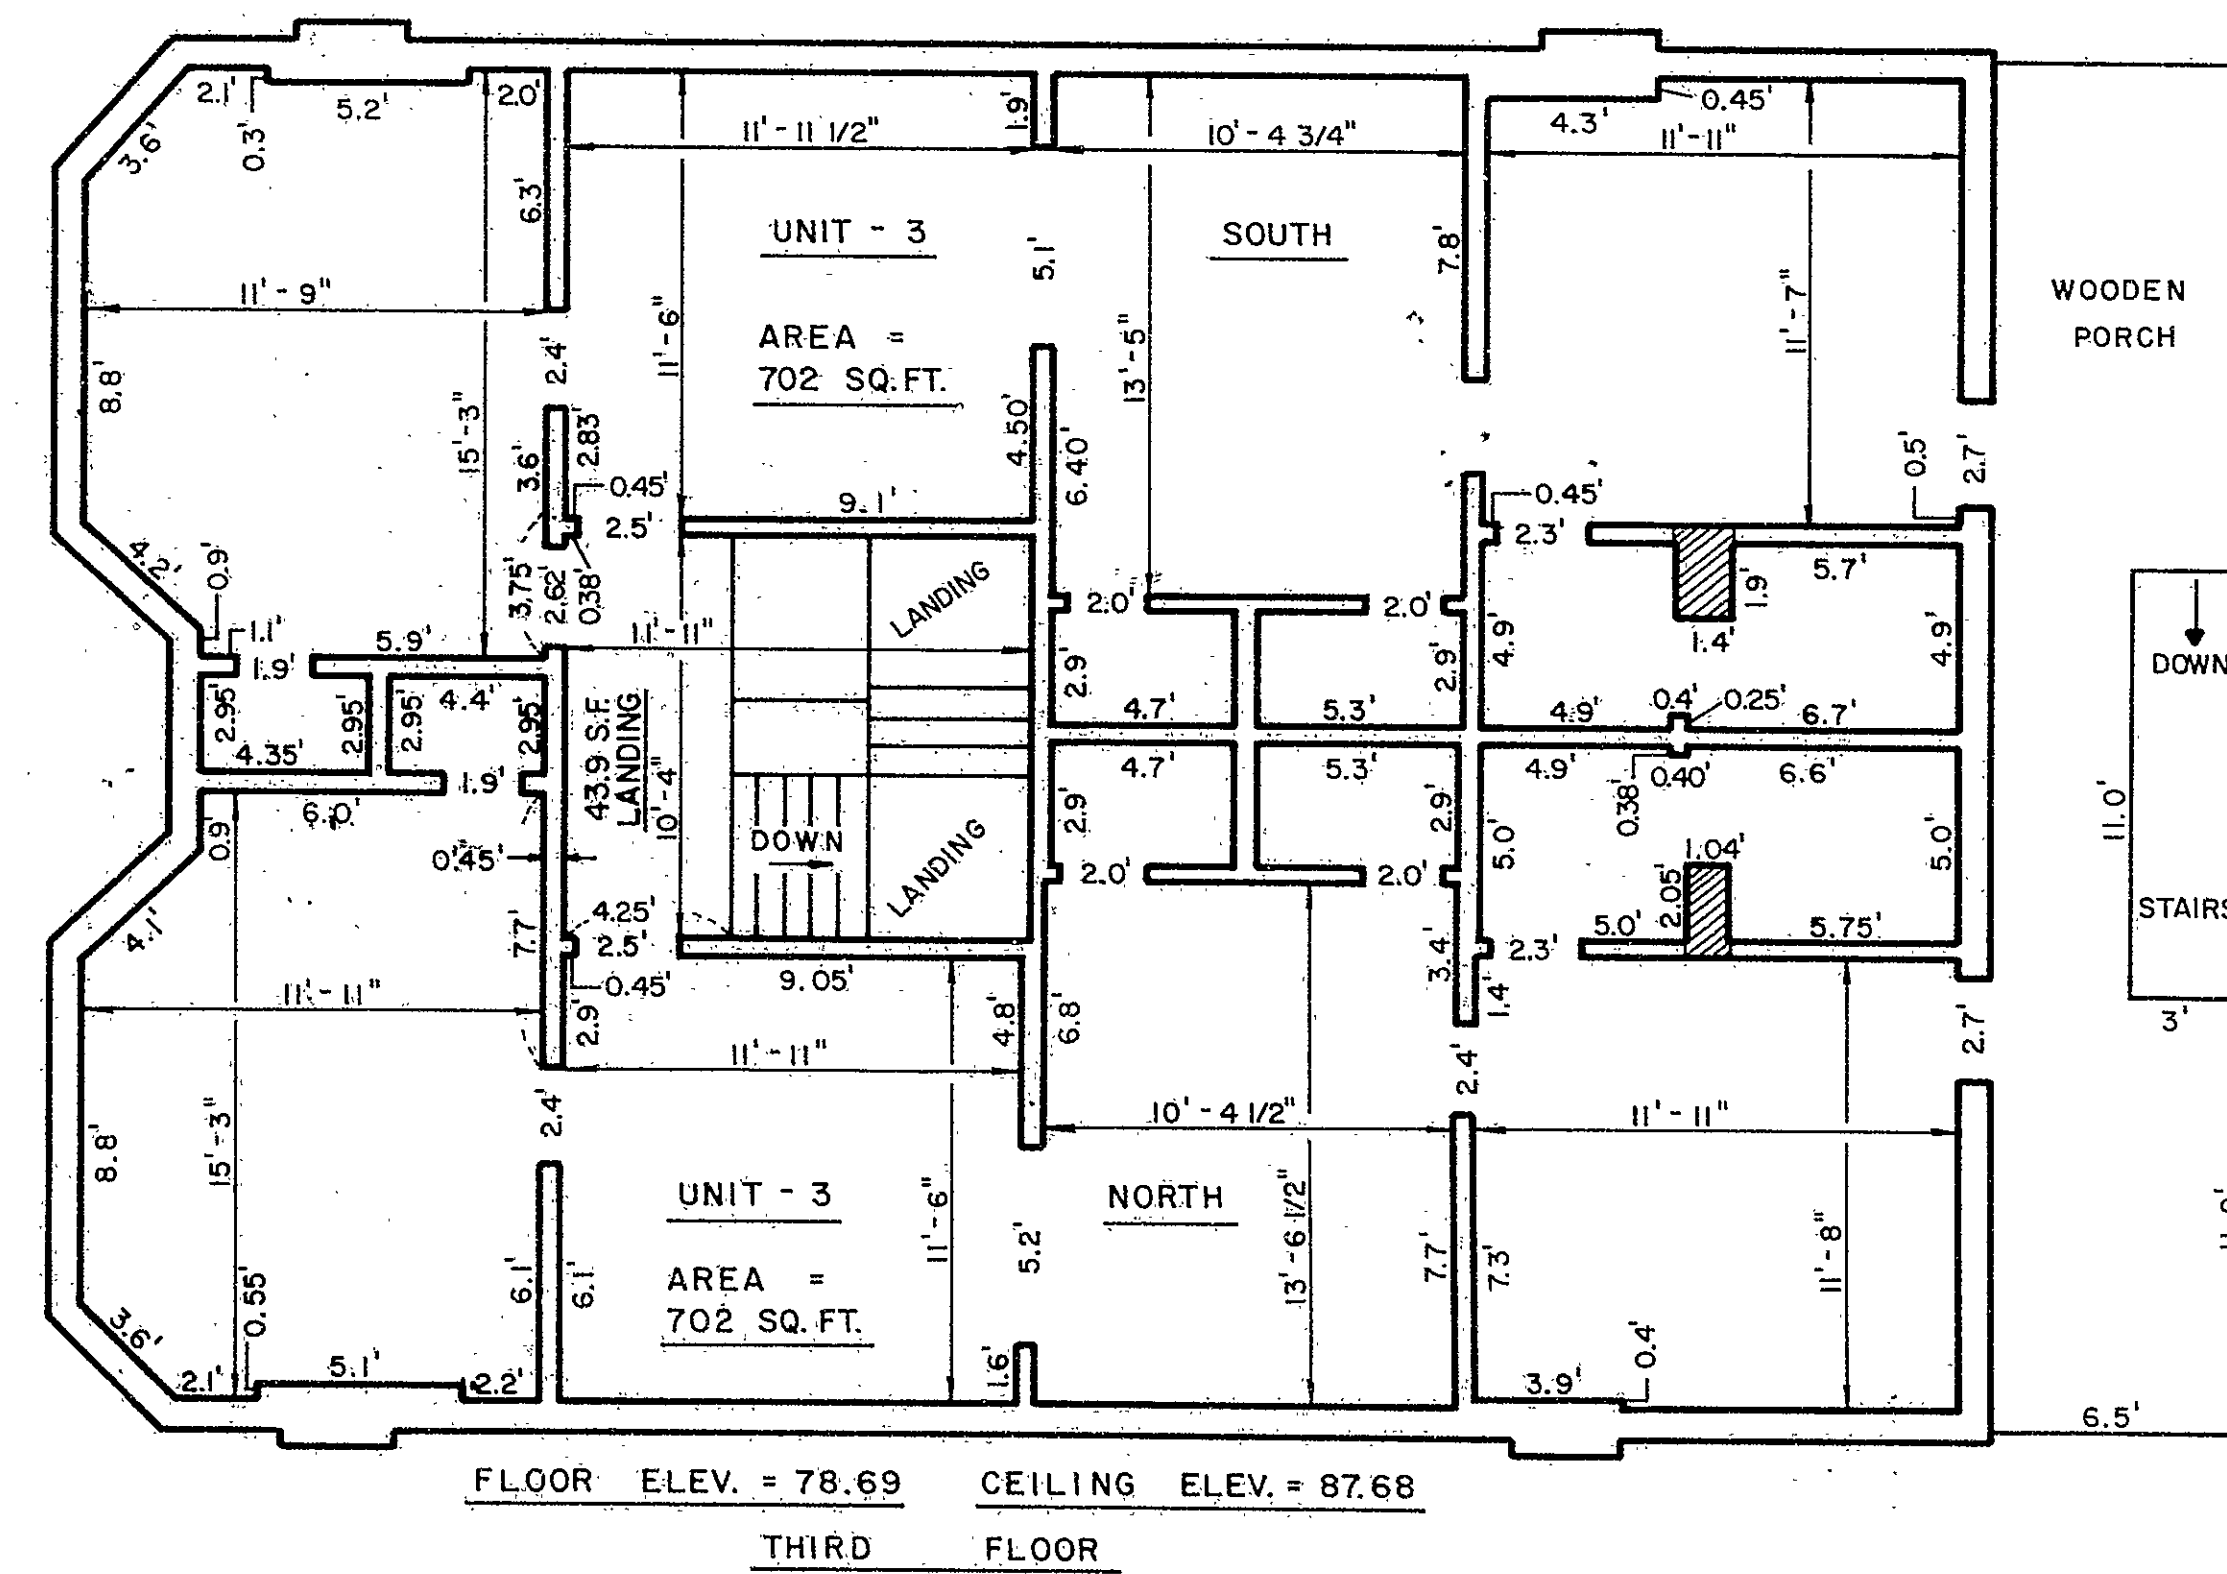
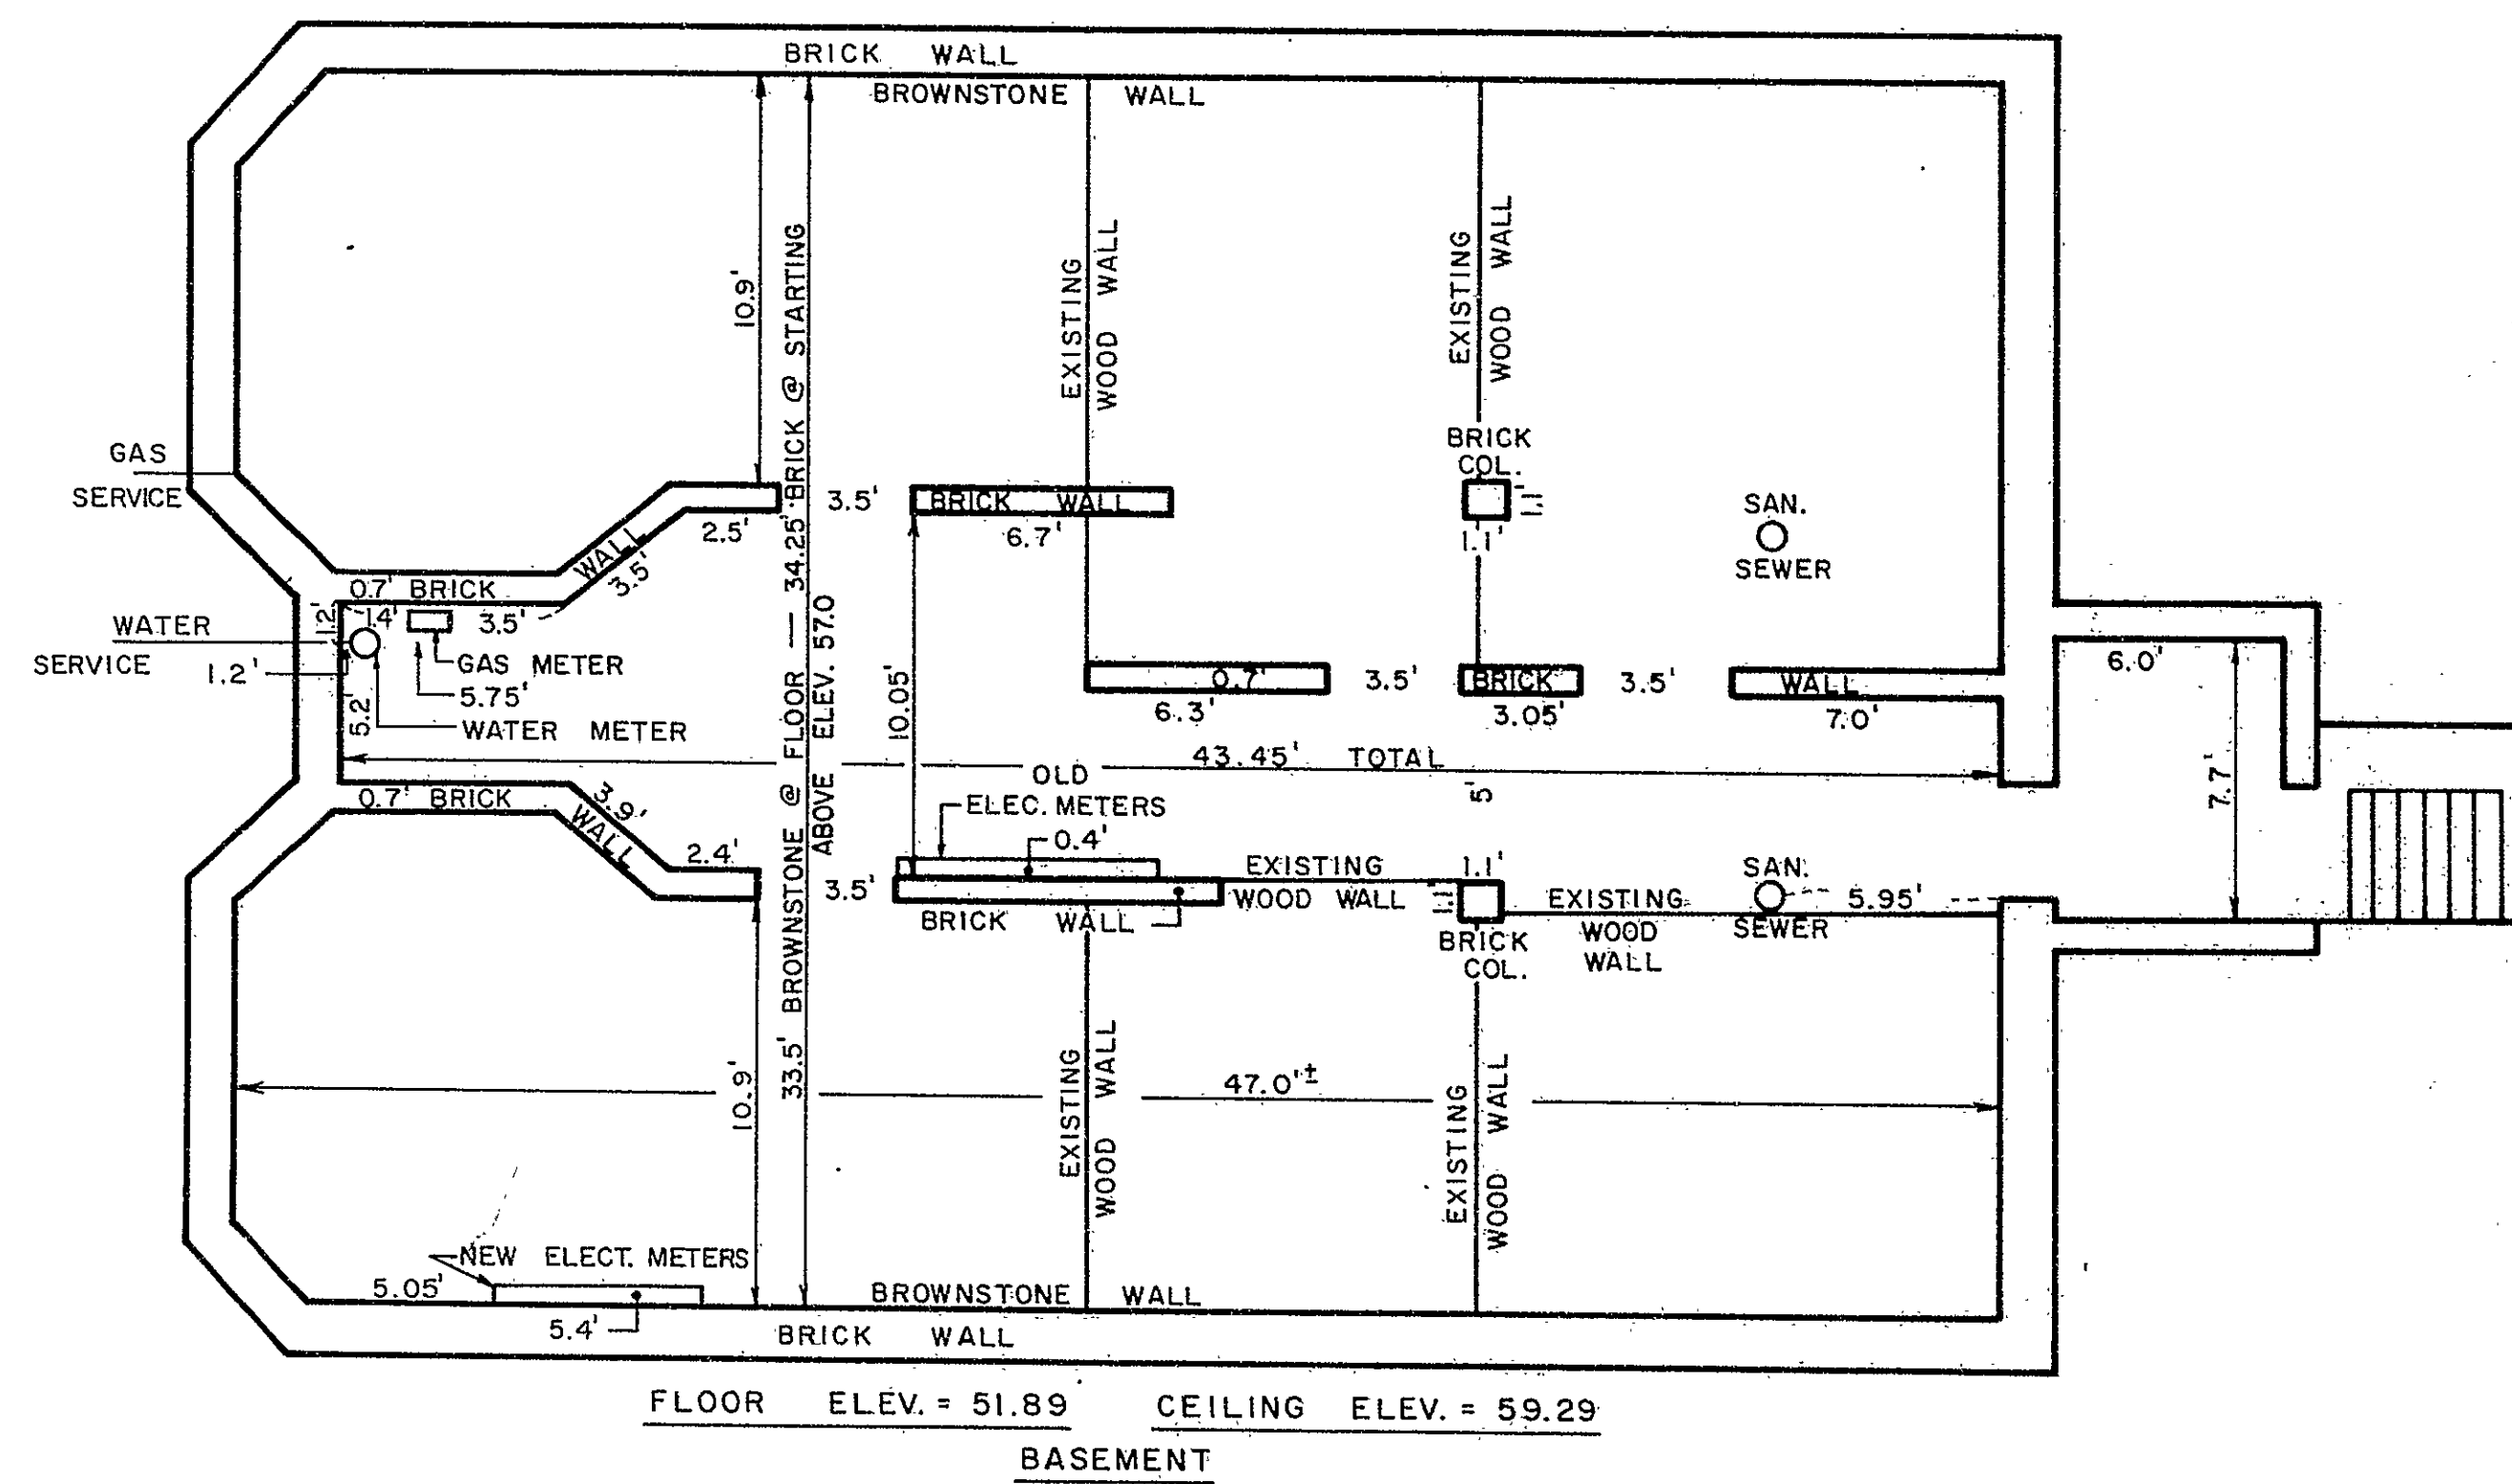
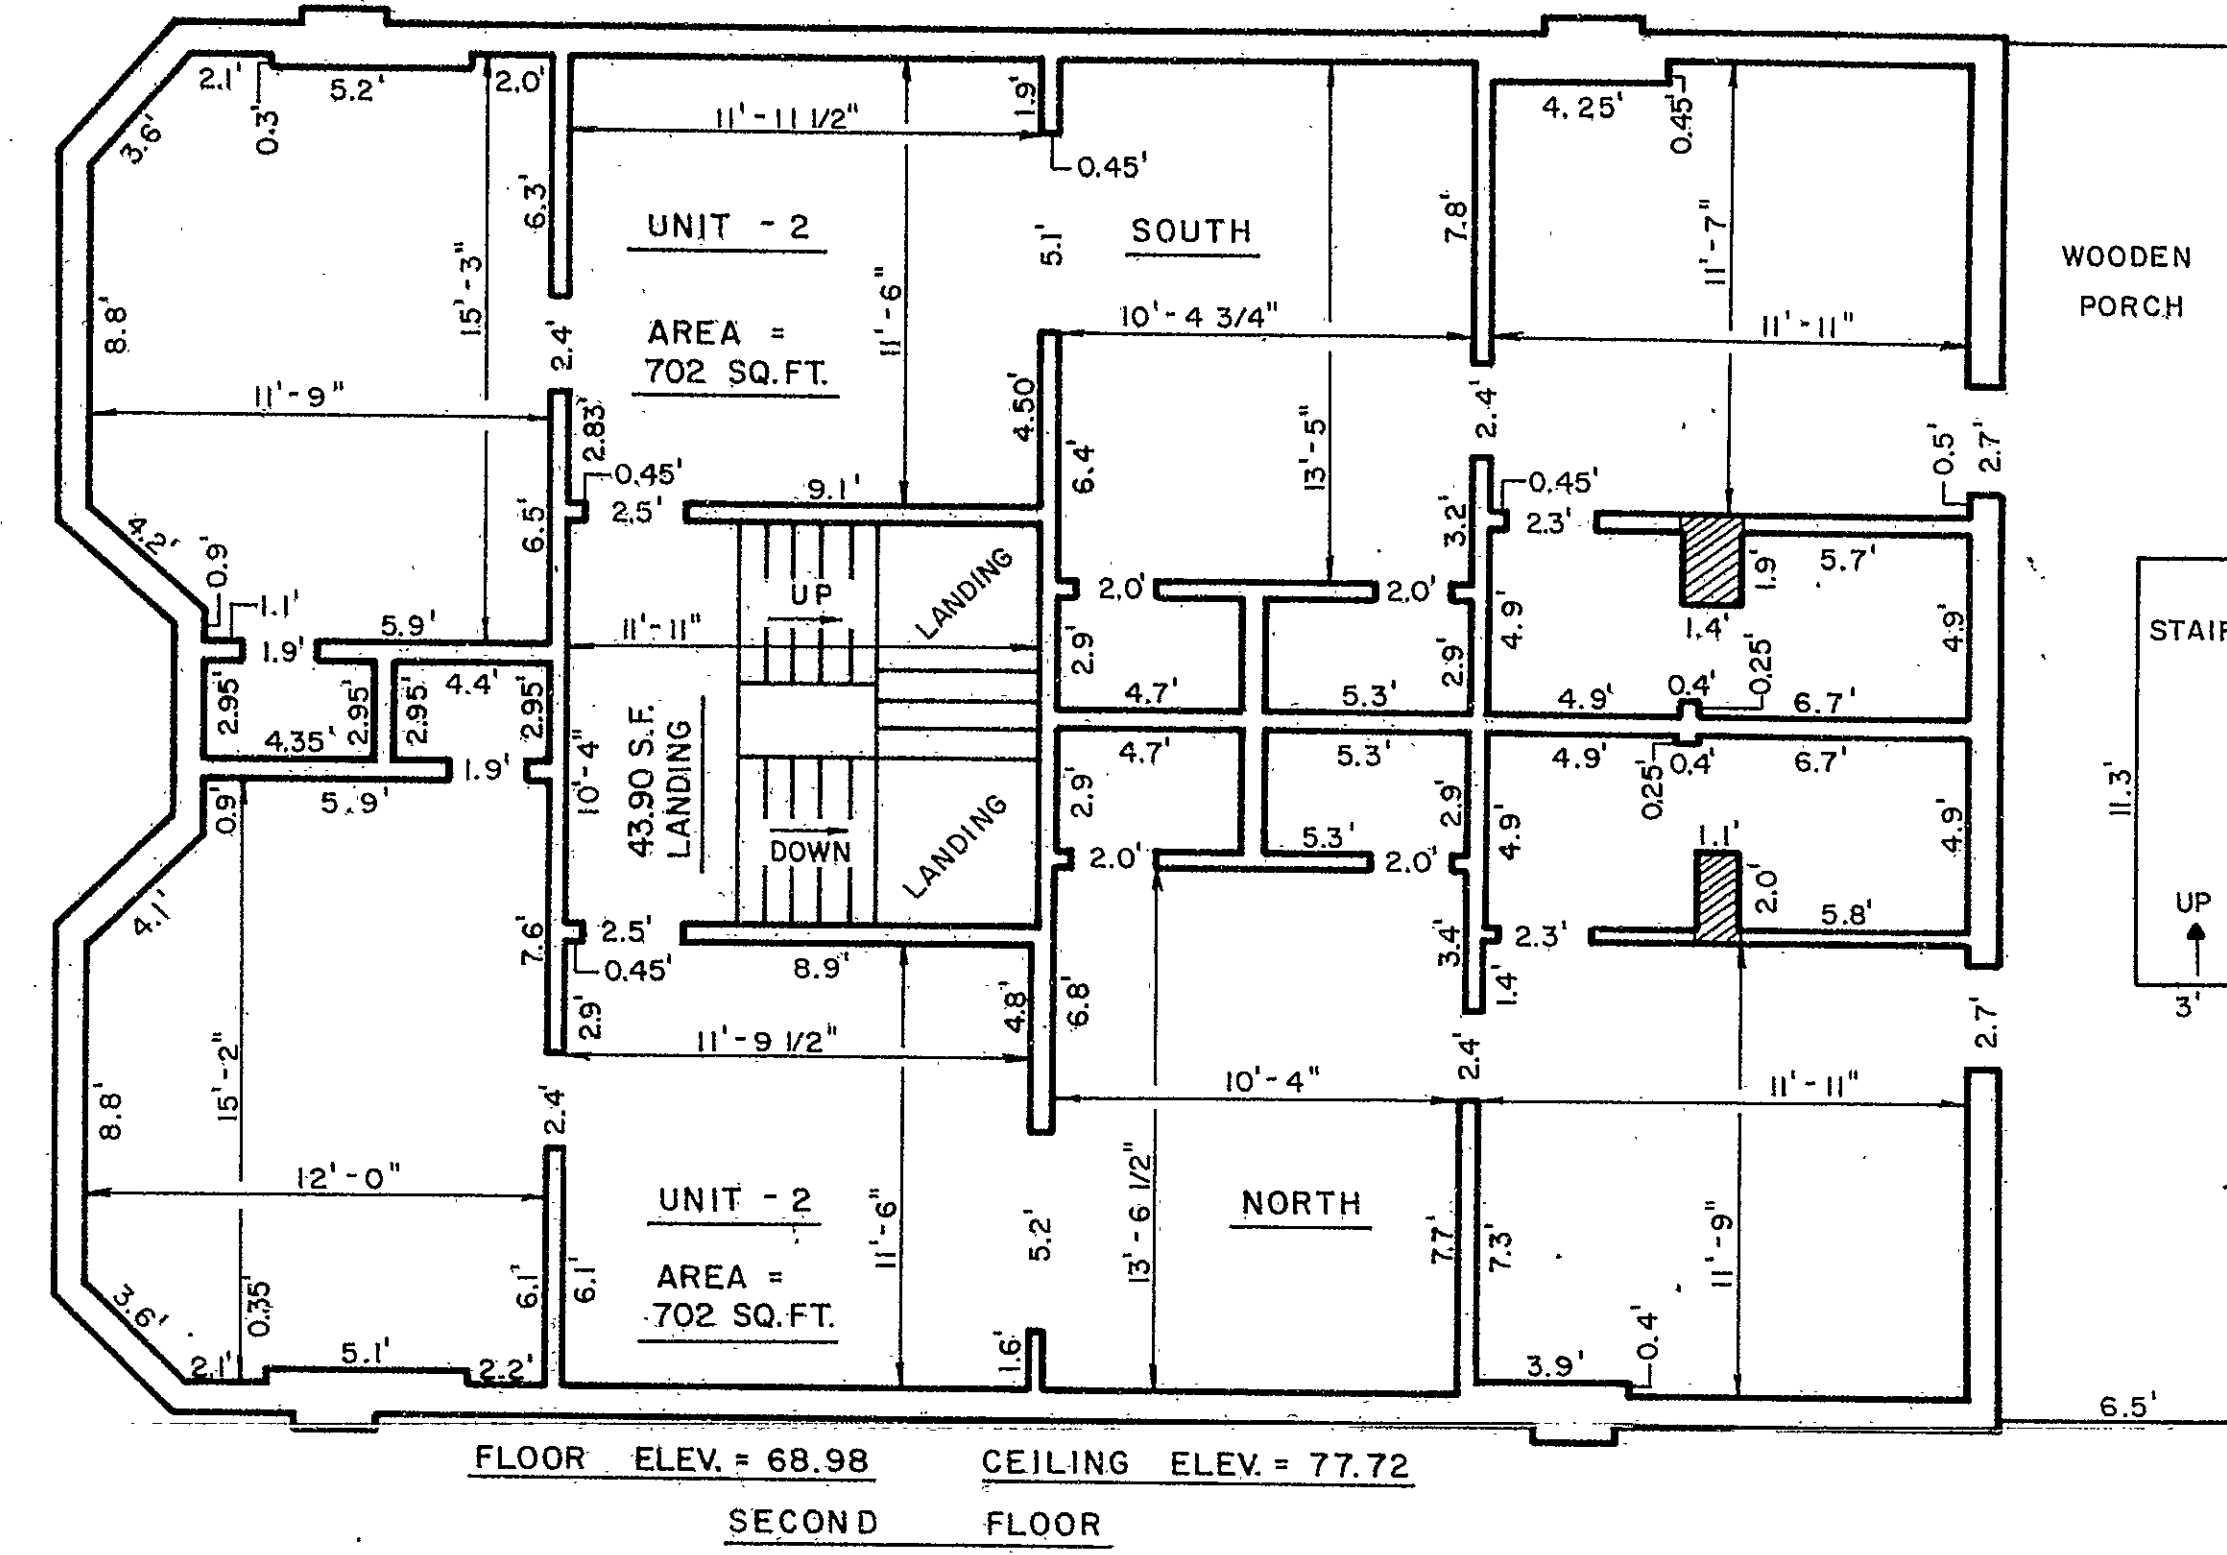


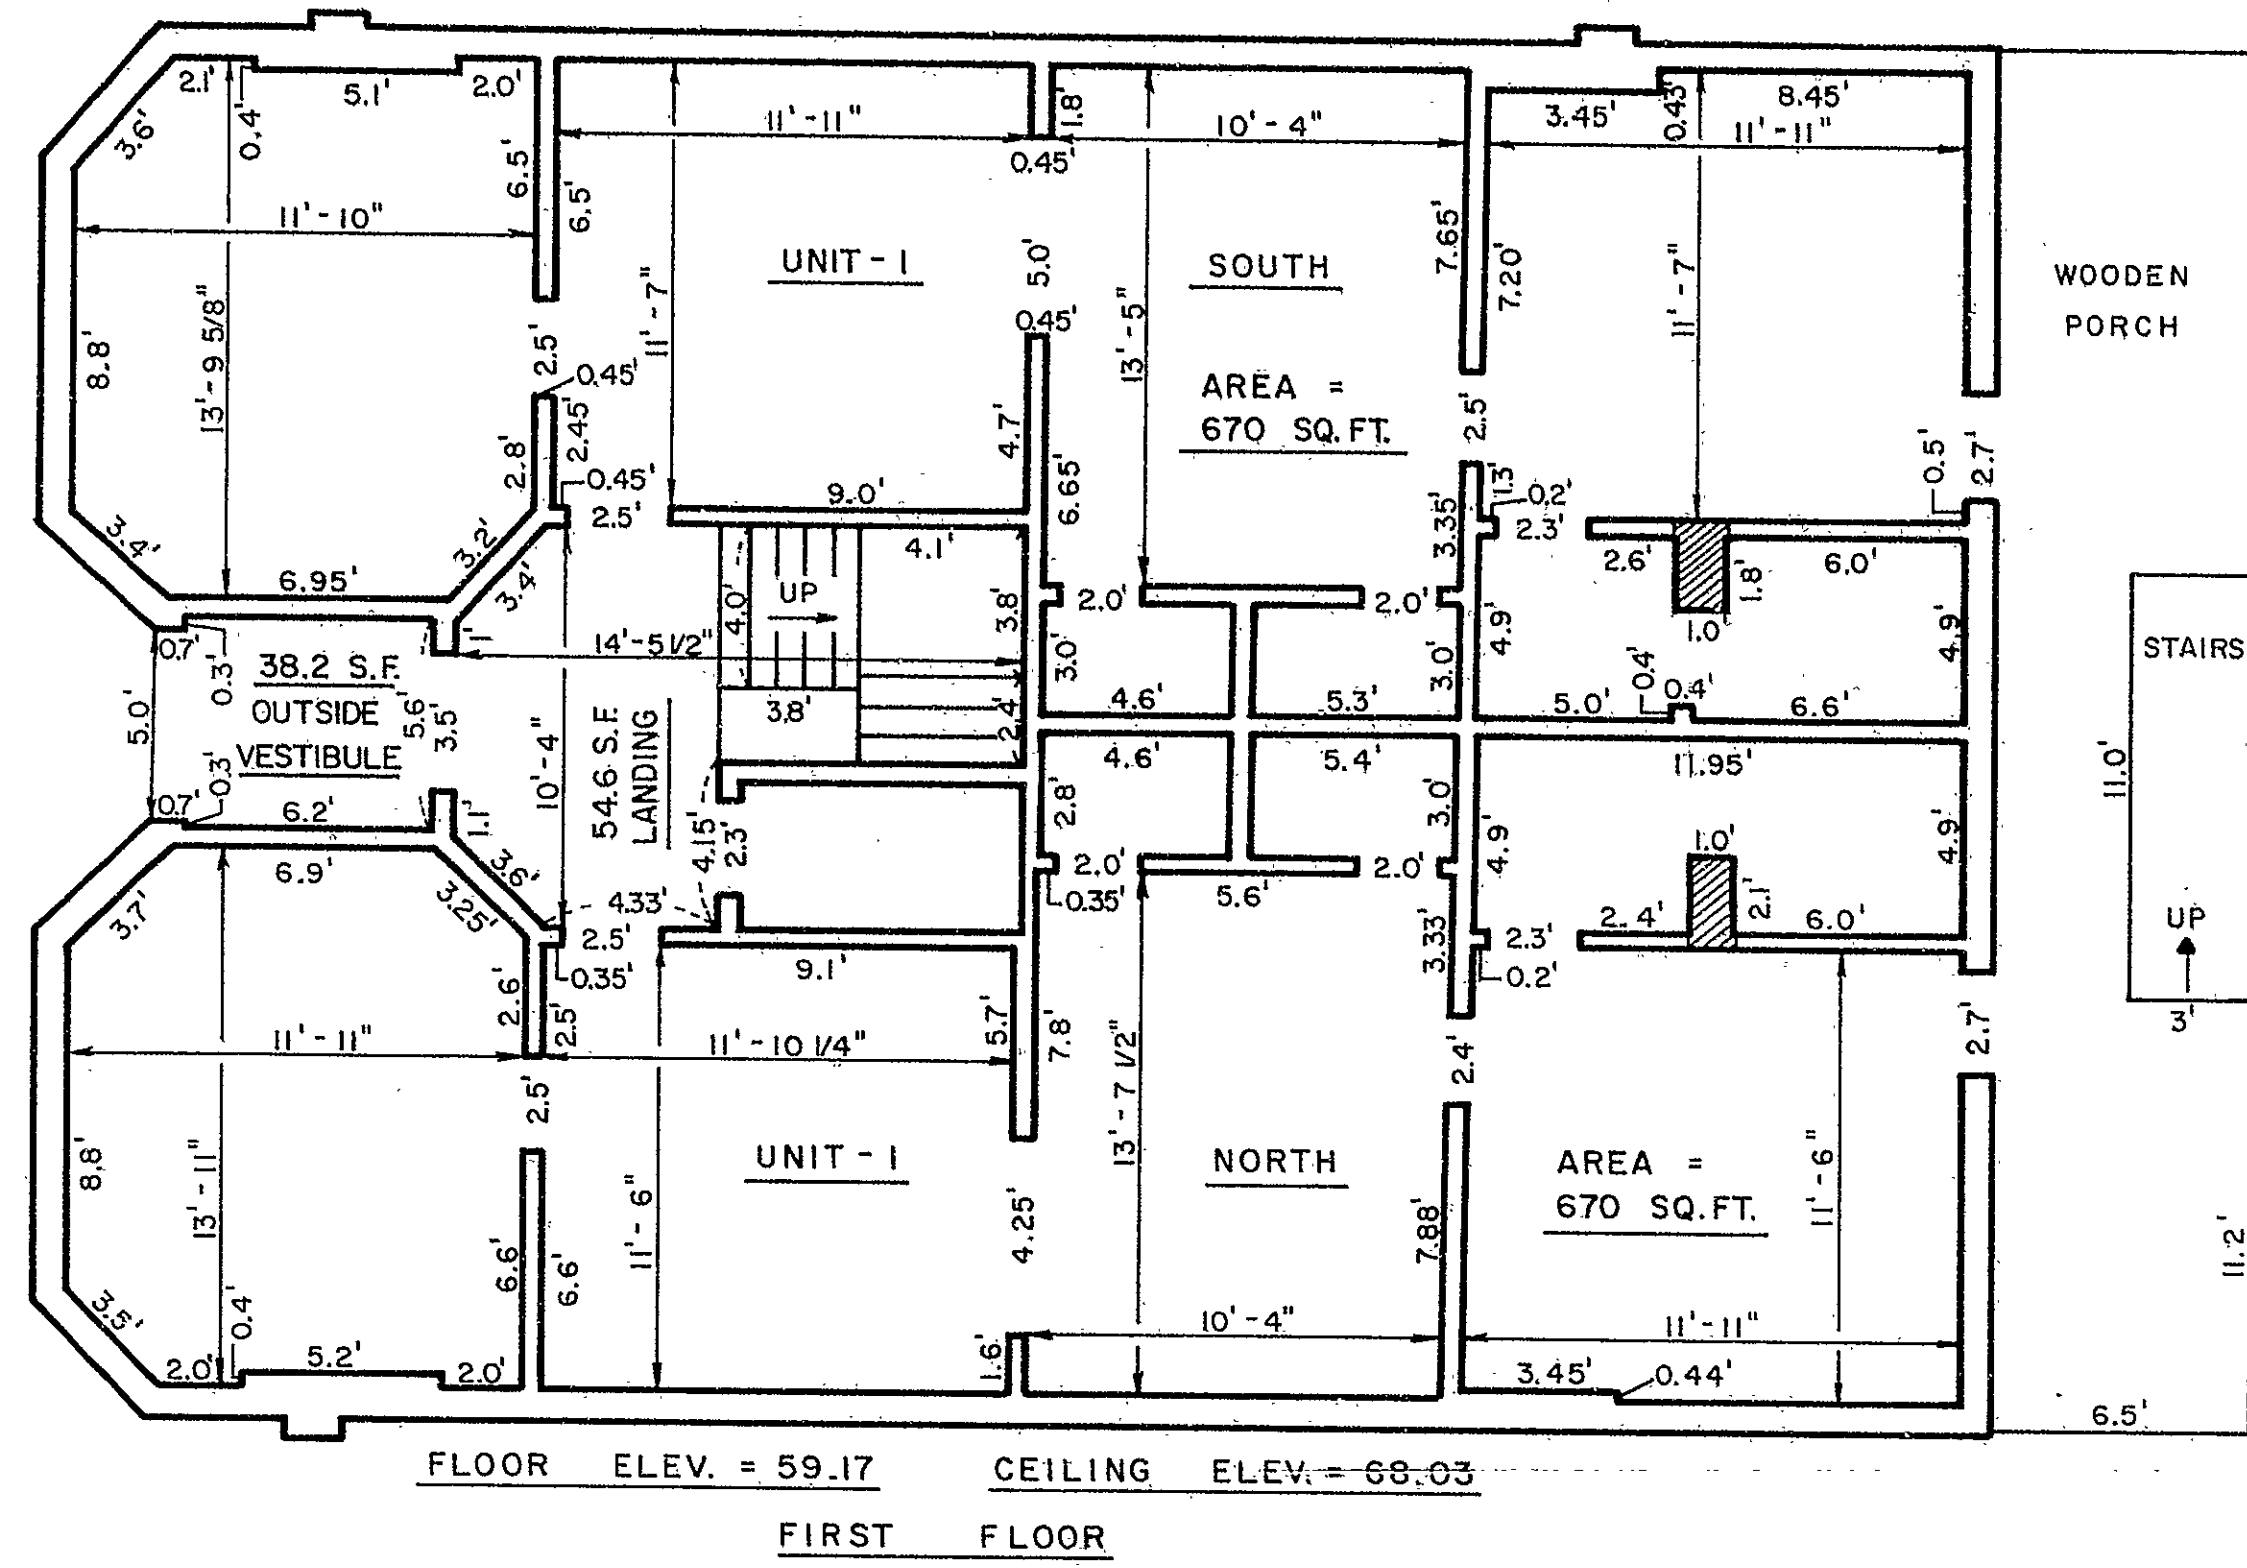


NOTE:
ELEVATIONS BASED ON METROPOLITAN DISTRICT COMMISSION DATUM.
ALL DIMENSIONS AND AREAS ARE APPROXIMATE.
ALL AREAS WHICH ARE NOT WITHIN A UNIT ARE COMMON ELEMENTS,
INCLUDING LIMITED COMMON ELEMENTS.

VERIFICATION

STATE OF CONNECTICUT
COUNTY OF HARTFORD
ON THIS 3rd DAY OF February 1982, I, FREDERICK A. HESKETH, Notary Public, personally appeared FREDERICK A. HESKETH, known to me to be the person whose name is subscribed to the foregoing instrument, and being duly sworn, made a solemn oath to the truth of the statement to which his name is subscribed.

Frederick A. Hesketh
NOTARY PUBLIC
COMMISSIONER OF SUPERIOR COURT

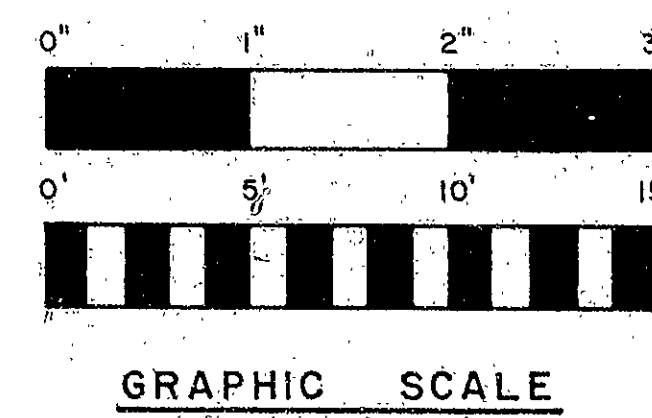


CERTIFICATION:

THE UNDERSIGNED CERTIFIES THAT THIS PLAN IS AN ACCURATE COPY OF THE PLAN ON FILE WITH THE BUILDING OFFICE OF THE CITY OF HARTFORD.

FREDERICK A. HESKETH

BUCKINGHAM SOUTH CONDOMINIUM FLOOR PLANS			
57 JOHN STREET HARTFORD, CONNECTICUT			
Date 12/16/81	Drawn by C.G.	Job no 81143	
Scale 1" = 5'	Checked by E.A.H.	Sheet no 1	
F A HESKETH & ASSOCIATES 101 Millbrook Common Bloomfield, CT 06002		ENGINEERS SURVEYORS	

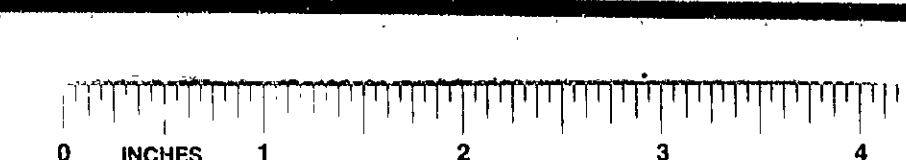

Condo Floor Plans # 74