


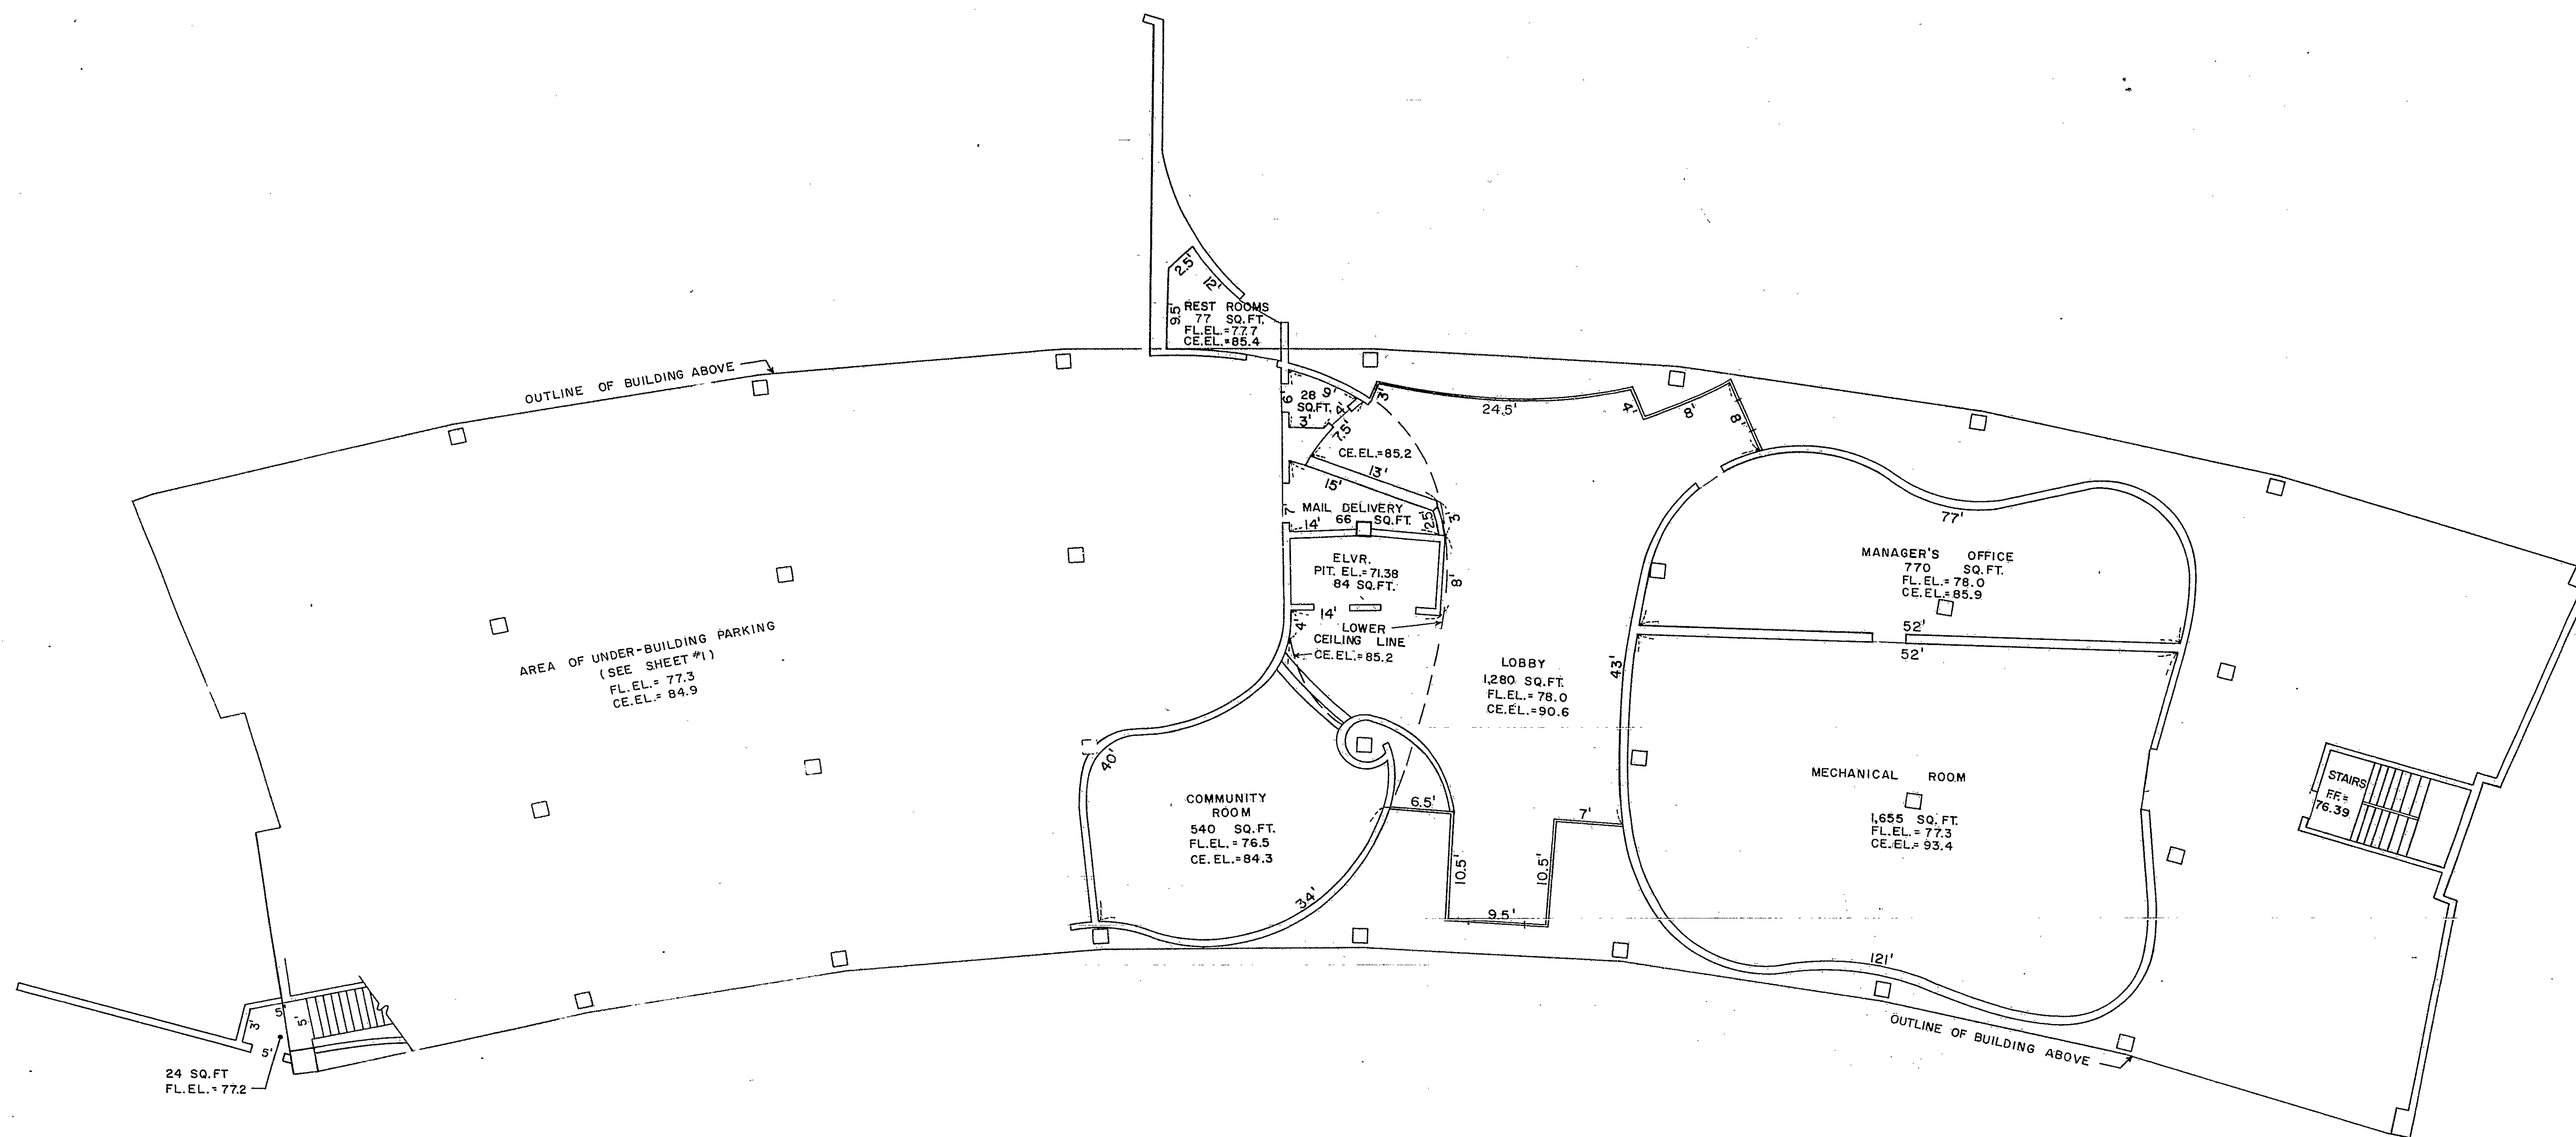

NOTE:

ELEVATIONS BASED ON METROPOLITAN
DISTRICT COMMISSION DATUM.
ALL DIMENSIONS AND AREAS ARE APPROXIMATE.

- ALL AREAS WHICH ARE NOT WITHIN A UNIT ARE
COMMON ELEMENTS, INCLUDING LIMITED COMMON
ELEMENTS.
- FOR SPECIFIC DESCRIPTION AND DEFINITION OF
UNIT BOUNDARIES SEE ARTICLE II OF THE
DECLARATION.

FLOOR # 1

LEGEND:

- BALCONY
- ELEVATOR
- FL. CL.
- ELVR.
- STAIR
- TRASH
- UNIT BOUNDARY
- OTHER STRUCTURAL ELEMENT

CERTIFICATION:


THE UNDERSIGNED CERTIFIES THAT THIS PLAN IS
AN ACCURATE COPY OF THE PLAN ON FILE WITH
THE BUILDING OFFICE OF THE CITY OF HARTFORD.

Frederick A. Hesketh
FREDERICK A. HESKETH

VERIFICATION:

STATE OF CONNECTICUT
COUNTY OF HARTFORD SS HARTFORD
ON THIS 11 DAY OF DECEMBER 1981 PERSONALLY APPEARED
FREDERICK A. HESKETH SIGNER OF THE FOREGOING CERTIFICATION
AND BEING DULY SWORN MADE A SOLEMN OATH TO THE
TRUTH OF THE STATEMENT TO WHICH HIS NAME IS SUBSCRIBED.

Susan Camillo
COMMISSIONER OF SUPERIOR COURT

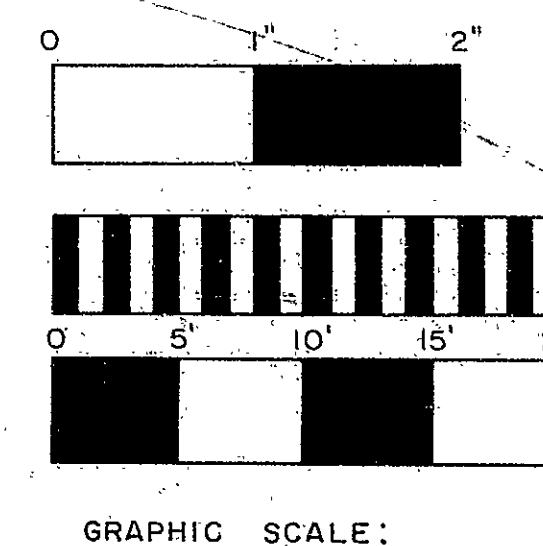

RECEIVED
12 17 2011
TOWN & CITY CLERK
HARTFORD
VOLUME
PAGE

REGENCY TOWERS CONDOMINIUM 30 WOODLAND STREET HARTFORD, CONNECTICUT			
date: 2/9/81	drawn by: C.G.	job no: 80162	sheet no: 2
scale: 1/8" = 1'			
checked by: F.A.H.			
F.A. HESKETH & ASSOCIATES ENGINEERS & SURVEYORS 101 Millbrook Common Bloomfield, CT 06002			

Condo Plan # 44

