


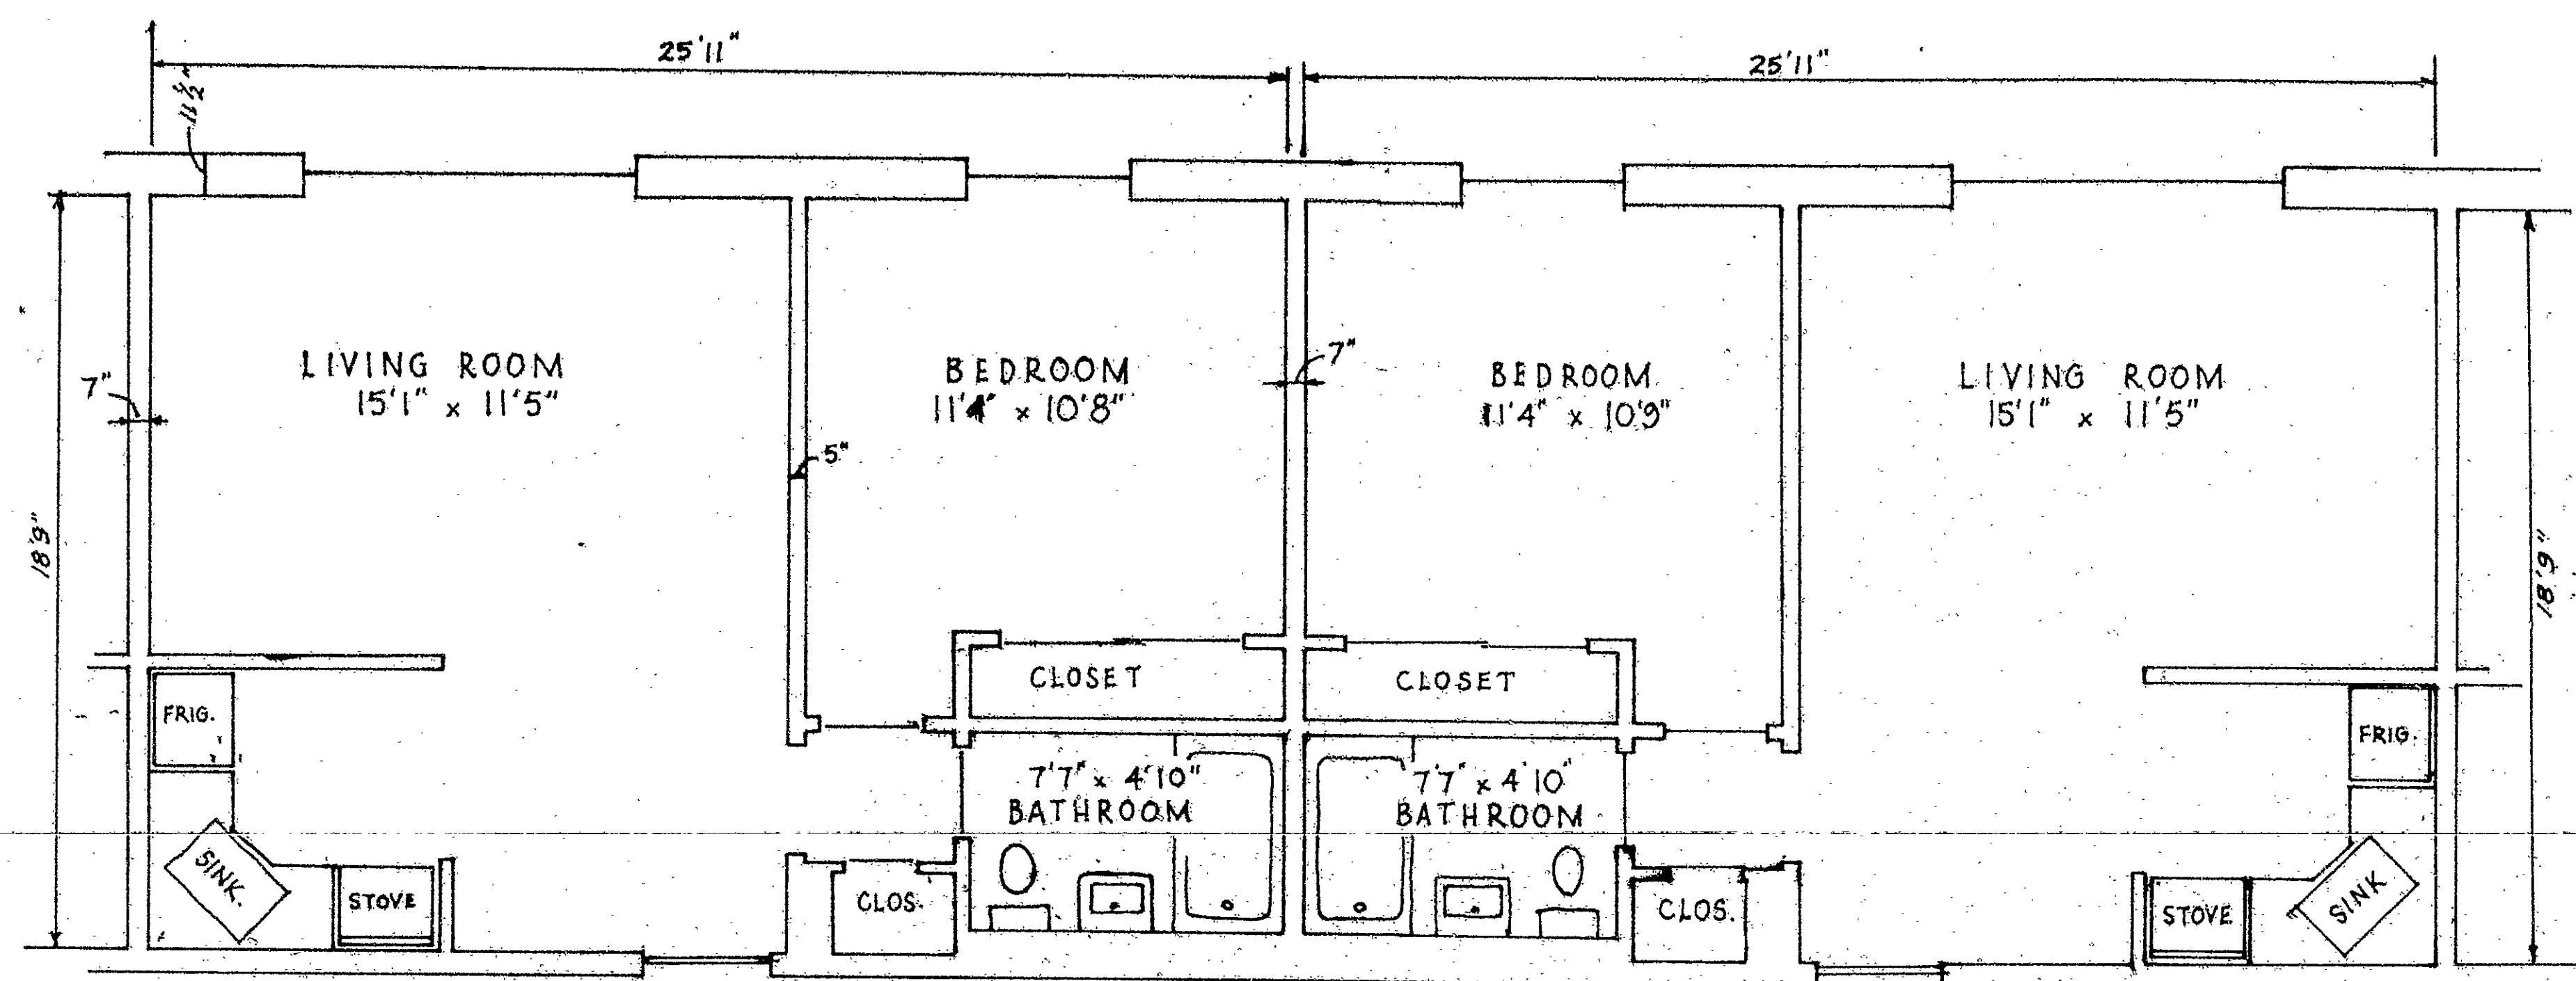

FLOOR PLAN FOR 201, 203, 206, 208, 301, 303, 306, 308, 401, 403, 406 and 408.

FLOOR PLAN FOR 202, 204, 207, 209, 302, 304, 307, 309, 402, 404, 407, and 409.


AVERAGE UNIT ELEVATIONS

UNIT NO.	FLOOR	CEILING
201-209	124.38	131.99
301-309	133.05	140.66
401-409	141.70	149.31

GROSS INTERIOR FLOOR AREA OF EACH UNIT IS 485 FT².

CERTIFIED A TRUE COPY OF THE MAP AND PLAN ON FILE IN MY OFFICE, THIS THIRTIETH DAY OF APRIL 1981.

CITY OF HARTFORD
COUNTY OF HARTFORD
STATE OF CONNECTICUT

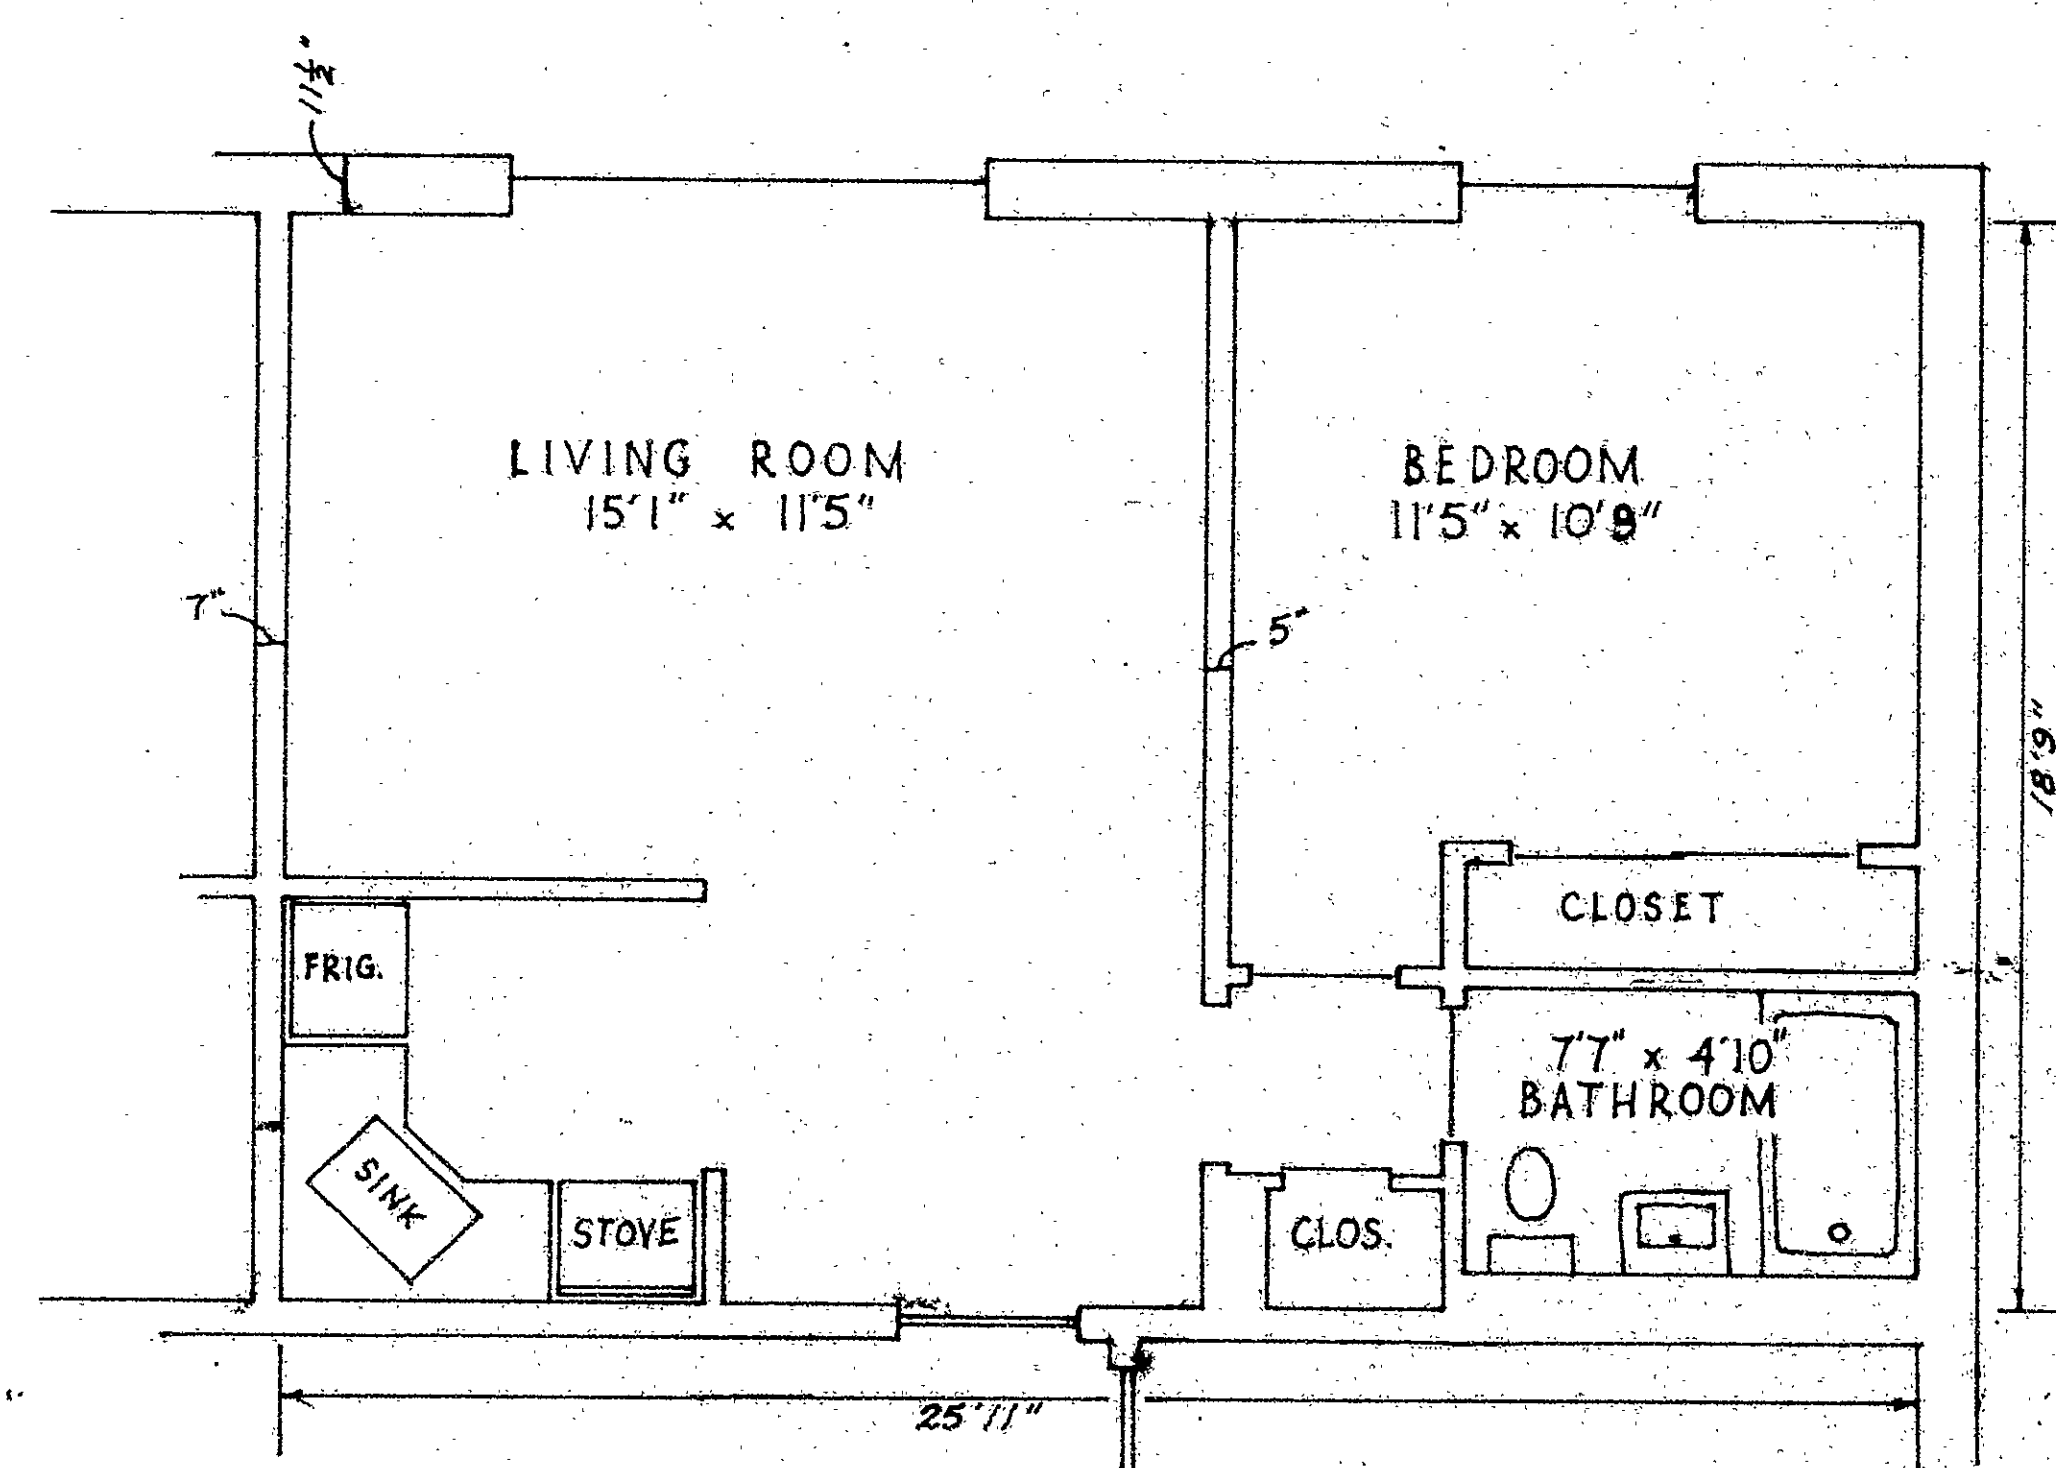

FLOOR PLAN FOR 205, 305, and 405.

- NOTE:
1. CEILING LINE AT UNDERSIDE OF JOISTS 7'8" ABOVE FLOOR. ONE INCH THICKNESS OF SOUNDPROOFING HAS BEEN ADDED, REDUCING CLEARANCE.
 2. FIRST FLOOR ELEVATION IS STATED ON SITE PLAN. 124.38" (MDC).
 3. STATED DIMENSIONS ARE BASED ON MEASUREMENTS OF WALL SEGMENTS TO NEAREST 1/2". INDIVIDUAL UNITS DIMENSIONS VARY SLIGHTLY; STATED DIMENSIONS ARE TYPICAL DIMENSIONS.
 4. THIS IS AN AS-BUILT.

CERTIFIED TO BE AN ACCURATE COPY OF PLANS AS FILED WITH THE CITY OF HARTFORD DEPT. OF LICENSES AND INSPECTIONS ON THE THIRTIETH DAY OF APRIL 1981.

GRANT MEITZLER
CONN. P.E. NO. 10,005


PERSONALLY APPEARED GRANT MEITZLER, SIGNER OF THE FOREGOING CERTIFICATE AND BEING DULY SWORN, MADE SOLEMN OATH TO THE TRUTH OF THE STATEMENT TO WHICH HIS MARK IS SUBSCRIBED

Richard N. Feltner
Commissioner - Superior Court

APRIL 30, 1981

THIS FLOOR PLAN IS BASED ON MEASUREMENTS ACTUALLY MADE IN THE BUILDING - SEE NOTE 3. MEASUREMENTS HAVE BEEN STATED SO THAT MINOR VARIATIONS SHOULD RESULT IN DIMENSIONS LARGER THAN THOSE STATED.

I CERTIFY THIS PLAN SUBSTANTIALLY COMES TO BE
GRANT MEITZLER, PHD, LS NO. 17005

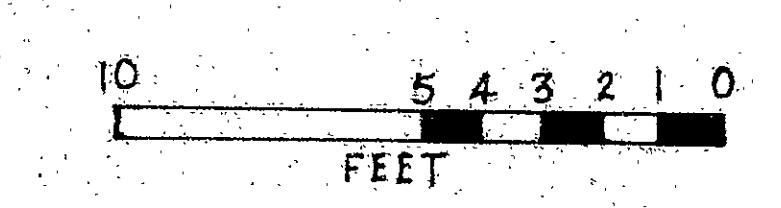

"DELNOR CONDOMINIUM"
160 NEW BRITAIN AVENUE, LTD.

INDIVIDUAL UNIT FLOOR PLANS - TYPICAL

HARTFORD, CONN.
SCALE 1" = 4 FT.

FEBRUARY 7, 1981
GRANT MEITZLER, PHD.

RECEIVED BY
TOWN & CITY CLERK
HARTFORD
VOLUME PAGE
APR 30 2 45 PM '81

