


46

46-3

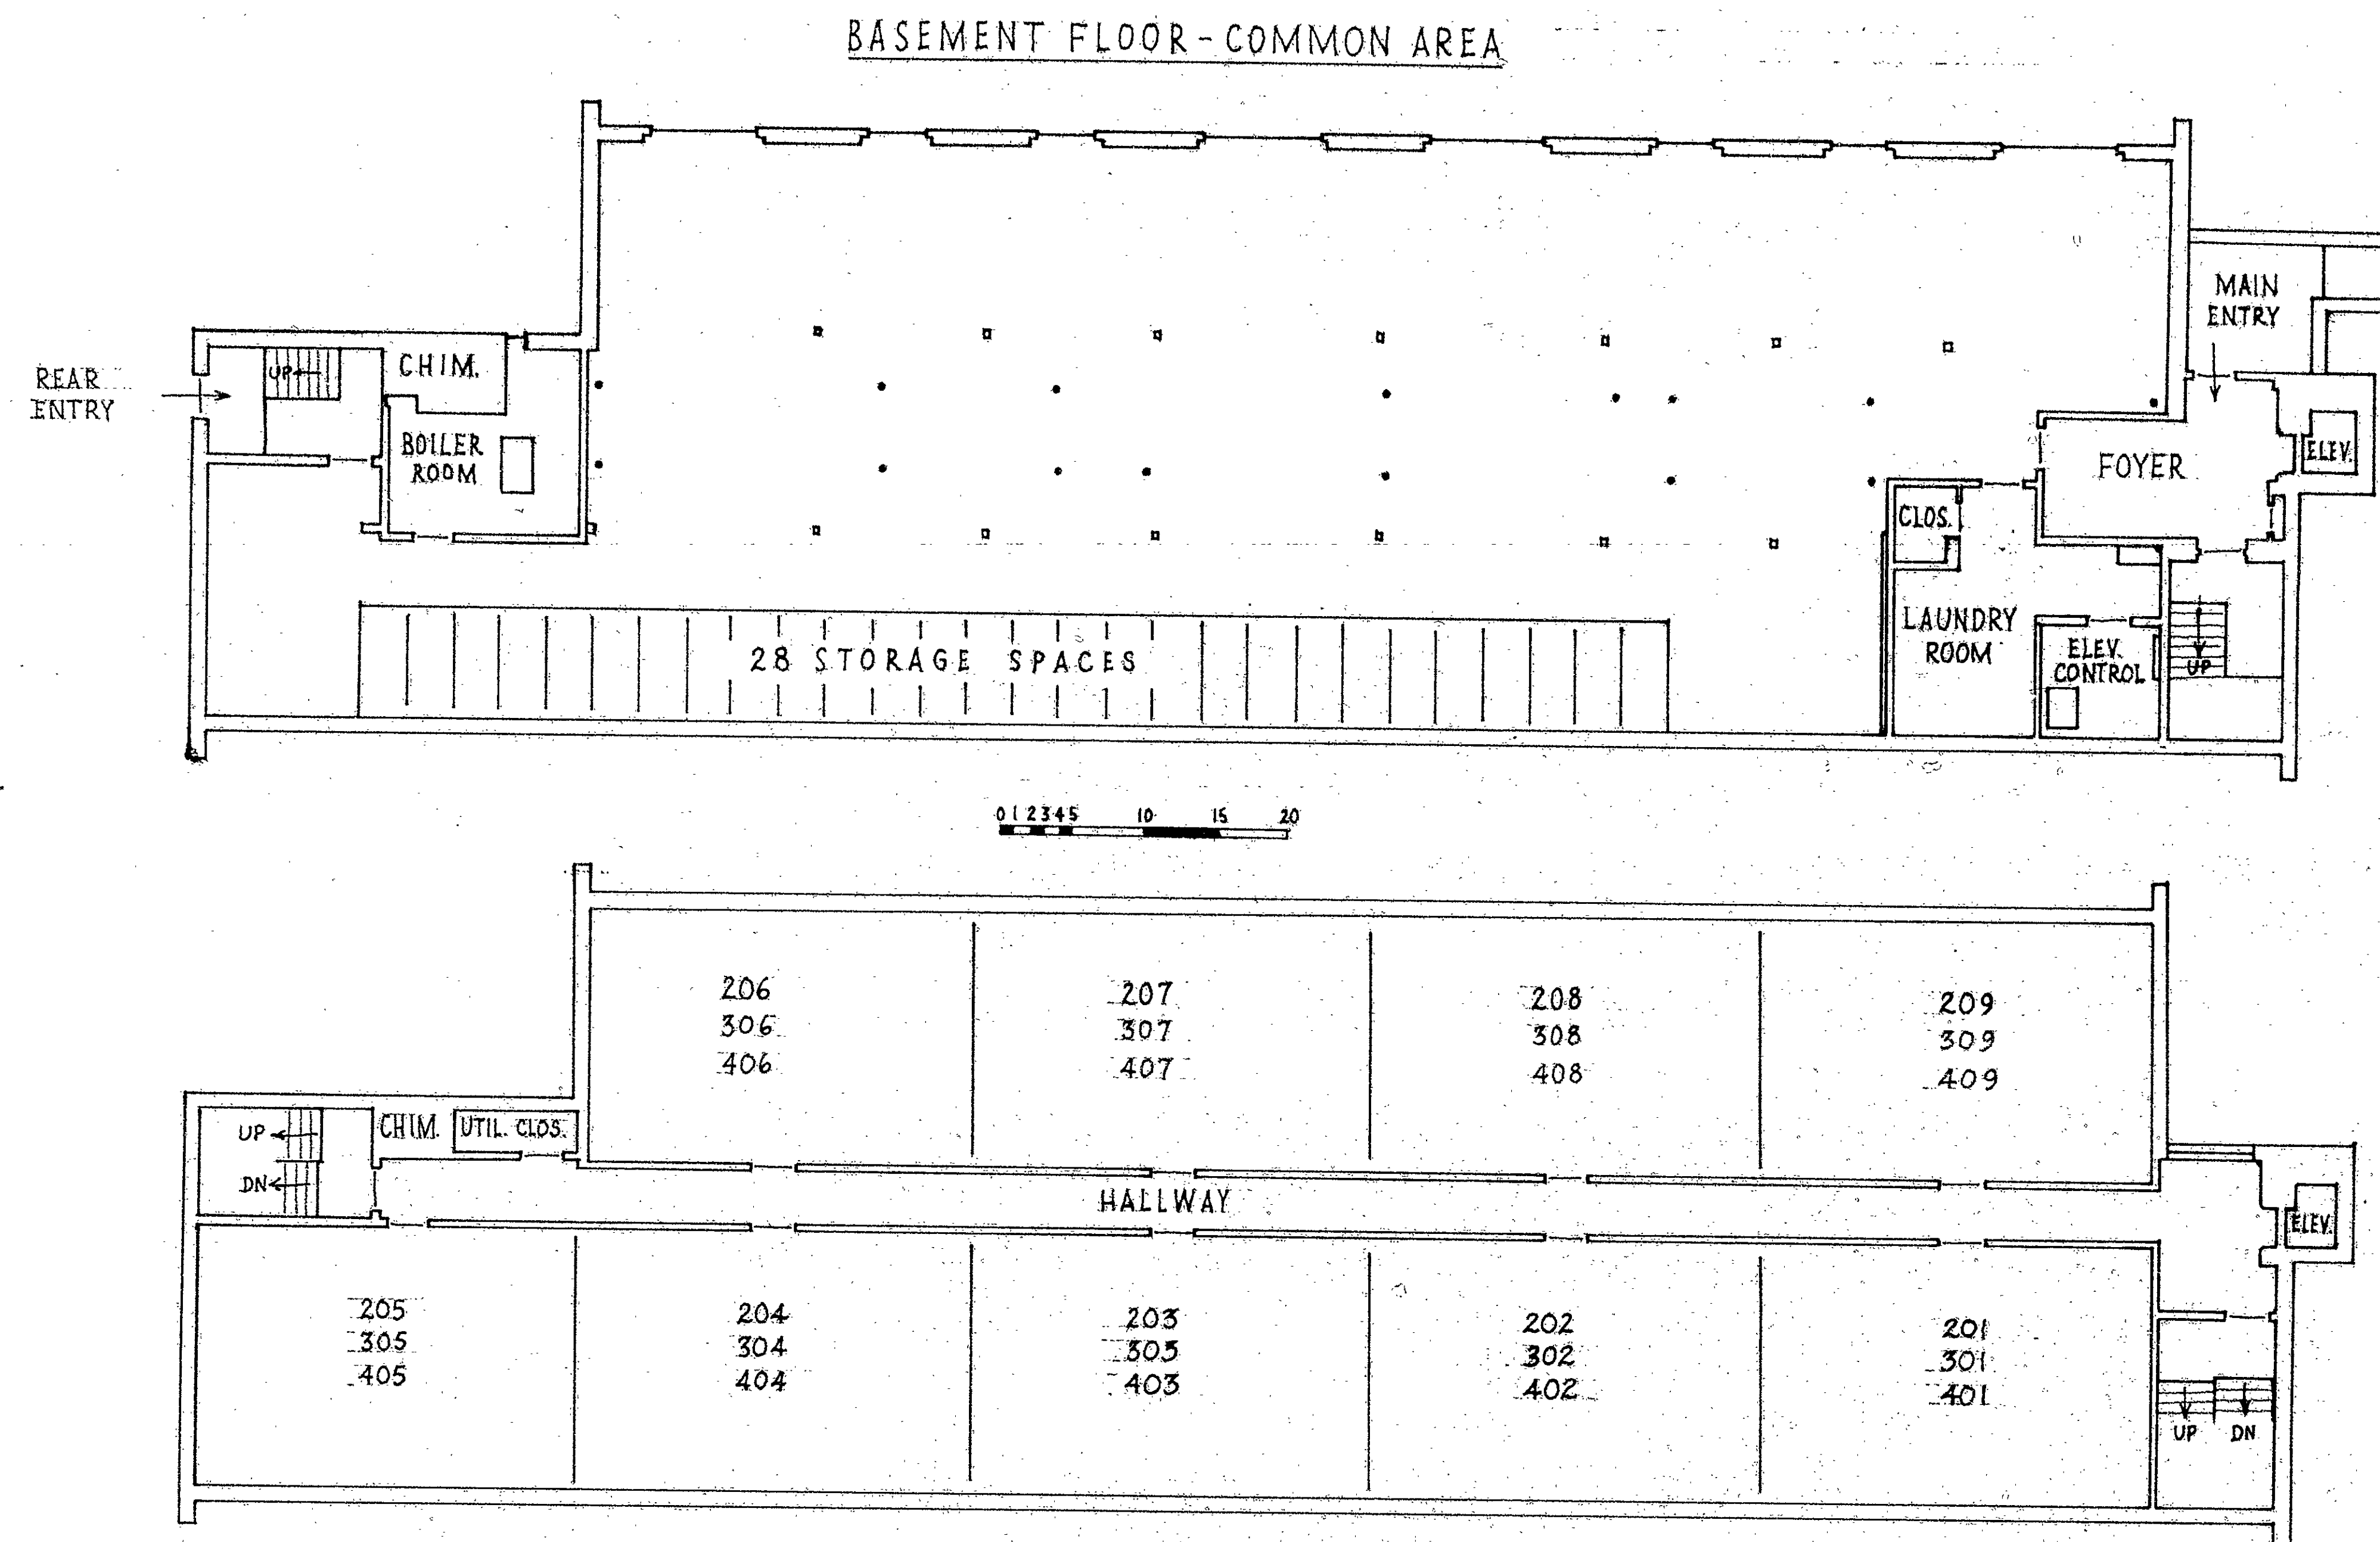

- DRAINPIPE
- BOXED SUPPORT COLUMN

LAYOUT OF UPPER THREE FLOORS IS IDENTICAL WITH NUMBERED UNITS LOCATED AS SHOWN.

FLOOR PLAN OF UNITS IS SHOWN ON SHEET TWO.

FILED
FEB 10 9 55 AM '81
TOWN & CITY CLERK
HARTFORD

MEASUREMENTS ARE BASED ON READINGS TAKEN TO NEAREST 1/2" ALONG INTERIOR WALL SEGMENTS. REFER TO PLAN ENTITLED "PROP. OF 160 NEW BRITAIN AVE., LTD., HTFD, CT." DATED 1-24-81 BY D. PAQUETTE, L.S. 4476 FOR EXTERIOR BUILDING DIMENSIONS.

I CERTIFY THIS MAP SUBSTANTIALLY CORRECT.

GRANT MEITZLER, PHD, LS NO. 10,005

Grant Meitzler

160 NEW BRITAIN AVENUE, LTD.

BUILDING FLOOR PLAN - SHOWING COMMON INTERIOR

HARTFORD, CONN.

SCALE 1" = 10 FT.

FEBRUARY 7, 1981

GRANT MEITZLER, PHD.