



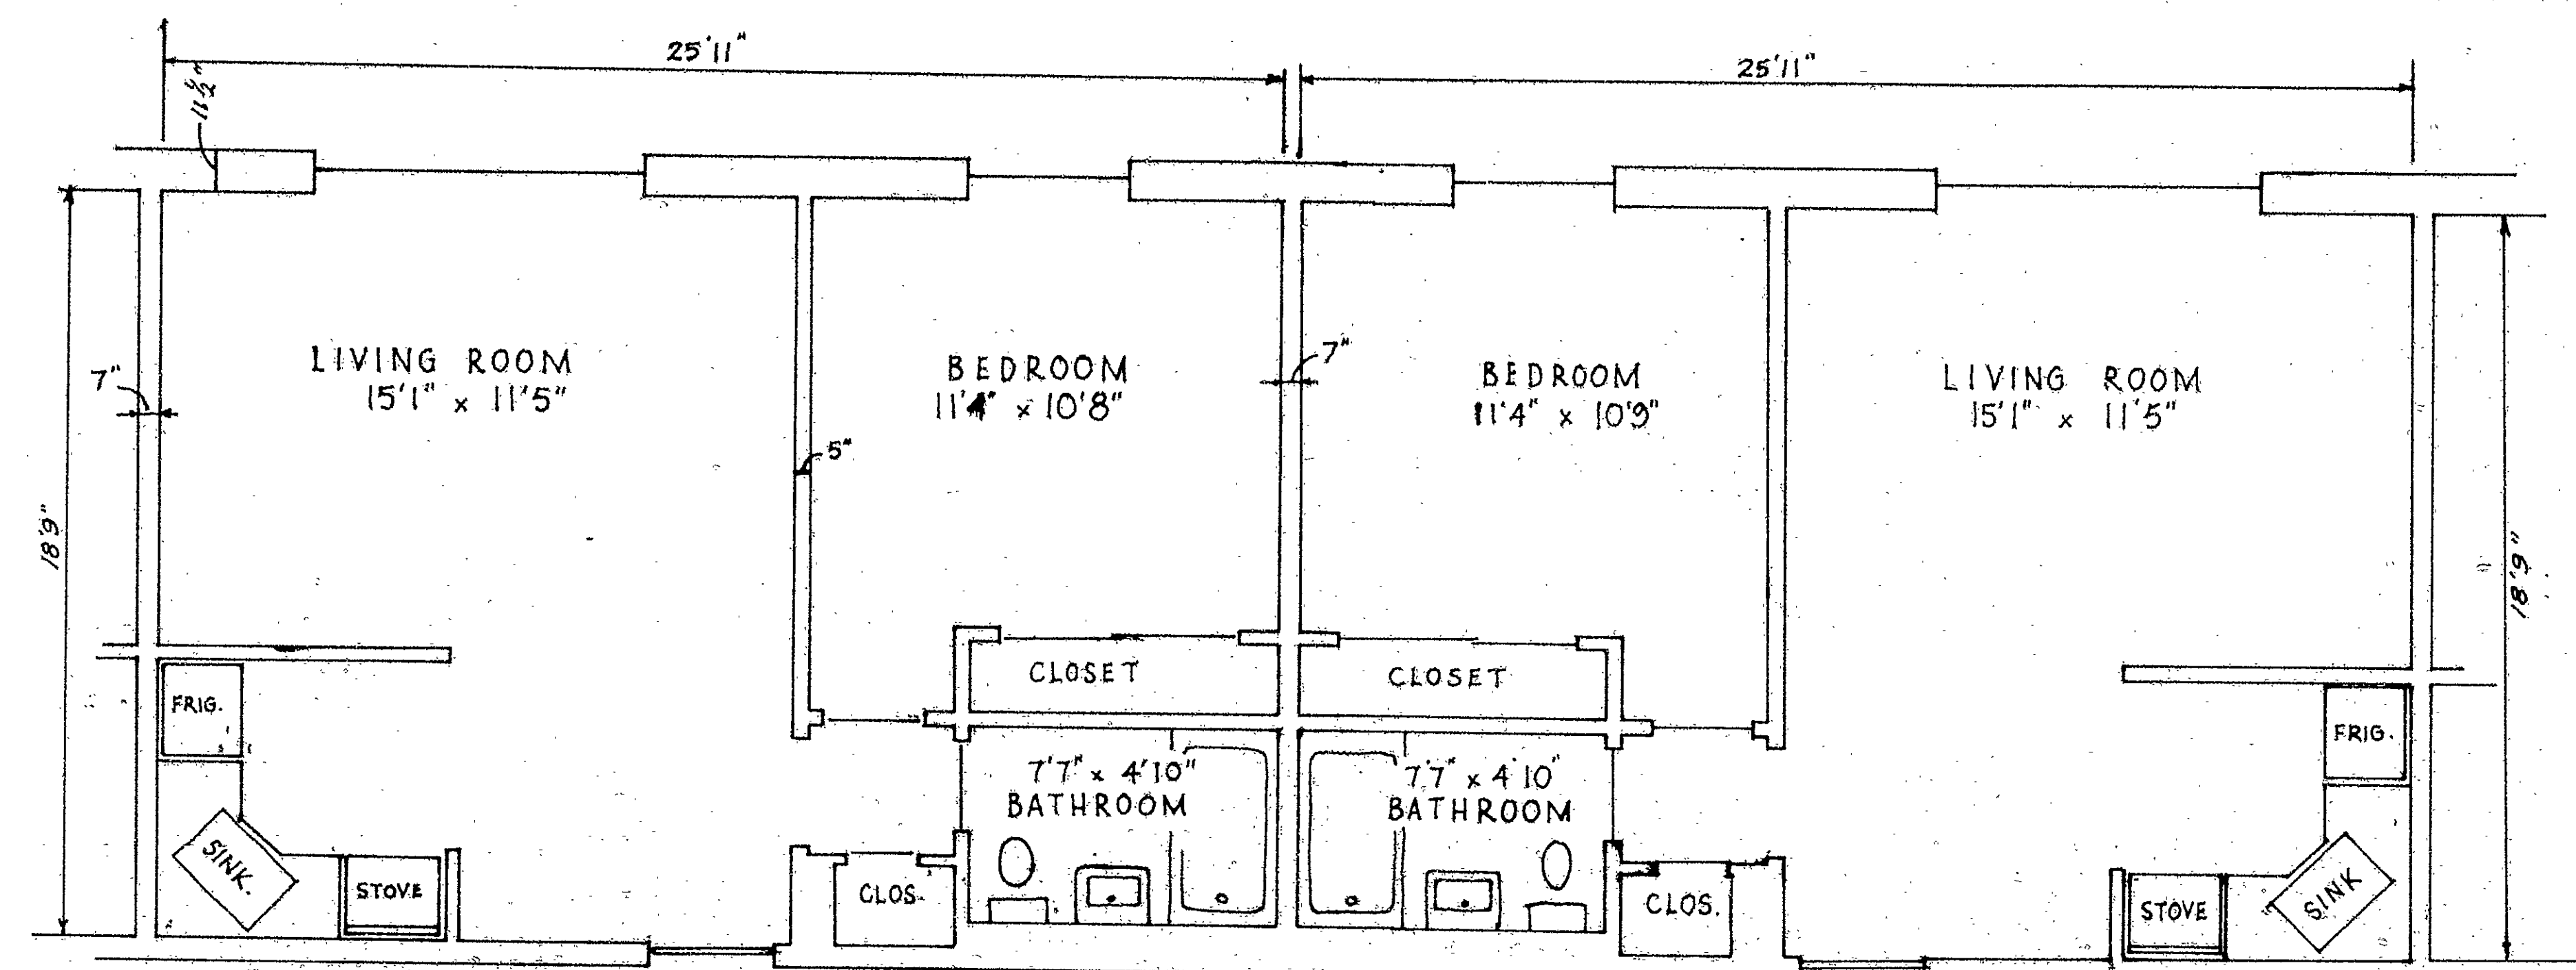

FLOOR PLAN FOR 201, 203, 206, 208, 301, 303, 306, 308, 401, 403, 406 and 408.

FLOOR PLAN FOR 202, 204, 207, 209, 302, 304, 307, 309, 402, 404, 407, and 409.


AVERAGE UNIT ELEVATIONS		
UNIT NO.	FLOOR	CEILING
201-209	124.38	131.99
301-309	133.05	140.66
401-409	141.70	149.31

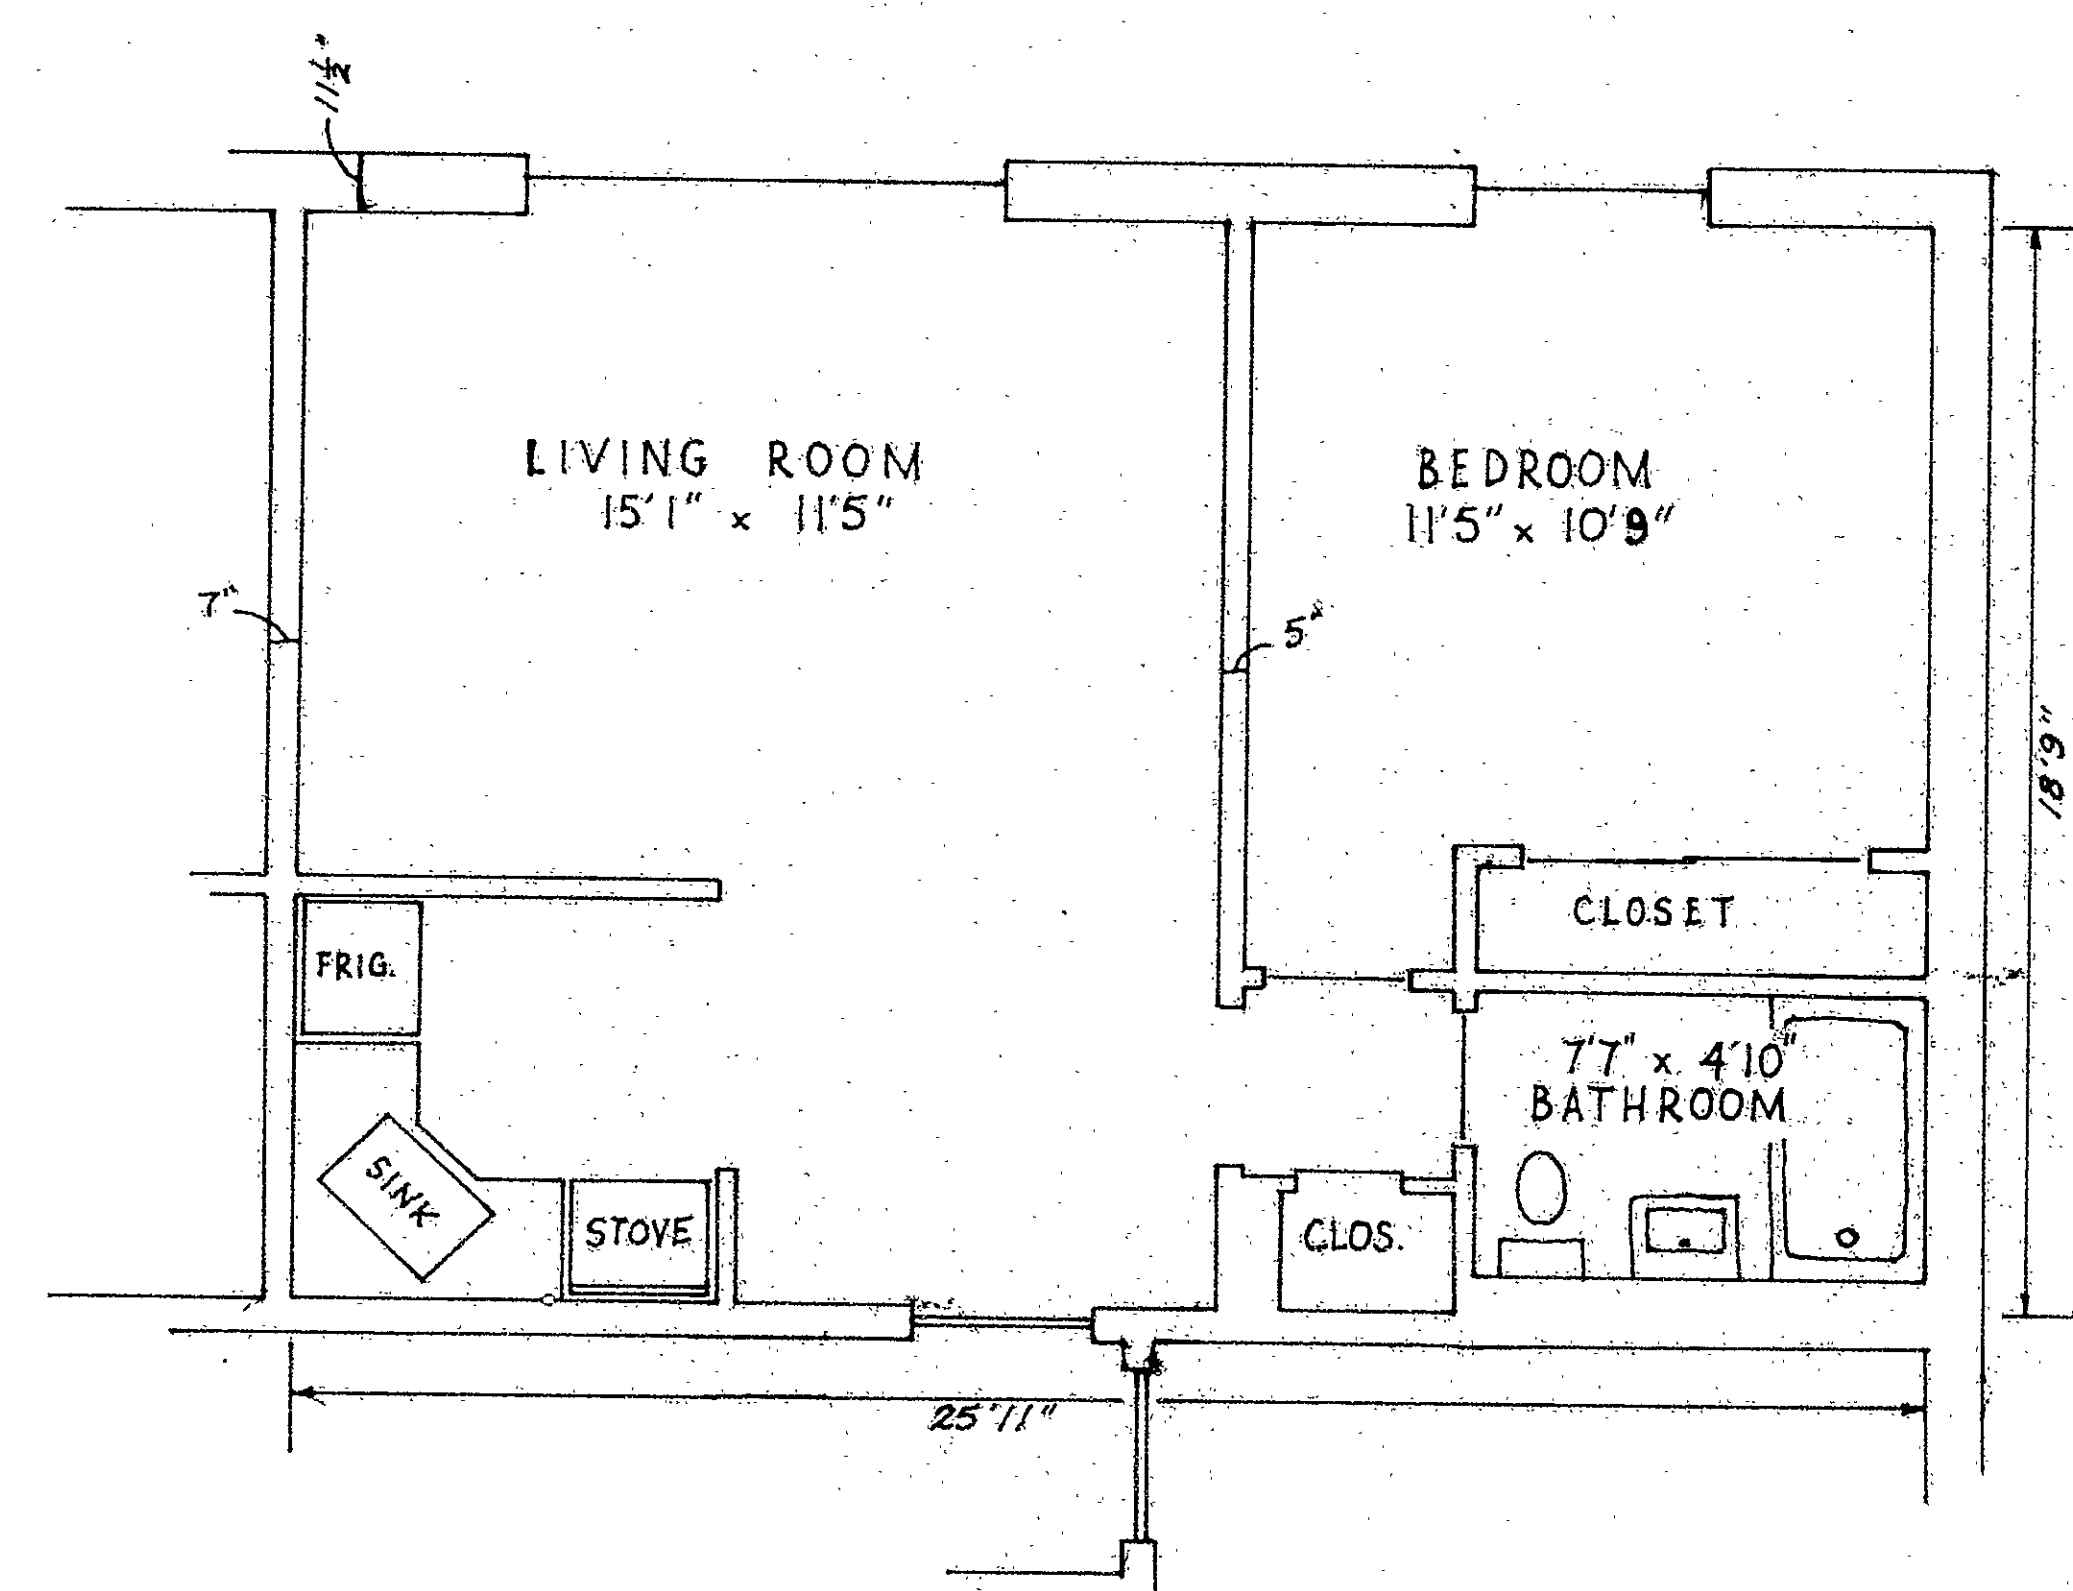

FLOOR PLAN FOR 205, 305, and 405.

NOTE:

1. CEILING LINE AT UNDERSIDE OF JOISTS 7'8" ABOVE FLOOR. ONE INCH THICKNESS OF SOUNDPROOFING HAS BEEN ADDED, REDUCING CLEARANCE.
2. FIRST FLOOR ELEVATION IS STATED ON SITE PLAN - 124.38' (MDC)
3. STATED DIMENSIONS ARE BASED ON MEASUREMENTS OF WALL SEGMENTS TO NEAREST 1/2". INDIVIDUAL UNITS DIMENSIONS VARY SLIGHTLY; STATED DIMENSIONS ARE TYPICAL DIMENSIONS.

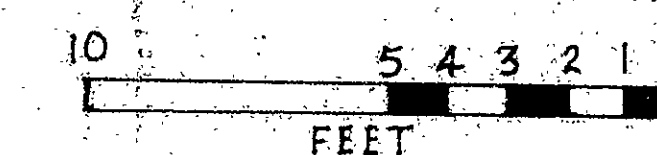

160 NEW BRITAIN AVENUE, LTD.
INDIVIDUAL UNIT FLOOR PLANS - TYPICAL


HARTFORD, CONN.
SCALE 1" = 4' FT.

FEBRUARY 7, 1981
GRANT MEITZLER, PH.D.

I CERTIFY THIS PLAN SUBSTANTIALLY CORRECT.
GRANT MEITZLER, PH.D. LS NO. 10,005

Grant Meitzler

Revised 2-25-81 GM - add unit elevations.

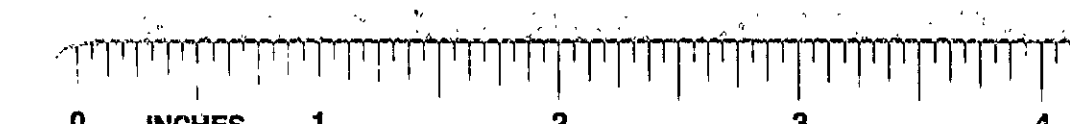

RECEIVED BY
GRANT MEITZLER
APR 8 9 55 AM '81
TOWN & CITY CLERK
HARTFORD
101 - 102 - 103 

46-4-5-2/16-5
Condo # 46