
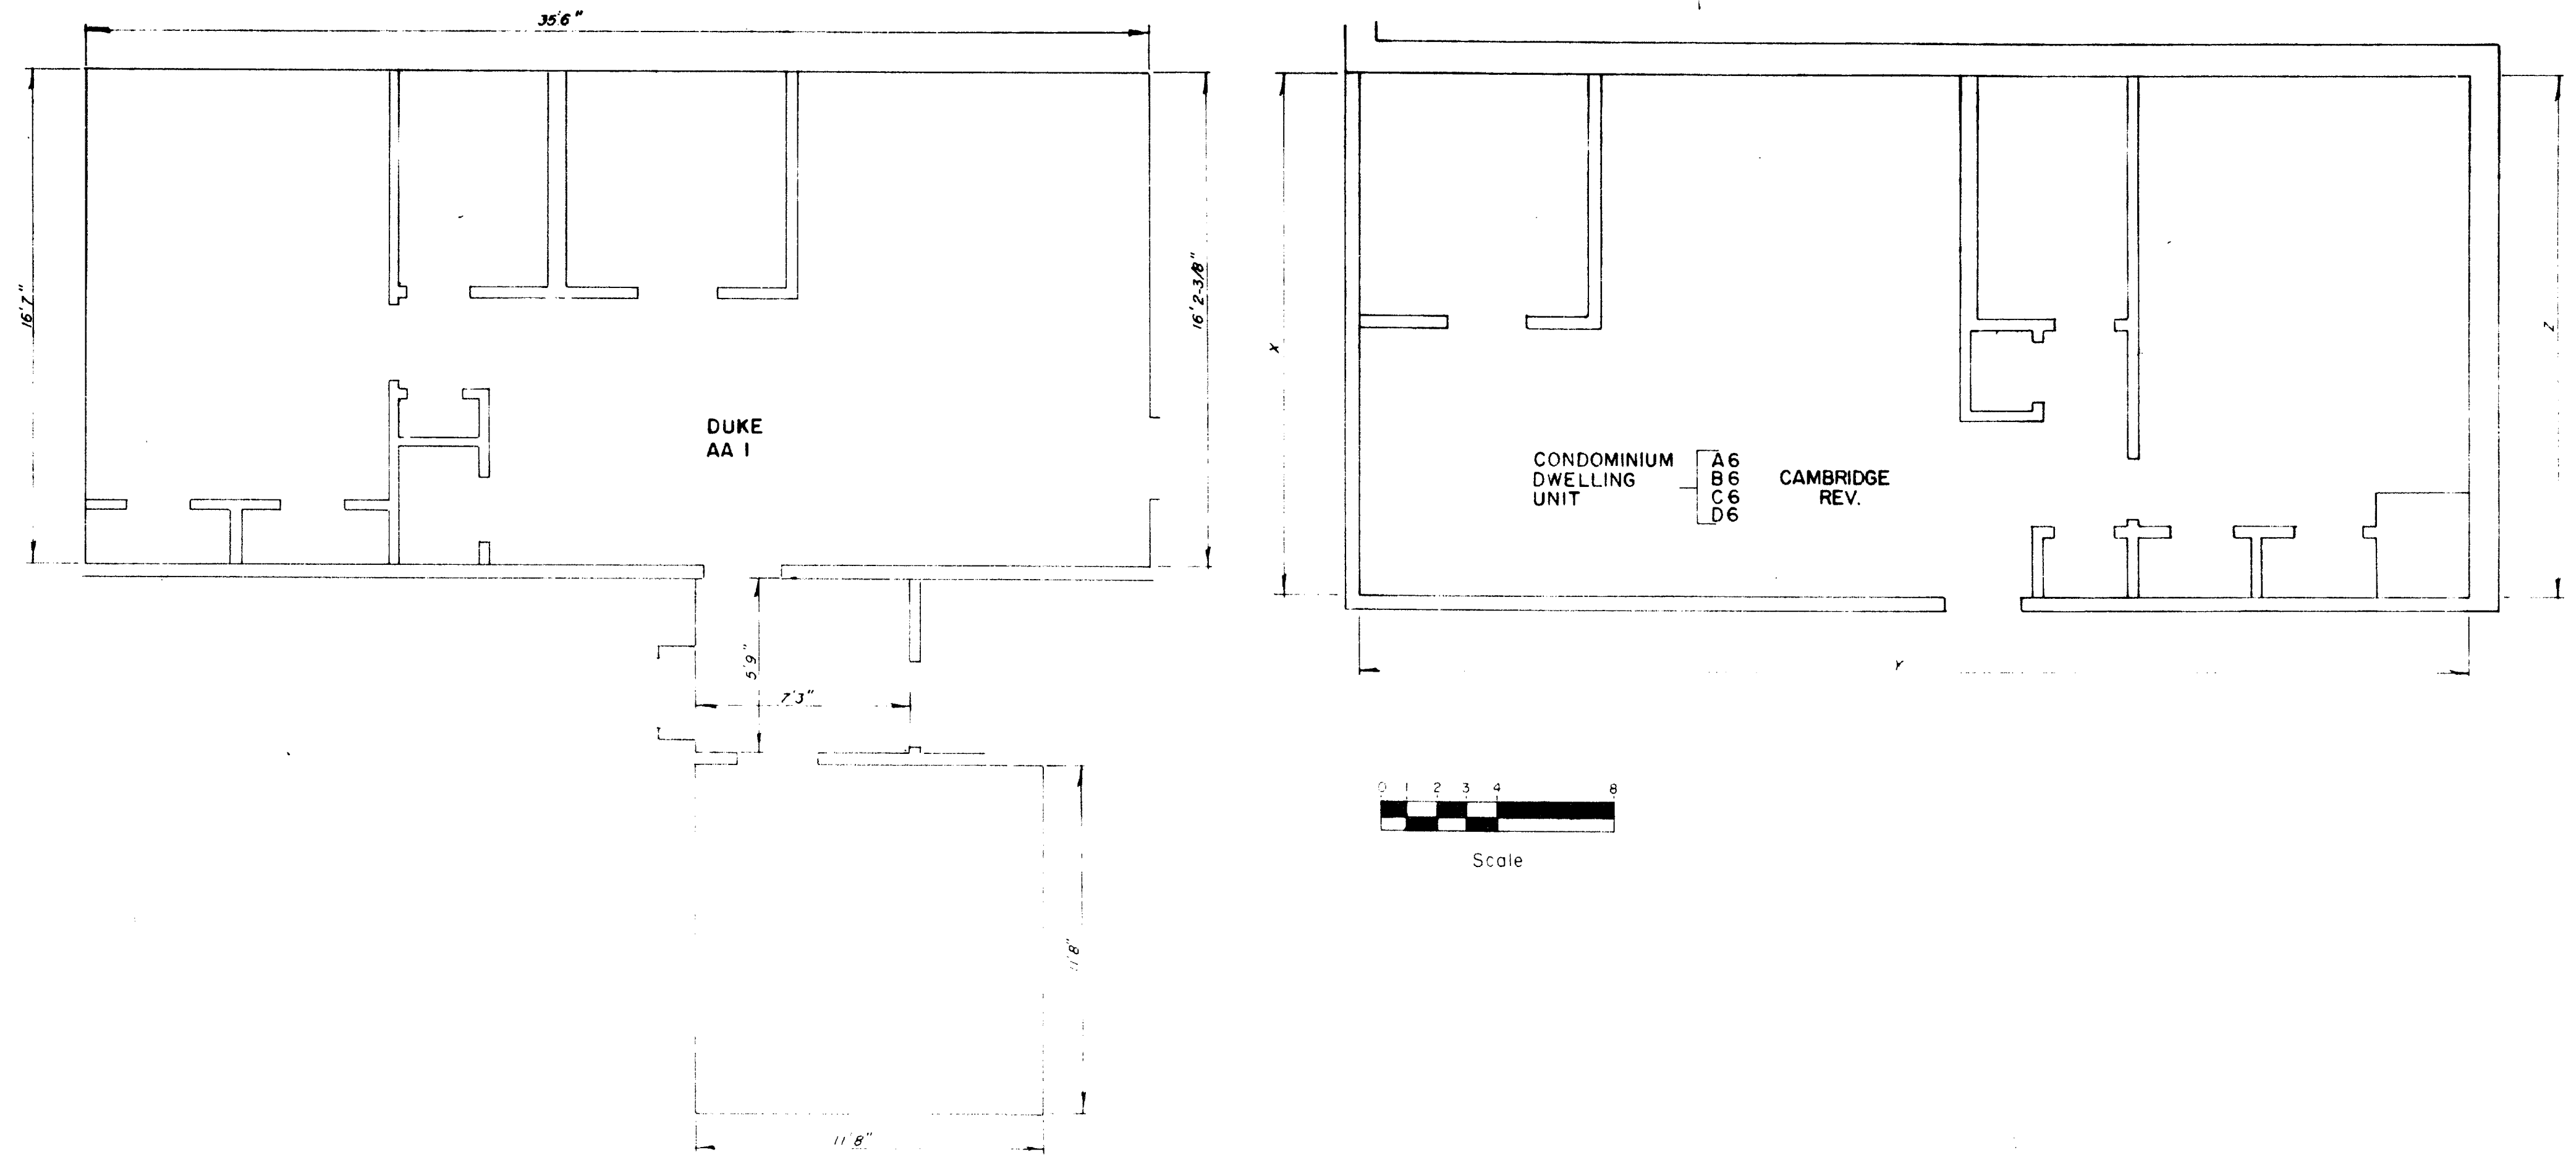


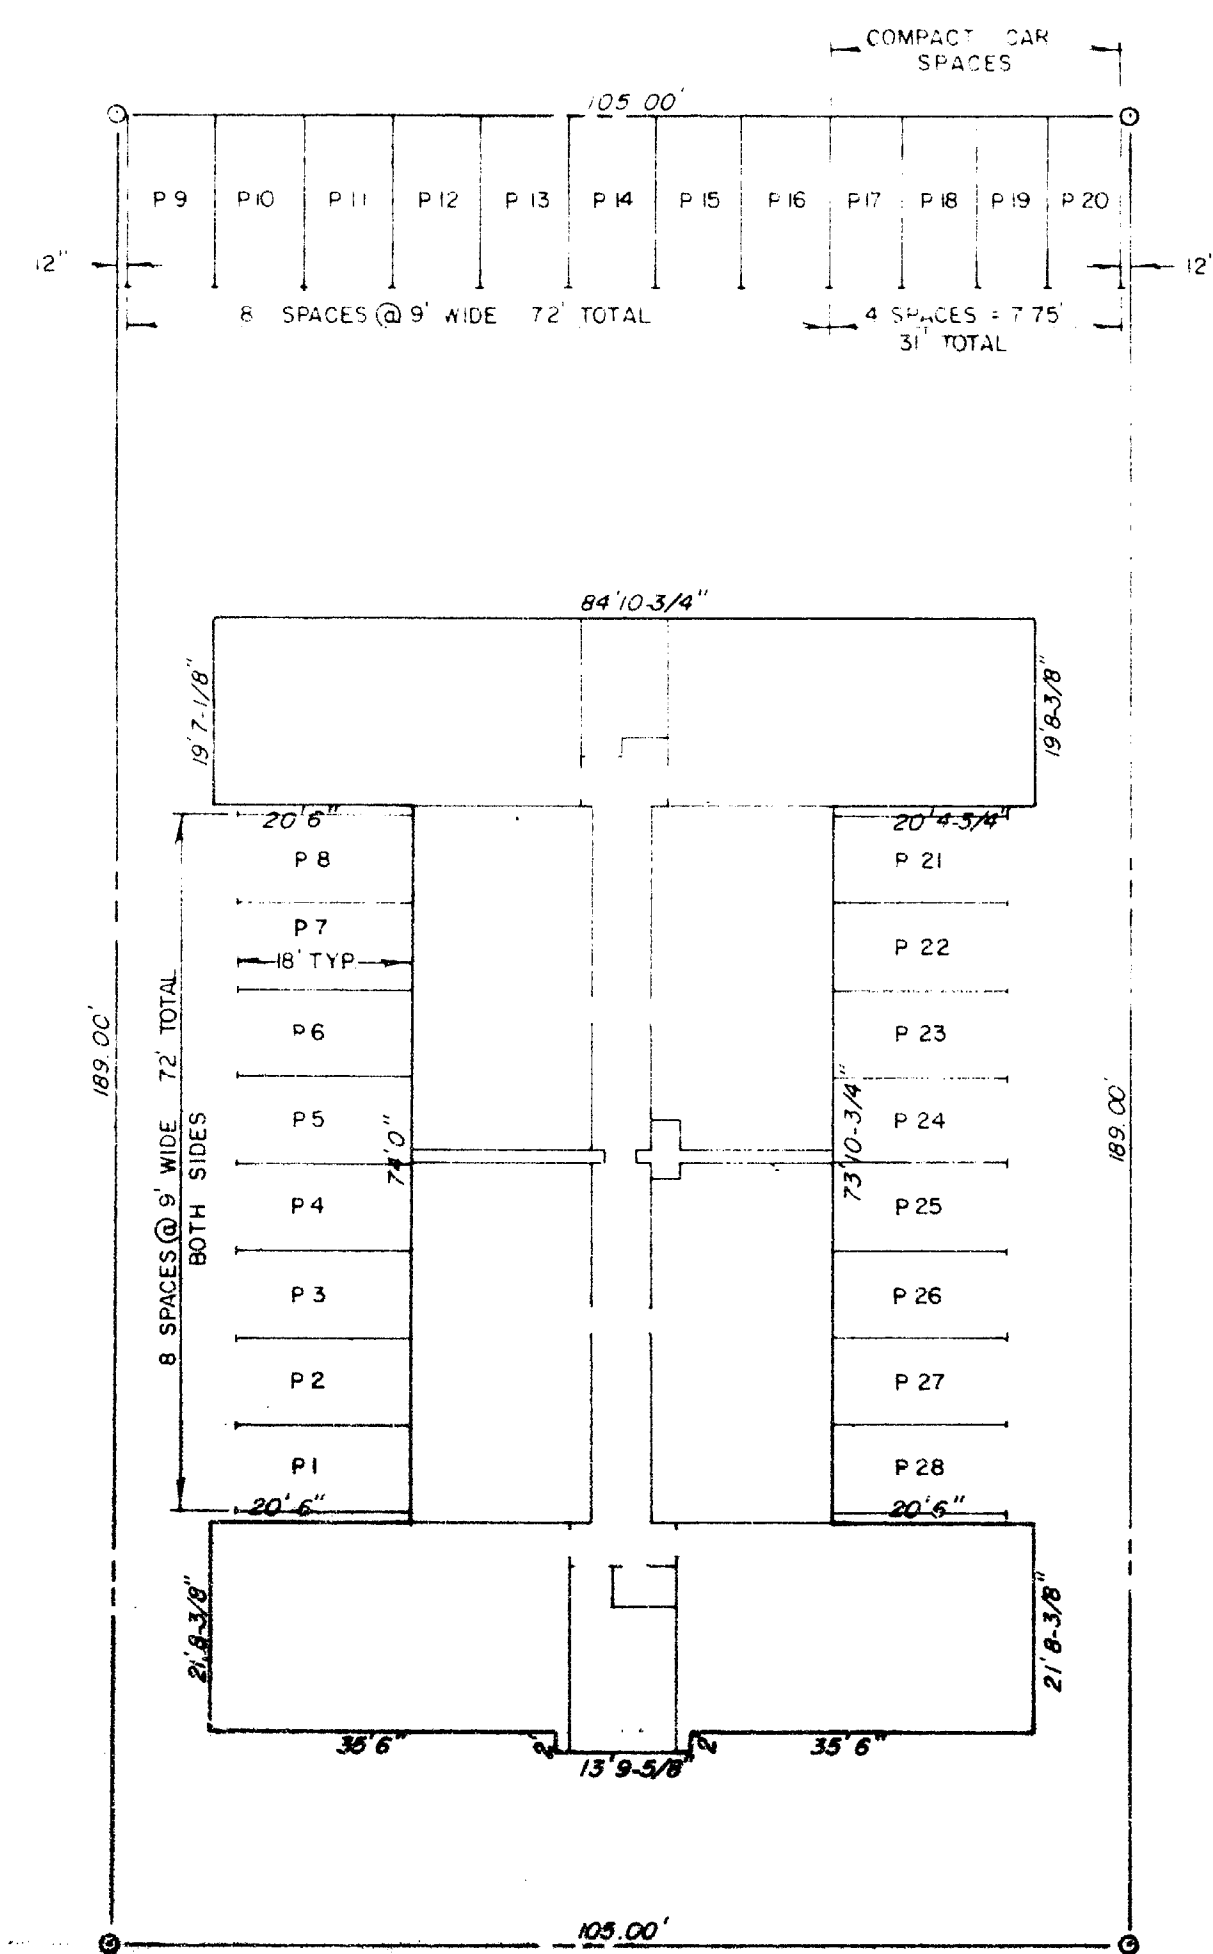

DWELLING UNIT	FLOOR ELEVATION	CEILING ELEVATION	SQUARE FOOTAGE	DIMENSIONS			UNIT STYLE
				X	Y	Z	
AA1	94.52	102.67	709 sf.	SEE DETAIL ABOVE			DUKE
A1	102.61	110.38	675 sf.	19'-13/8"	35'-13/4"	19'-3-3/8"	KENT
B1	111.51	119.31	674 sf.	19'-13/4"	35' 1"	19' 4"	
C1	120.43	128.21	700 sf.	19'-5-7/8"	35'-6-1/2"	19'-11-1/4"	
D1	129.34	137.18	700 sf.	19'-5-1/8"	35' 6"	19'-11-3/4"	
A2	102.61	110.38	673 sf.	19'-2-1/8"	34'-11-3/8"	19'-3-7/8"	KENT REV.
B2	111.51	119.31	673 sf.	19'-2-1/8"	34'-11-3/8"	19'-3-7/8"	
C2	120.43	128.31	701 sf.	19'-11-7/8"	35'-5-7/8"	19' 6"	
D2	129.34	137.18	701 sf.	20' 0"	35'-5-3/4"	19'-5-3/4"	
A3	102.61	110.38	639 sf.	17'-2-7/8"	37'-1-1/8"	17'-2-3/4"	CAMBRIDGE REV.
B3	111.51	119.31	646 sf.	17'-4-1/2"	37'-1-3/8"	17' 5"	
C3	120.43	128.31	657 sf.	17'-7-7/8"	37'-5-3/4"	17'-8-5/8"	
D3	129.34	137.18	660 sf.	17'-8-3/8"	37'-3-3/8"	17'-8-1/2"	
A4	102.61	110.38	639 sf.	17'-2-1/2"	37'-0-3/8"	17'-3-1/2"	CAMBRIDGE
B4	111.51	119.31	645 sf.	17'-4-1/2"	37'-0-7/8"	17' 5"	
C4	120.43	128.31	659 sf.	17'-8-1/4"	37' 3"	17'-8-1/8"	
D4	129.34	137.18	659 sf.	17'-8-1/4"	37' 3"	17'-8-1/8"	
A5	102.61	110.38	636 sf.	17'-3-3/8"	36'-11-3/8"	17'-1-7/8"	CAMBRIDGE
B5	111.51	119.31	636 sf.	17'-3-3/8"	36'-11-3/8"	17'-1-7/8"	
C5	120.43	128.31	659 sf.	17'-9-1/4"	37'-1-3/8"	17'-8-5/8"	
D5	129.34	137.18	659 sf.	17'-9-1/4"	37'-1-3/8"	17'-8-5/8"	
A6	102.61	110.38	639 sf.	17'-2-7/8"	37'-1-1/8"	17'-2-3/4"	CAMBRIDGE REV.
B6	111.51	119.31	646 sf.	17'-4-1/2"	37'-1-3/8"	17' 5"	
C6	120.43	128.31	657 sf.	17'-8-5/8"	37'-0-7/8"	17'-8-3/4"	
D6	129.34	137.18	660 sf.	17'-8-3/8"	37'-3-3/8"	17'-8-1/2"	
A7	102.61	110.38	629 sf.	17'-2-5/8"	36'-5-1/4"	17'-3-3/8"	OXFORD
B7	111.51	119.31	633 sf.	17'-3-5/8"	36'-7-3/8"	17'-3-5/8"	
C7	120.43	128.31	658 sf.	17'-7-3/8"	37' 0"	17'-11-3/8"	
D7	129.34	137.18	658 sf.	17'-7-3/8"	37' 0"	17'-11-3/8"	
A8	102.61	110.38	630 sf.	17'-4-3/4"	36' 4"	17'-5-5/8"	OXFORD REV.
B8	111.51	119.31	632 sf.	17'-4-1/8"	36'-5-3/4"	17' 4"	
C8	120.43	128.31	658 sf.	18'-0-5/8"	36'-10-1/8"	17'-8-3/8"	
D8	129.34	137.18	658 sf.	18'-0-5/8"	36'-10-1/8"	17'-8-3/8"	

- NOTES**
1. DWELLING UNITS (DU) ARE DESIGNATED BY LETTER & NUMBER.
 2. THE BOUNDARIES OF EACH DWELLING UNIT ARE THE INTERIOR SURFACES OF CEILINGS, FLOORS, WINDOWS, DOORS & PERIMETER WALLS THEREOF, AS SHOWN HEREON. THE RELATIVE ELEVATIONS OF THE INTERIOR SURFACE OF THE CEILINGS ARE SHOWN ON DWELLING UNIT SCHEDULE.
 3. ALL PROPERTY SHOWN ON SHEETS 1-7 NOT LOCATED WITHIN ANY LIVING UNIT IS PART OF THE COMMON AREA OR LIMITED COMMON AREA.
 4. THE LOCATION OF THE UNITS SHOWN ON THIS MAP ARE FIELD LOCATED.
 5. ASTERISKED DIMENSIONS ARE BASED ON MEASUREMENTS ACTUALLY TAKEN IN SIMILAR UNITS BUT NOT TAKEN IN THIS PARTICULAR UNIT.
 6. INTERIOR PARTITION LOCATIONS ARE APPROXIMATE ONLY AND ARE SUBJECT TO VARIATIONS.

DETAILS
SURVEYS AND PLANS
FOR
BANCROFT CONDOMINIUM
SHEET 1 OF 7

dean e philips associates
consulting engineers
portland, conn

DATE: 08-06-81
SCALE: AS SHOWN
DR. BY: RCH
FILE: 396.01.01



87

RECEIVED BY
FEB 5 1982
HARTFORD
PAGE 10

0 INCHES 1 2 3 4