49-2

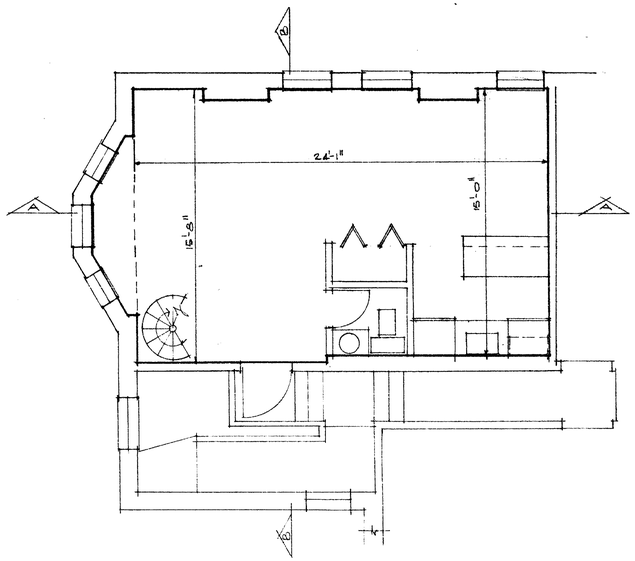

LOWER LEVEL PLAN (SECOND FLOOR)

SCALE = 1/4" = 1'-0"

UNIT SQUARE FOOTAGE:

LOWER LEVEL - 386 SQ.FT.
UPPER LEVEL - 329 SQ.FT.
TOTAL = 715 SQ.FT. ±

GENERAL NOTES:

1. THE WALL THICKNESS FROM EXTERIOR TO INTERIOR FINISH APPEARS TO BE 15" ON AVERAGE.
2. THE INTERIOR PARTITIONS SHOWN ARE APPROXIMATE.

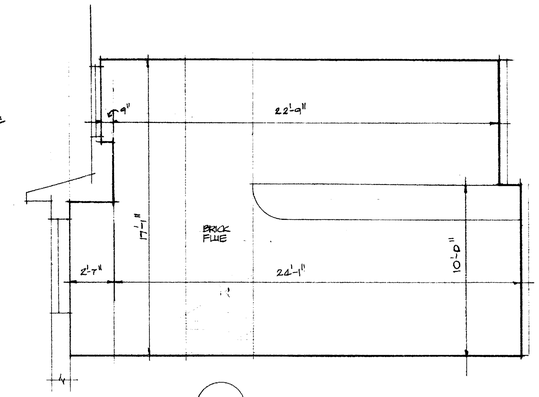

SECTION A-A

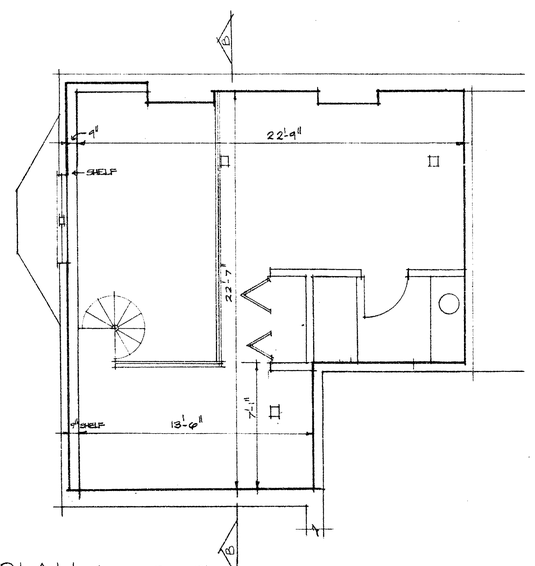

UPPER LEVEL PLAN (ATTIC FLOOR)

SCALE = 1/4" = 1'-0"

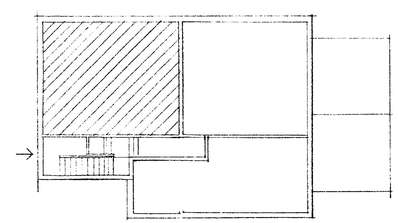

KEY PLAN (2ND FLOOR) SEE LOWER LEVEL THIS SHT

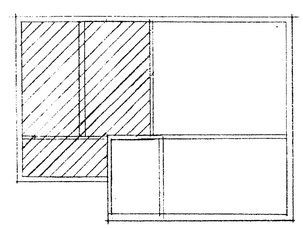

KEY PLAN (ATTIC FLOOR) SEE UPPER LEVEL THIS SHT.

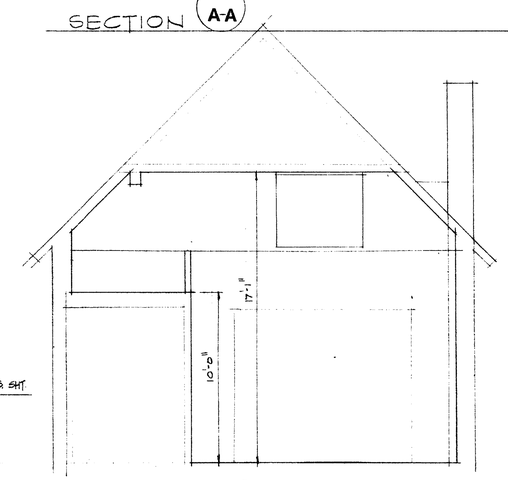

SECTION B-B

DATE: 11-1-80
10/80
SCALE: 1/4"=1'-0"
JOB NO 11-80-1

UNIT PLANS AND SECTIONS NO 2

hungerford court condos
89 HUNGERFORD STREET, HARTFORD CT.
GINO A MISCIAGNA - developer

Condo Z Con Plan #49

EAST FILE COMP. IRVINE CA. 49 EF-14

RECEIVED BY
TOWN & CITY CLERK
HARTFORD
VOL. ____ PAGE ____