
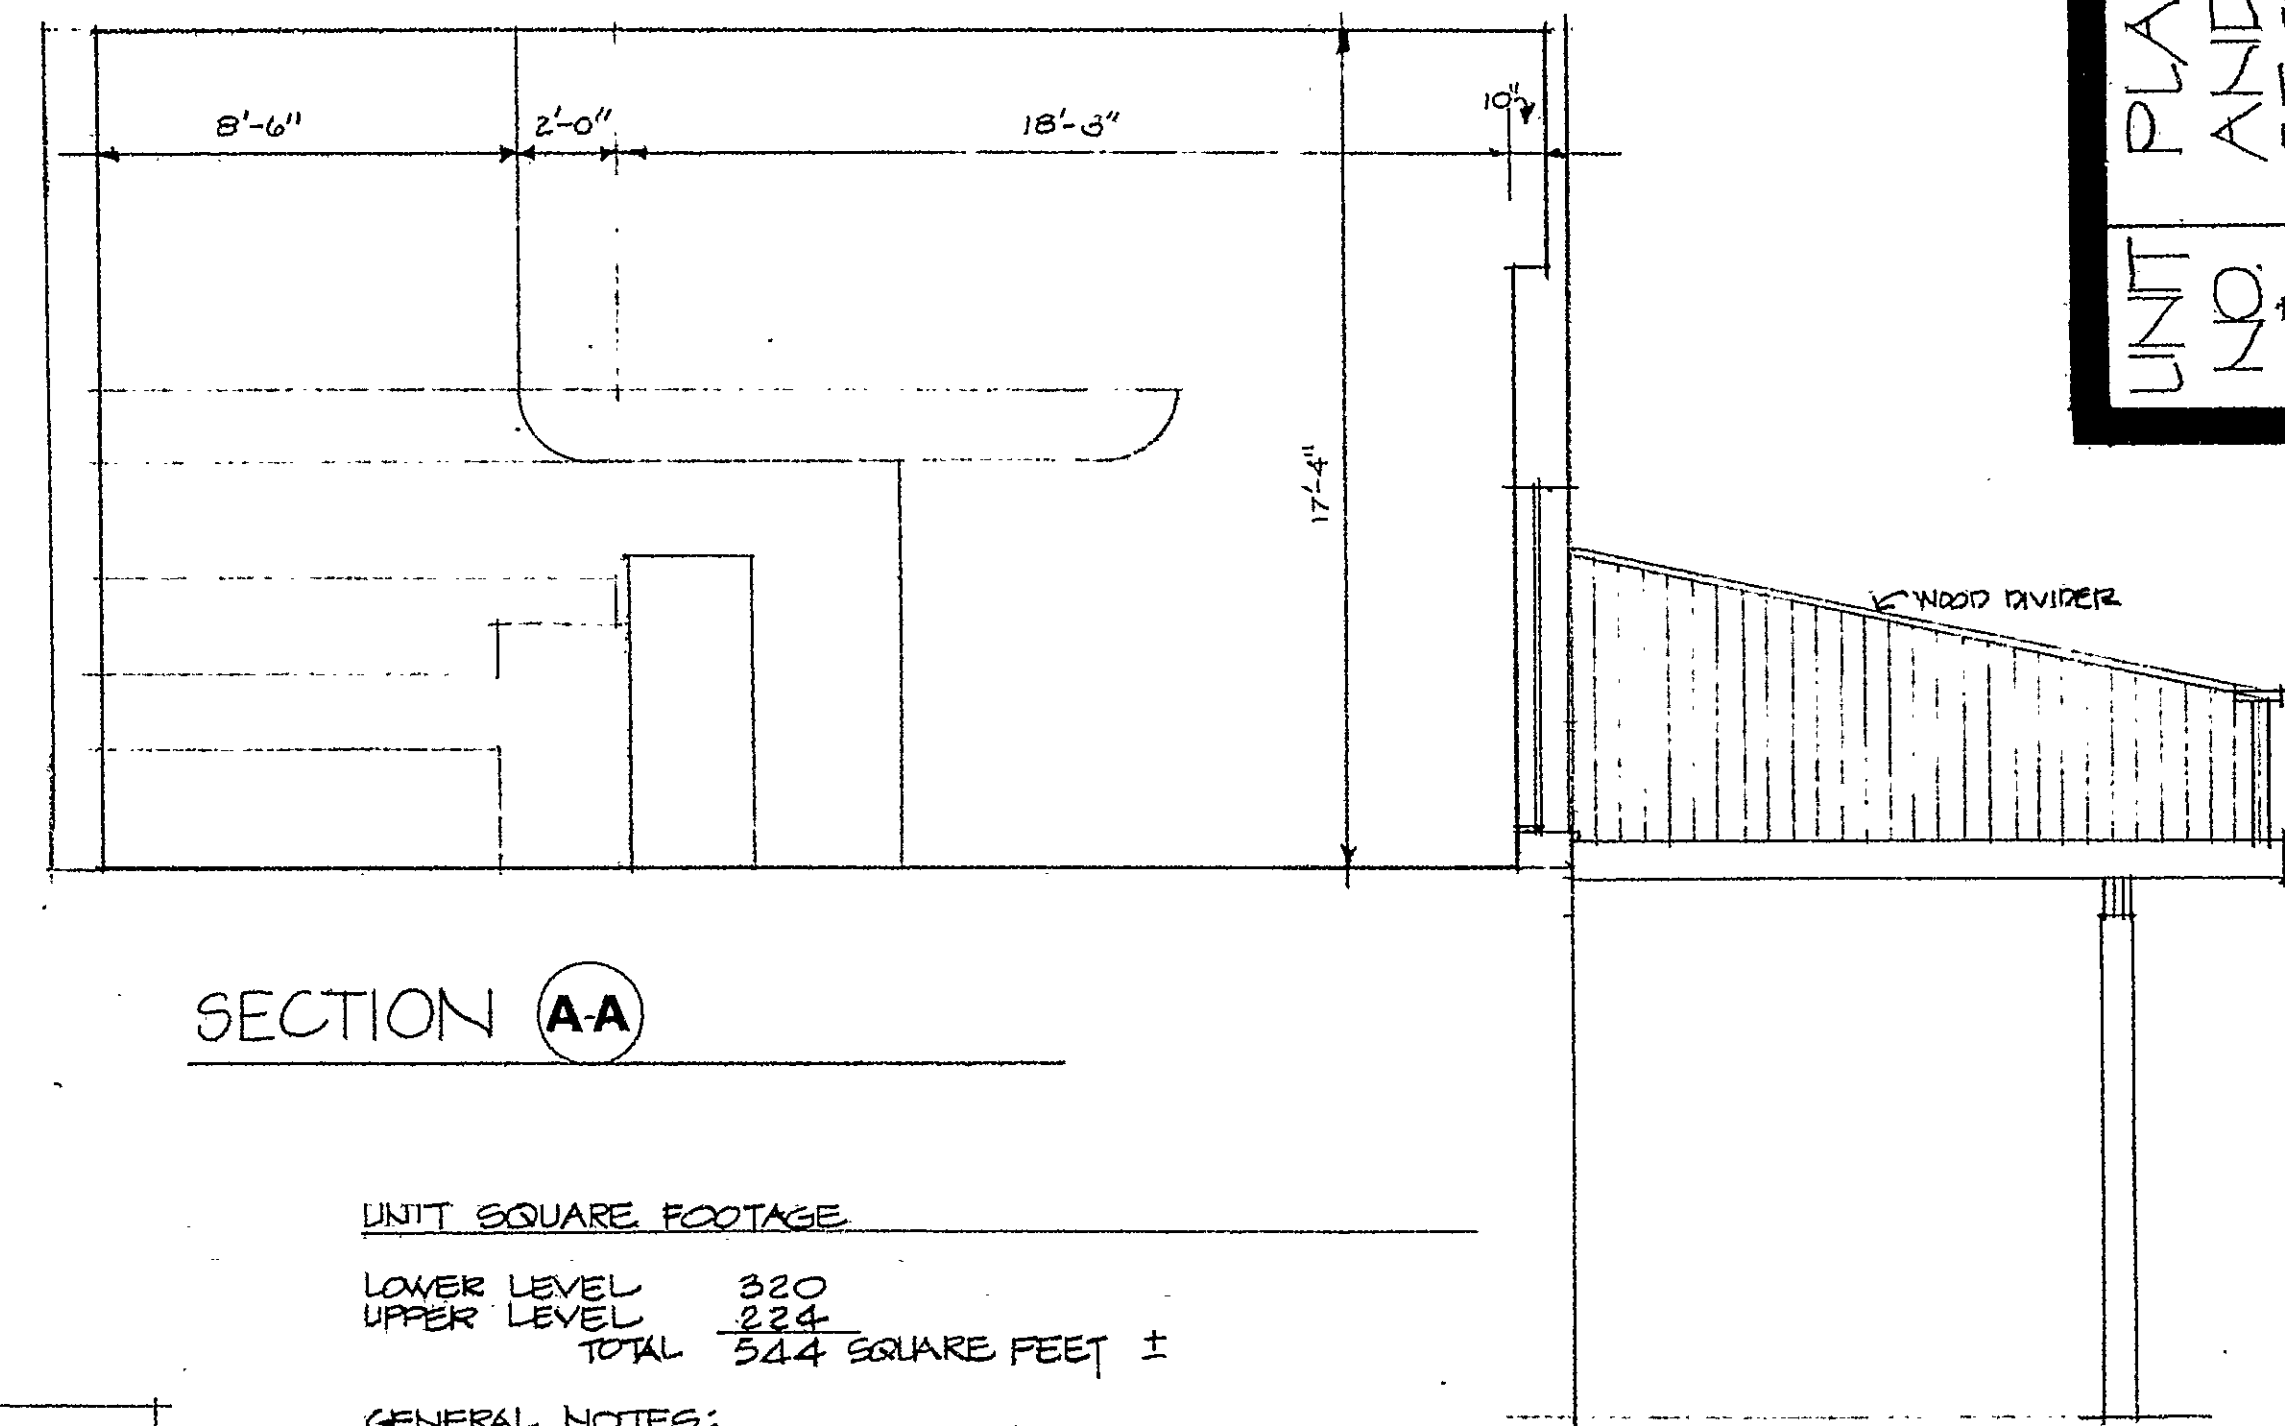


DATE: 11-30
10/780
SCALE:
1/4"=1'-0"
JOB NO.
17827

PLANS
AND
SECTIONS
UNIT
4




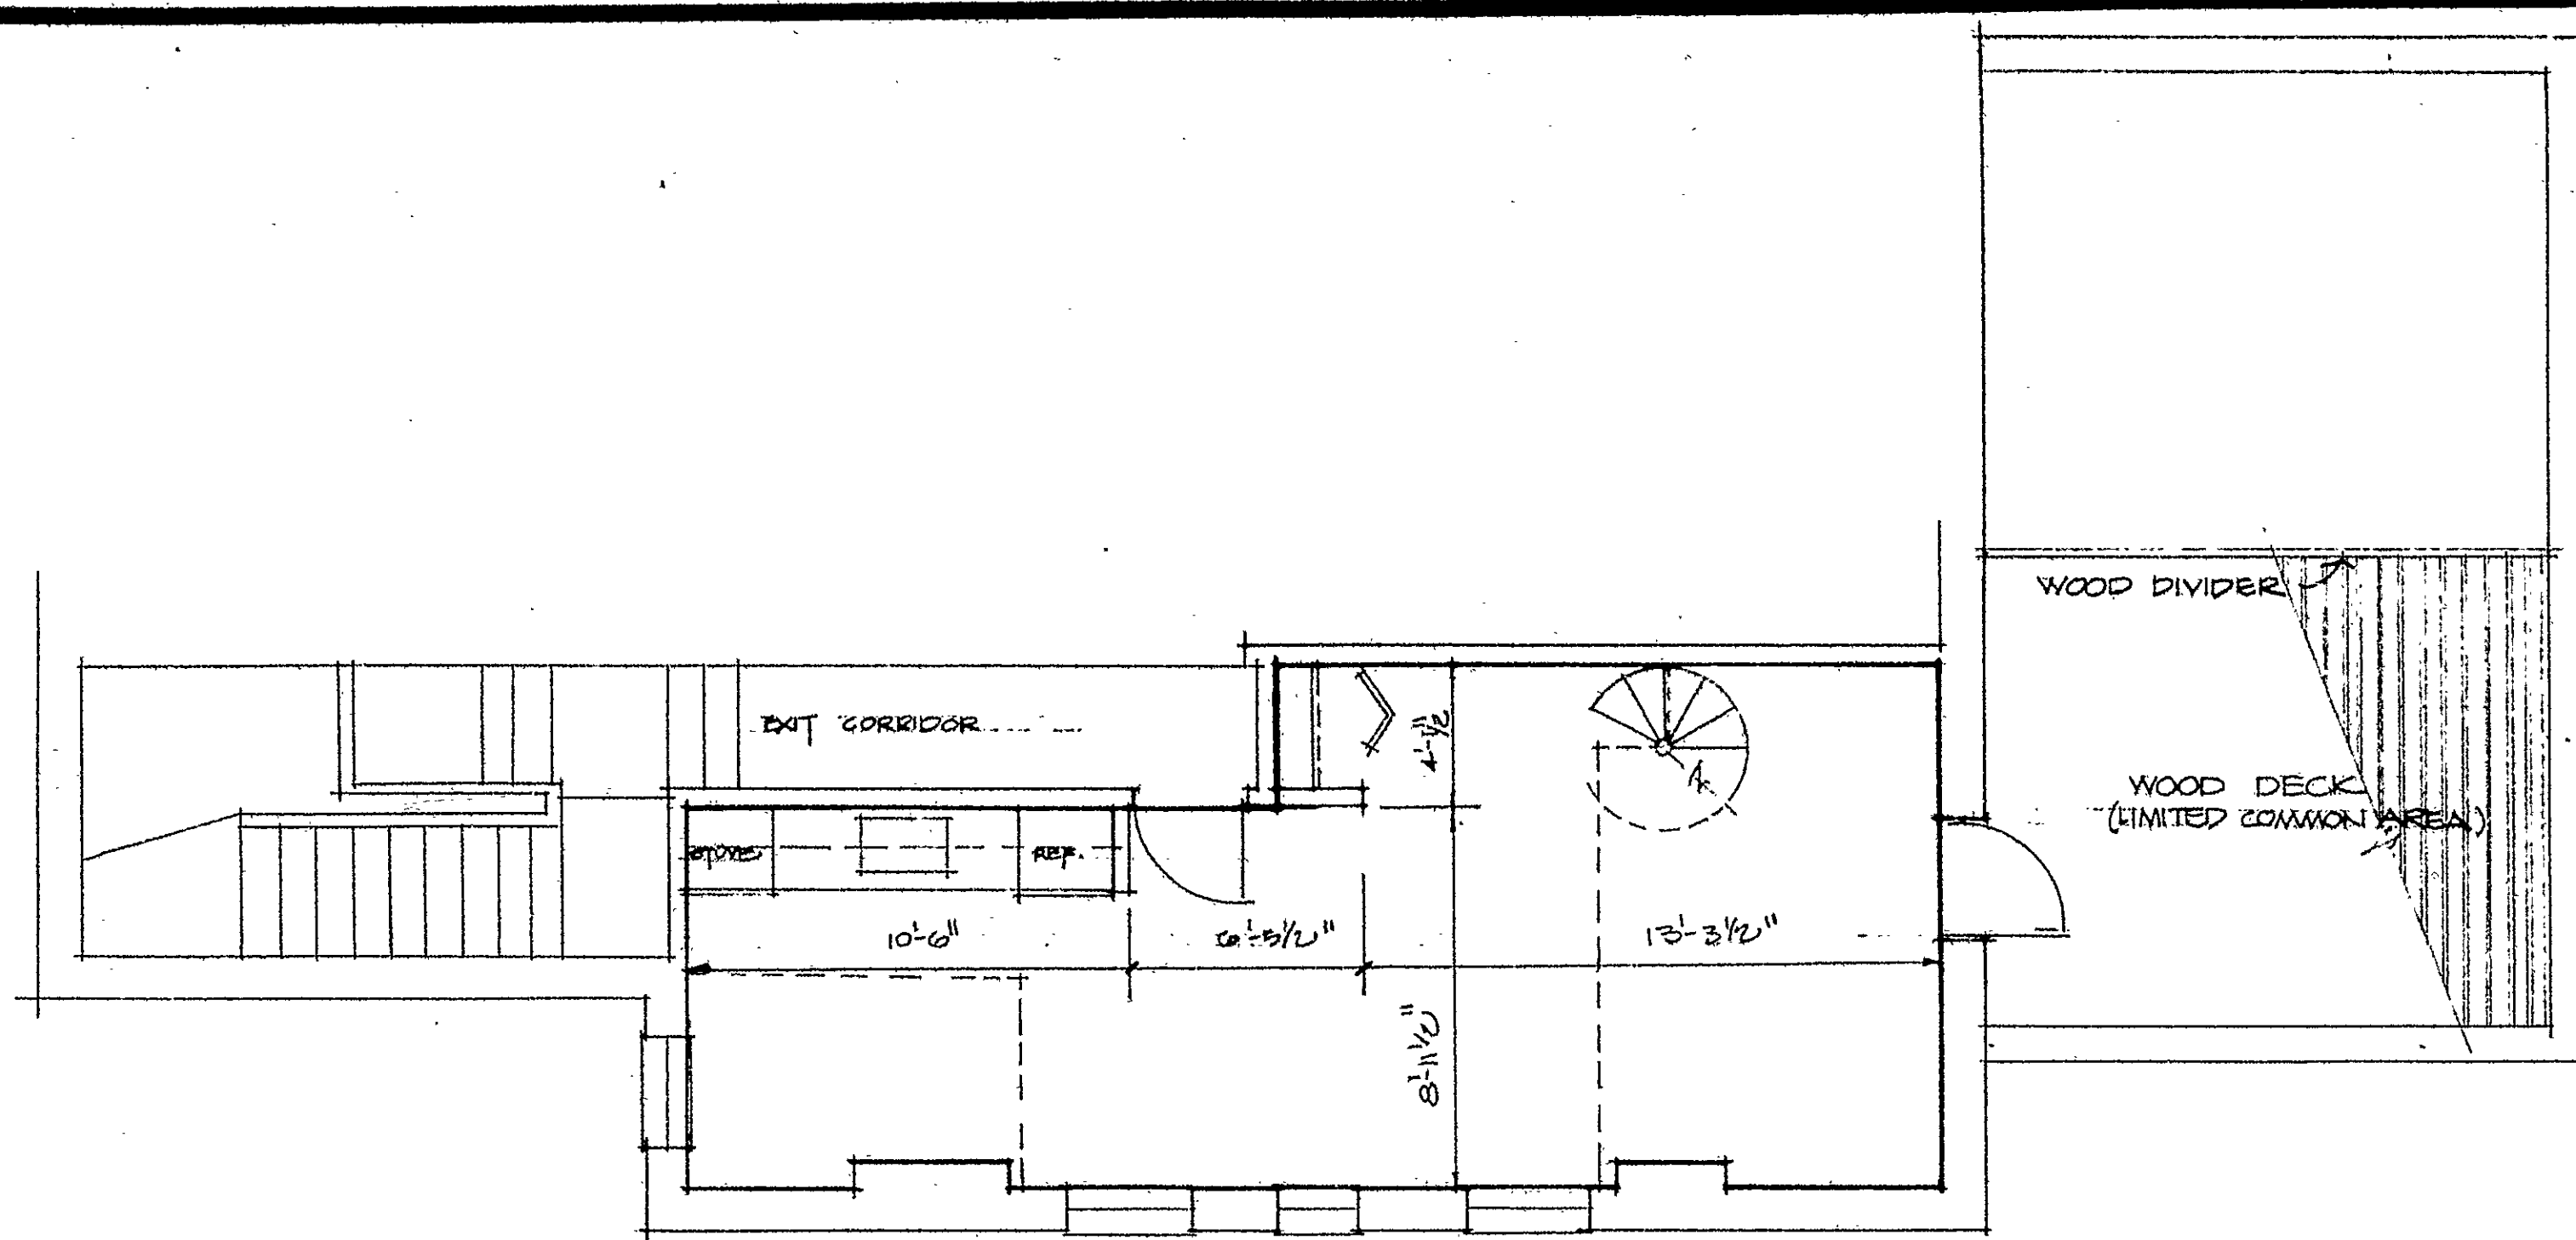


UNIT SQUARE FOOTAGE

LOWER LEVEL 320
UPPER LEVEL 224
TOTAL 544 SQUARE FEET ±

GENERAL NOTES:

1. THE WALL THICKNESS FROM EXTERIOR TO INTERIOR FINISH APPEARS TO BE 16" ON AVERAGE.
2. THE INTERIOR PARTITIONS SHOWN ARE APPROXIMATE.

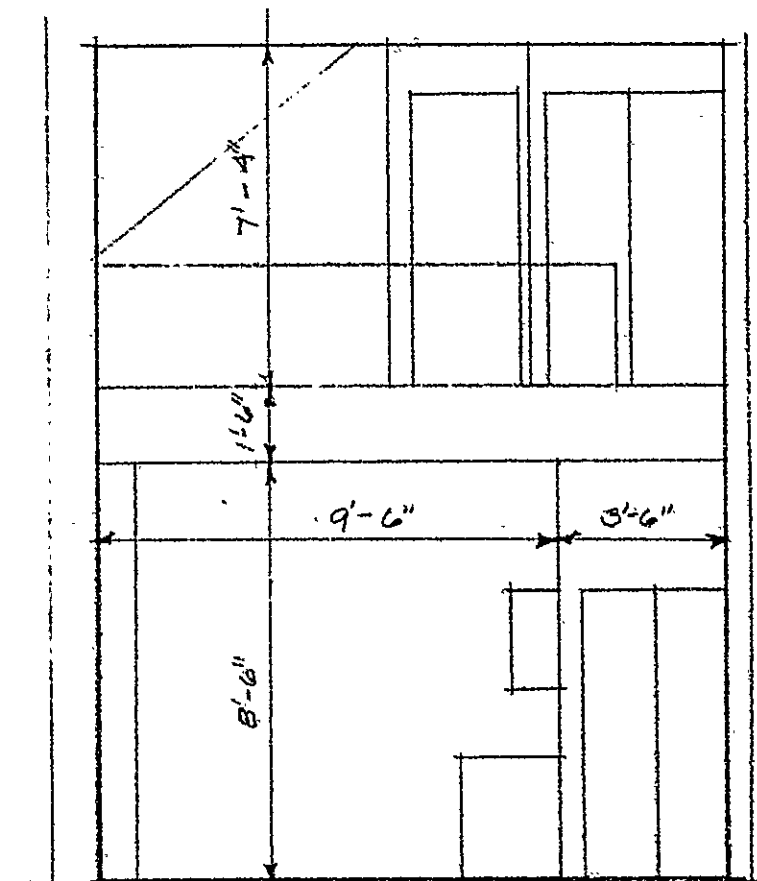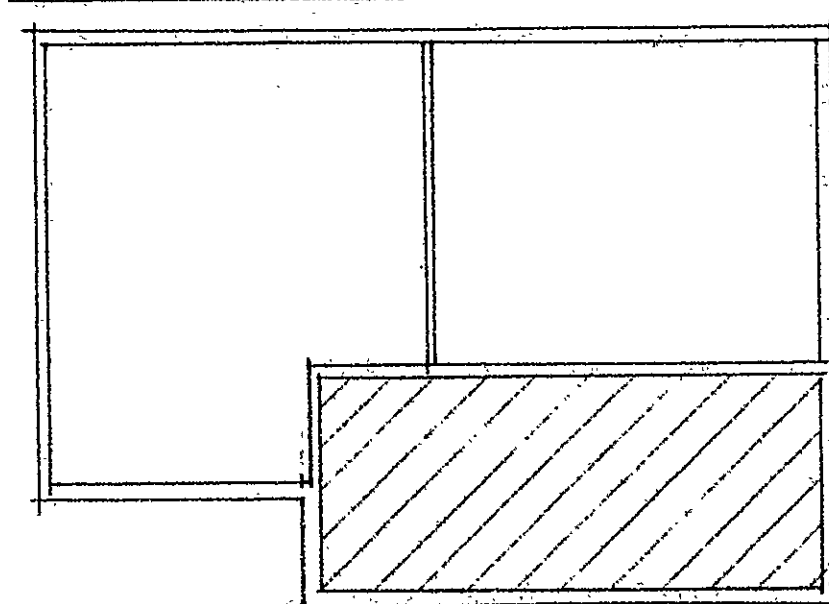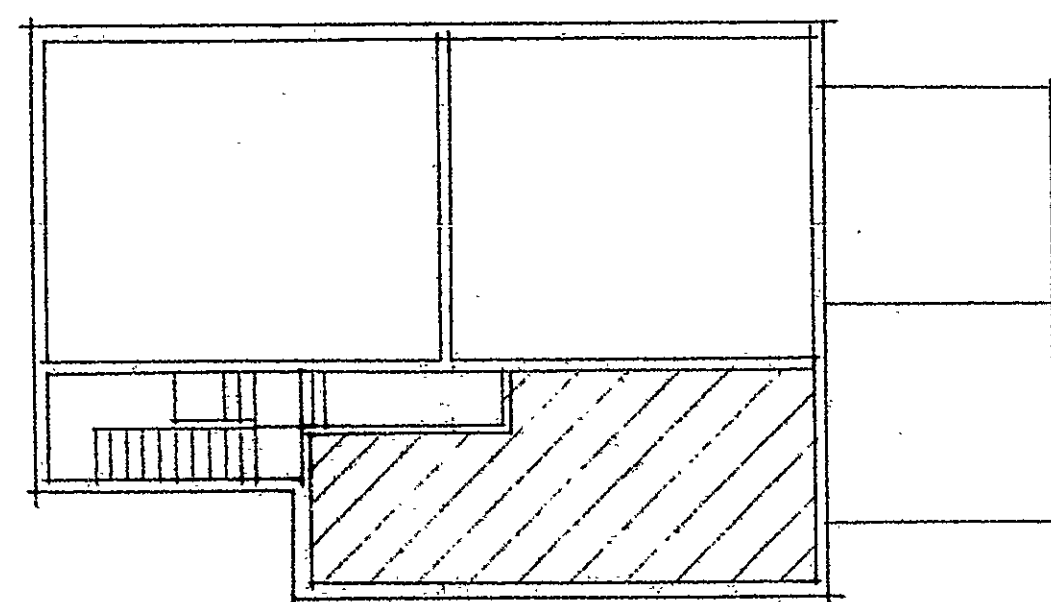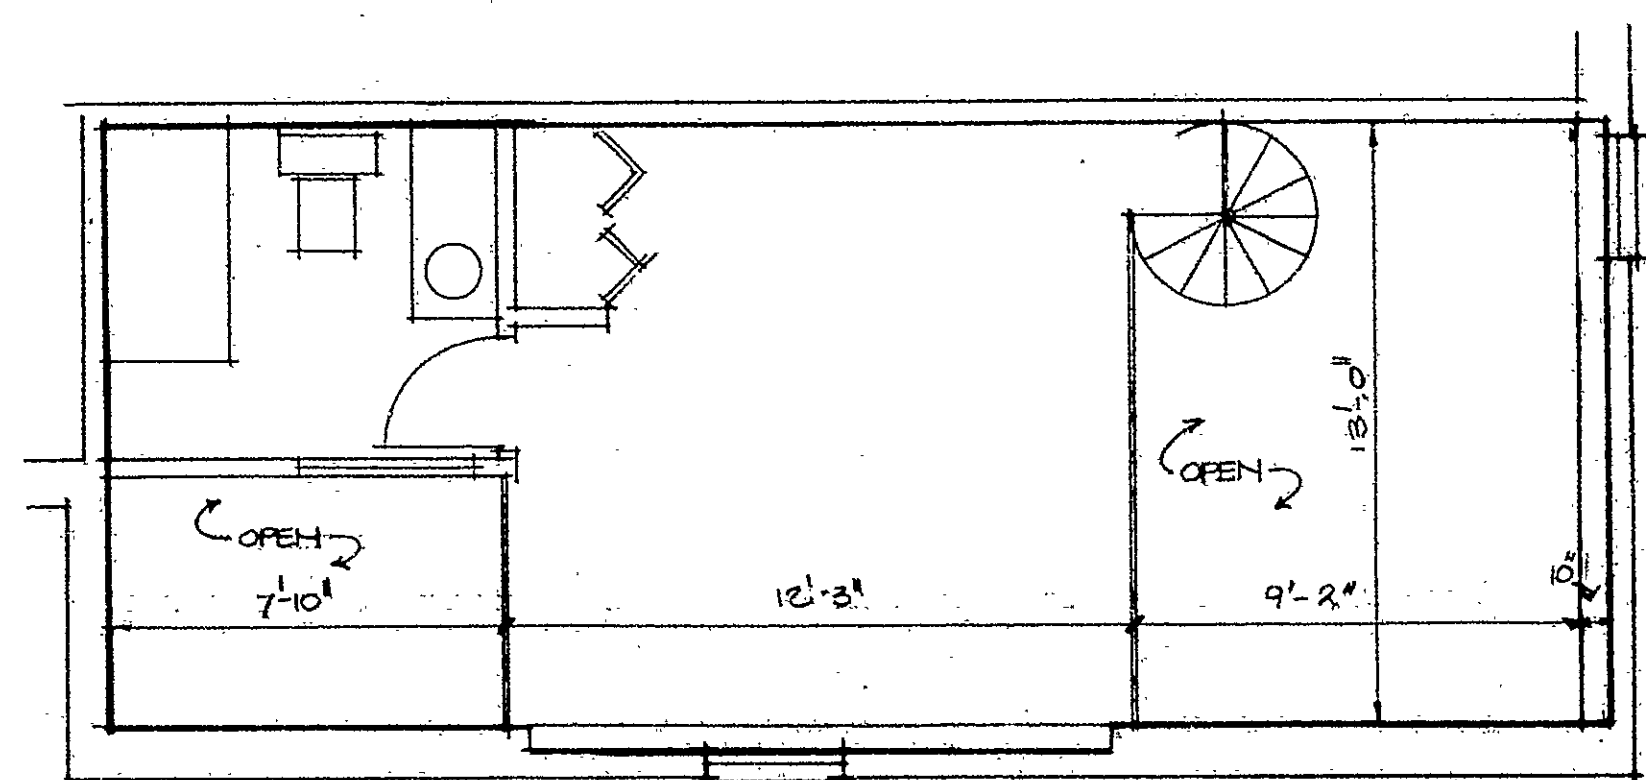

hungerford
court condos
39 HUNGERFORD ST. HARTFORD CT.
GINO A. MISCAGNA-developer

Condo Floor Plan # 49

bh