




dean e. phillips associates
consulting engineers
portland, conn.

REV.	11-03-81
DATE	08-28-81
SCALE	AS SHOWN
DR. BY	R.C.H.
FILE	375.01.02

SURVEYS AND PLANS
FOR
SUMNERWOOD

47 SUMNER STREET

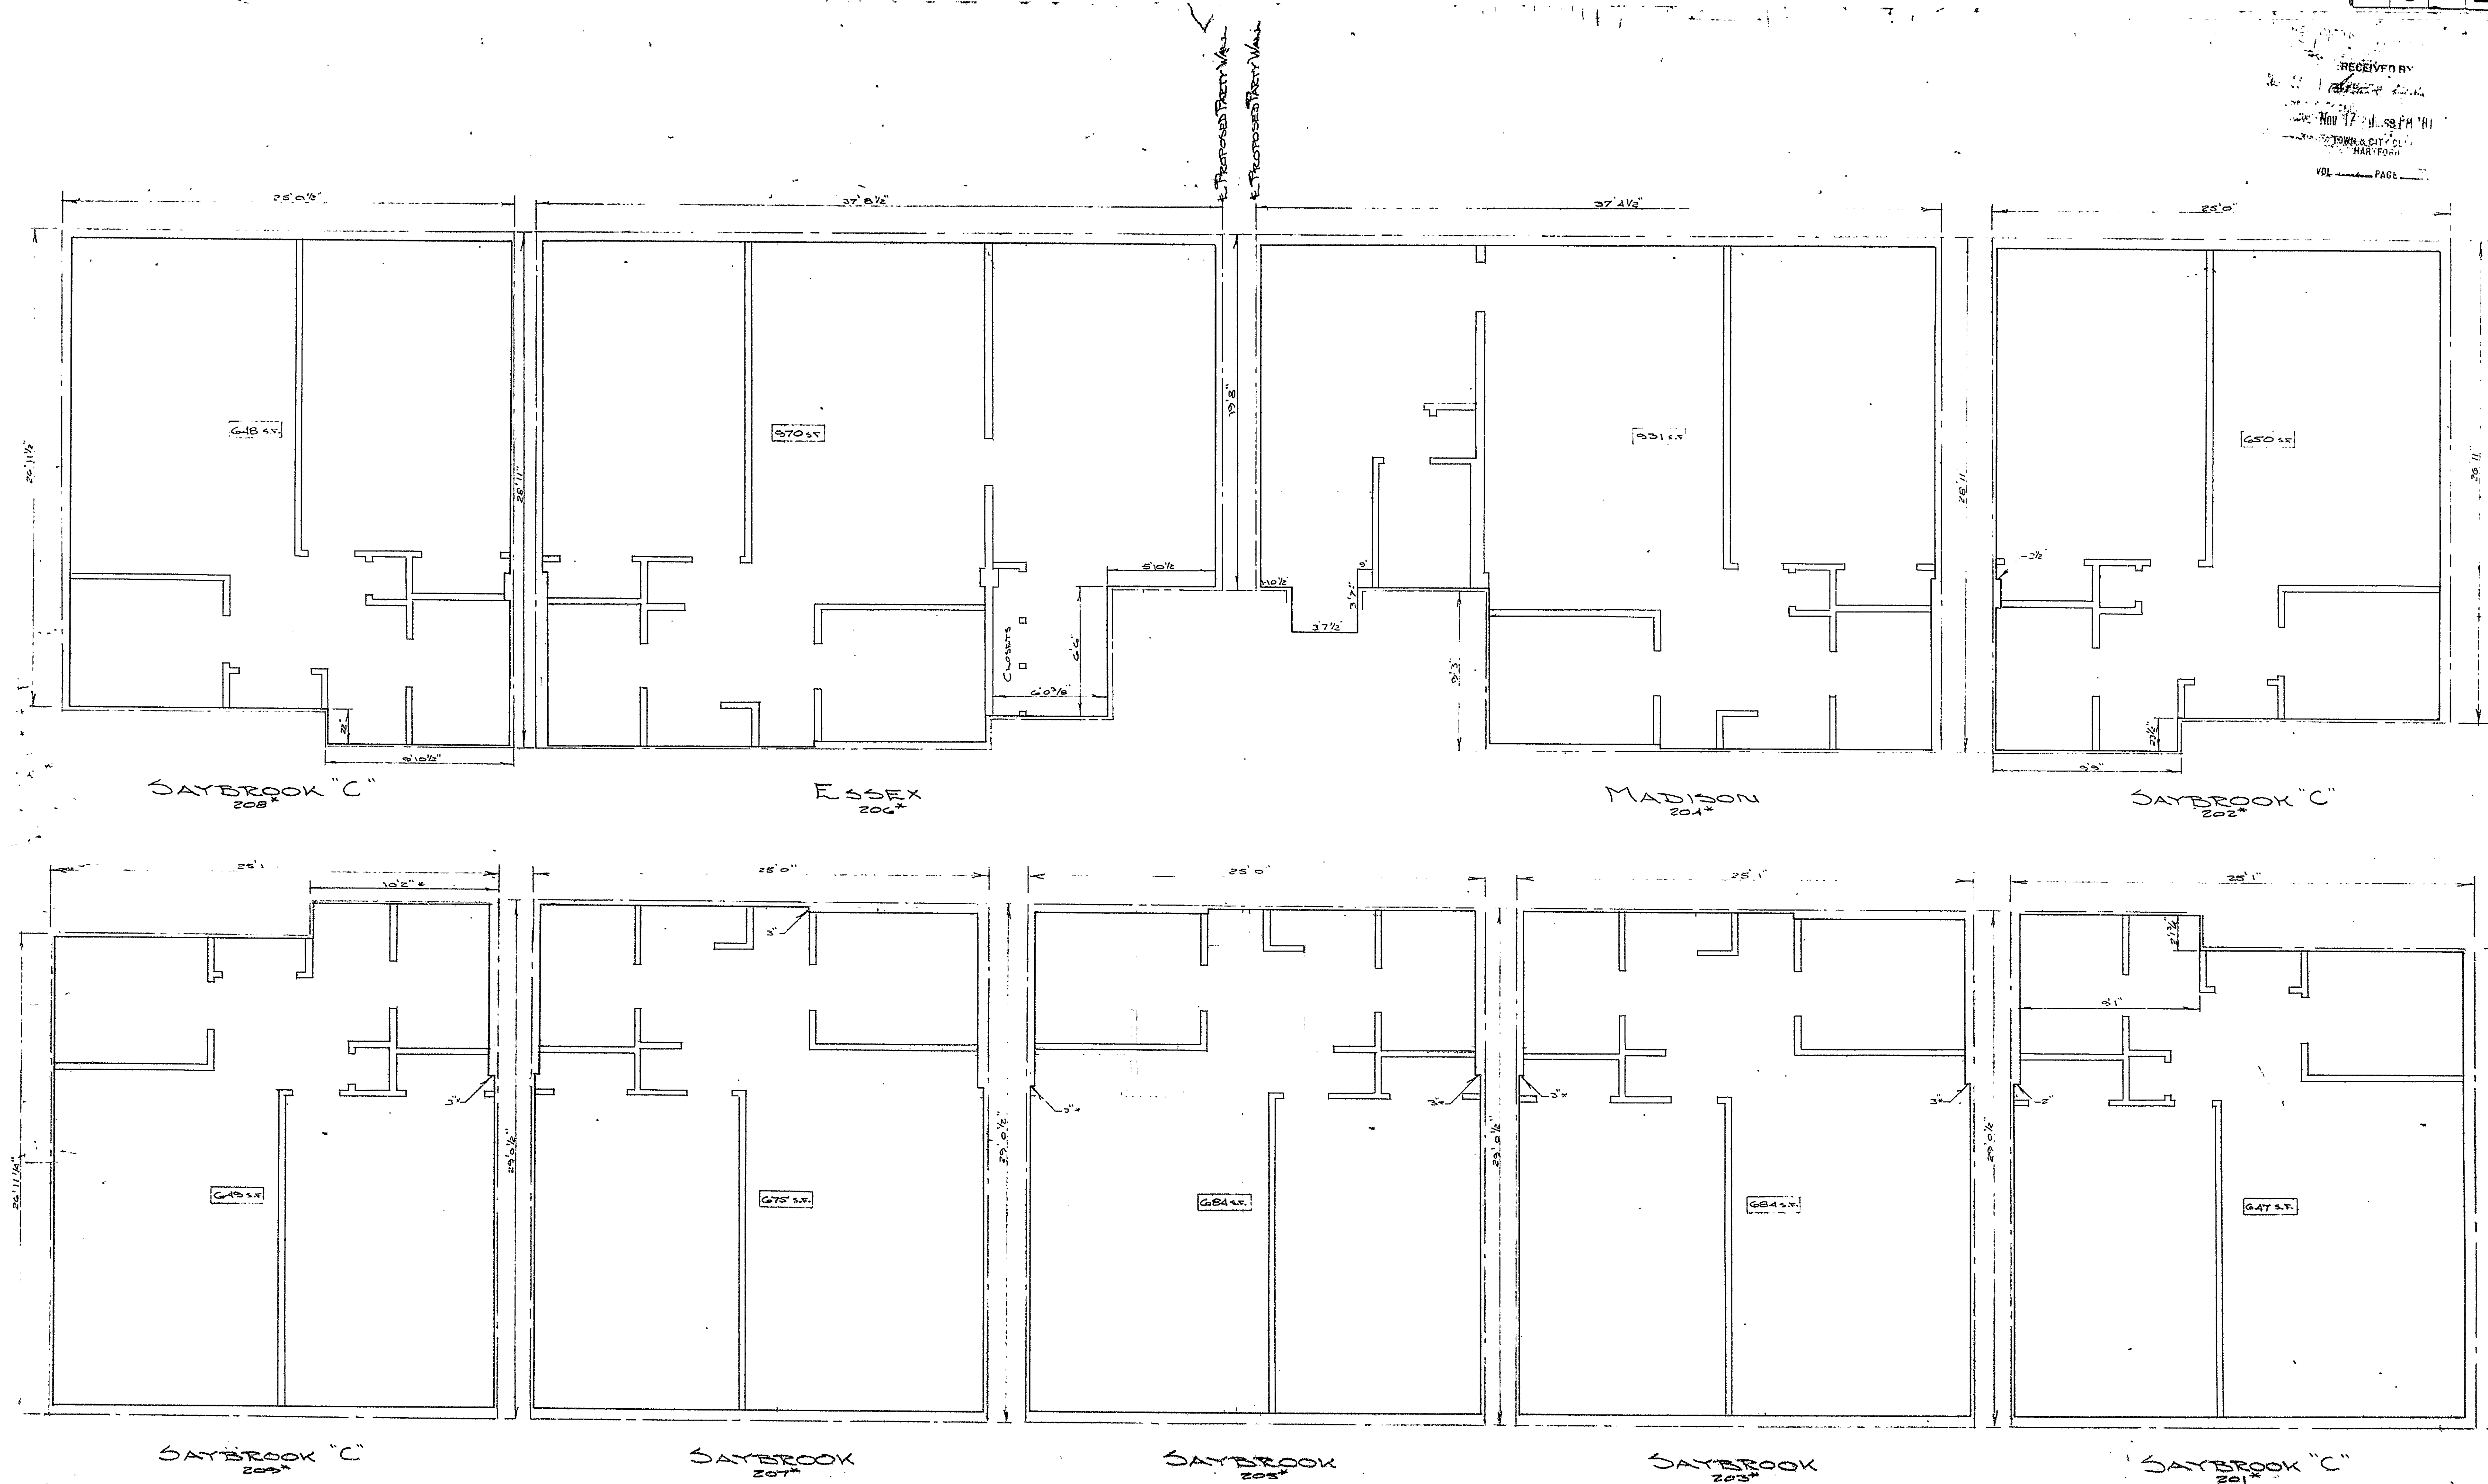

- NOTES
1. ALL OVERALL DIMENSIONS ARE MEASURED TO APPROXIMATE CENTER OF WALLS.
 2. ASTERISKED DIMENSIONS ARE BASED ON MEASUREMENTS ACTUALLY TAKEN IN SIMILAR UNITS BUT NOT TAKEN IN THIS PARTICULAR UNIT.
 3. INTERIOR PARTITION LOCATIONS ARE APPROXIMATE ONLY AND ARE SUBJECT TO VARIATIONS.

I HEREBY CERTIFY THAT THESE PLANS RELATIVE TO THIS CONDOMINIUM, FILED WITH THE HARTFORD CITY CLERK, ARE AN ACCURATE COPY OF PLANS ON FILE WITH THE HARTFORD BUILDING DEPARTMENT.

Dean E. Phillips
DEAN E. PHILLIPS, REG. PROF. ENGR., CT No 7881