


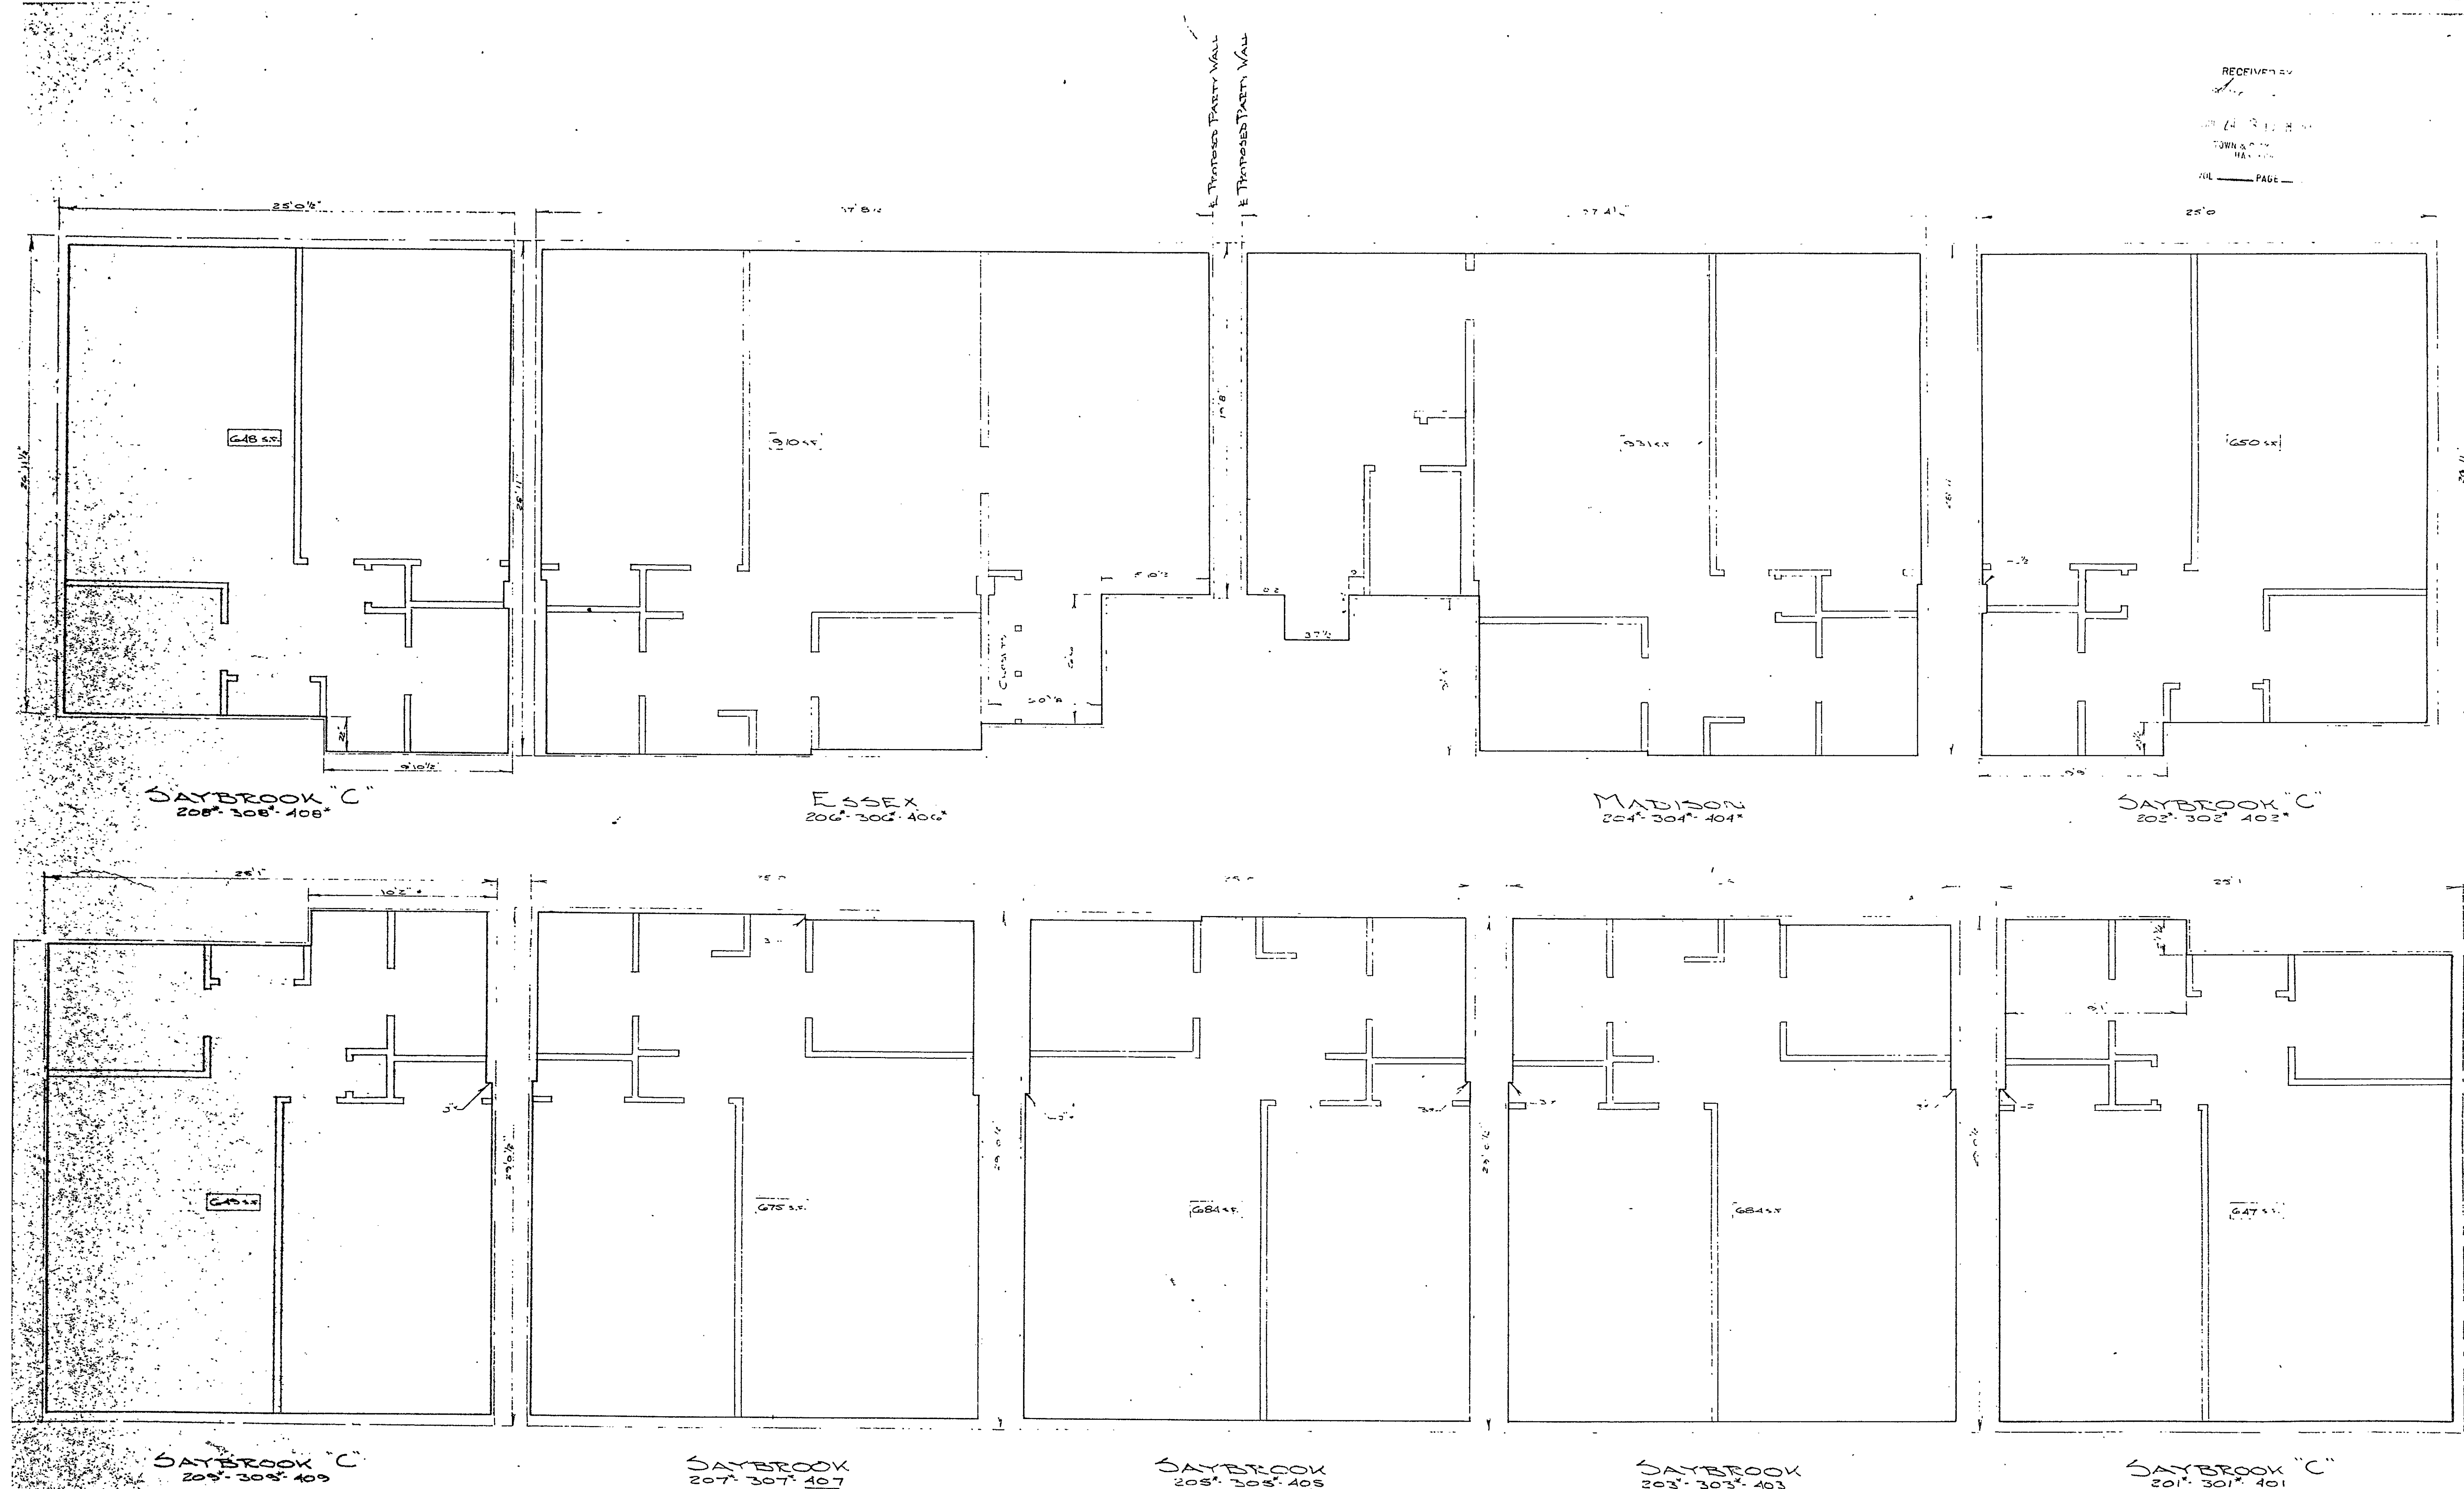

- NOTES
1. ALL OVERALL DIMENSIONS ARE MEASURED TO APPROXIMATE CENTER OF WALLS.
 2. ALL DIMENSIONS ARE BASED ON MEASUREMENTS ACTUALLY TAKEN IN SITU AND NOT TAKEN IN THE FIELD OR UNIT.
 3. INTERIOR PARTITION LOCATIONS ARE APPROXIMATE ONLY AND ARE SUBJECT TO VARIATIONS.

I HEREBY CERTIFY THAT THESE PLANS RELATIVE TO THIS CONDOMINIUM, FILED WITH THE HARTFORD CITY CLERK, ARE AN ACCURATE COPY OF PLANS ON FILE WITH THE HARTFORD BUILDING DEPARTMENT.

Dean E. Phillips
 DEAN E. PHILLIPS, REG. PROFESSIONAL ENGINEER, CT No. 7331

Scale 1/8" = 1'-0"

dean e. phillips associates consulting engineers portland, conn.	
DATE 05-28-81	SCALE AS SHOWN
DR. BY R.C.H.	FILE 375.01.01
SURVEYS AND PLANS FOR SUMNERWOOD HARTFORD, CONN.	
47 SUMNER STREET	