


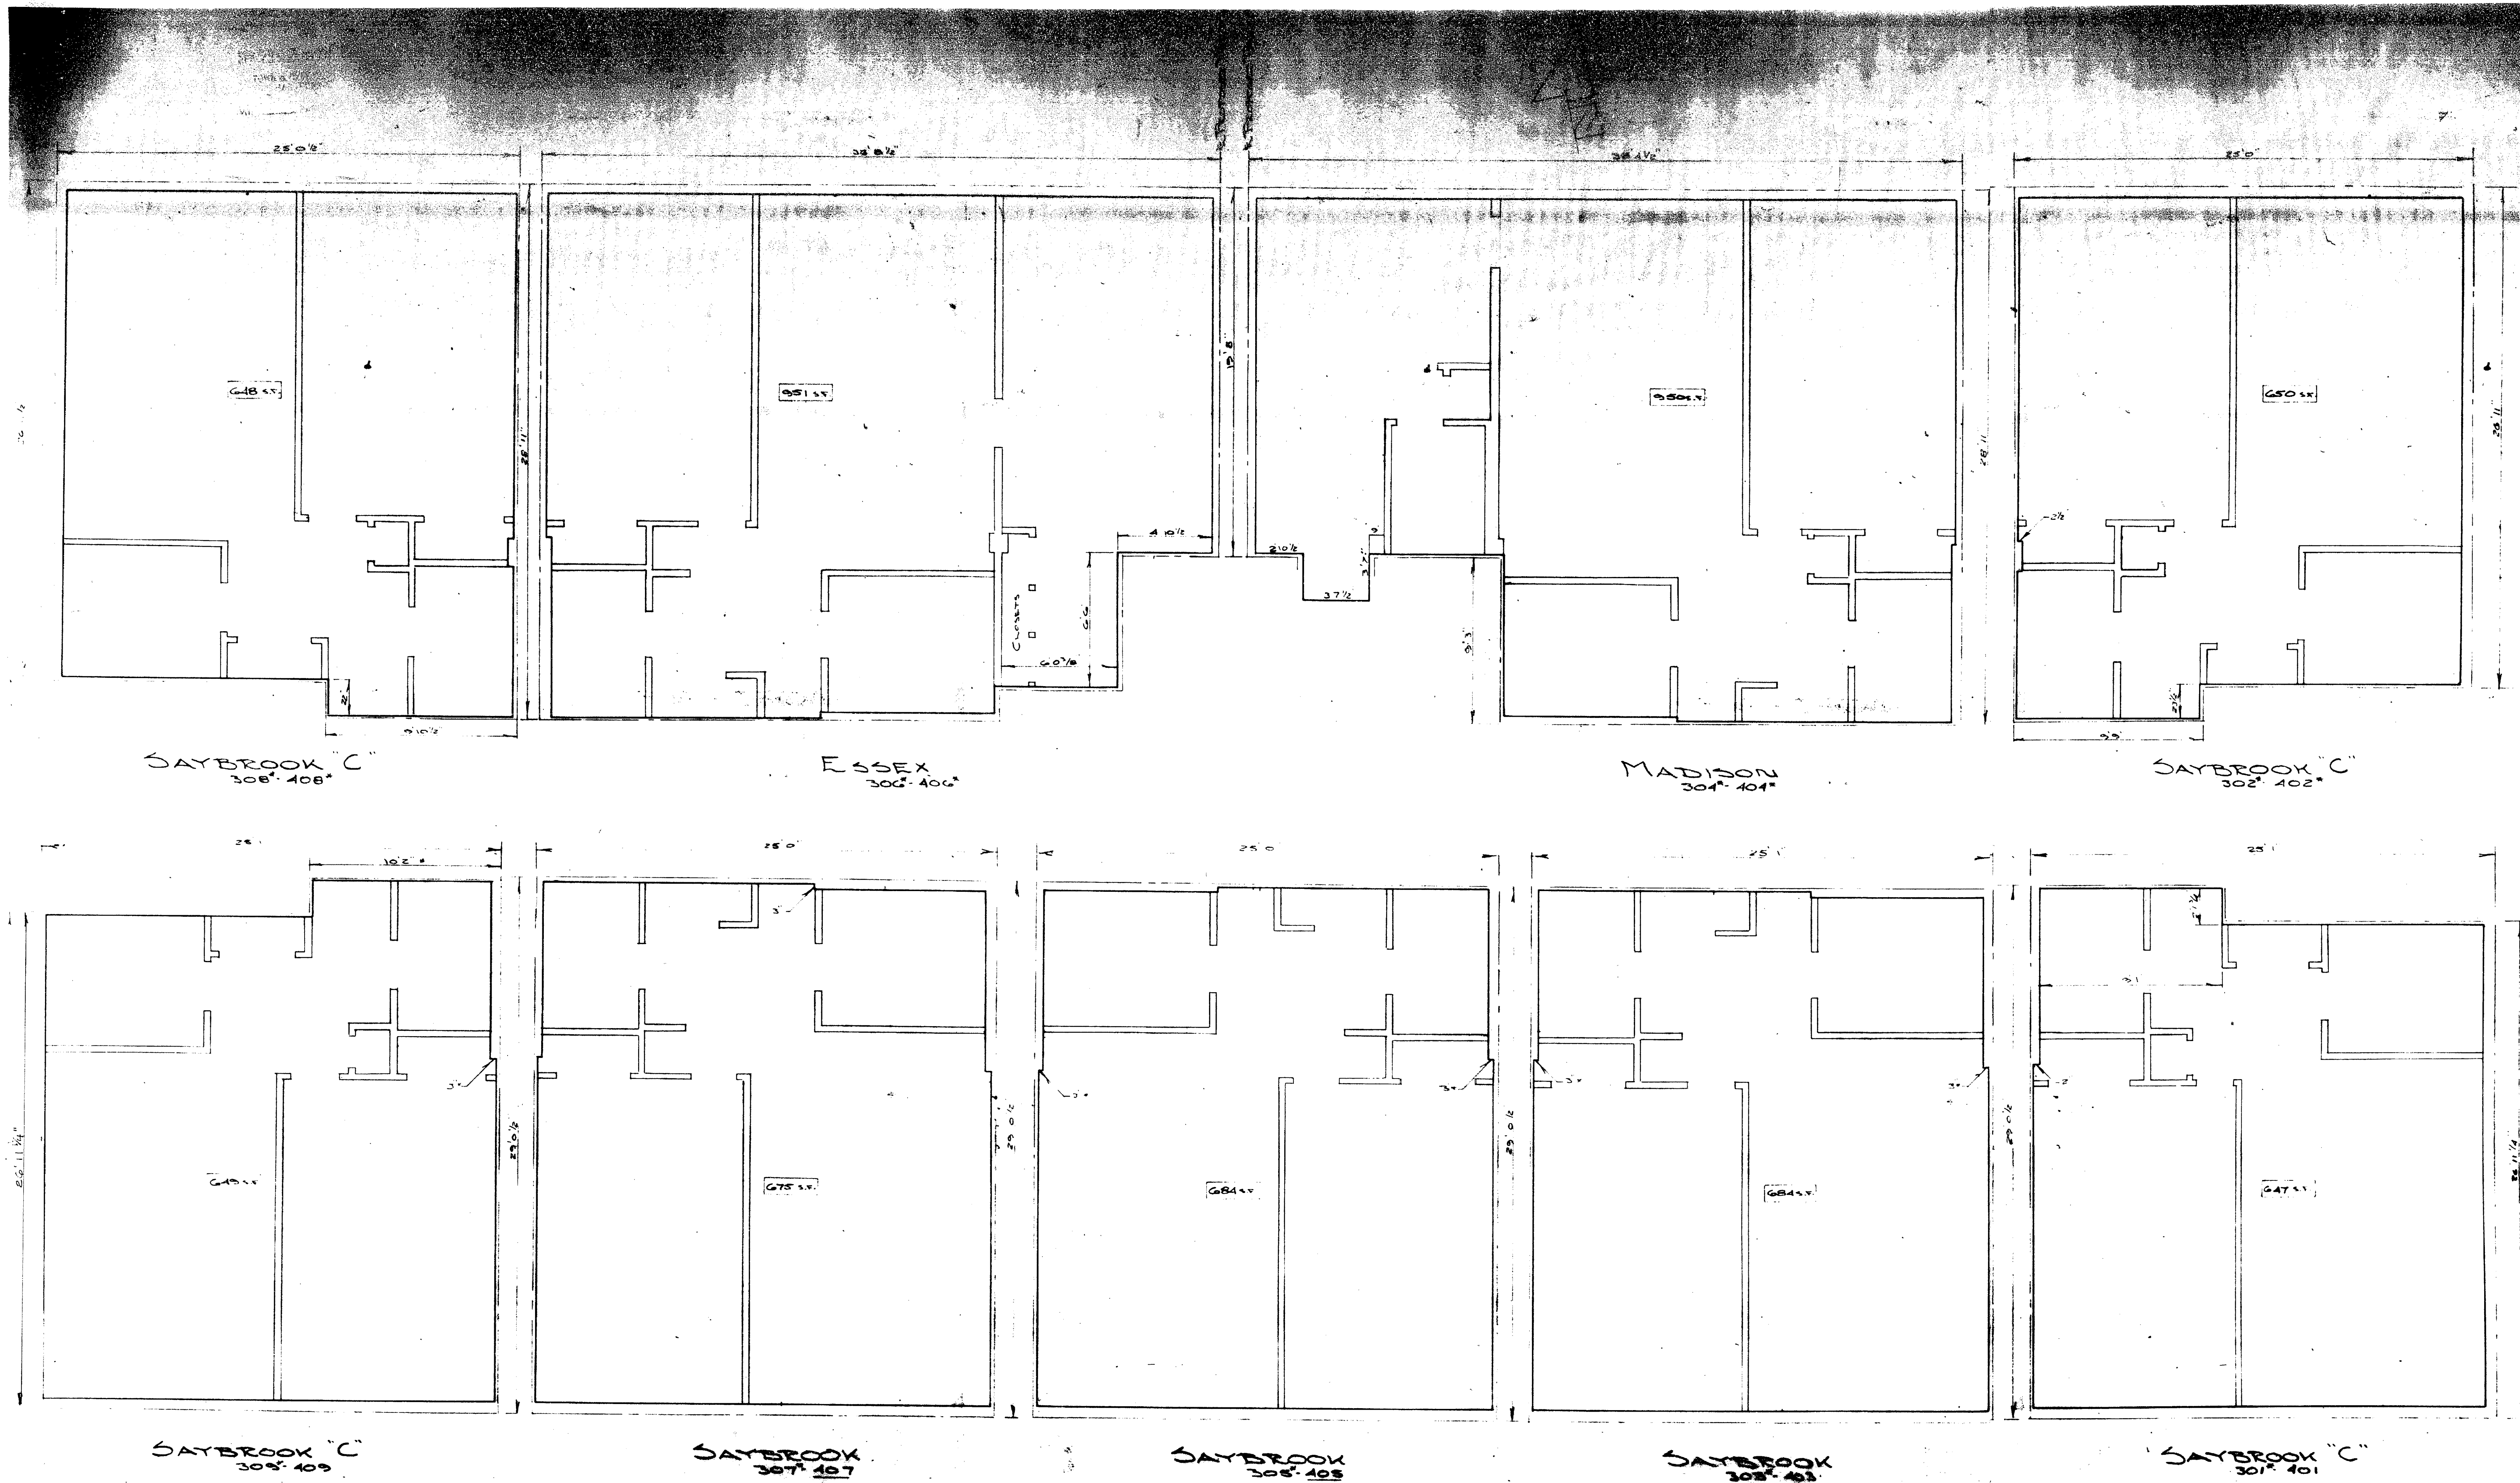

dean e. phillips associates
consulting engineers
portland, conn.

REV.	04-19-82
DATE	11-3-81
SCALE	AS SHOWN
DR. BY	R.C.H.
FILE	375.01.03

SURVEYS AND PLANS
FOR
SUMNERWOOD

27 SUMNER STREET
HARTFORD, CONN.

- NOTES
1. ALL OVERALL DIMENSIONS ARE MEASURED TO APPROXIMATE CENTRE OF WALLS.
 2. APARTMENT DIMENSIONS ARE BASED ON MEASUREMENTS TAKEN IN SIMILAR UNITS NOT TAKEN IN THIS PARTICULAR UNIT.
 3. INTERIOR PARTITION LOCATIONS ARE APPROXIMATE ONLY AND ARE SUBJECT TO VARIATIONS.

I HEREBY CERTIFY THAT THESE PLANS RELATIVE TO THIS CONDOMINIUM, FILED WITH THE HARTFORD CITY CLERK, ARE AN ACCURATE COPY OF PLANS ON FILE WITH THE HARTFORD BUILDING DEPARTMENT.

Dean E. Phillips, Reg. Prof. Engr. Ct No 7881