


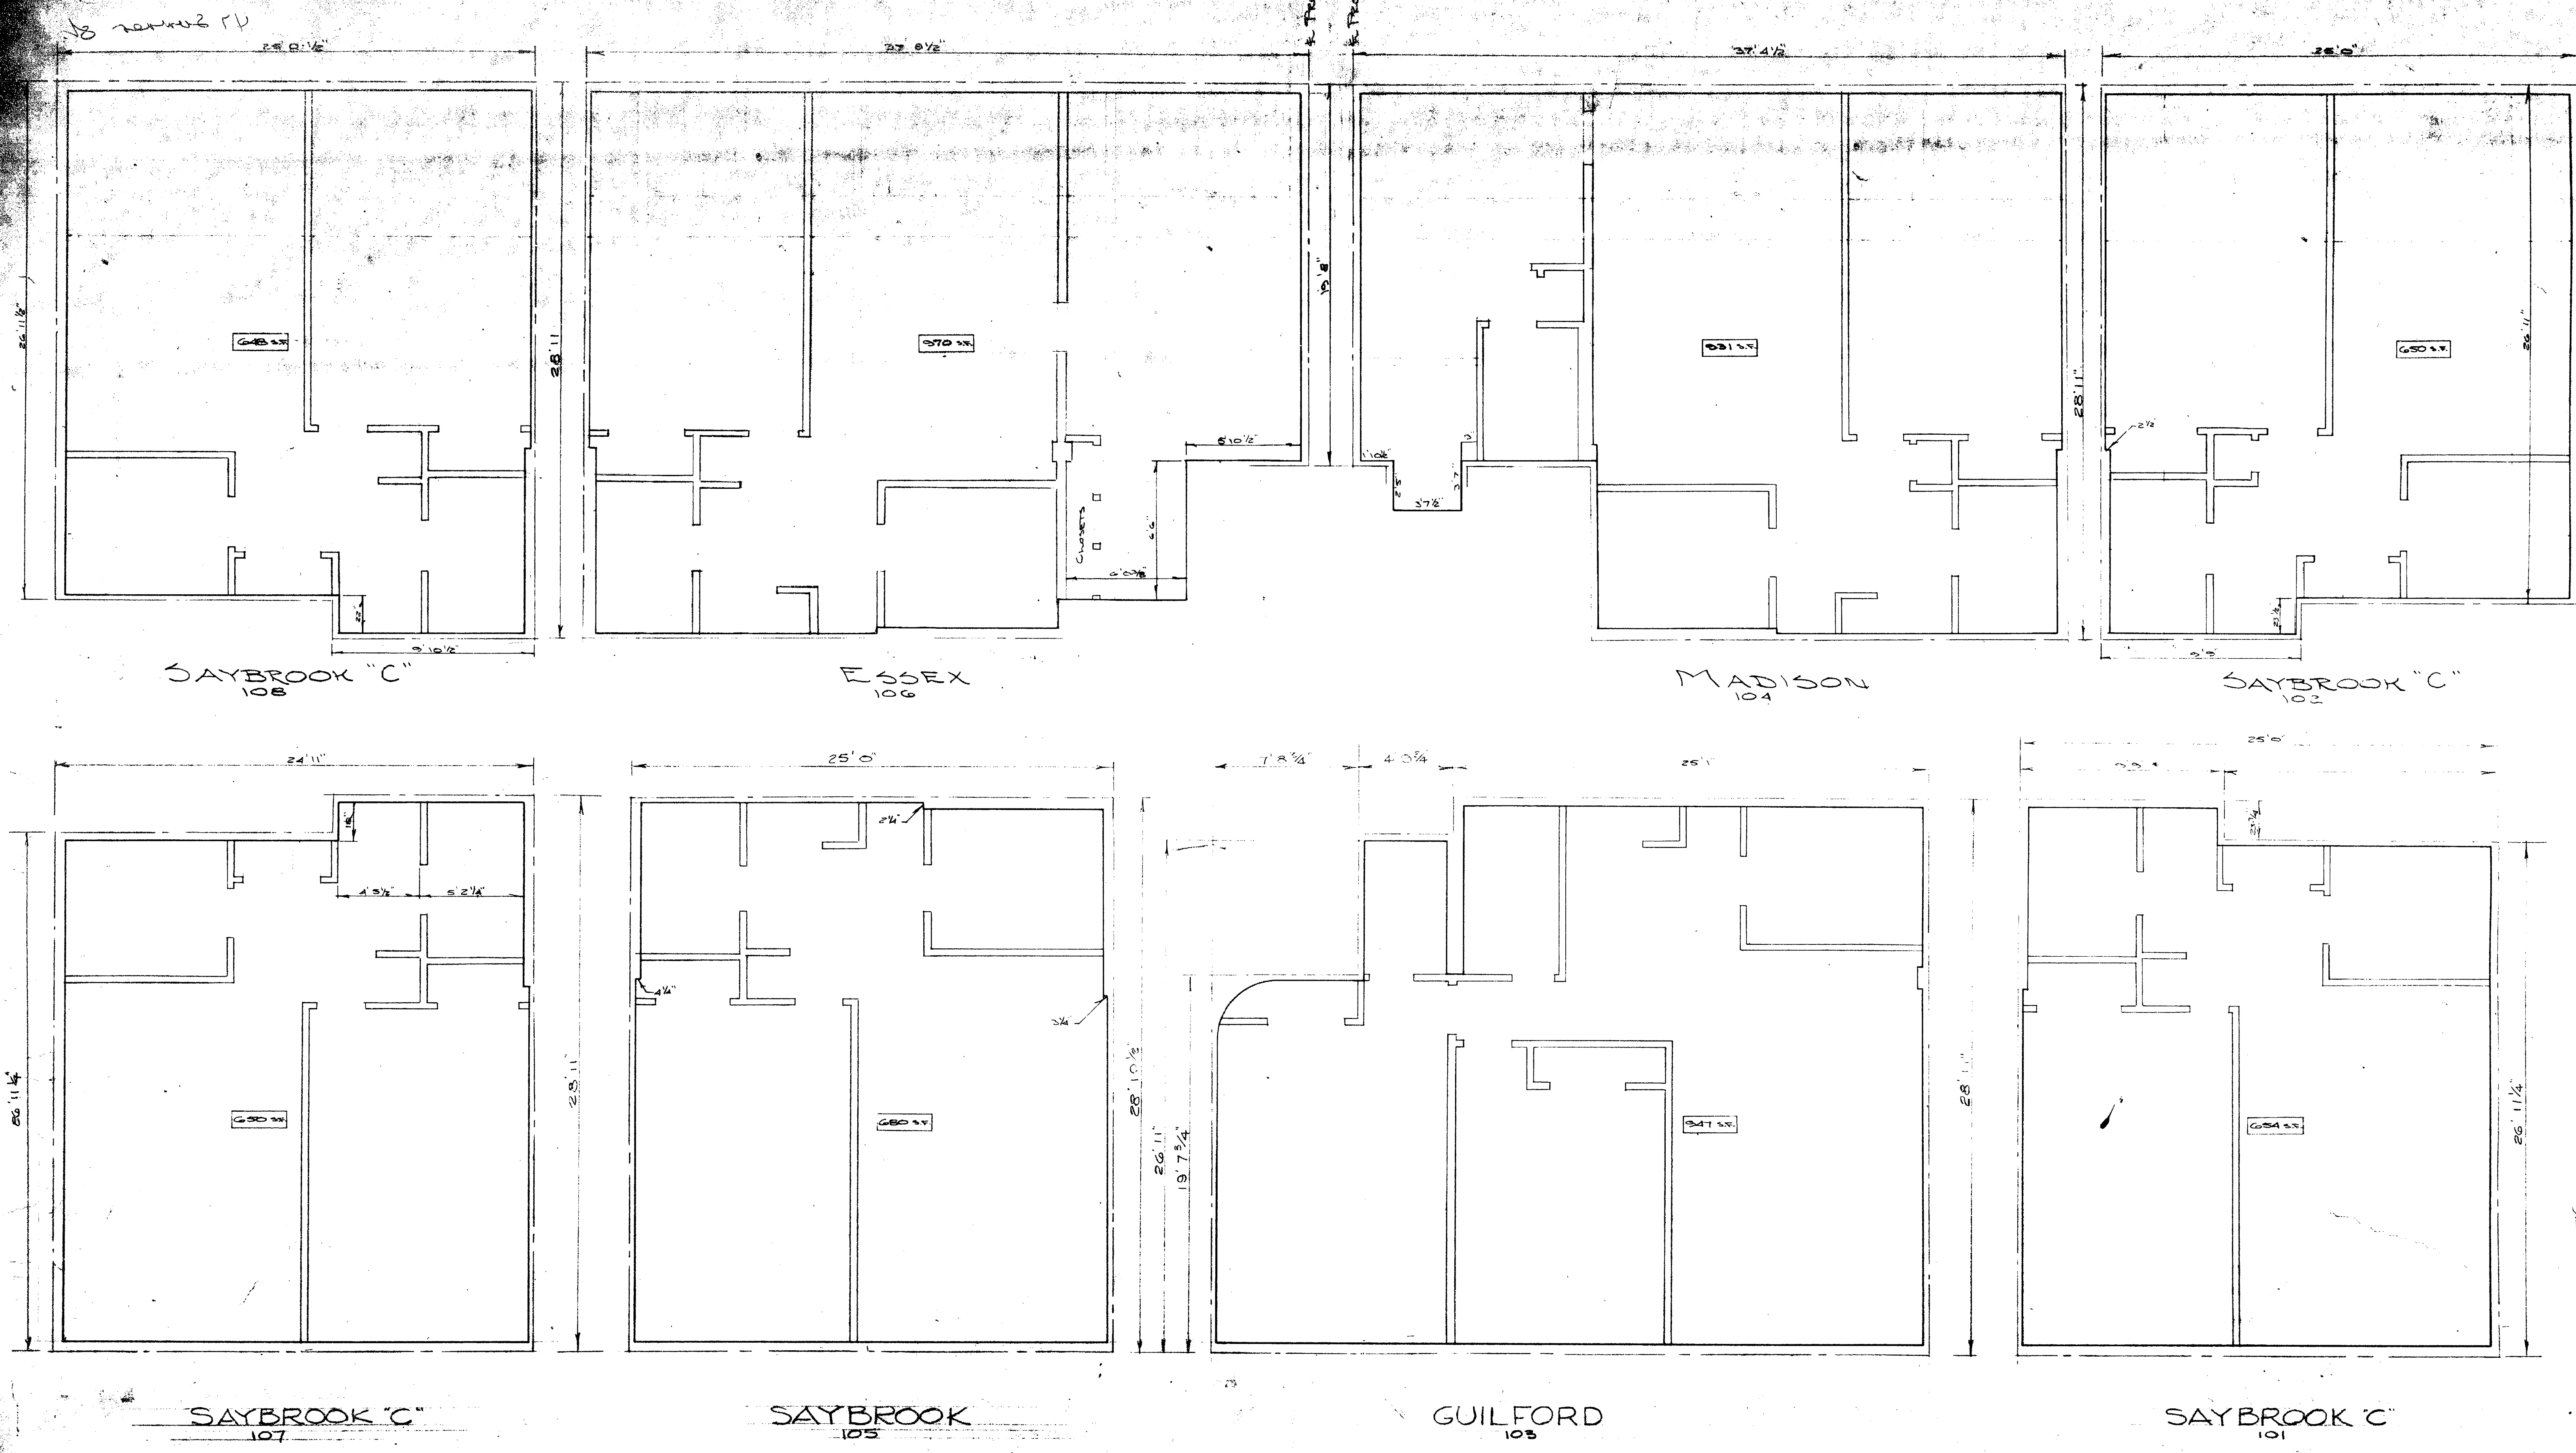

- NOTES
1. ALL OVERALL DIMENSIONS ARE MEASURED TO APPROXIMATE CENTER OF WALLS.
 2. DIMENSIONS ARE BASED ON MEASUREMENTS ACTUALLY TAKEN IN SIMILAR UNITS BUT NOT TAKEN IN THIS PARTICULAR UNIT.
 3. INTERIOR PARTITION LOCATIONS ARE APPROXIMATE ONLY AND ARE SUBJECT TO VARIATIONS.

I HEREBY CERTIFY THAT THESE PLANS RELATIVE TO THIS CONDOMINIUM, FILED WITH THE HARTFORD CITY CLERK, ARE AN ACCURATE COPY OF PLANS ON FILE WITH THE HARTFORD BUILDING DEPARTMENT.

Dean E. Phillips
 DEAN E. PHILLIPS, REG. PROF. ENGR., CT. NO. 7881

dean e. phillips associates
consulting engineers
portland, conn.

HARTFORD, CONN.

SURVEYS AND PLANS
FOR
SUMMERWOOD

101 SUMMER STREET

REV.	04-05-82
REV.	11-03-81
DATE	05-26-81
SCALE	AS SHOWN
DR. BY	R.C.H.
FILE	375.01.01