

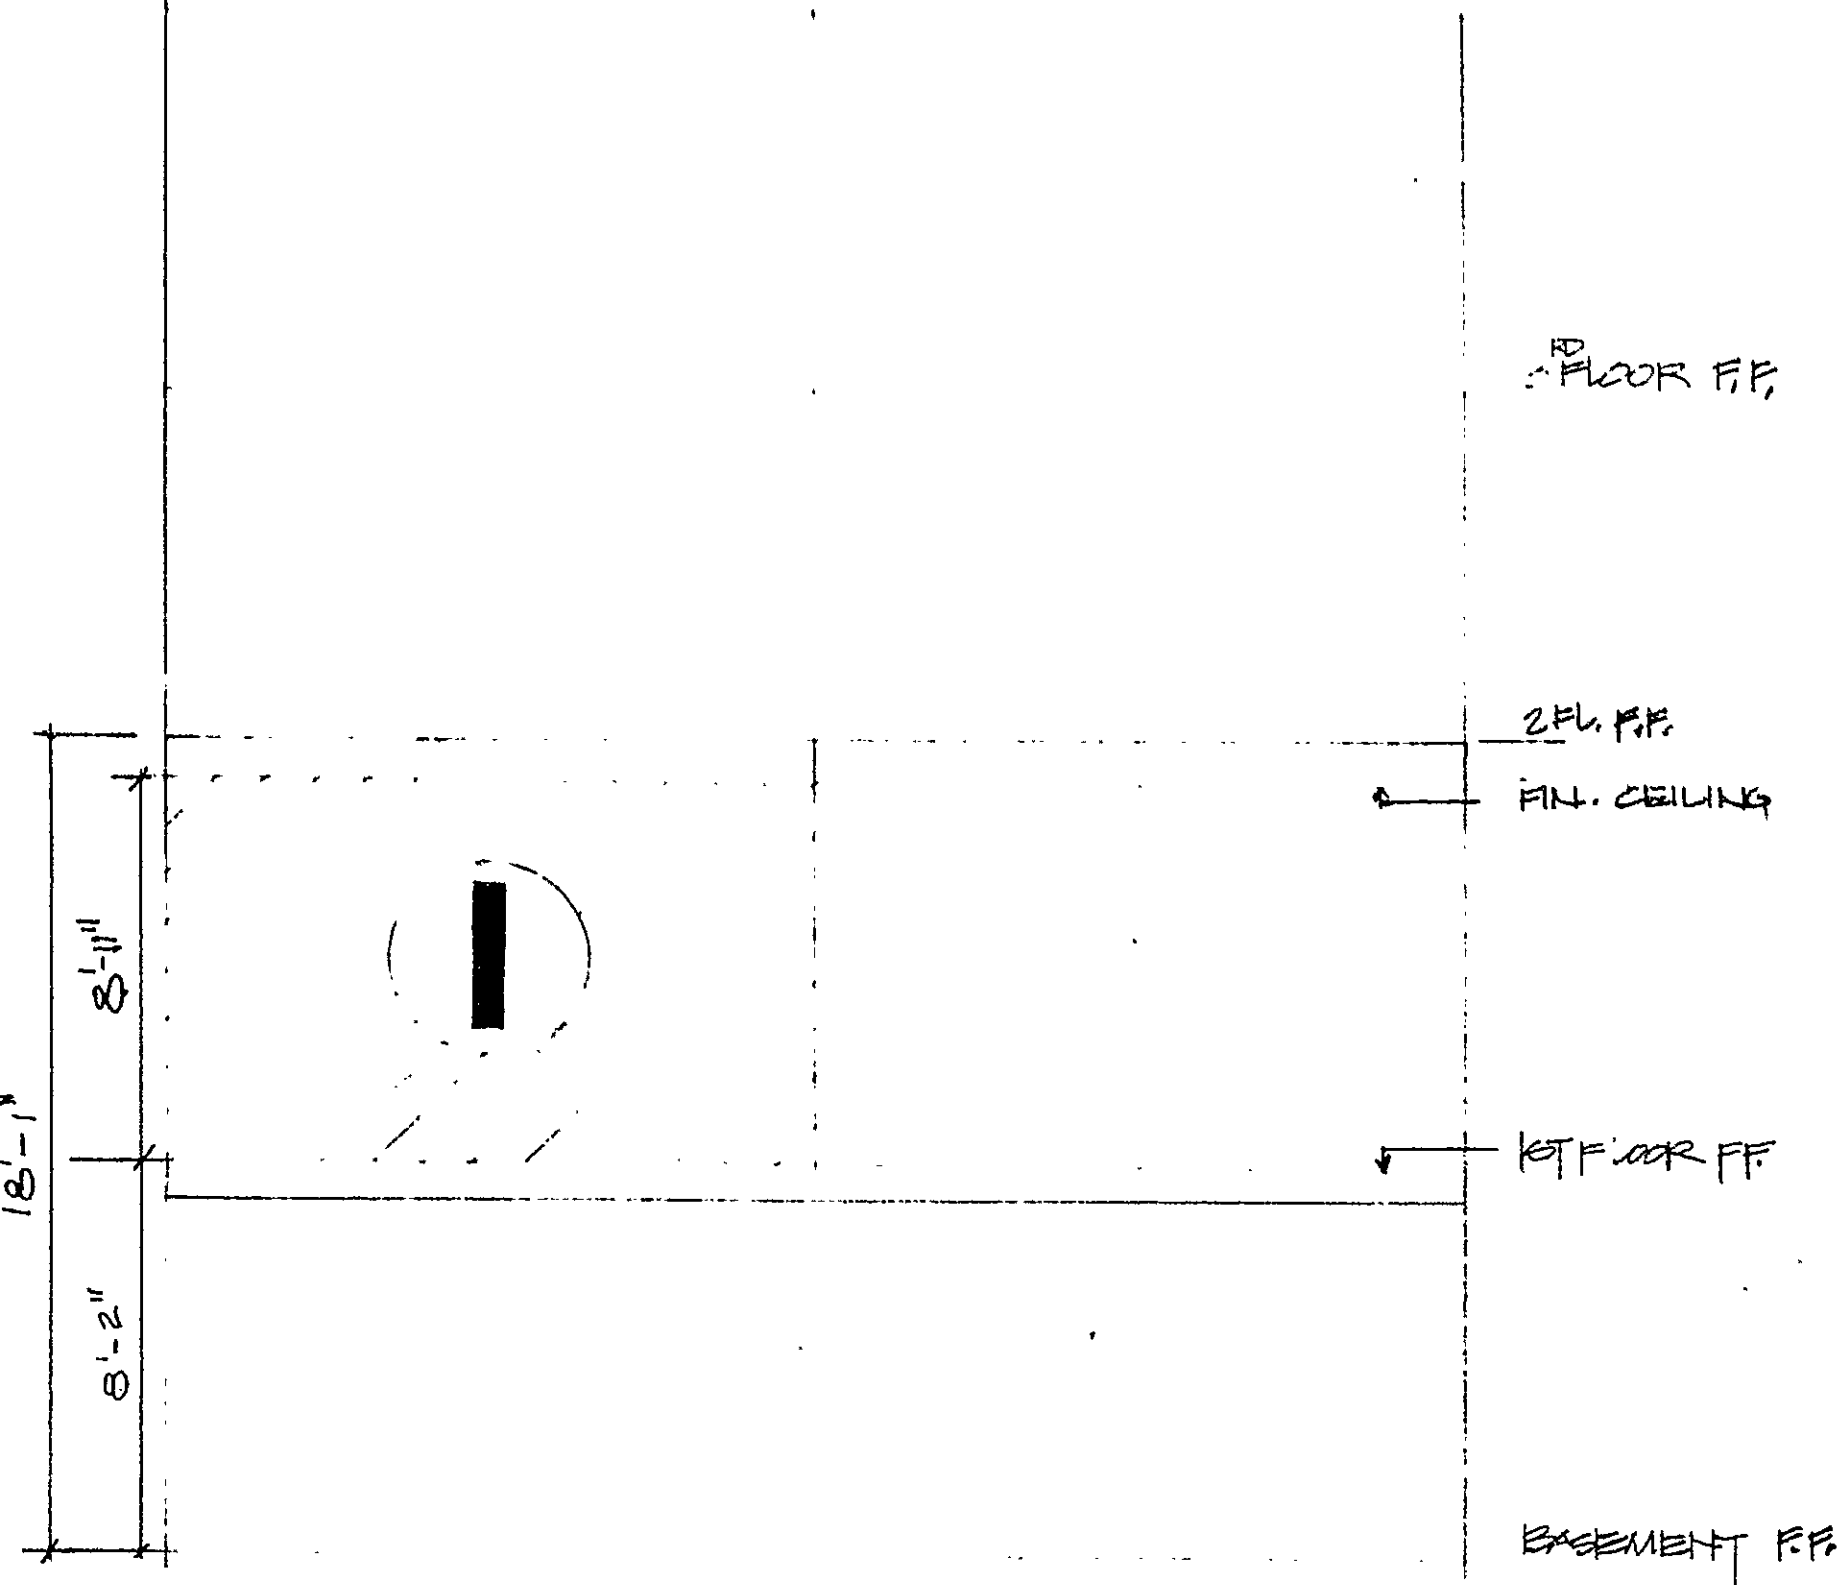


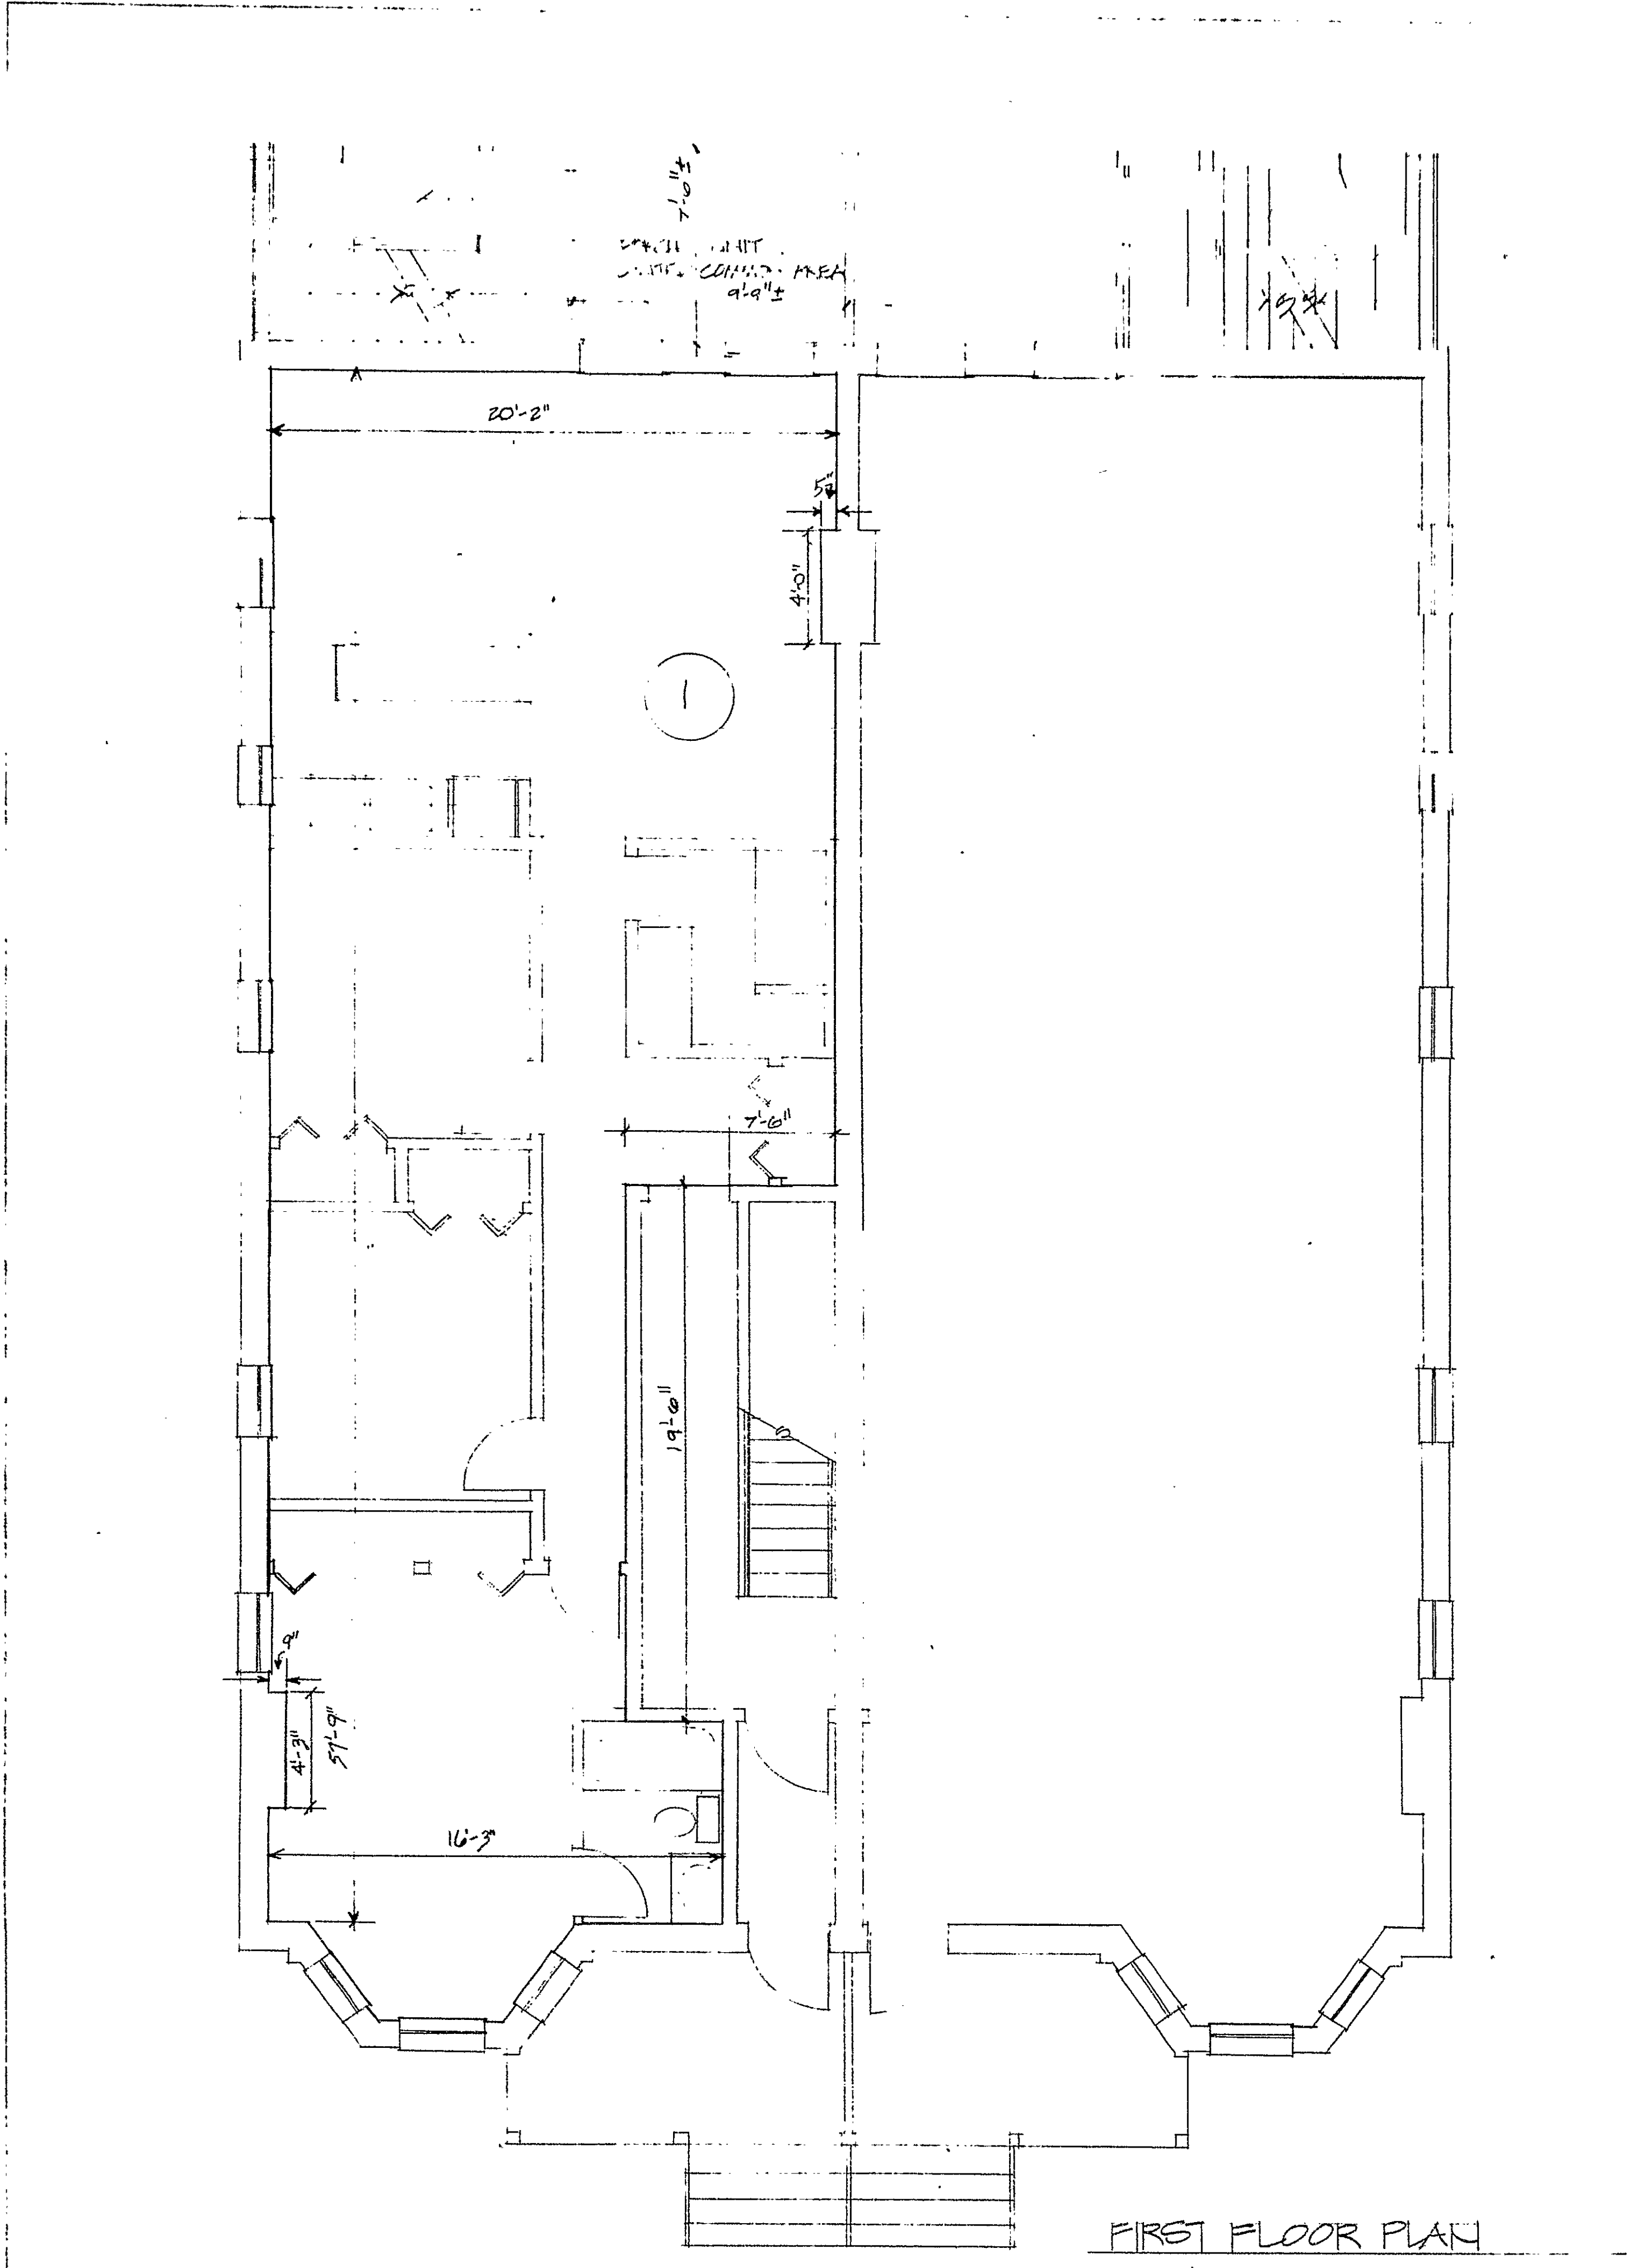


RECEIVED BY
DATE
TOWN & PLANNING
PAGE

Condo Floor Plan # 57

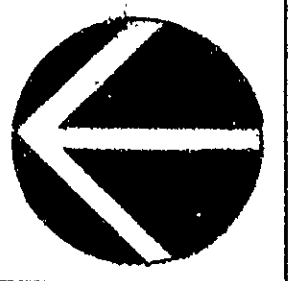

SHEET
2 OF 7

THE LAWRENCE CONDOMINIUM
UNITS DEVELOPER: OWNER/DEVELOPER

510 AMESBURY
PROJ. COORDINATOR

ARCHITECTS
VAN DER BEEK
353 Park Road, West Hartford, CT 06119

UNIT #