




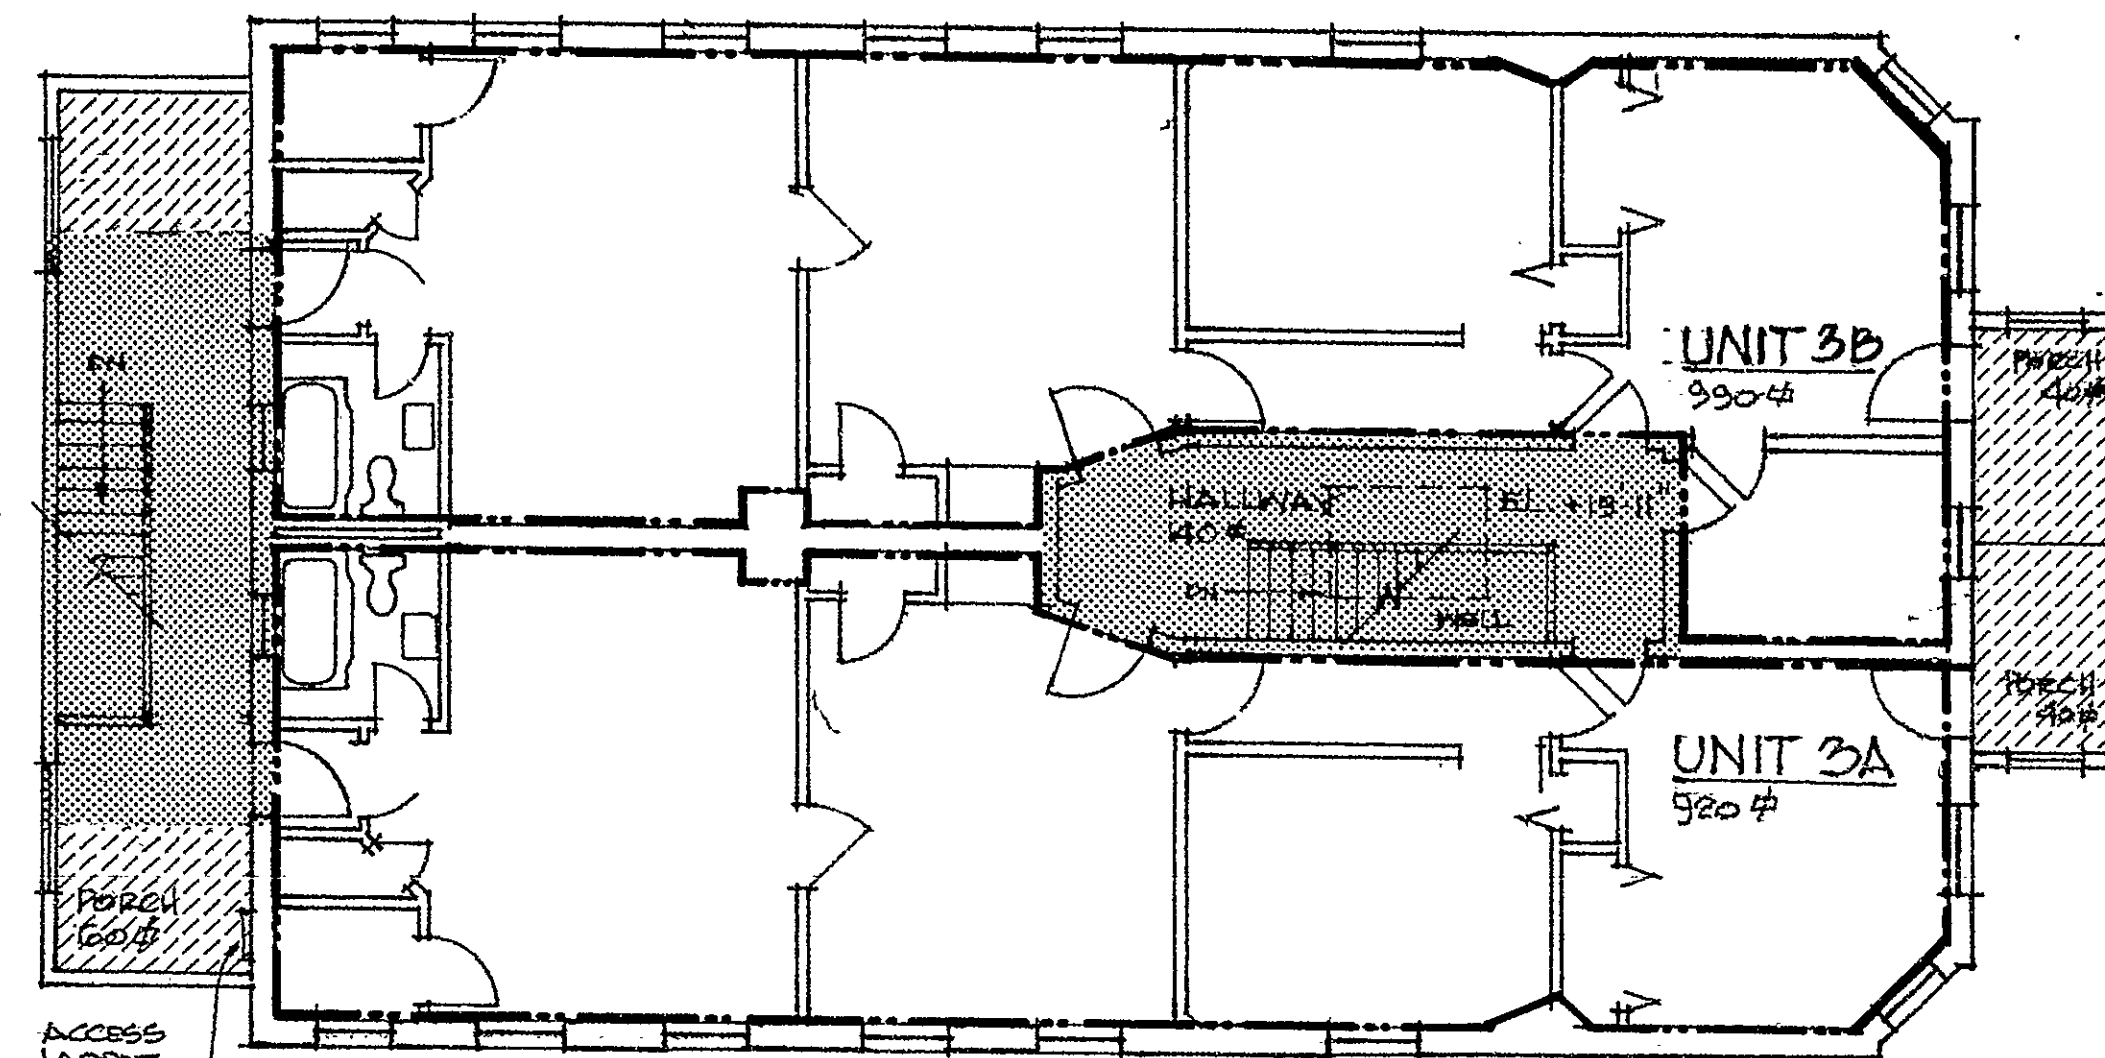


THIRD FLOOR SAME DIMENSIONS AS 2ND FLOOR.
 CLG. HGT. 8'-4 1/2" L.B. EL. 72.08 U.B. EL. 81.64

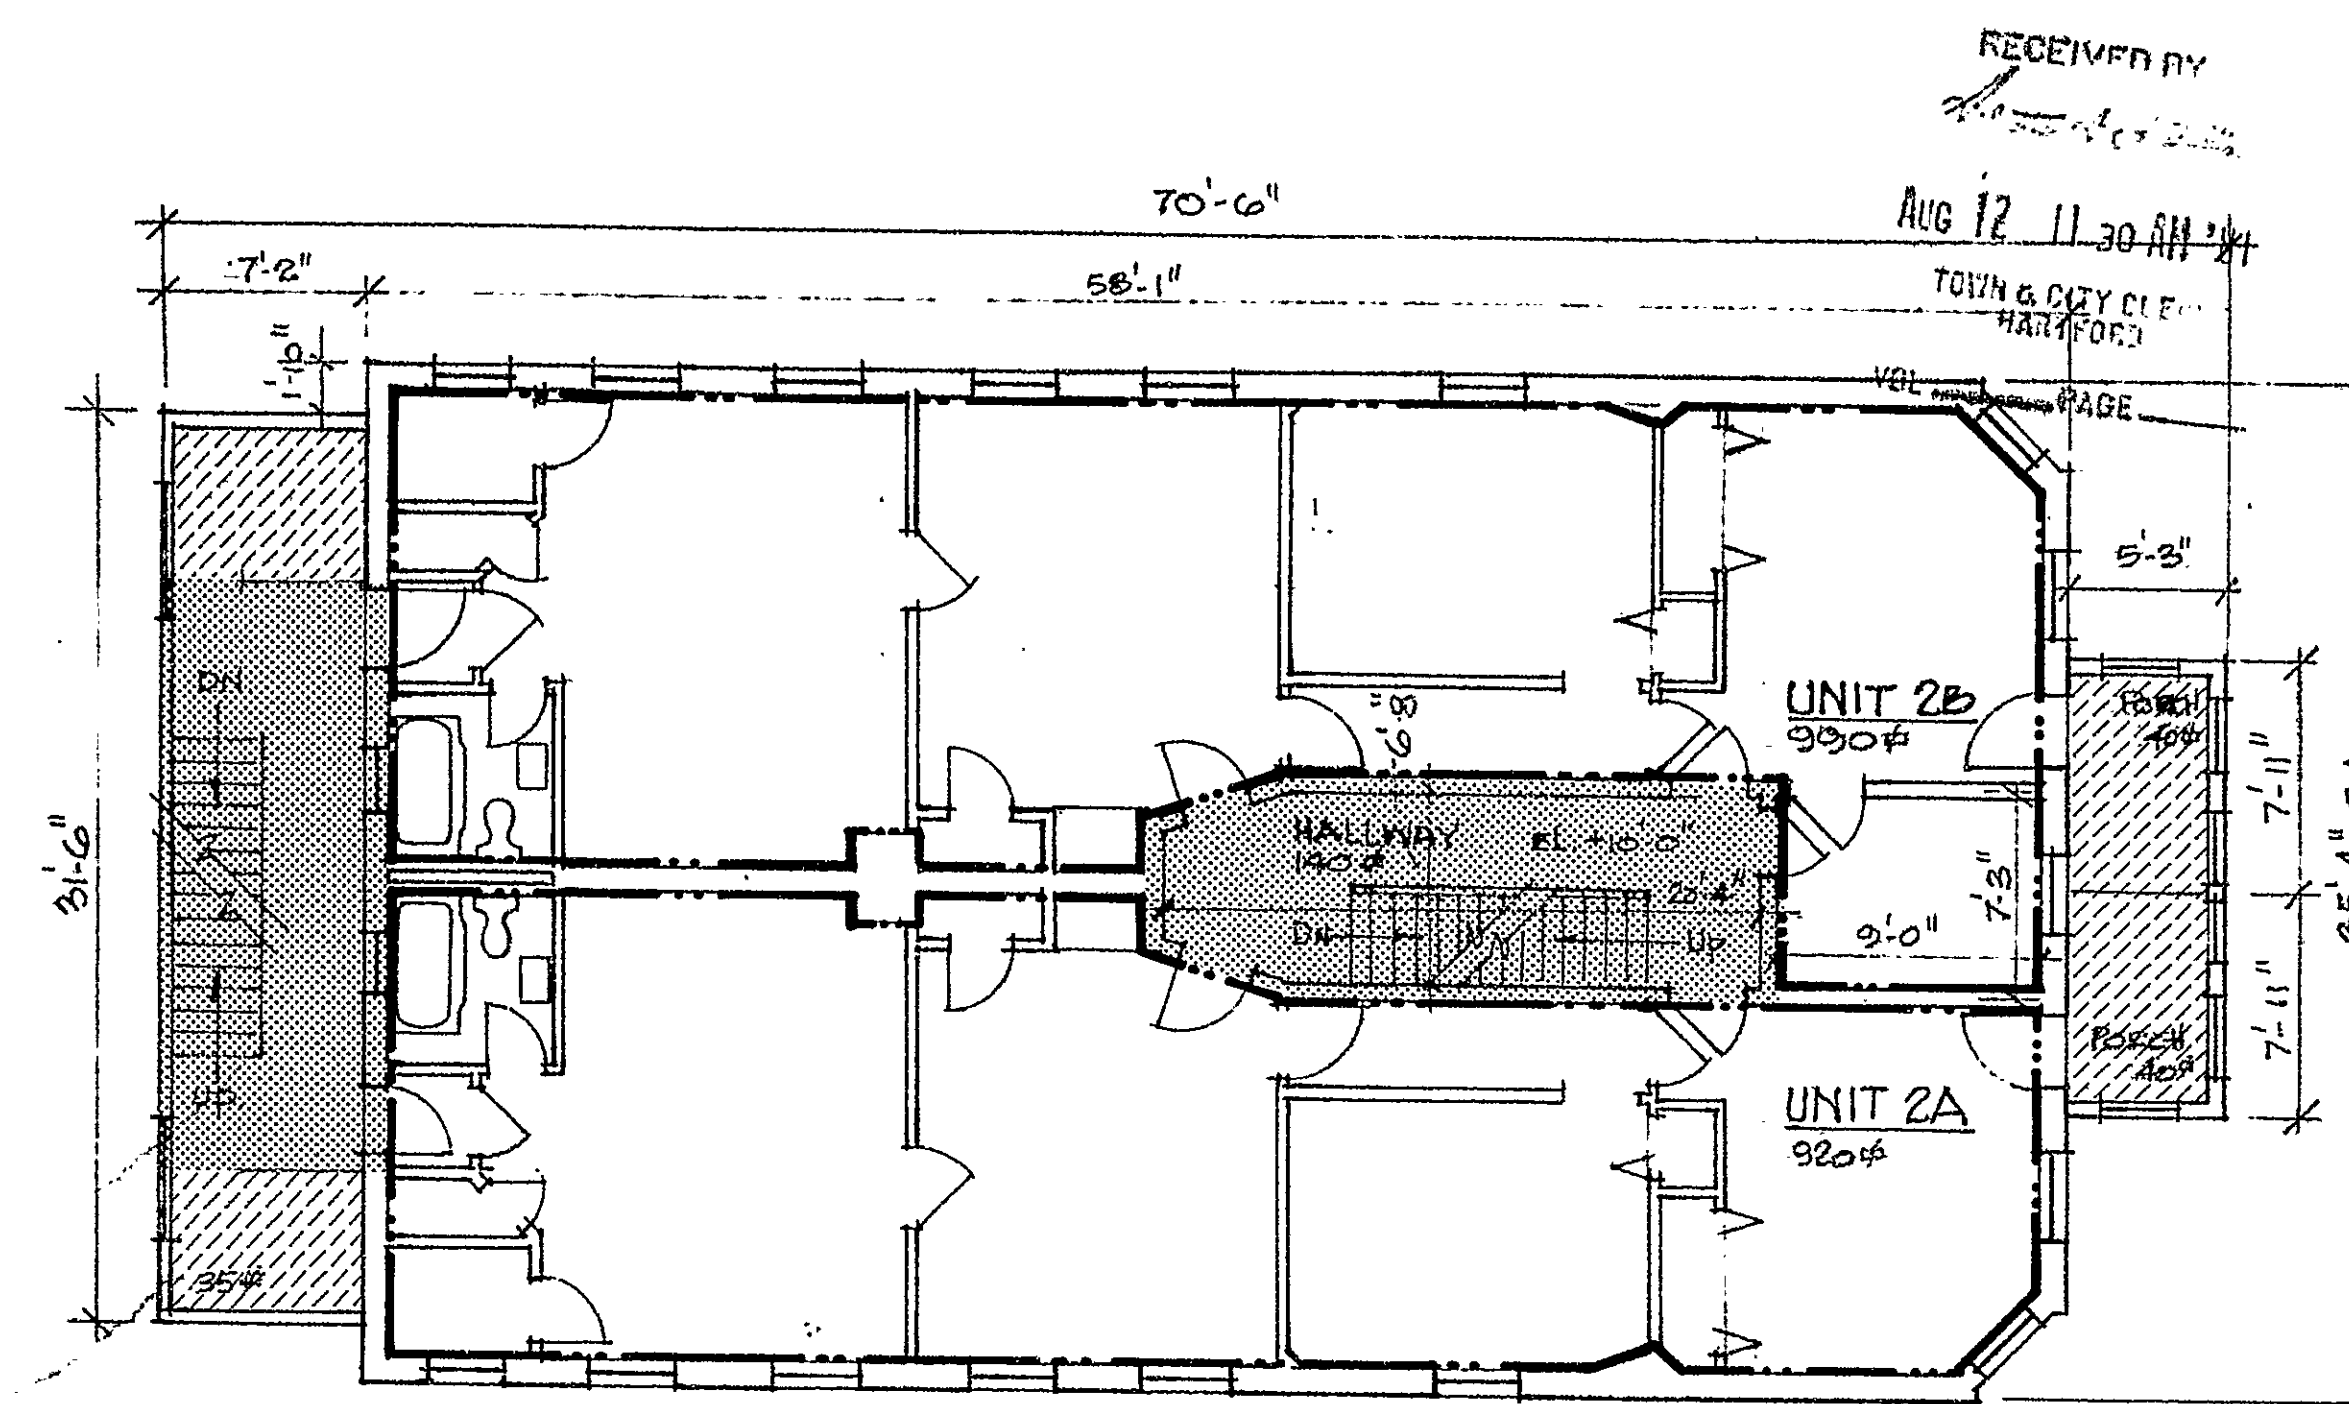


SECOND FLOOR ROOM DIMENSIONS SAME AS 1ST FLOOR.
 CLG. HGT. 9'-0" L.B. EL. 62.76 U.B. EL. 71.76

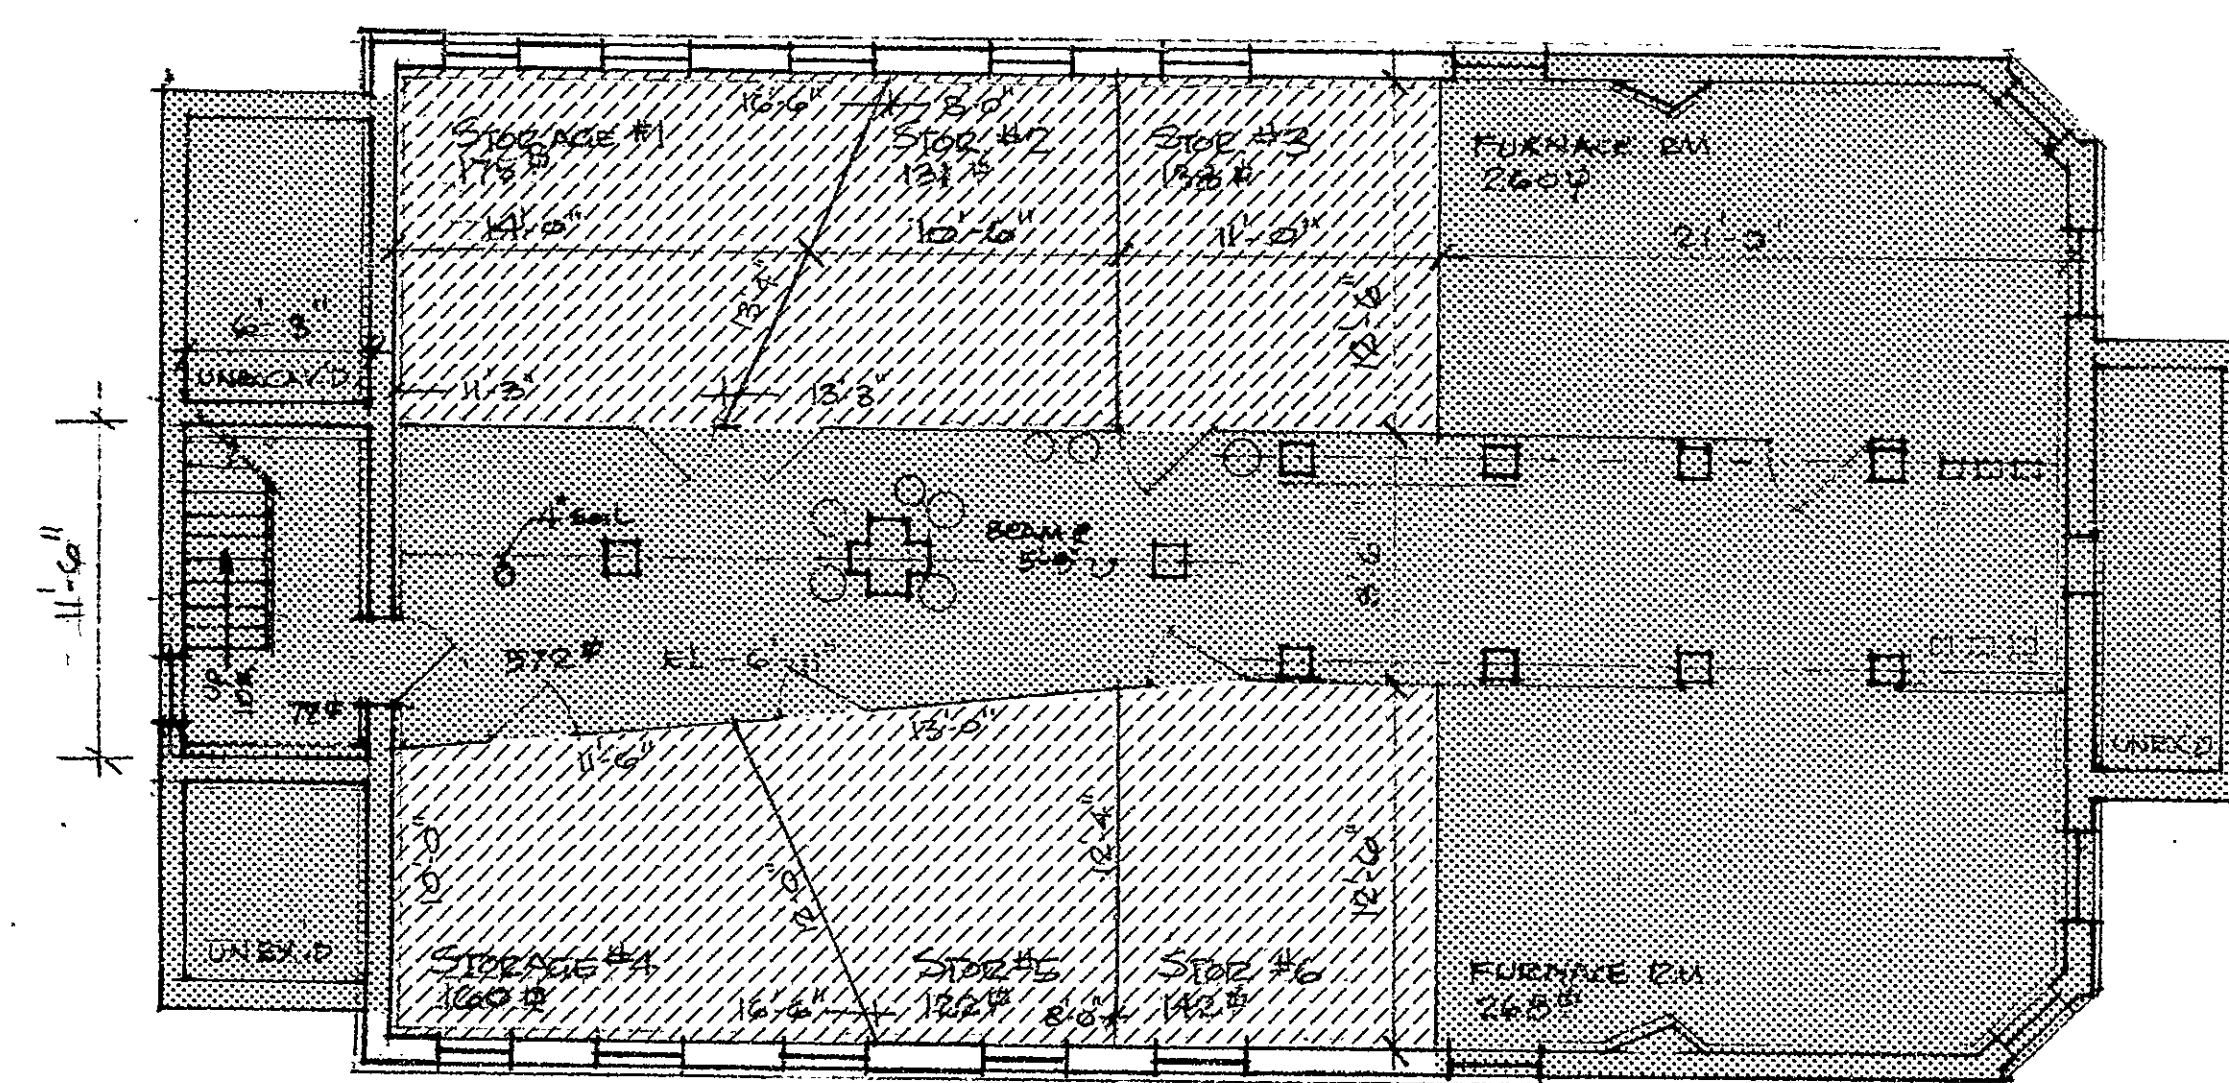

BASEMENT
 CEILING HGT. 6'-2" LOWER BOUNDARY EL. 45.8 UPPER BOUNDARY EL. 51.96

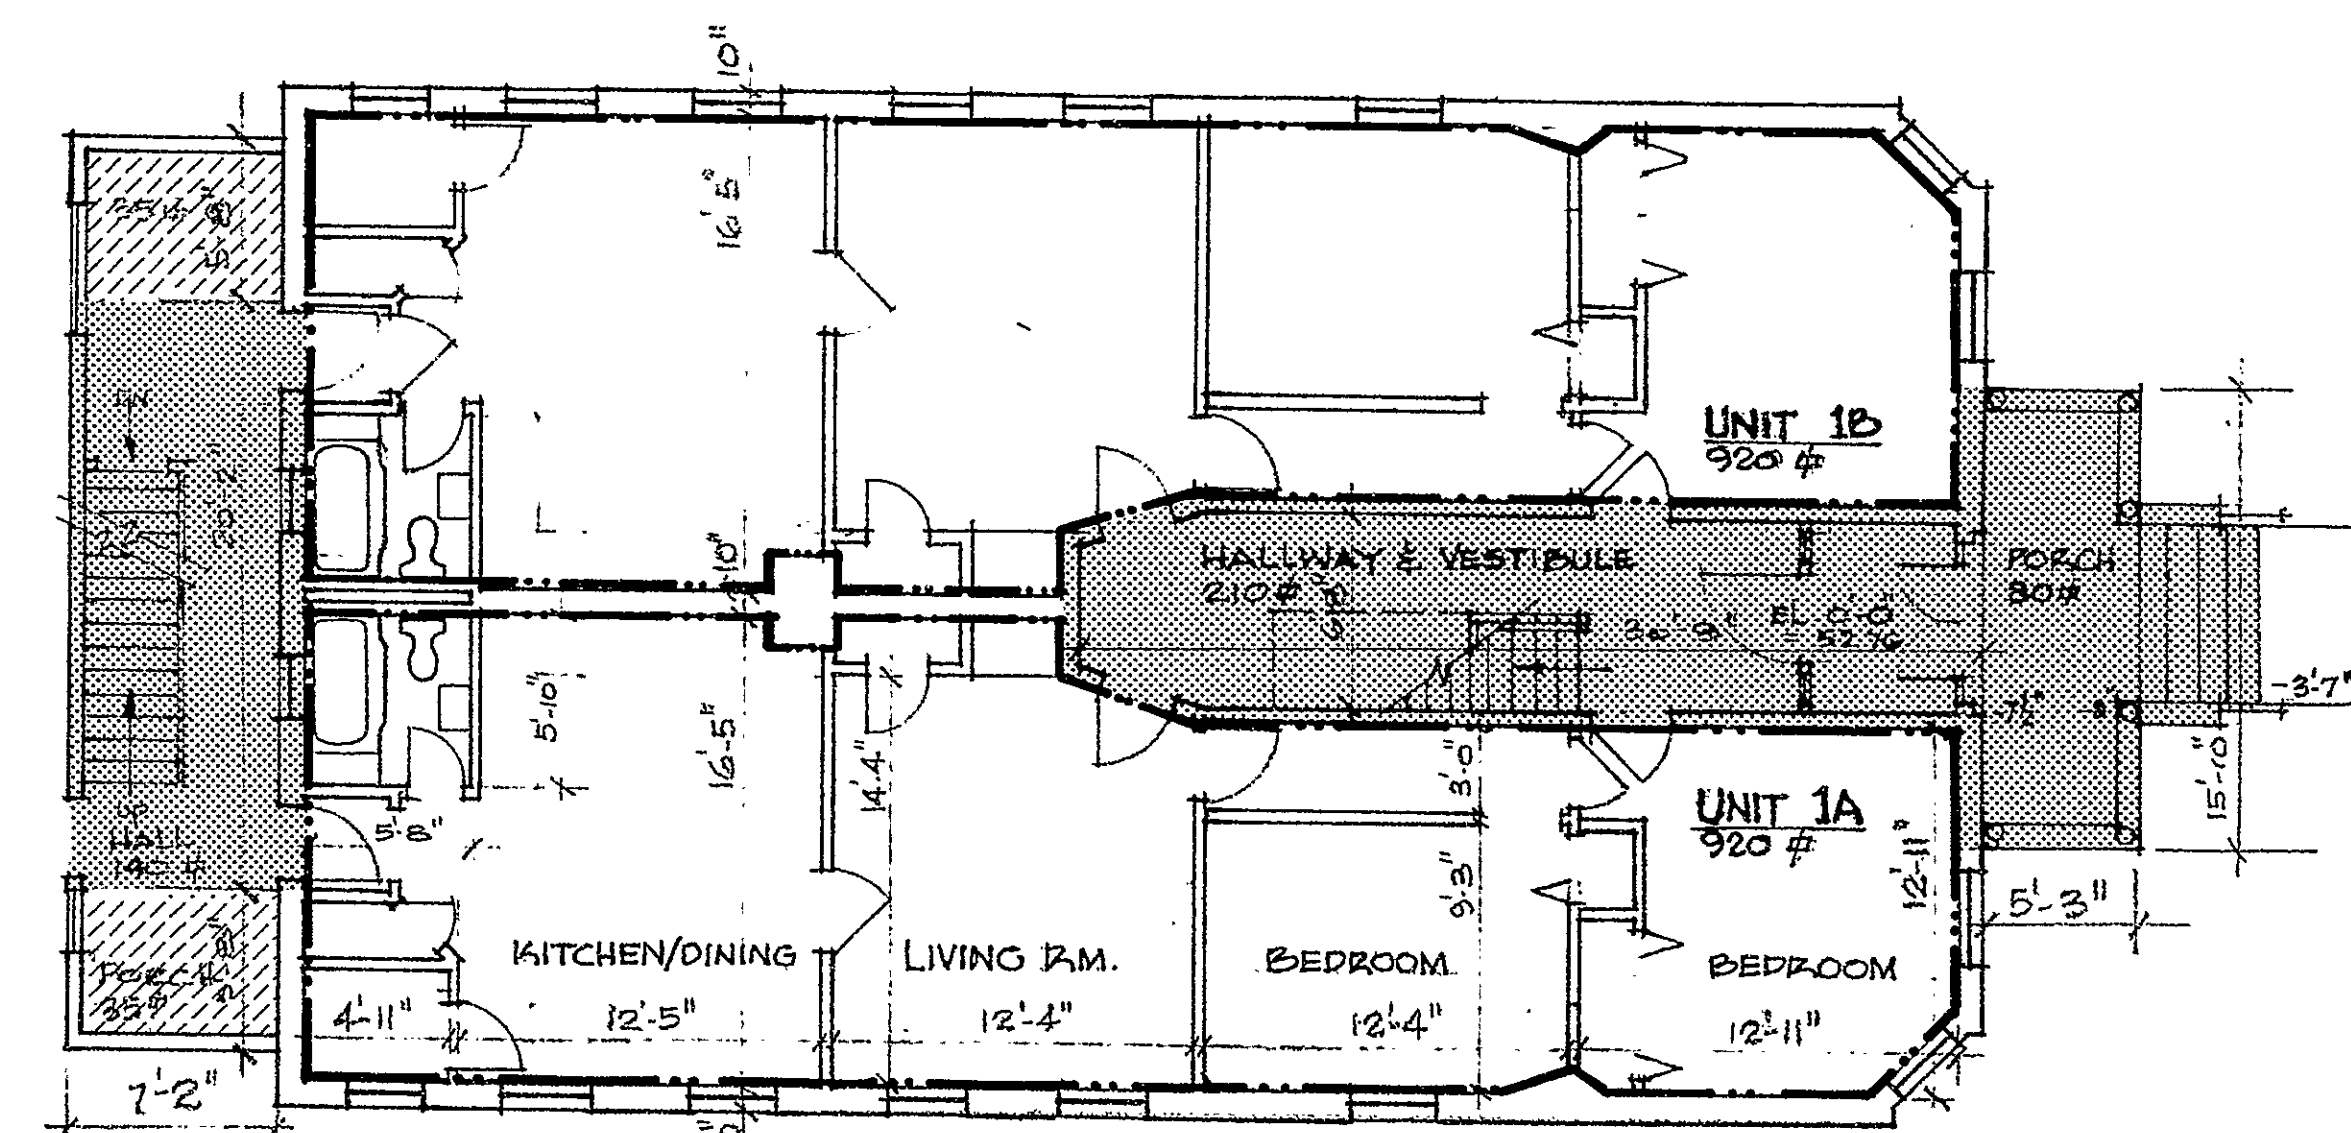

FIRST FLOOR
 CLG. HGT. 9'-0" LOWER BOUNDARY EL. 52.76, UPPER BOUNDARY EL. 61.76

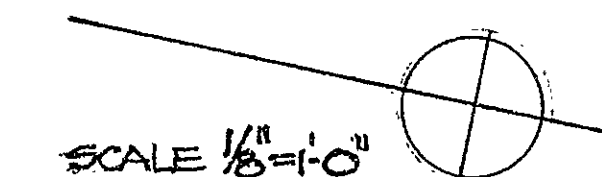


KEY:

- UNIT DEMISING WALL
- COMMON ELEMENT
- LIMITED COMMON ELEMENT

MARK ONES CONDOMINIUM
 AN EXPANDABLE CONDOMINIUM
 43-45 BOND STREET • HARTFORD, CT.

I CERTIFY THAT THESE PLANS ARE AN ACCURATE COPY OF PORTIONS OF PLANS FILED WITH THE TOWN CLERK, CITY OF HARTFORD, CT.

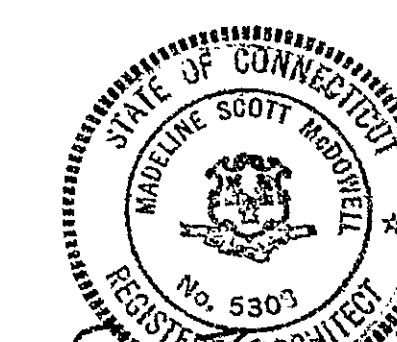

Condo Floor Plan # 58

